
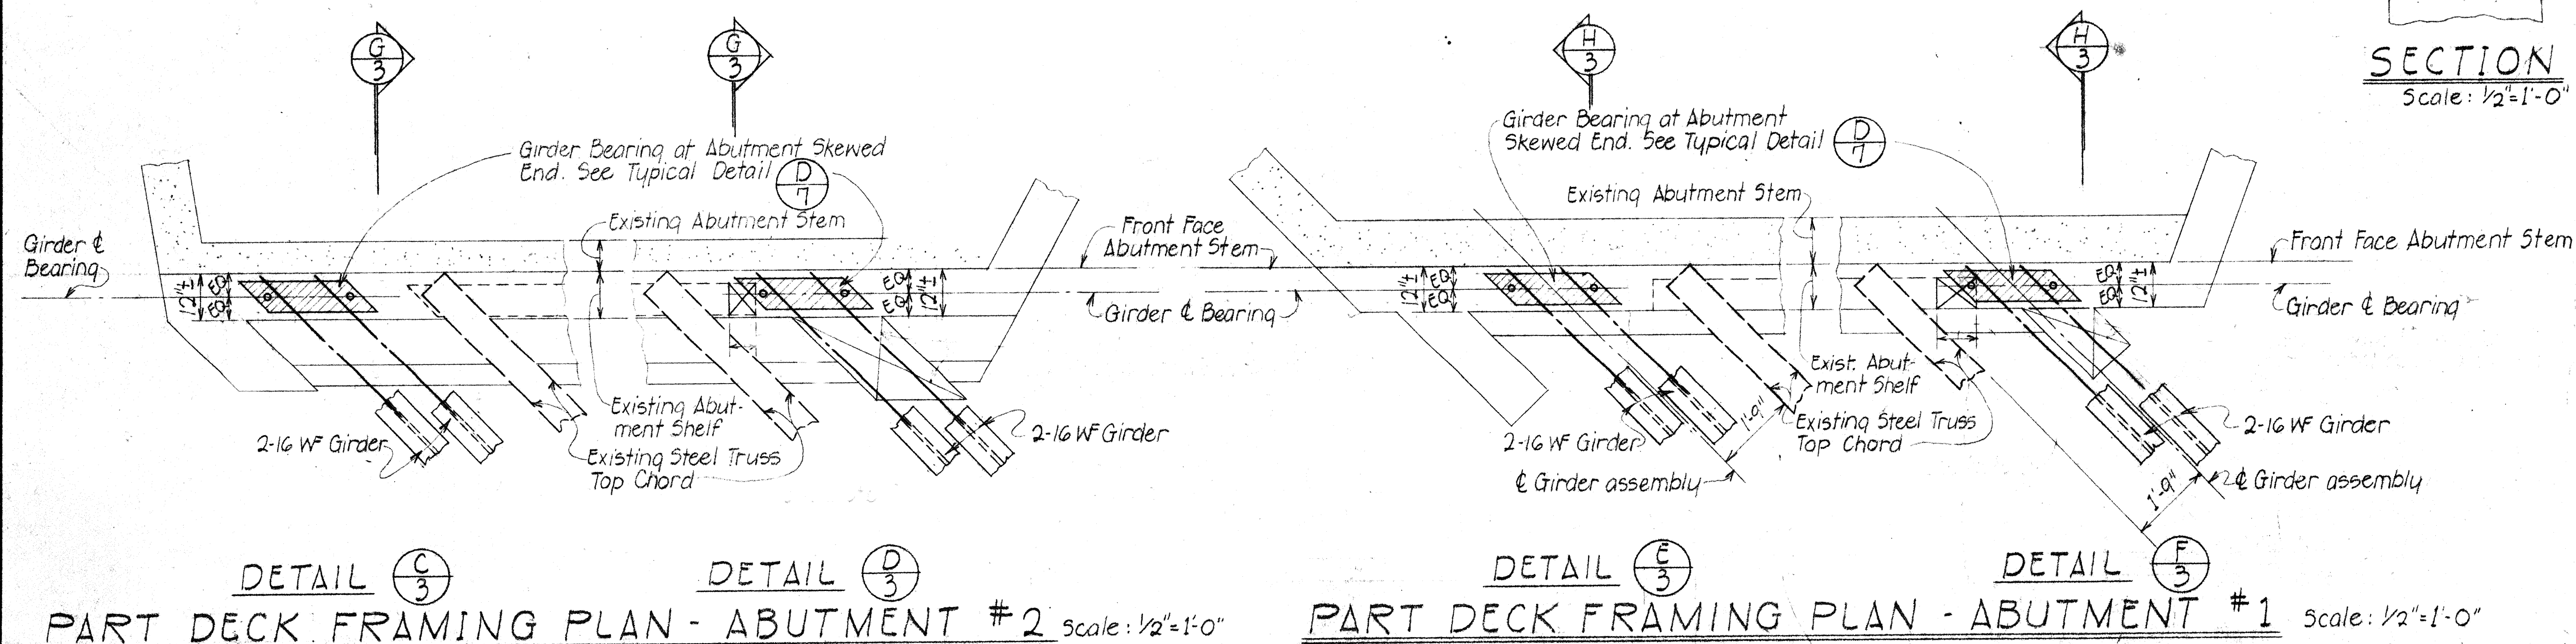
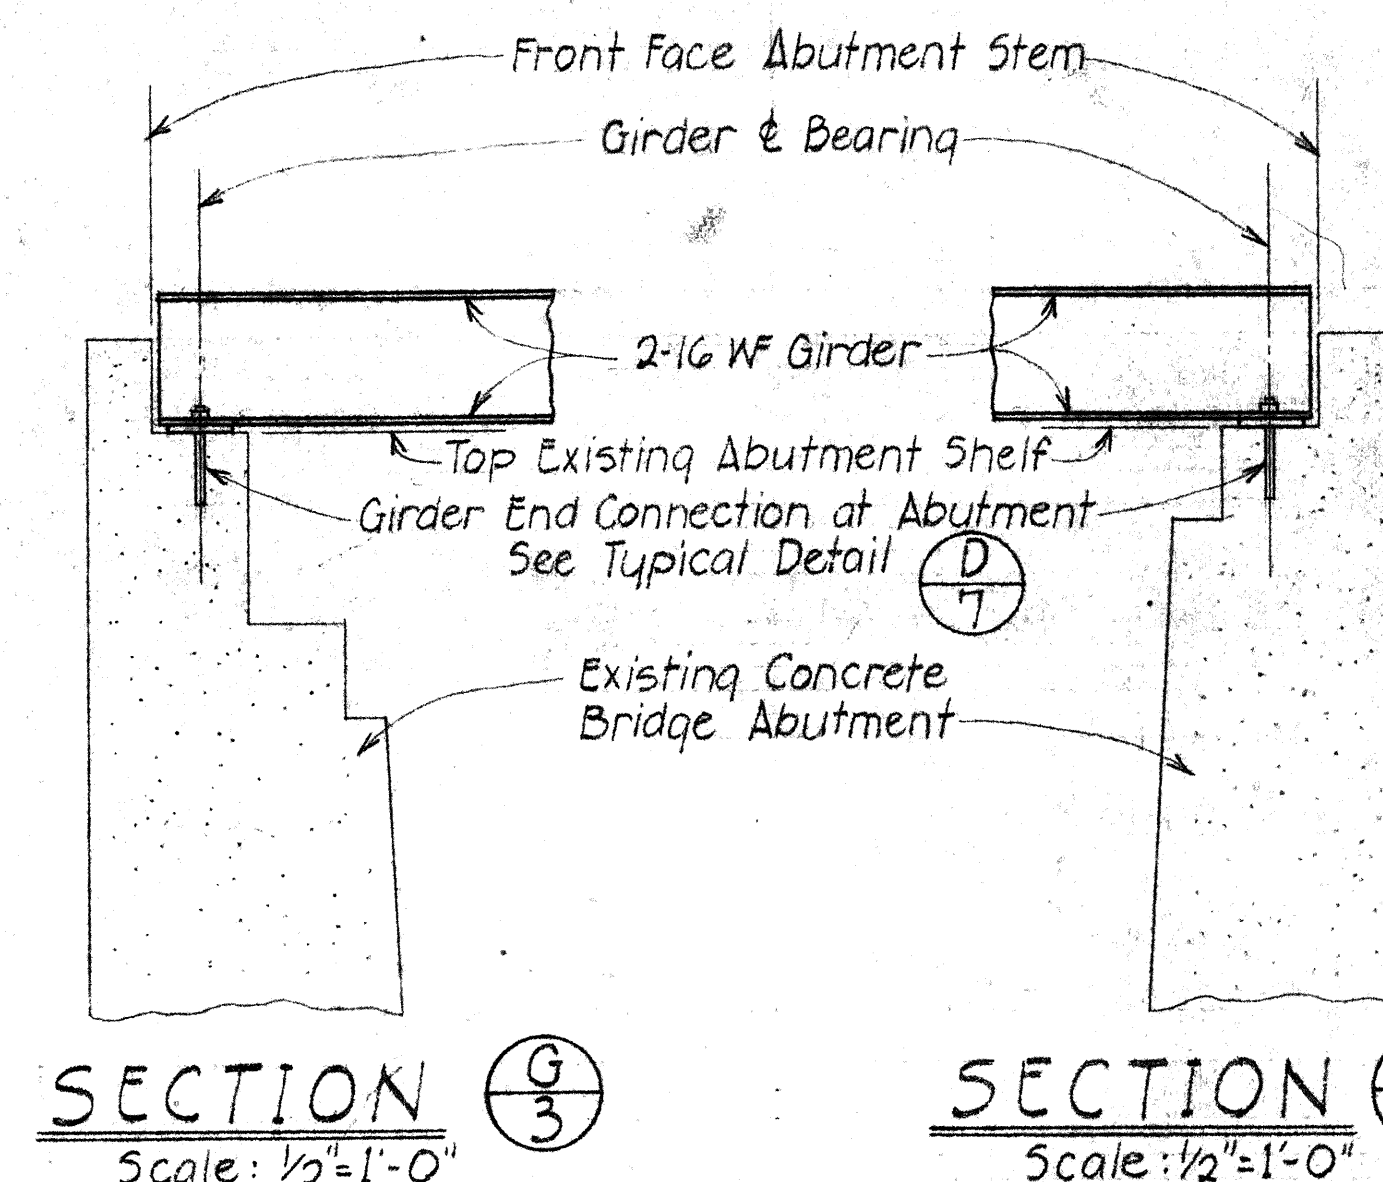
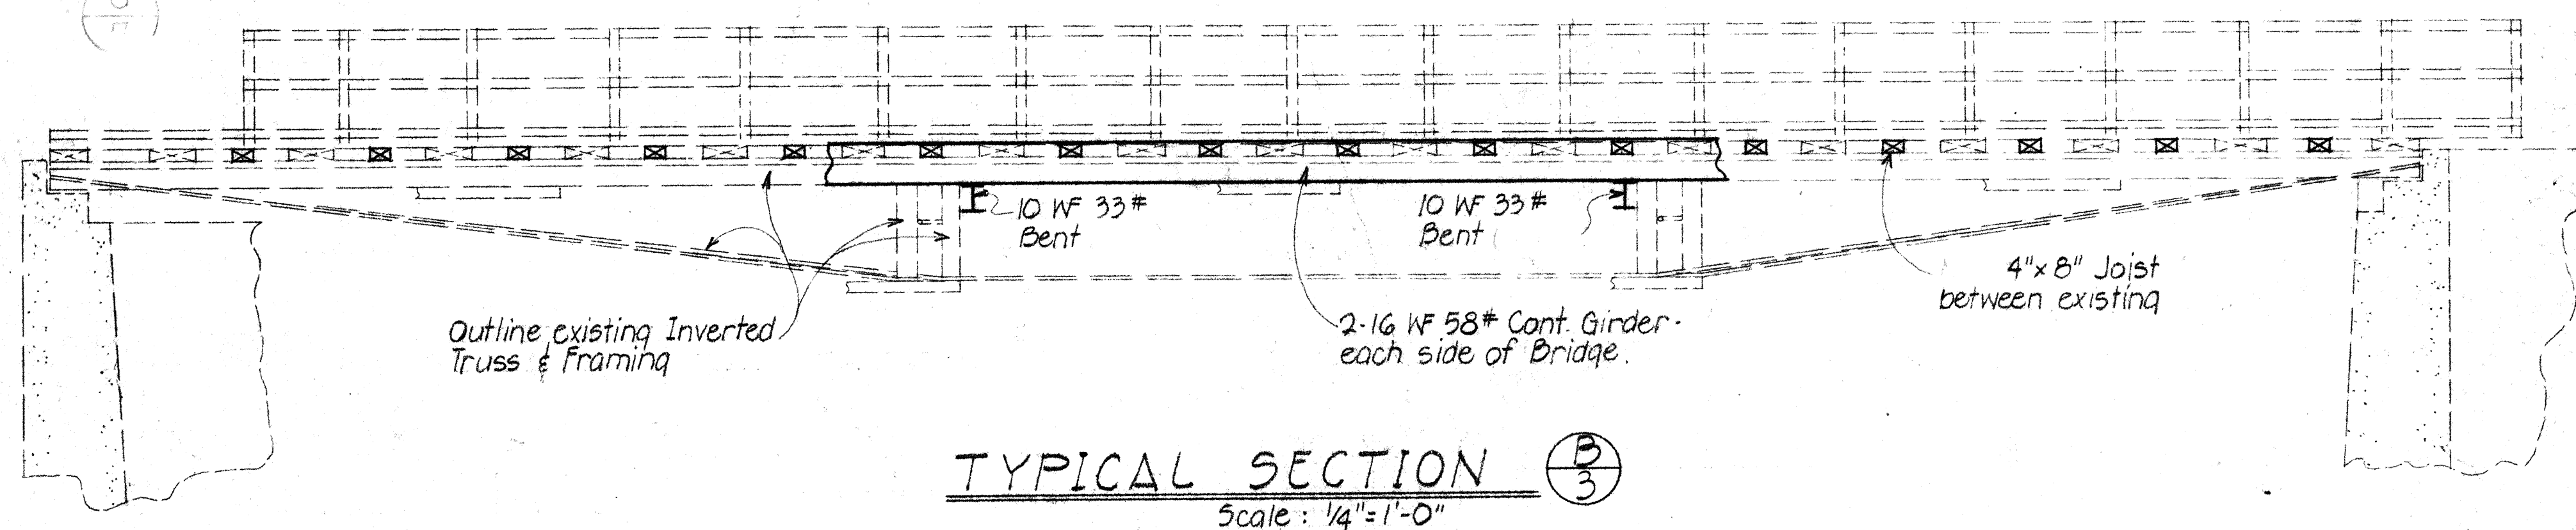


FED. ROAD DIST. NO.	STATE	PROJ. NO.	FISCAL YEAR	SHEET NO.	TOTAL SHEETS
HAWAII	HAW.	HWY-K-03-BBM HWY-K-01-BBM	1980	6	8

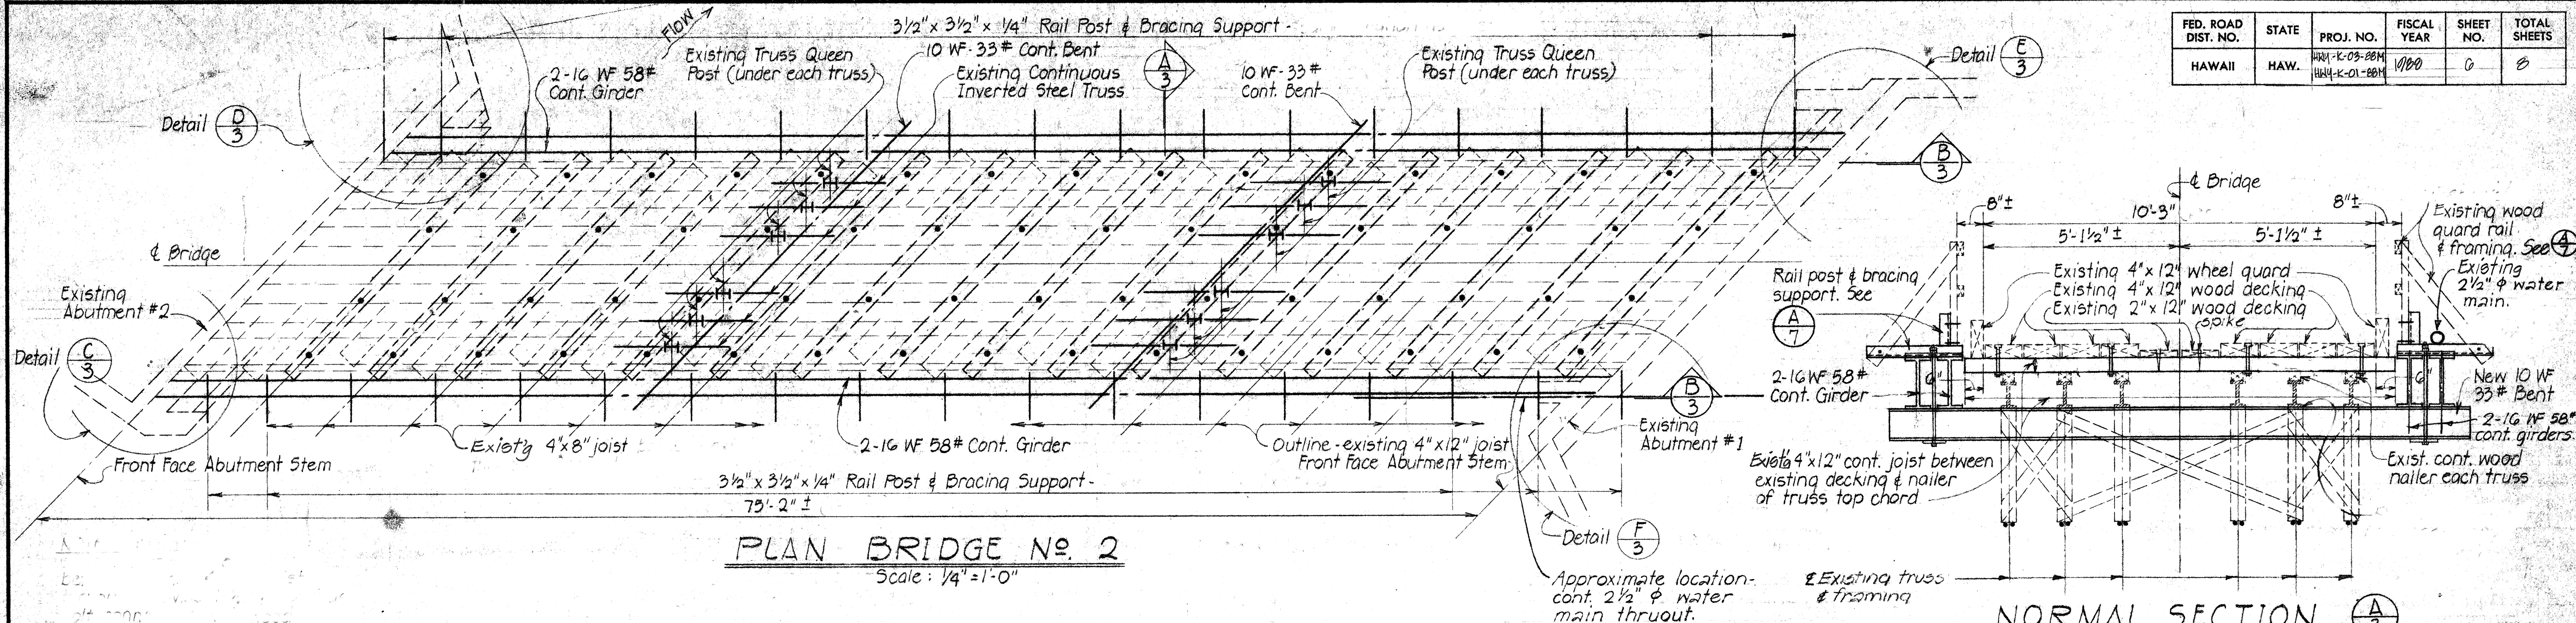

STATE OF HAWAII
DEPARTMENT OF TRANSPORTATION
HIGHWAYS DIVISION
WAINIHA BRIDGE NO. 2
PREPARATION AND PAINTING OF
STEEL SUPERSTRUCTURE
PLAN AND SECTIONS
Project No.: HWY-K-01-B6M APRIL 1966
SHEET No. 1 OF 2 SHEETS