


FED. ROAD DIST. NO.	STATE	PROJ. NO.	FISCAL YEAR	SHEET NO.	TOTAL SHEETS
HAWAII	HAW.	500A-01-99M 500A-01-99M	1099	15	16

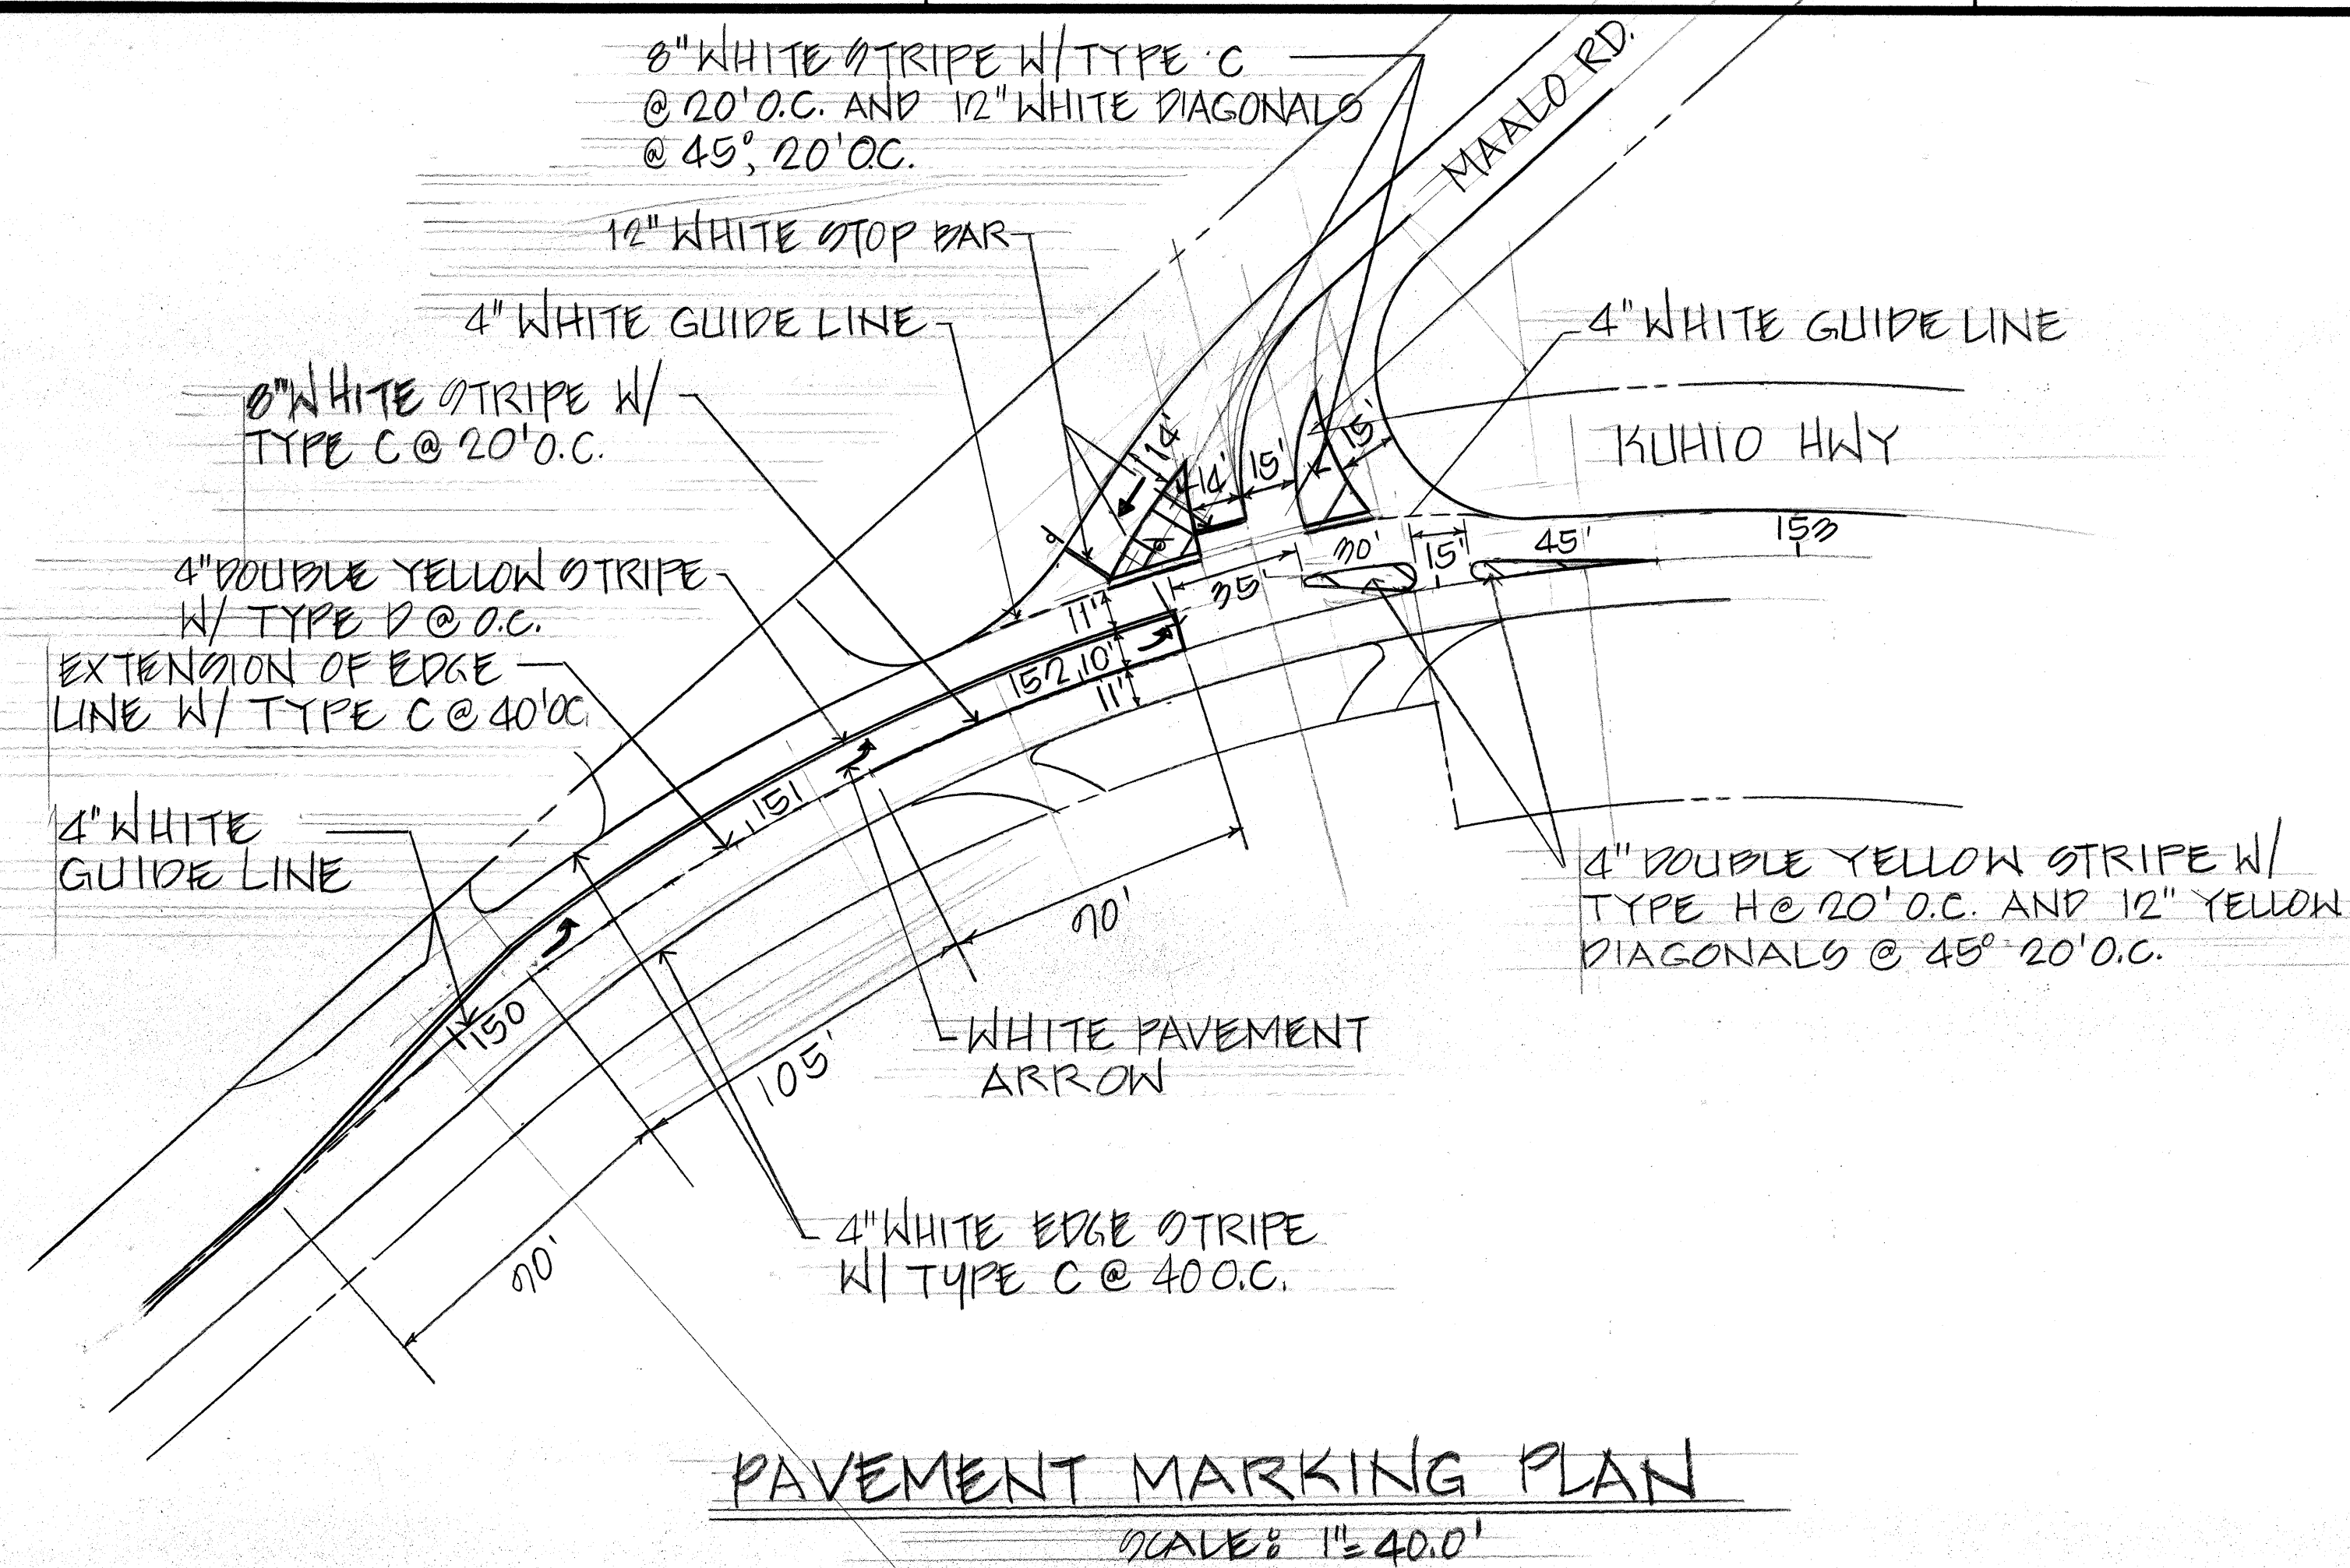

ORIGINAL PLAN	SURVEY PLOTTED BY _____ DATE _____
NOTE BOOK	DRAWN BY _____
	TRACED BY _____
	DESIGNED BY _____
	QUANTITIES BY _____
No. _____	CHECKED BY _____

Details + Summary

STATE OF HAWAII
DEPARTMENT OF TRANSPORTATION
HIGHWAYS DIVISION

PAVEMENT MARKING DETAILS

KUHIO HIGHWAY RESURFACING
PROJECT NO. 50A-01-79M
KIAMOO ROAD RESURFACING
PROJECT NO. 500A-01-79M

SCALE: AS SHOWN MAY 14, 1979

SHEET NO. 1 OF 1 SHEETS