

PAVEMENT MARKING SUMMARY

FED. ROAD DIST. NO.	STATE	PROJ. NO.	FISCAL YEAR	SHEET NO.	TOTAL SHEETS
HAWAII	HAW.	56A-01-93M 580A-01-93M	1993	16	16

	TYPE D	TYPE H	TYPE J	TYPE C	TYPE A	4" YELLOW GUIDE III OR TPE	4" YELLOW DOUBLE I OR TPE	4" YELLOW DOUBLE II OR TPE	12" YELLOW SOLID II OR TPE	4" WHITE EXT-LINE III OR TPE	4" WHITE GUIDE III OR TPE	4" WHITE MISC. I OR TPE	4" WHITE EDGE II OR TPE	8" WHITE SOLID I OR TPE	8" WHITE EDGE II OR TPE	12" WHITE STOP III OR TPE	12" WHITE MISC. II OR TPE	CROSS-WALK III OR TPE	WORDS AND ARROWS III OR TPE	REMARKS
KUHIO HWY.																				
139+90 BEG. PROJECT																				
147+00	65			100	132		1,304						2,608							NO PASS
148+50	5			16	8		110						305	60	125	26			± 6	INTERSECTION
152+00	17			26			355			150	185		480		230				4	NO PASS
154+00	2	15		28		155	105				30				355	30			5	INTERSECTION
158+00	20			20			400								800					NO PASS
160+00	9			5			95	240			200		265		420	40	80			INTERSECTION
179+50	77	39	#2	135	112	20	1,540	800	60	100	100		3,900	50		12	130		2	NO PASS
181+00	3			13									280	60	110	50	40	8	± 4	INTERSECTION
195+50	34	24		54		220	670	560		40		100	1,980	65					4	NO PASS
195+50	3			8			50						200	25		15				INTERSECTION
195+50	32			35			650				50		1,300	80		15		3	2	NO PASS
203+00 END PROJECT																				
SUBTOTAL	267	78	#2	440	#2 252	395	5,279	1,600	60	290	565	100	11,318	340	2,040	188	250	11	± 27	
KUAMOO ROAD																				
106+50																				NO PASS
107+00	6			4			50						100							
108+00	6			13			90						290			25				
116+00	40			40			800			60	30		1,600						±	NO PASS
119+00	19			20			280						600			50				INTERSECTION
127+50	43			43			850			120	60		1,700						±	NO PASS
128+50	6			6			50						200			15				INTERSECTION
133+00	23			24			450						900							NO PASS
134+00	6			6			50						200			20				INTERSECTION
138+50	23			24			450						900							NO PASS
139+50	23			24			50						200			20				INTERSECTION
140+50	5			6			100						200							NO PASS
141+50	6			6			60						200			15				INTERSECTION
156+50	75			76			1,500			120	60		3,000						±	NO PASS
157+50	6			5			50						200			12				INTERSECTION
167+00	48			50			920						1,840							NO PASS
170+00	20			29			350						830			70	400	2	2	INTERSECTION
171+50	8			8			150						300							NO PASS
173+50	9			20			175			100			510						2	INTERSECTION
179+50	30			30			600						1,200							NO PASS
180+50	6			6			50						200							INTERSECTION
182+50	10			10			200						400						1	NO PASS
184+00=0+00 EQN. STA.	8			10			125						300			20			1	INTERSECTION
57+50	288			288			5,750			370	120	100	9,130	2,120	250					NO PASS
58+50	6			6			50								120	70			±	INTERSECTION
59+50	5			6			100								200					NO PASS
60+50	6			6			50								130	40				INTERSECTION
66+96	33			34			650						300		1,020					NO PASS
SUBTOTAL	764			800			14,000			470	420	250	25,300	2,120	1,720	357	400	2	± 6	
TOTAL	1,031 EACH	78 EACH	#2 EACH	1,240 EACH	#2 252 EACH	395 L. F.	19,279 L. F.	1,600 L. F.	60 L. F.	760 L. F.	985 L. F.	350 L. F.	36,618 L. F.	2,460 L. F.	3,760 L. F.	545 L. F.	650 L. F.	13 LANES	± 33 EACH	

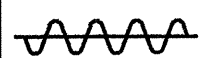
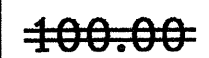
LEGEND:

- I = Tape, Type I
II = Tape, Type II
III = Tape, Type III
TPE = Thermoplastic Extrusion

NOTES:

1. Tape, Type I or Thermoplastic Extrusion (No Passing Zones, Channelizing Lines or Solid Lines)
2. Tape, Type II or Thermoplastic Extrusion (Transverse Median Markings, Transverse Shoulder Markings, Channelizing Islands or Edg
3. Tape, Type III or Thermoplastic Extrusion (Guide Lines, Stop Lines, Extension of Edge Lines, Crosswalk Markings, Pavement Words or Pavement Arrows)
4. Equation Station = Sta. 184+00 Proj. No. 580A-01-70 = Sta. 0+00 Proj. No. A-58

ORIGINAL PLAN	SURVEY PLOTTED BY	DATE
NOTE BOOK	DRAWN BY	
4kmsdms	TRACED BY	
	QUANTITIES BY	
	CHECKED BY	

LEGEND FOR AS-BUILT POSTINGS	
	Squiggly line for as-built deletion
	Double line for as-built deletion
Roadway	Text for as-built posting

STATE OF HAWAII DEPARTMENT OF TRANSPORTATION HIGHWAYS DIVISION
PAVEMENT MARKING SUMMARY
KUHIO HIGHWAY RESURFACING PROJECT NO. 56A-01-93M KUAMOO ROAD RESURFACING PROJECT NO. 580A-01-93M
Date: June 2, 1993
SHEET No. 1 OF 1 SHEETS