

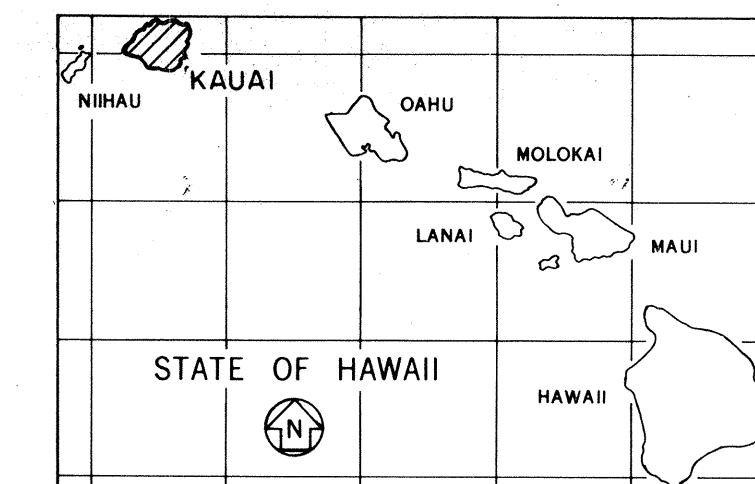
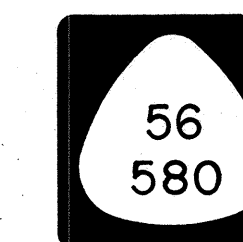
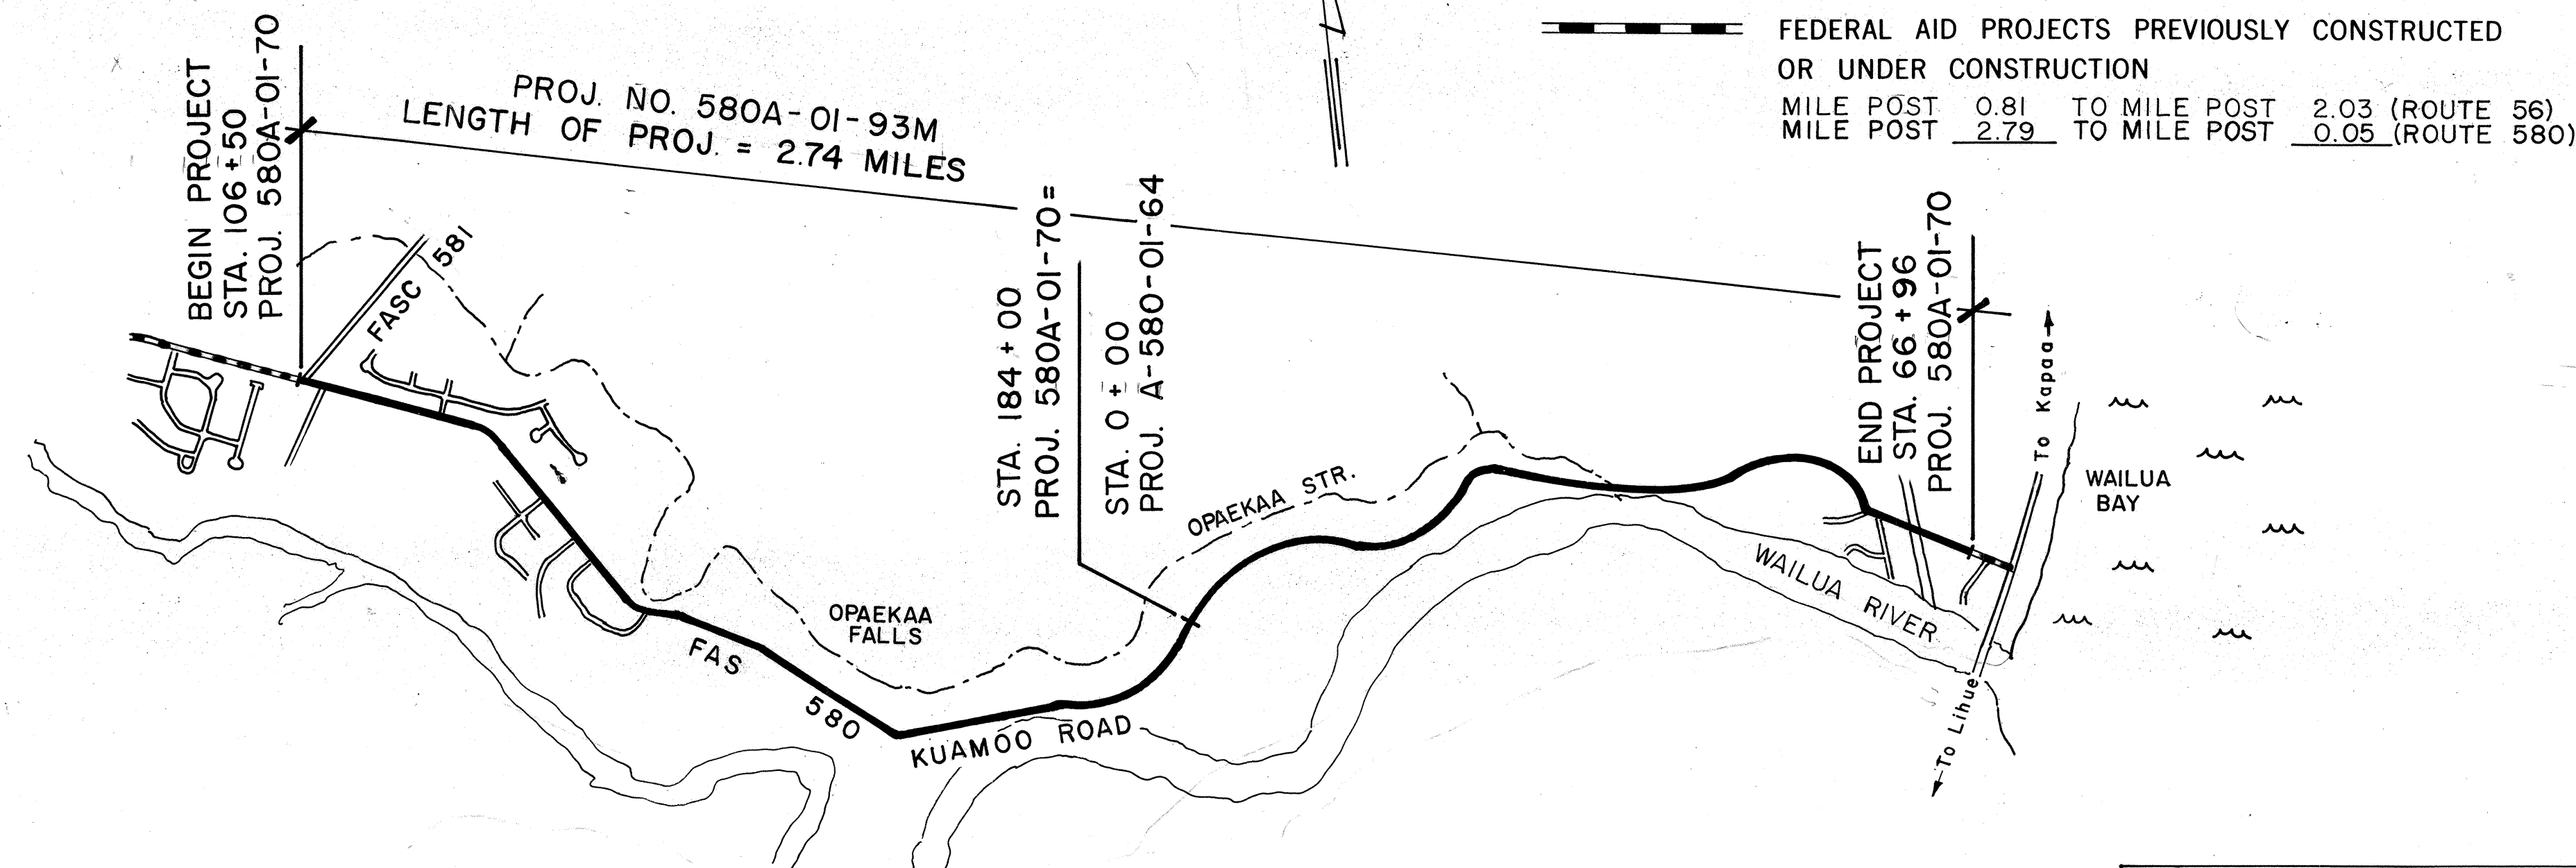


[illegible]

FED. ROAD DIST. NO.	STATE	PROJ. NO.	FISCAL YEAR	SHEET NO.	TOTAL SHEETS
HAWAII	HAW.	56A-01-93M 580A-01-93M	1993	1	16

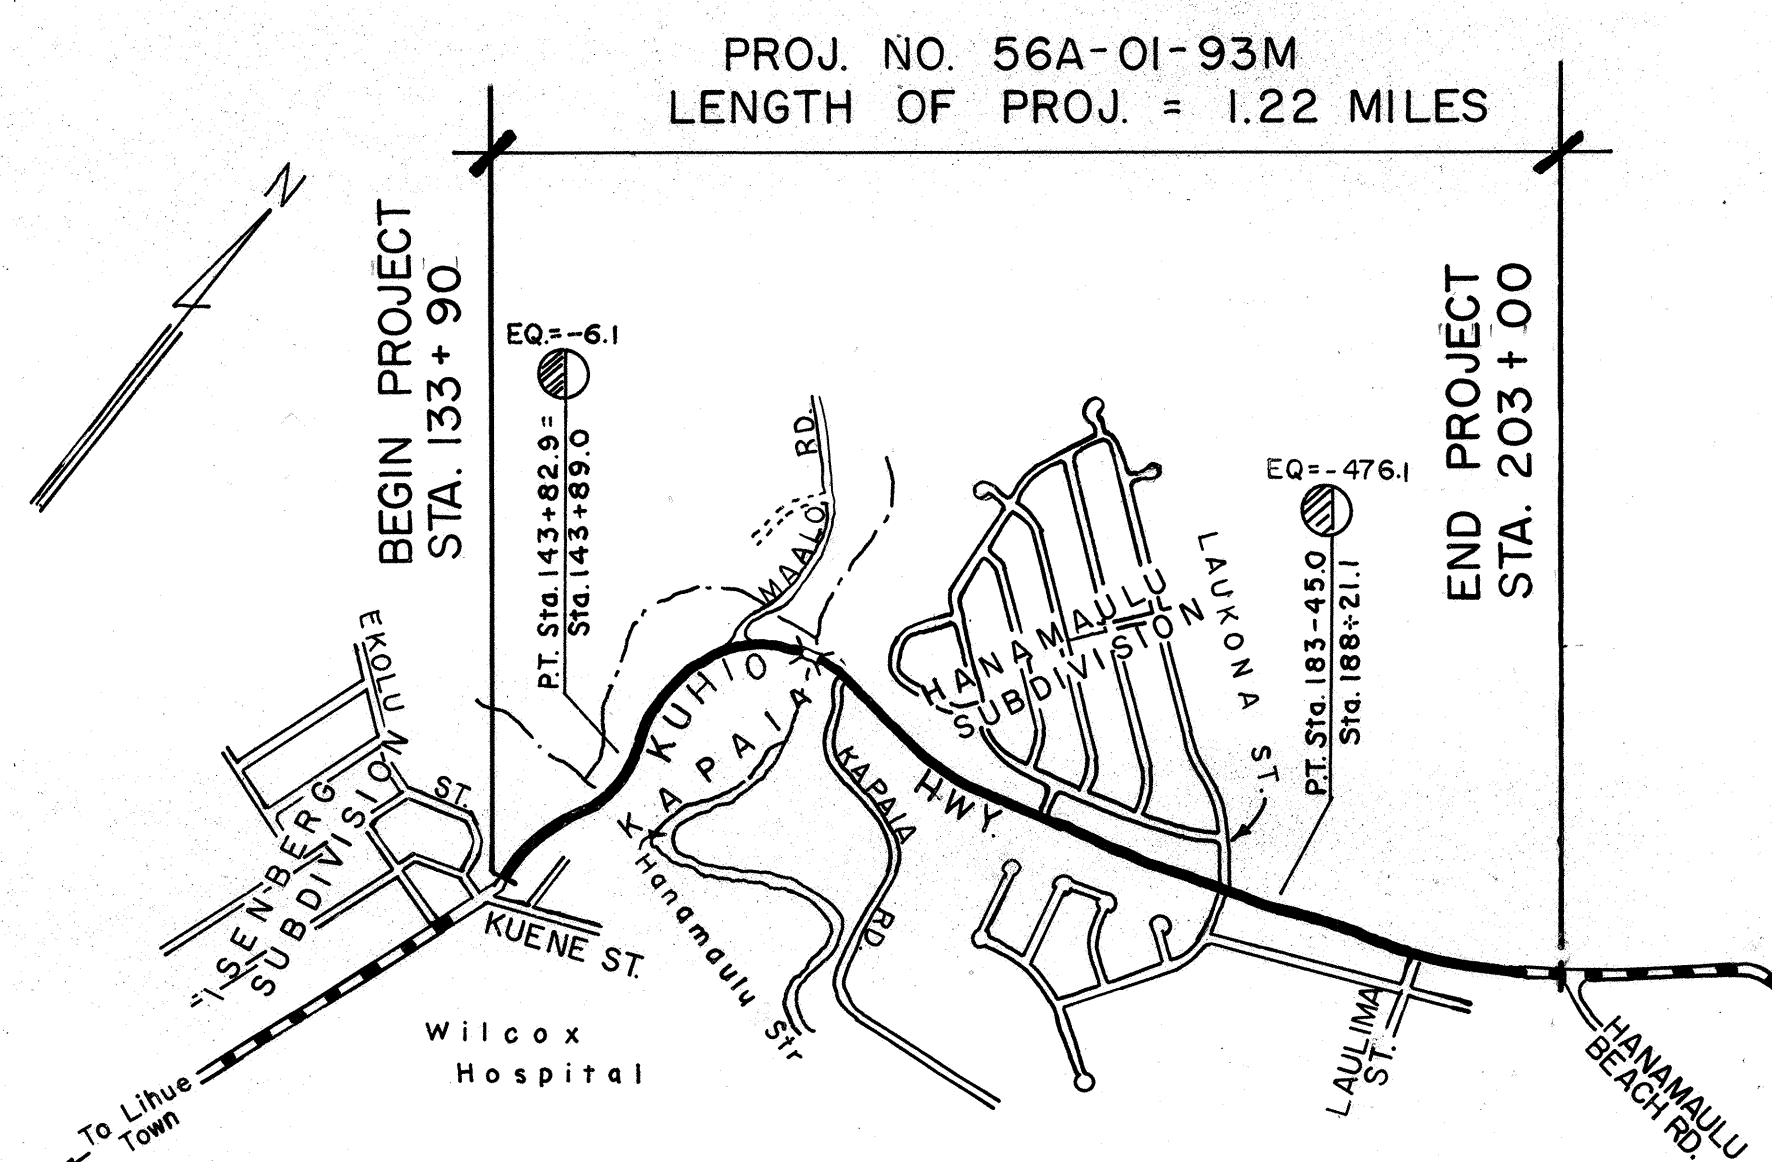

STATE OF HAWAII
DEPARTMENT OF TRANSPORTATION
HIGHWAYS DIVISION
HONOLULU, HAWAII
"AS-BUILT"
PLANS FOR
KUHIO HIGHWAY RESURFACING
KUENE STREET TO HANAMAULU ROAD
PROJECT NO. 56A - 01 - 93M
AND
KUAMOO ROAD RESURFACING
KUHIO HIGHWAY TO KAMALU ROAD
PROJECT NO. 580A - 01 - 93M
DISTRICT OF LIHUE
AND KAWAIHAU
ISLAND OF KAUAI

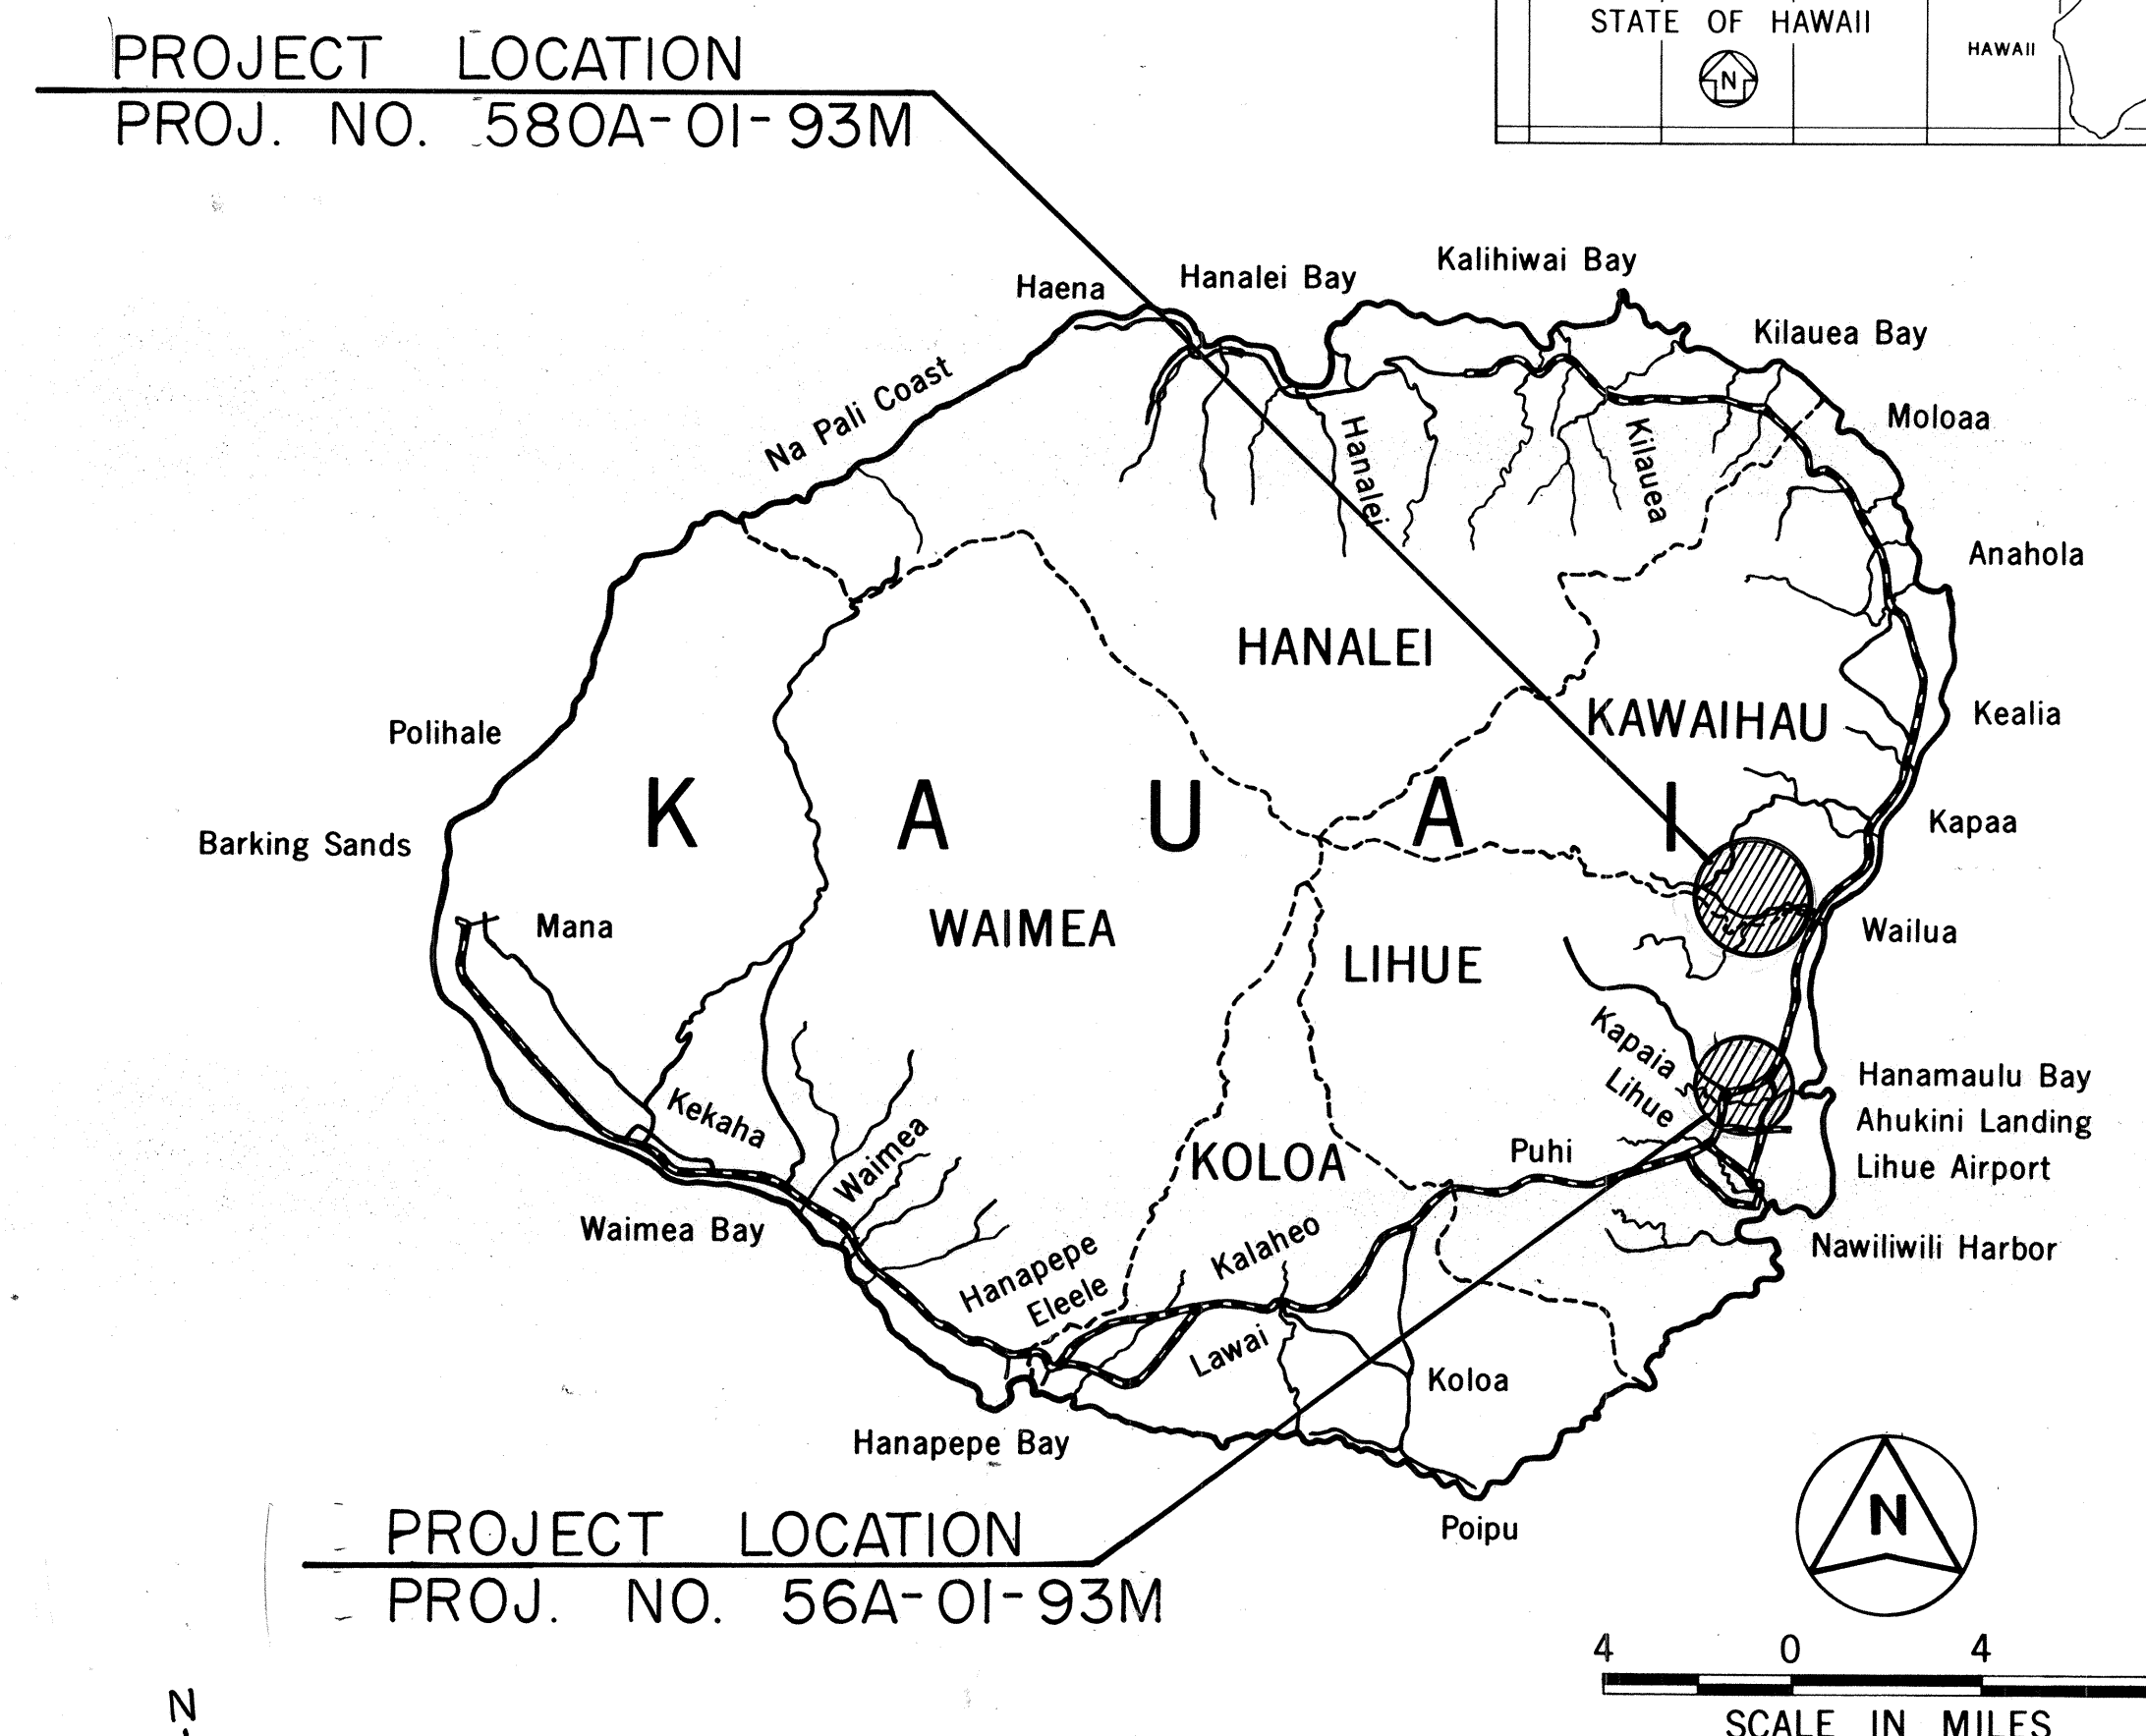

LAYOUT OF PROJECTS

Scale: 1" = 1000'

KUHIO HIGHWAY TO KAMALU ROAD

CHANGES MADE DURING CONSTRUCTION HAVE
BEEN NOTED ON THESE PLANS AND CHECKED BY:

D. Maeda by: 
RESIDENT ENGINEER

7-30-97
DATE

DEPARTMENT OF TRANSPORTATION
STATE OF HAWAII

APPROVED: _____

J. Harano 6/2/9

J. Harano DEPT. OF TRANSPORTATION DATE

DESIGNED BY HWY - K JULIUS FRONDA 587-2246 MAY, 1993
P. S. & E. BY PHONE DATE