

| INDEX TO DRAWINGS |                          |
|-------------------|--------------------------|
| SHEET NO.         | DESCRIPTION              |
| 1                 | TITLE SHEET              |
| 2                 | TYPICAL SECTION          |
| 3                 | PROJECT INFORMATION SIGN |
|                   |                          |
|                   |                          |
STATE OF HAWAII  
DEPARTMENT OF TRANSPORTATION  
HIGHWAYS DIVISION

"AS BUILT"  
PLANS FOR

INITIAL IMPROVEMENTS PROGRAM PLAN


RECONSTRUCTION AND RESURFACING  
WAIMEA CANYON DRIVE (PHASE 2)

AND

RECONSTRUCTION AND RESURFACING  
MAALO ROAD - WAILUA FALLS ROAD (PHASE 2)  
PROJECT NO. HWY-K-OI-70

DISTRICTS OF WAIMEA AND LIHUE

| DIST. NO. | STATE | PROJ. NO.   | FISCAL YEAR | SHEET NO. | TOTAL SHEETS |
|-----------|-------|-------------|-------------|-----------|--------------|
| HAWAII    | HAW.  | HWY-K-OI-70 | 1970        | 1         | 3            |

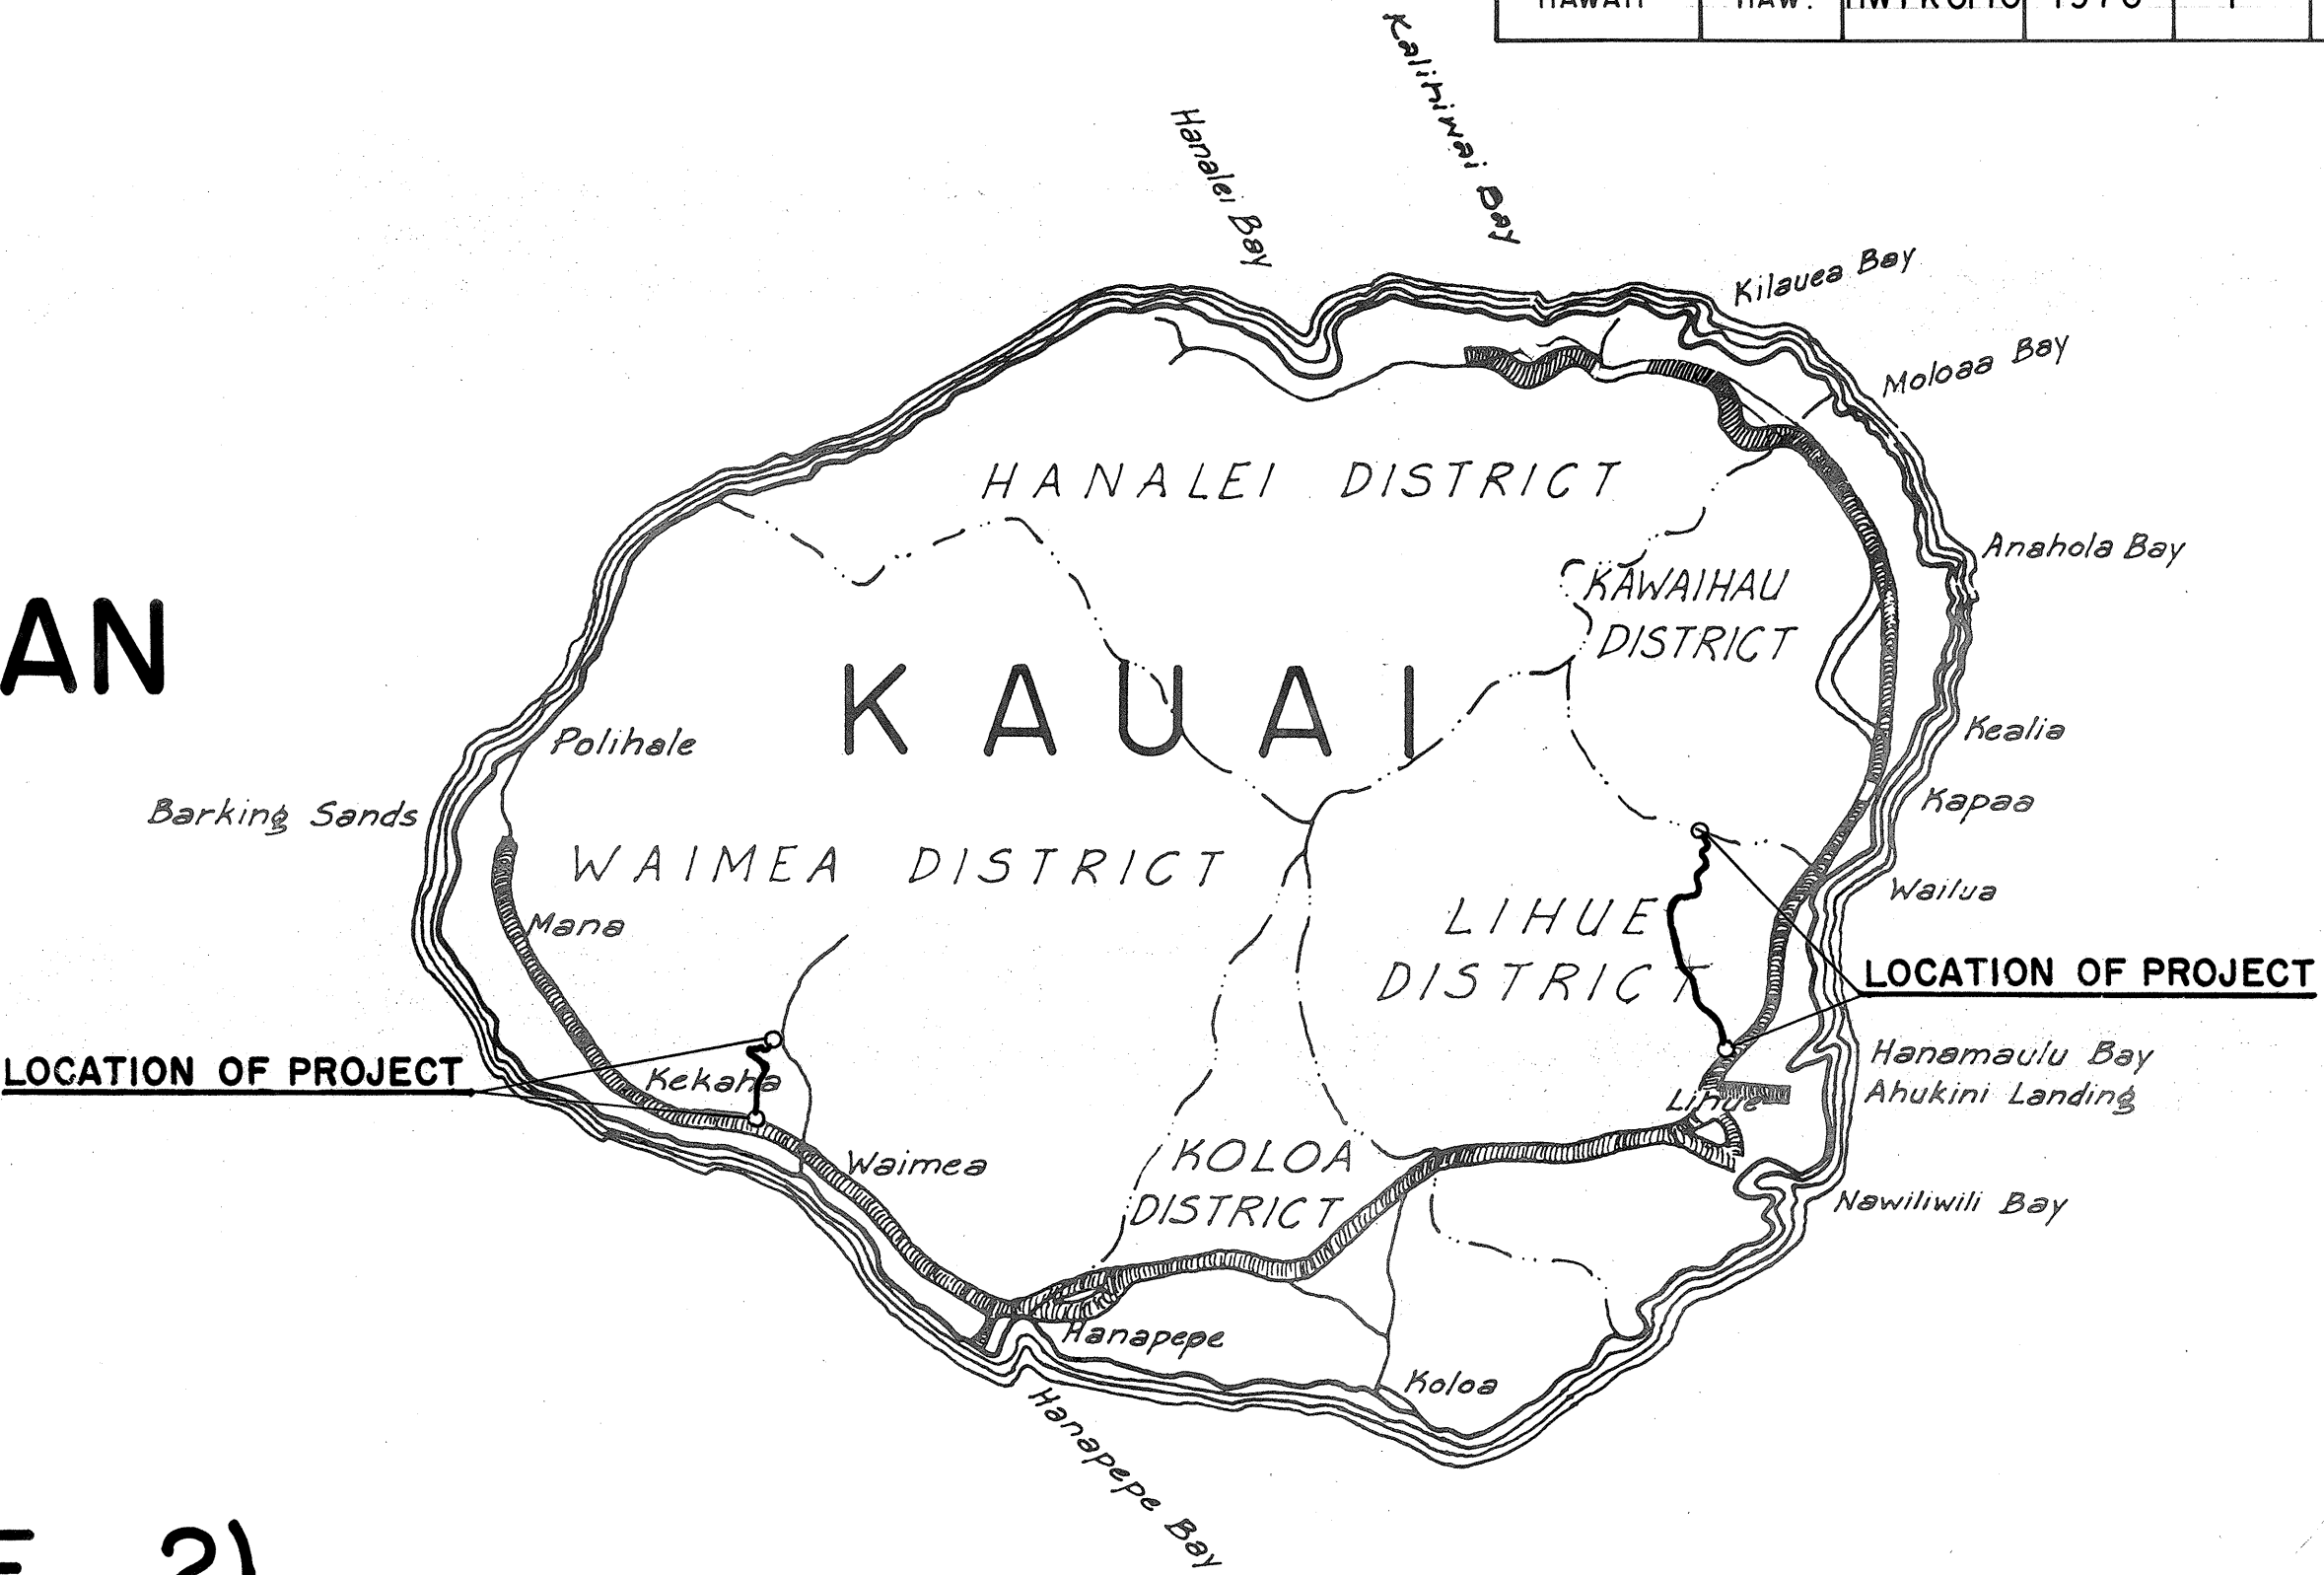

FEDERAL AID PROJECTS PREVIOUSLY CONSTRUCTED OR UNDER CONSTRUCTION



MAR. 1970  
Date

Phone- Loc.

D. BEVIER  
PS&E By

Kauai District  
Designed By

|                       |  |
|-----------------------|--|
| DATE                  |  |
| SURVEY PLOTTED BY     |  |
| DESIGNED BY           |  |
| DRAWN BY              |  |
| CHECKED BY            |  |
| NOTE BOOK             |  |
| QUANTITIES CHECKED BY |  |
|                       |  |
|                       |  |
|                       |  |

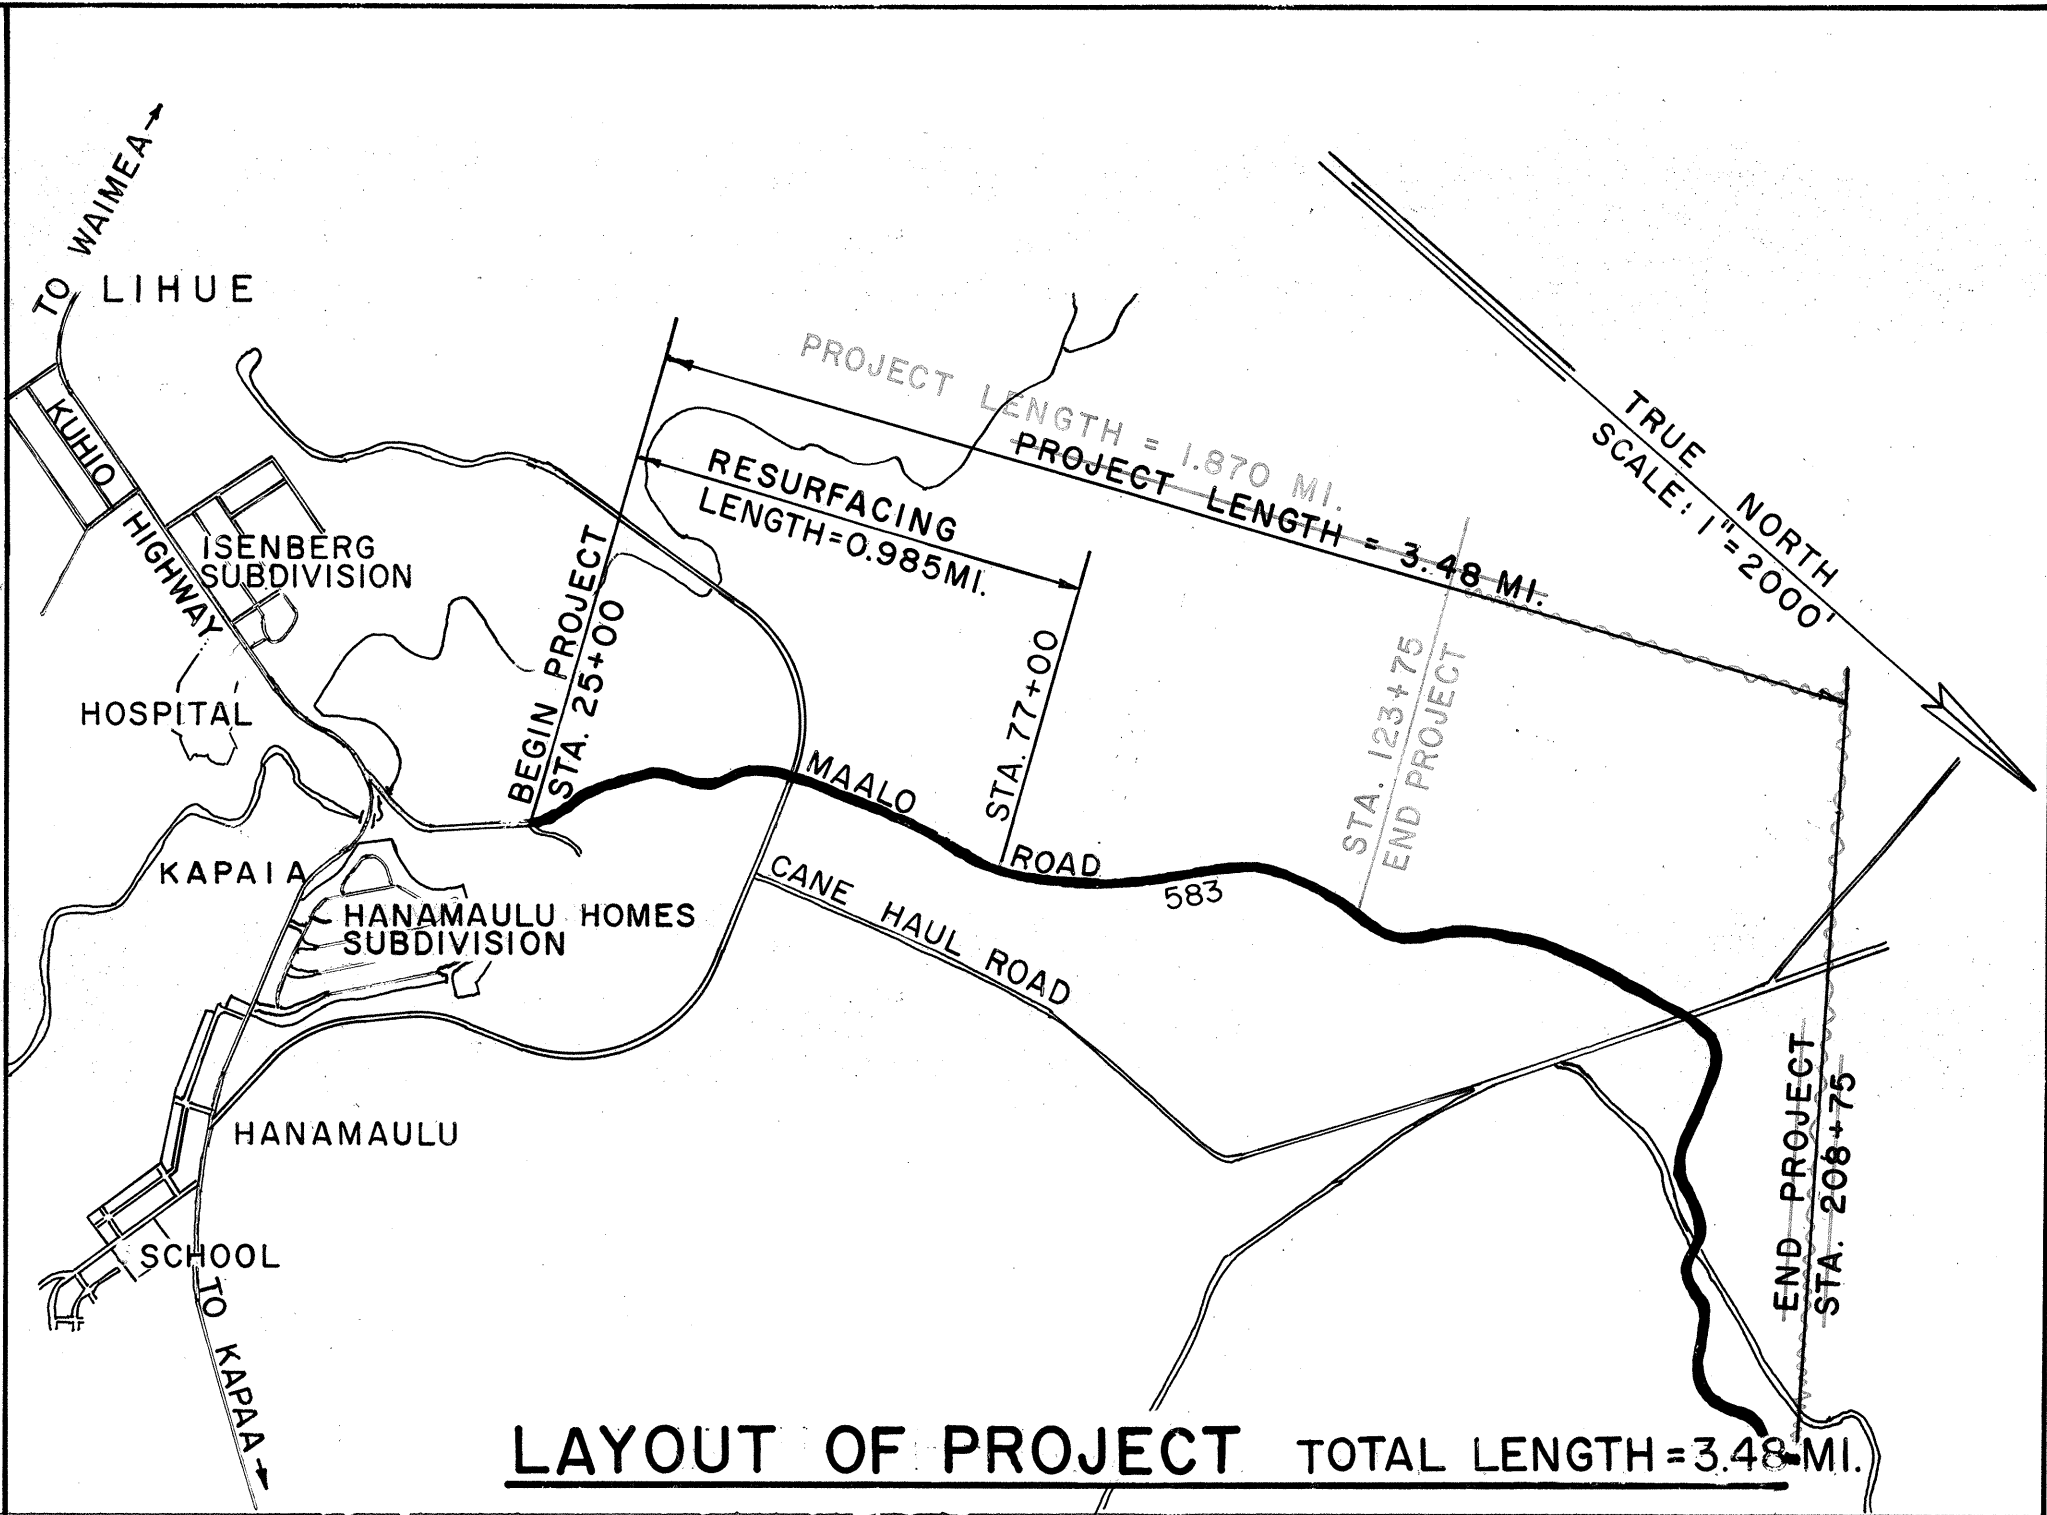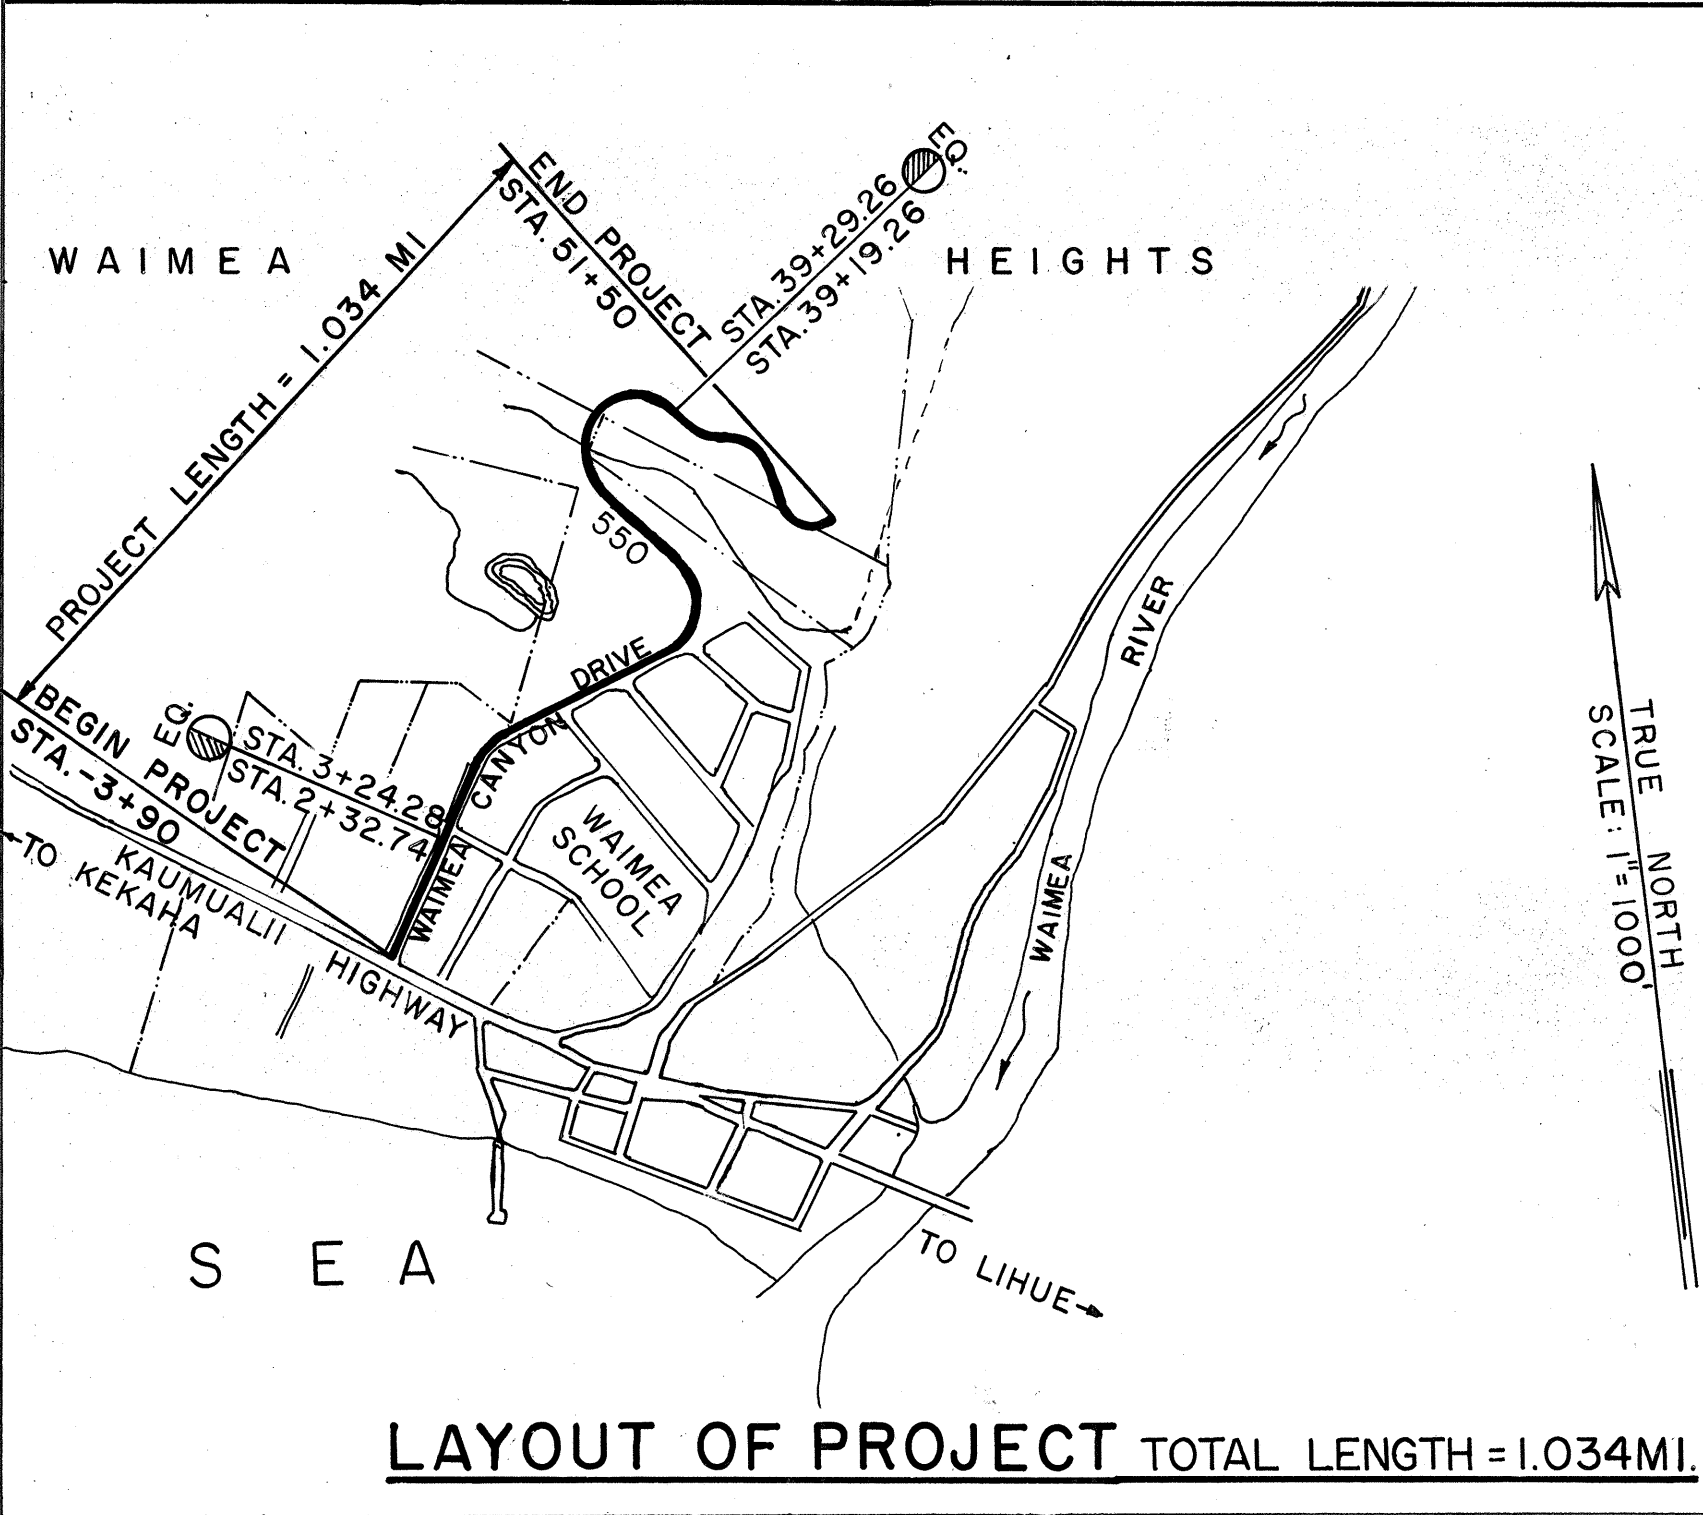

NOTE:  
ALL CHANGES MADE DURING CONSTRUCTION  
HAVE BEEN INCORPORATED ON THESE  
PLANS IN RED EXCEPT CHANGES IN THE  
ORIGINAL THEORETICAL QUANTITIES.

Donald Nagamine  
PROJECT ENGINEER  
8-11-81  
DATE

|   |         |
|---|---------|
| DEPARTMENT OF TRANSPORTATION<br>STATE OF HAWAII |         |
| APPROVED:                                       |         |
| E. Alvey Knight                                 | 3/18/70 |
| DIR. OF TRANSPORTATION                          | DATE    |