	INDEX TO DRAWINGS
SHEET NO.	DESCRIPTION
1	TITLE SHEET
2	INDEX TO DRAWINGS
3	STANDARD PLANS SUMMARY
4-7	NOTES
8	ABBREVIATIONS AND LEGEND
9-10	GENERAL PLANS
11	CURB RAMP NOTES
12-16	CURB RAMP DETAILS
17	TYPICAL DETAILS
18-19	SIDEWALK DETAILS
20	CURB RAMP STRIPING DETAILS
21	PEDESTRIAN PUSH BUTTON DETAILS
22-25	MISCELLANEOUS DETAILS
26-73	CURB RAMP PLANS
74-79	TYPICAL TRAFFIC CONTROL PLANS
80-81	CALL BOX GENERAL NOTES
82-85	CALL BOX LOCATION MAPS
86-88	CALL BOX TYPICAL AND MISCELLANEOUS DETAILS
89-99	CALL BOX SITE AND GRADING PLANS
100	CALL BOX TRAFFIC CONTROL PLANS AND NOTES

STATE OF HAWAI'I DEPARTMENT OF TRANSPORTATION


HIGHWAYS DIVISION HONOLULU, HAWAI'I

"AS-BUILT"

PLANS FOR

PEDESTRIAN FACILITIES AND ADA COMPLIANCE AT VARIOUS LOCATIONS ON KAUA'I FEDERAL AID PROJECT NO. CMAQ-0700(50) R


DISTRICTS OF WAIMEA, KŌLOA, LĪHU'E AND KAWAIHAU

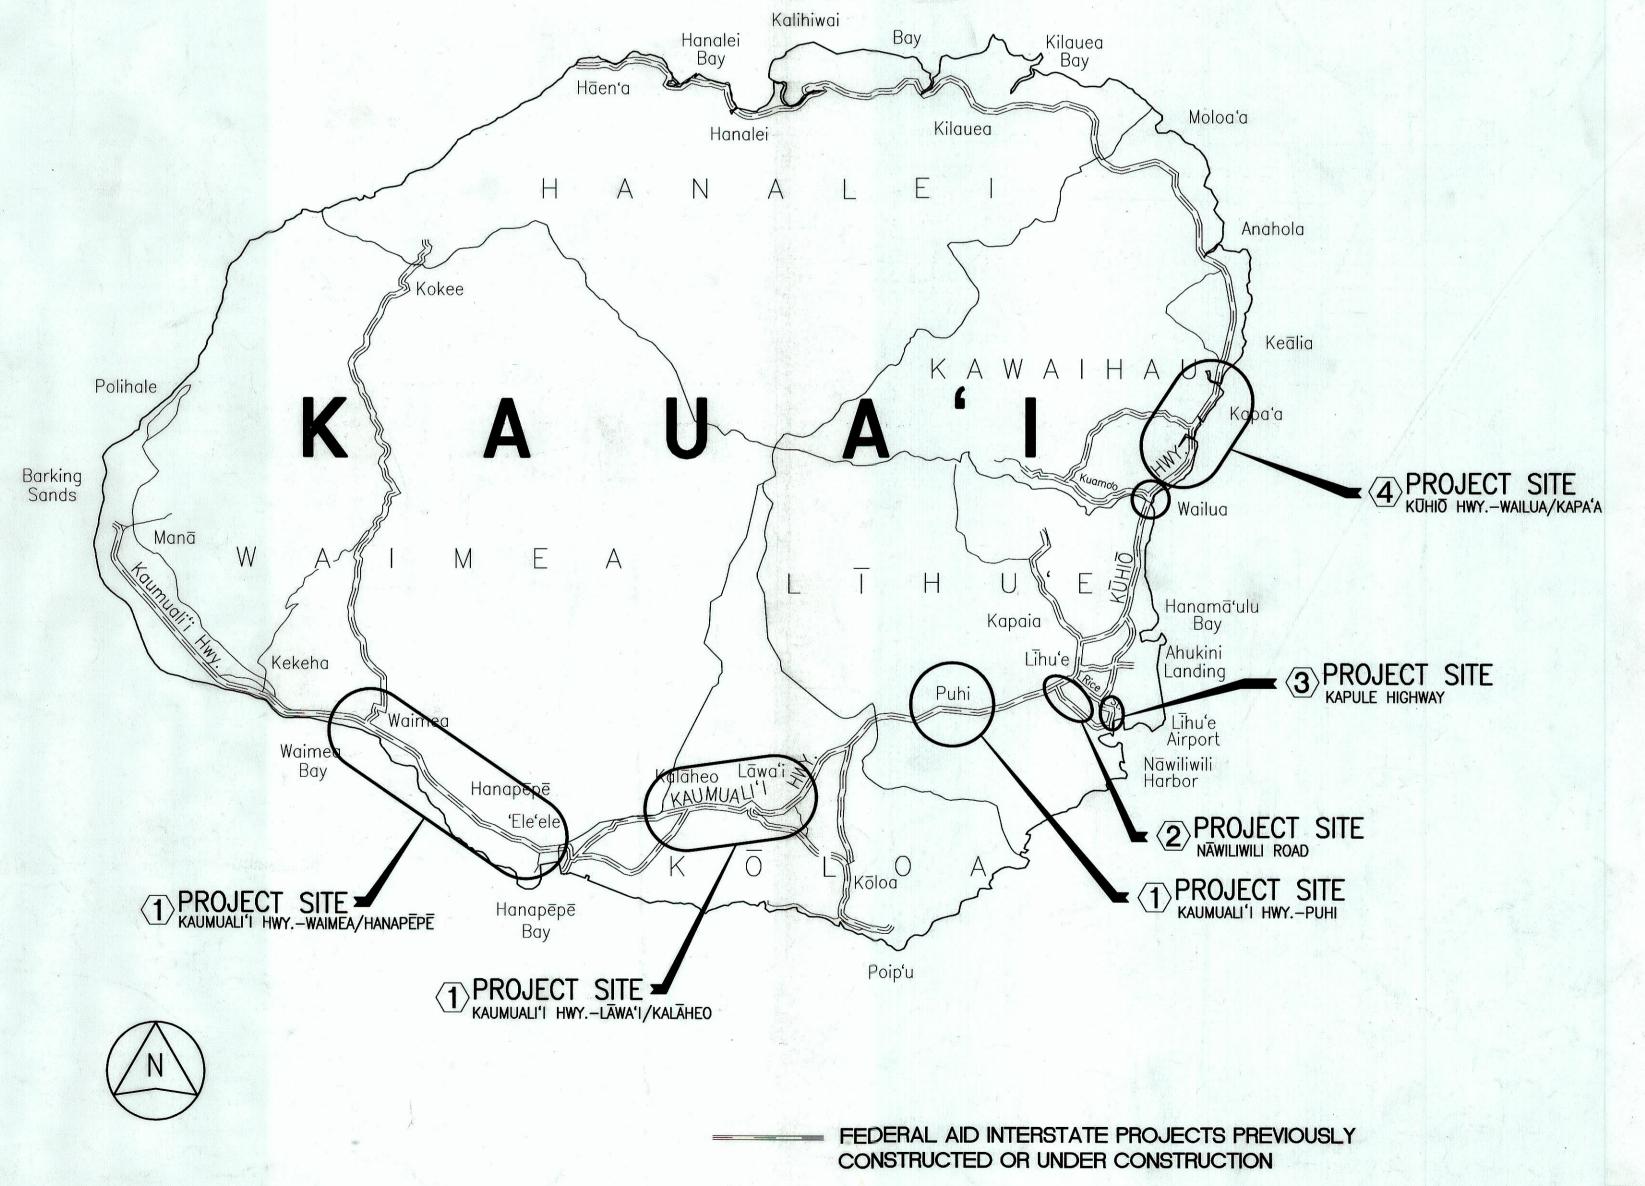


FED. ROAD DIST. NO. STATE FED. AID PROJ. NO. FISCAL SHEET NO. SHEETS

HAWAI'I HAW. CMAQ-0700(50) R 2004 1 100



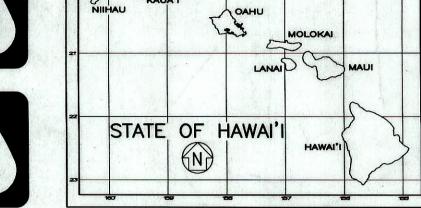



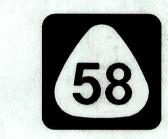



PROJECT SITES

- 1 Kaumuali'i Hwy. Route 50 MILE POST 23.20 TO MILE POST 1.53
- 2 Nāwiliwili Road Route 58
 MILE POST 2.06 TO MILE POST 1.64
- 3 Kapule Hwy. Route 51
 MILE POST 0.0 TO MILE POST 0.33
- 4 Kūhiō Hwy. Route 56
 MILE POST 0.13 TO MILE POST 8.47

CHANGES MADE DURING CONSTRUCTION HAVE BEEN INCORPORATED ON THESE PLANS EXCEPT CHANGES IN THE ORIGINAL THEORETICAL QUANTITIES. FOR ACTUAL QUANTITIES, REFER TO PROJECT LEDGER AND/OR COMPUTATION BOOK.



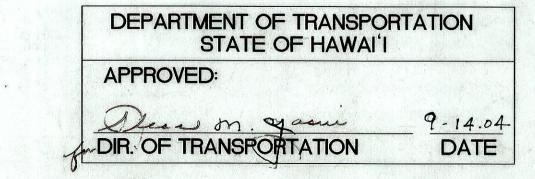

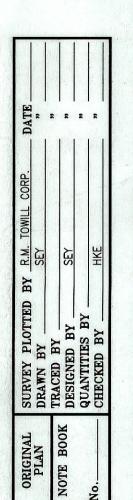

HWY-DS MANAGED BY