


INDEX TO DRAWINGS	
SHEET NO.	DESCRIPTION
1	TITLE SHEET
2	STANDARD PLANS SUMMARY
3	GENERAL NOTES & LEGEND
4 - 5	WATER POLLUTION AND EROSION CONTROL NOTES
6 - 11	ROADWAY PLAN - KUHIO HIGHWAY
12 - 13	ROADWAY PLAN - KUAMOO ROAD
14 - 18	ROADWAY PLAN - KOKEE ROAD
19 - 20	DRAINAGE DETAILS
21	GUARDRAIL DETAILS & NOTES
22	STRONG POST W-BEAM GUARDRAIL
23 - 24	MODIFIED TYPE "A-1" DETAILS & NOTES
25	FLEAT-350 DETAILS & NOTES
26	TYPE "G" TERMINAL END
27	STRONG POST MODIFIED THRIE BEAM GUARDRAIL
28	THRIE BEAM INSTALLATION
29	GUARDRAIL DETAILS AT OBSTRUCTION
30	A.C. PAVEMENT UNDER FLEAT-350
31	PORTABLE PHYSICAL BARRIER
32	HIGH SPEED UNDIVIDED HIGHWAY WORK ZONE SIGNING PLAN, DETAILS & NOTES


STATE OF HAWAII  
DEPARTMENT OF TRANSPORTATION  
HIGHWAYS DIVISION  
HONOLULU, HAWAII

**"AS-BUILT" PLANS FOR**  
**KUHIO HIGHWAY, KUAMOO ROAD AND KOKEE ROAD**  
**GUARDRAIL AND SHOULDER IMPROVEMENTS**  
**AT VARIOUS LOCATIONS**  
**FEDERAL-AID PROJECT NO. STP-0700(58)**  
DISTRICTS OF WAIMEA, LIHUE, KAWAIHAU AND HANAIEI  
ISLAND OF KAUAI

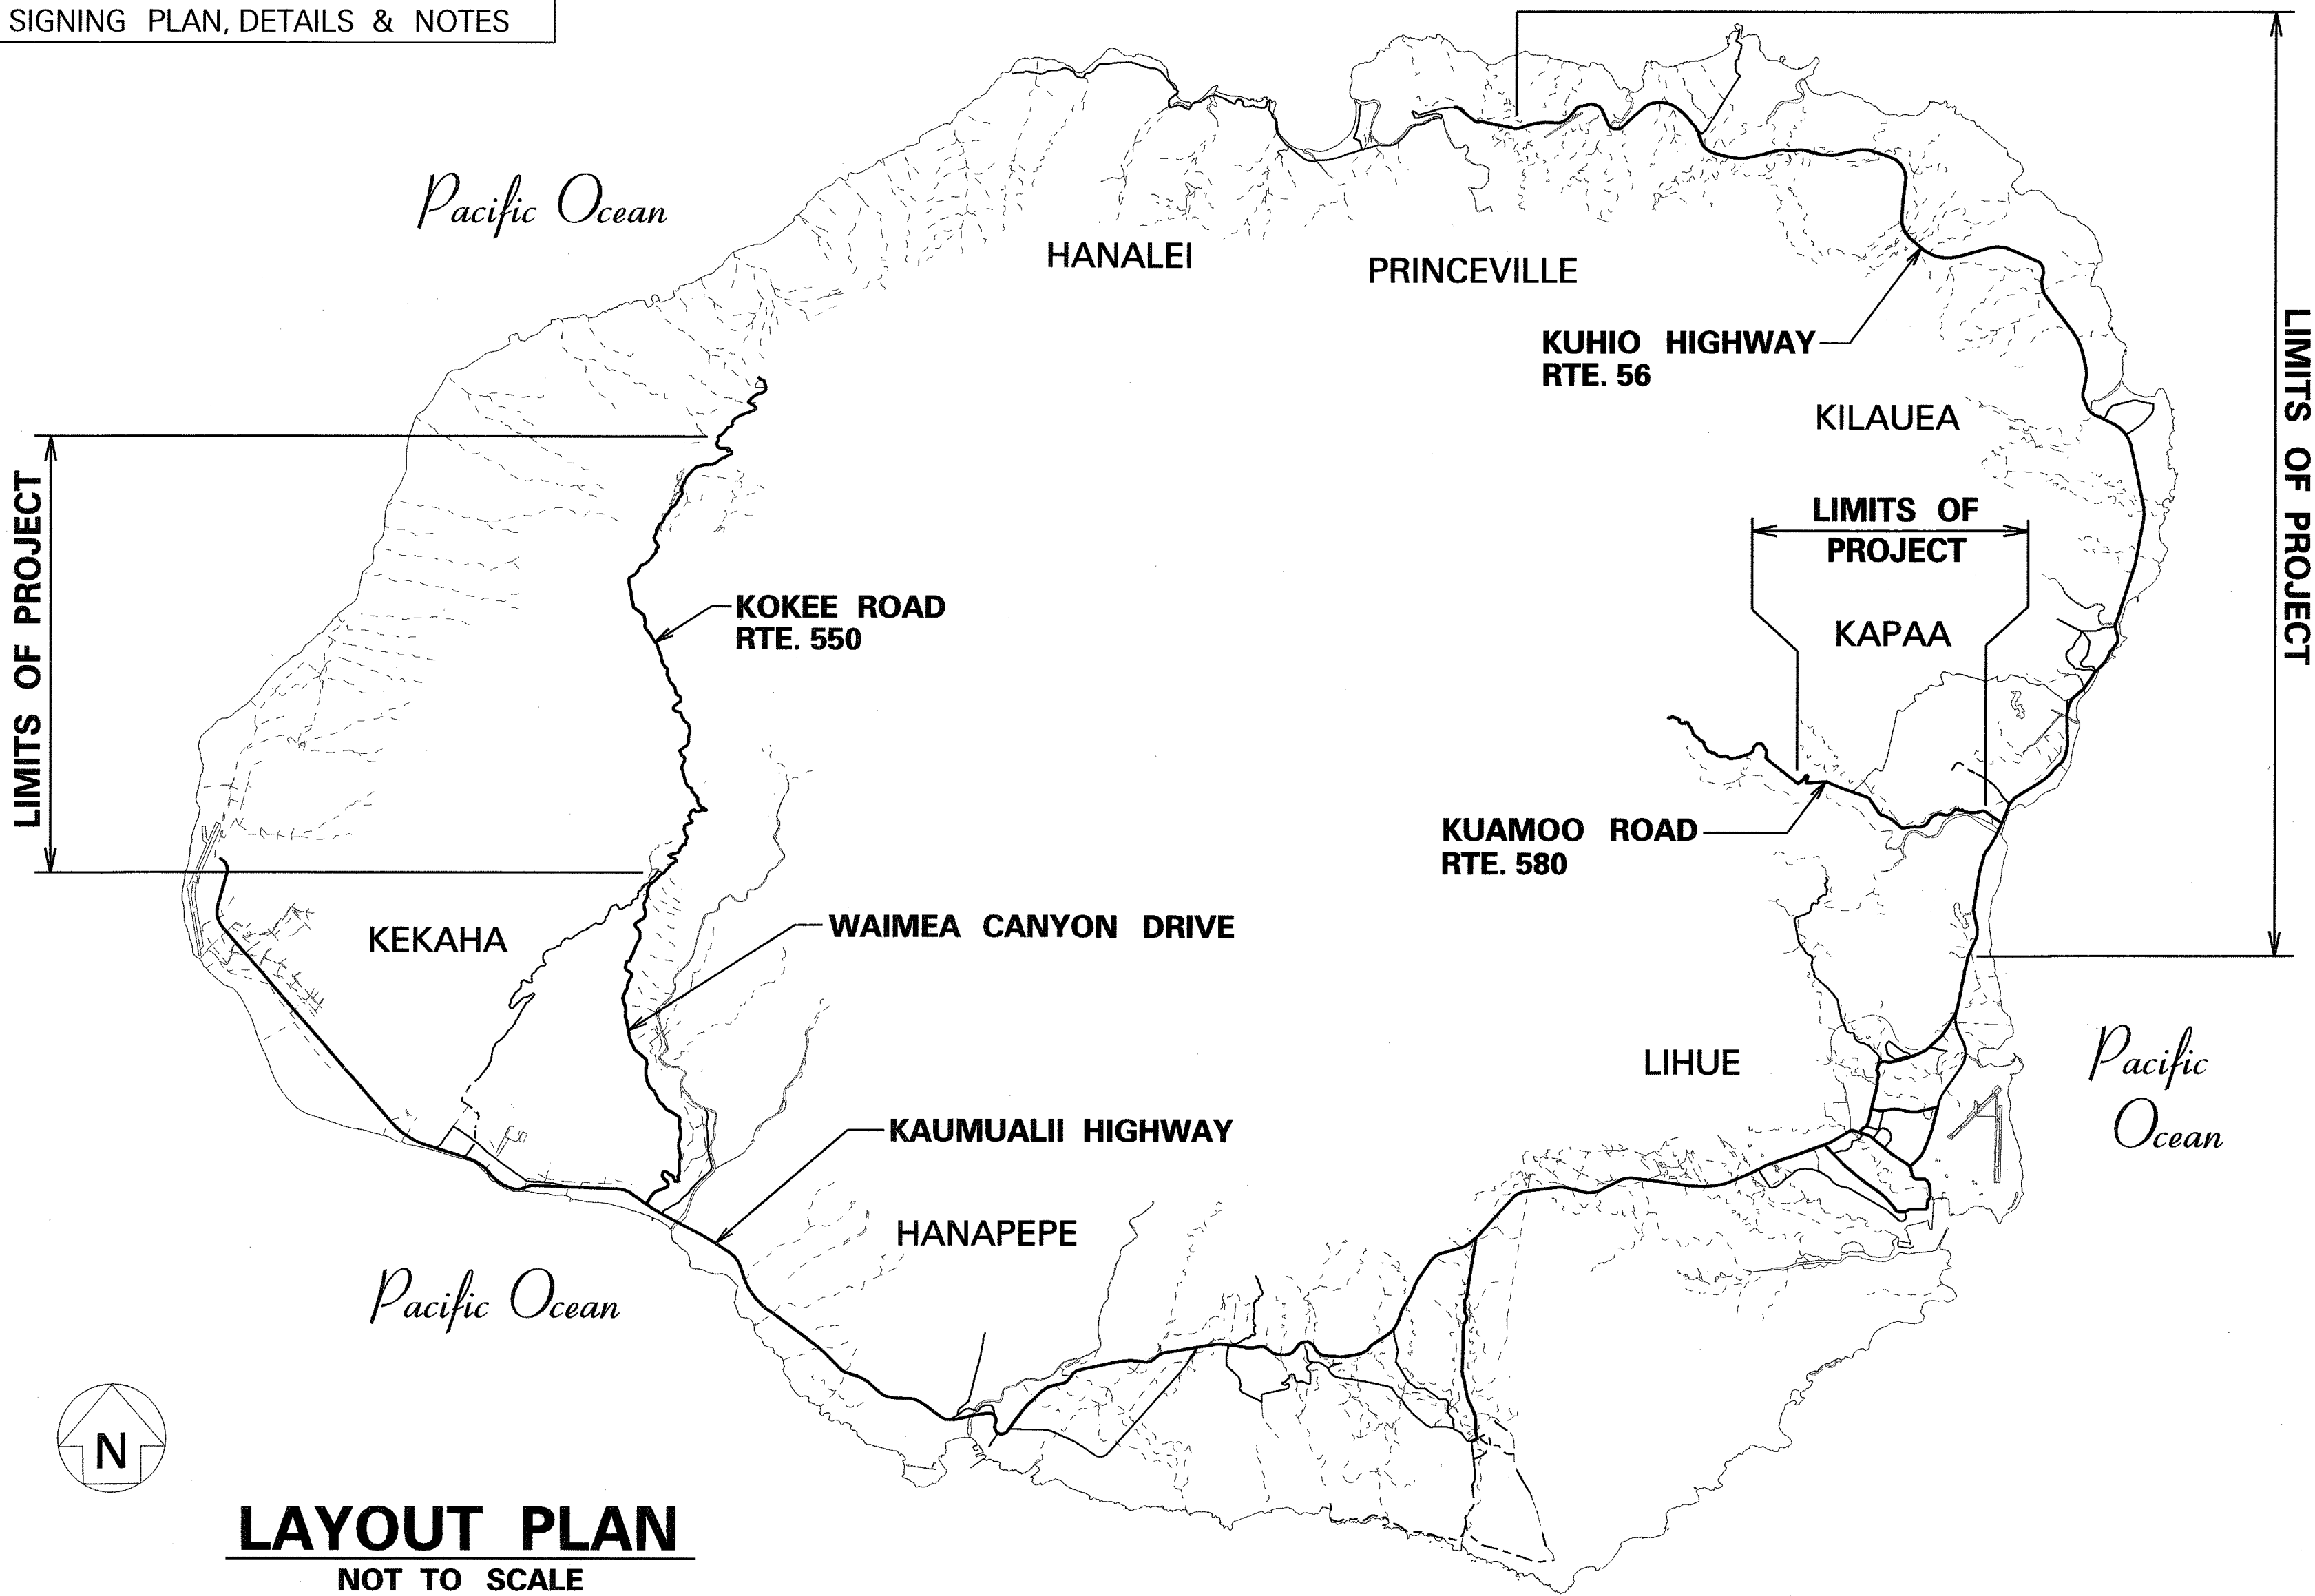

DESIGNED BY  
HWY-K  
MANAGED BY  
HWY-KE  
PHONE 241-3016  
DATE JULY 2006

FED. ROAD DIST. NO.	STATE	FED. AID PROJ. NO.	FISCAL YEAR	SHEET NO.	TOTAL SHEETS
HAWAII	HAW.	STP-0700(58)	2006	1	32

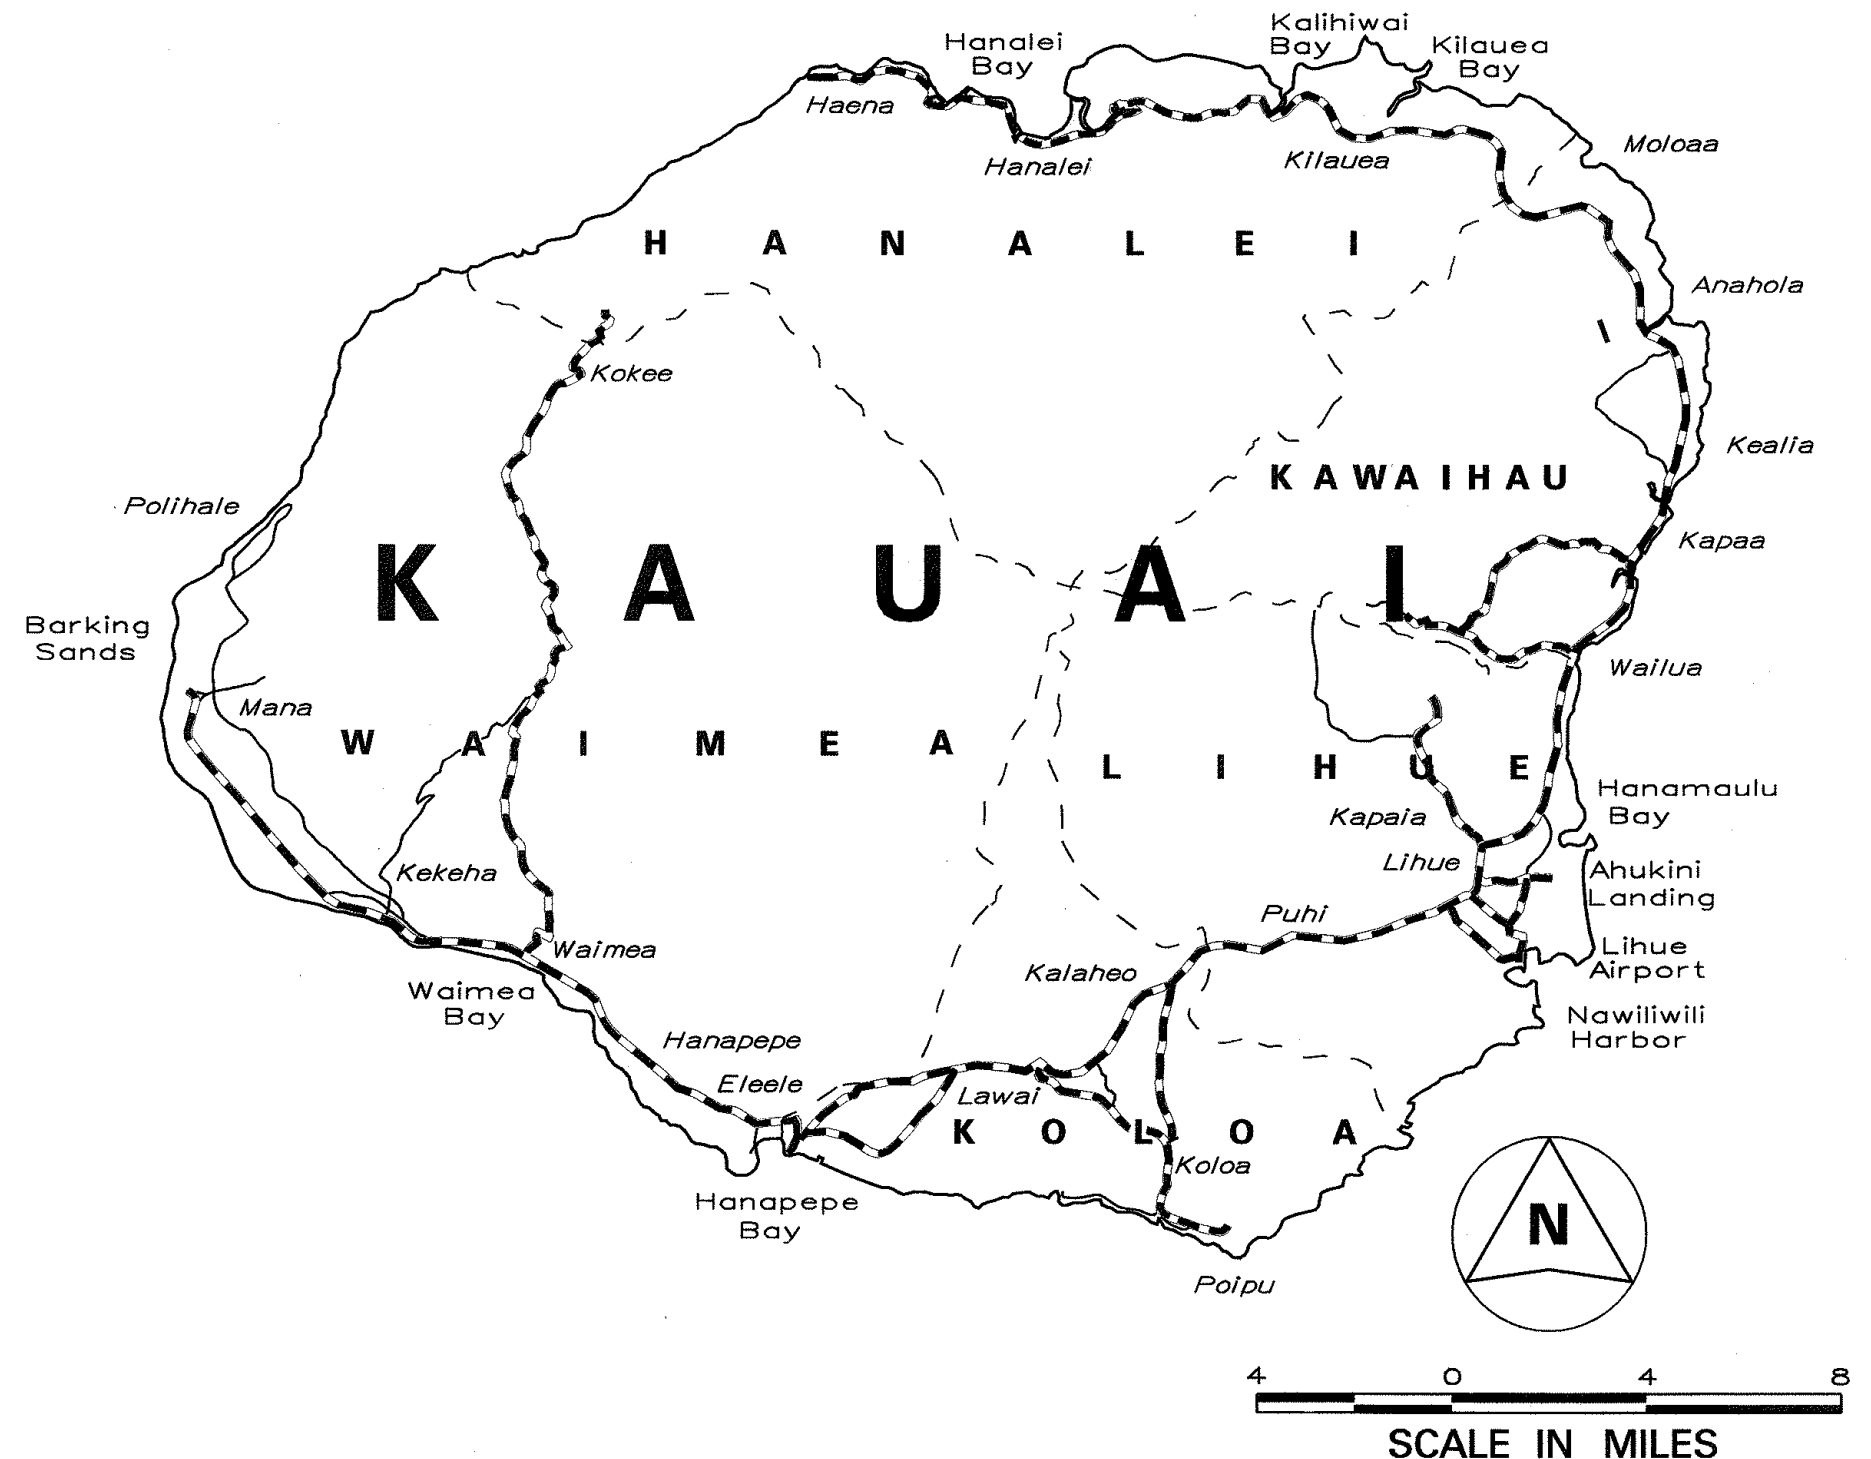

--- FEDERAL AID PROJECTS PREVIOUSLY CONSTRUCTED OR UNDER CONSTRUCTION

MILE POST 0.00 TO MILE POST 28.11 (RTE. 56)  
MILE POST 0.00 TO MILE POST 6.60 (RTE. 580)  
MILE POST 6.75 TO MILE POST 14.10 (RTE. 550)

DESIGN DESIGNATION			
	KUHIO HIGHWAY	KUAMOO ROAD	KOKEE ROAD
ADT (2006)	34,300	2,560	1,300
ADT (2026)	39,500	3,250	1,690
DHV	3,200	290	210
D	70/30	55/45	60/40
T	4.0%	2.5%	3.5%
V	35 - 50 M.P.H.	35 - 50 M.P.H.	35 - 50 M.P.H.

CHANGES MADE DURING CONSTRUCTION HAVE BEEN INCORPORATED ON THESE PLANS EXCEPT CHANGES IN THE ORIGINAL THEORETICAL QUANTITIES. FOR ACTUAL QUANTITIES, REFER TO PROJECT LEDGER AND/OR COMPLETION BOOK.

RESIDENT ENGINEER

5/5/09  
DATE

DEPARTMENT OF TRANSPORTATION  
STATE OF HAWAII

APPROVED:  
  
DIR. OF TRANSPORTATION

7-20-06  
DATE