
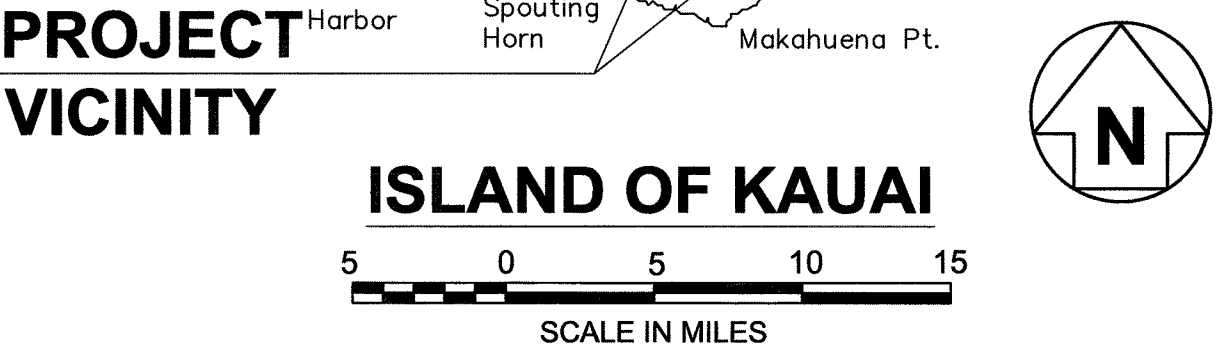
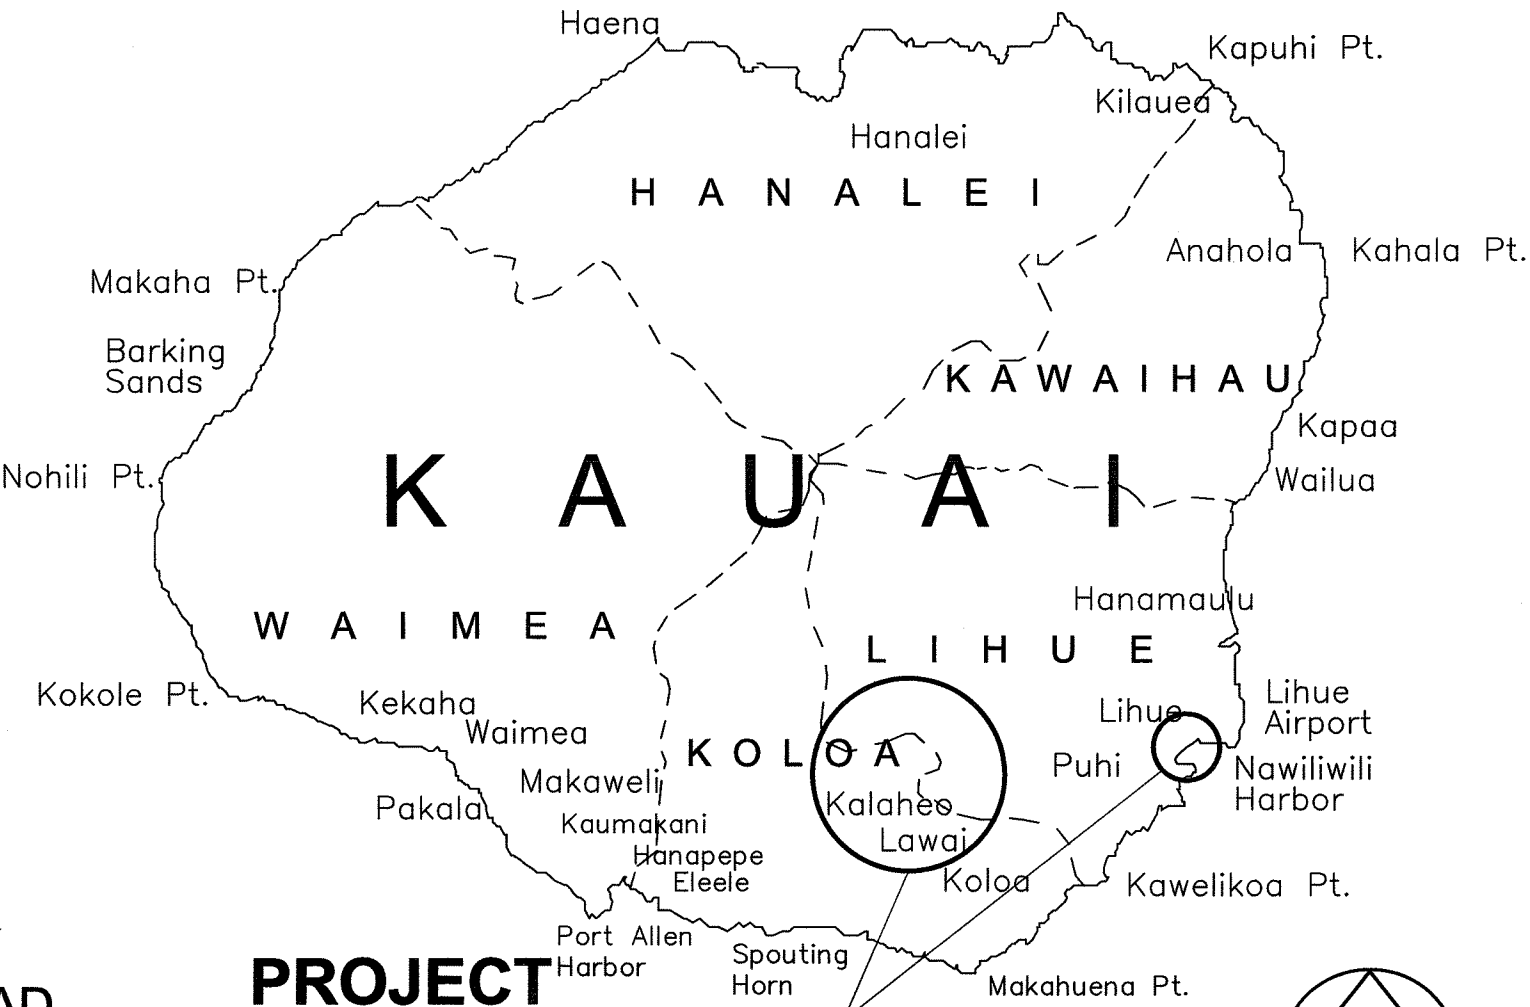
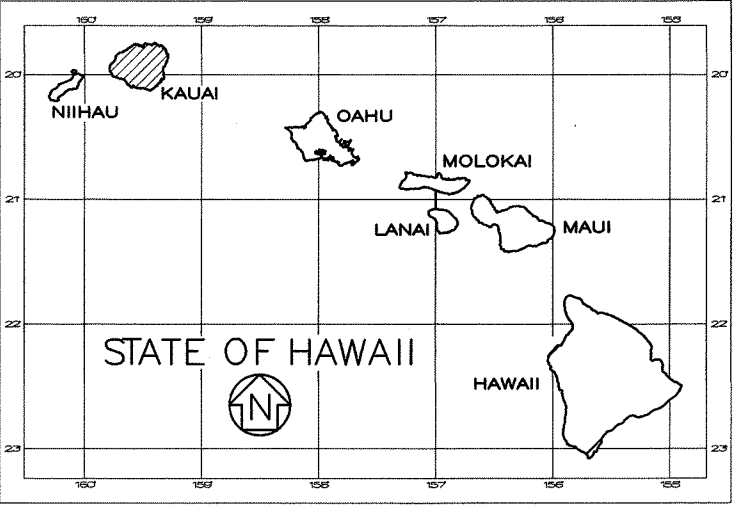





INDEX TO DRAWINGS	
SHEET NO.	DESCRIPTION
1	TITLE SHEET
2	STANDARD PLANS SUMMARY
3 - 5	GENERAL NOTES, UTILITY NOTES
6 - 7	WATER POLLUTION AND EROSION CONTROL NOTES
8-9	SLOPE REPAIRS RICE STREET MP 0.45
10-11	SLOPE REPAIRS KAUMUALII HWY MP 5.7
12-16	SLOPE REPAIRS KAUMUALII HWY MP 9.8
17-21	SLOPE REPAIRS KAUMUALII HWY MP 10.7
22	EROSION CONTROL MAT DETAILS
23-31	TRAFFIC CONTROL

STATE OF HAWAII
DEPARTMENT OF TRANSPORTATION
HIGHWAYS DIVISION
HONOLULU, HAWAII
"AS-BUILT"
PLANS FOR
KAUMUALII HIGHWAY AND RICE
STREET EMERGENCY REPAIRS AND
SLOPE STABILIZATION
AT VARIOUS LOCATIONS
PROJECT NO. HWY-K-06-07
DISTRICTS OF LIHUE AND KOLOA
ISLAND OF KAUAI

FED. ROAD DIST. NO.	STATE	PROJ. NO.	FISCAL YEAR	SHEET NO.	TOTAL SHEETS
KAUAI	HAWAII	HWY-K-06-07	2007	1	31

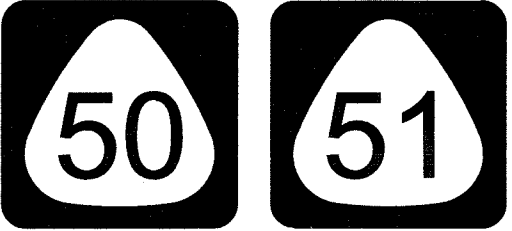

MILEPOST 5.7 TO MILE POST 10.7, ROUTE 50
MILEPOST 0.45, ROUTE 51

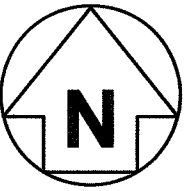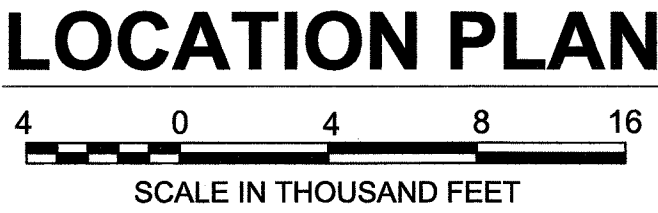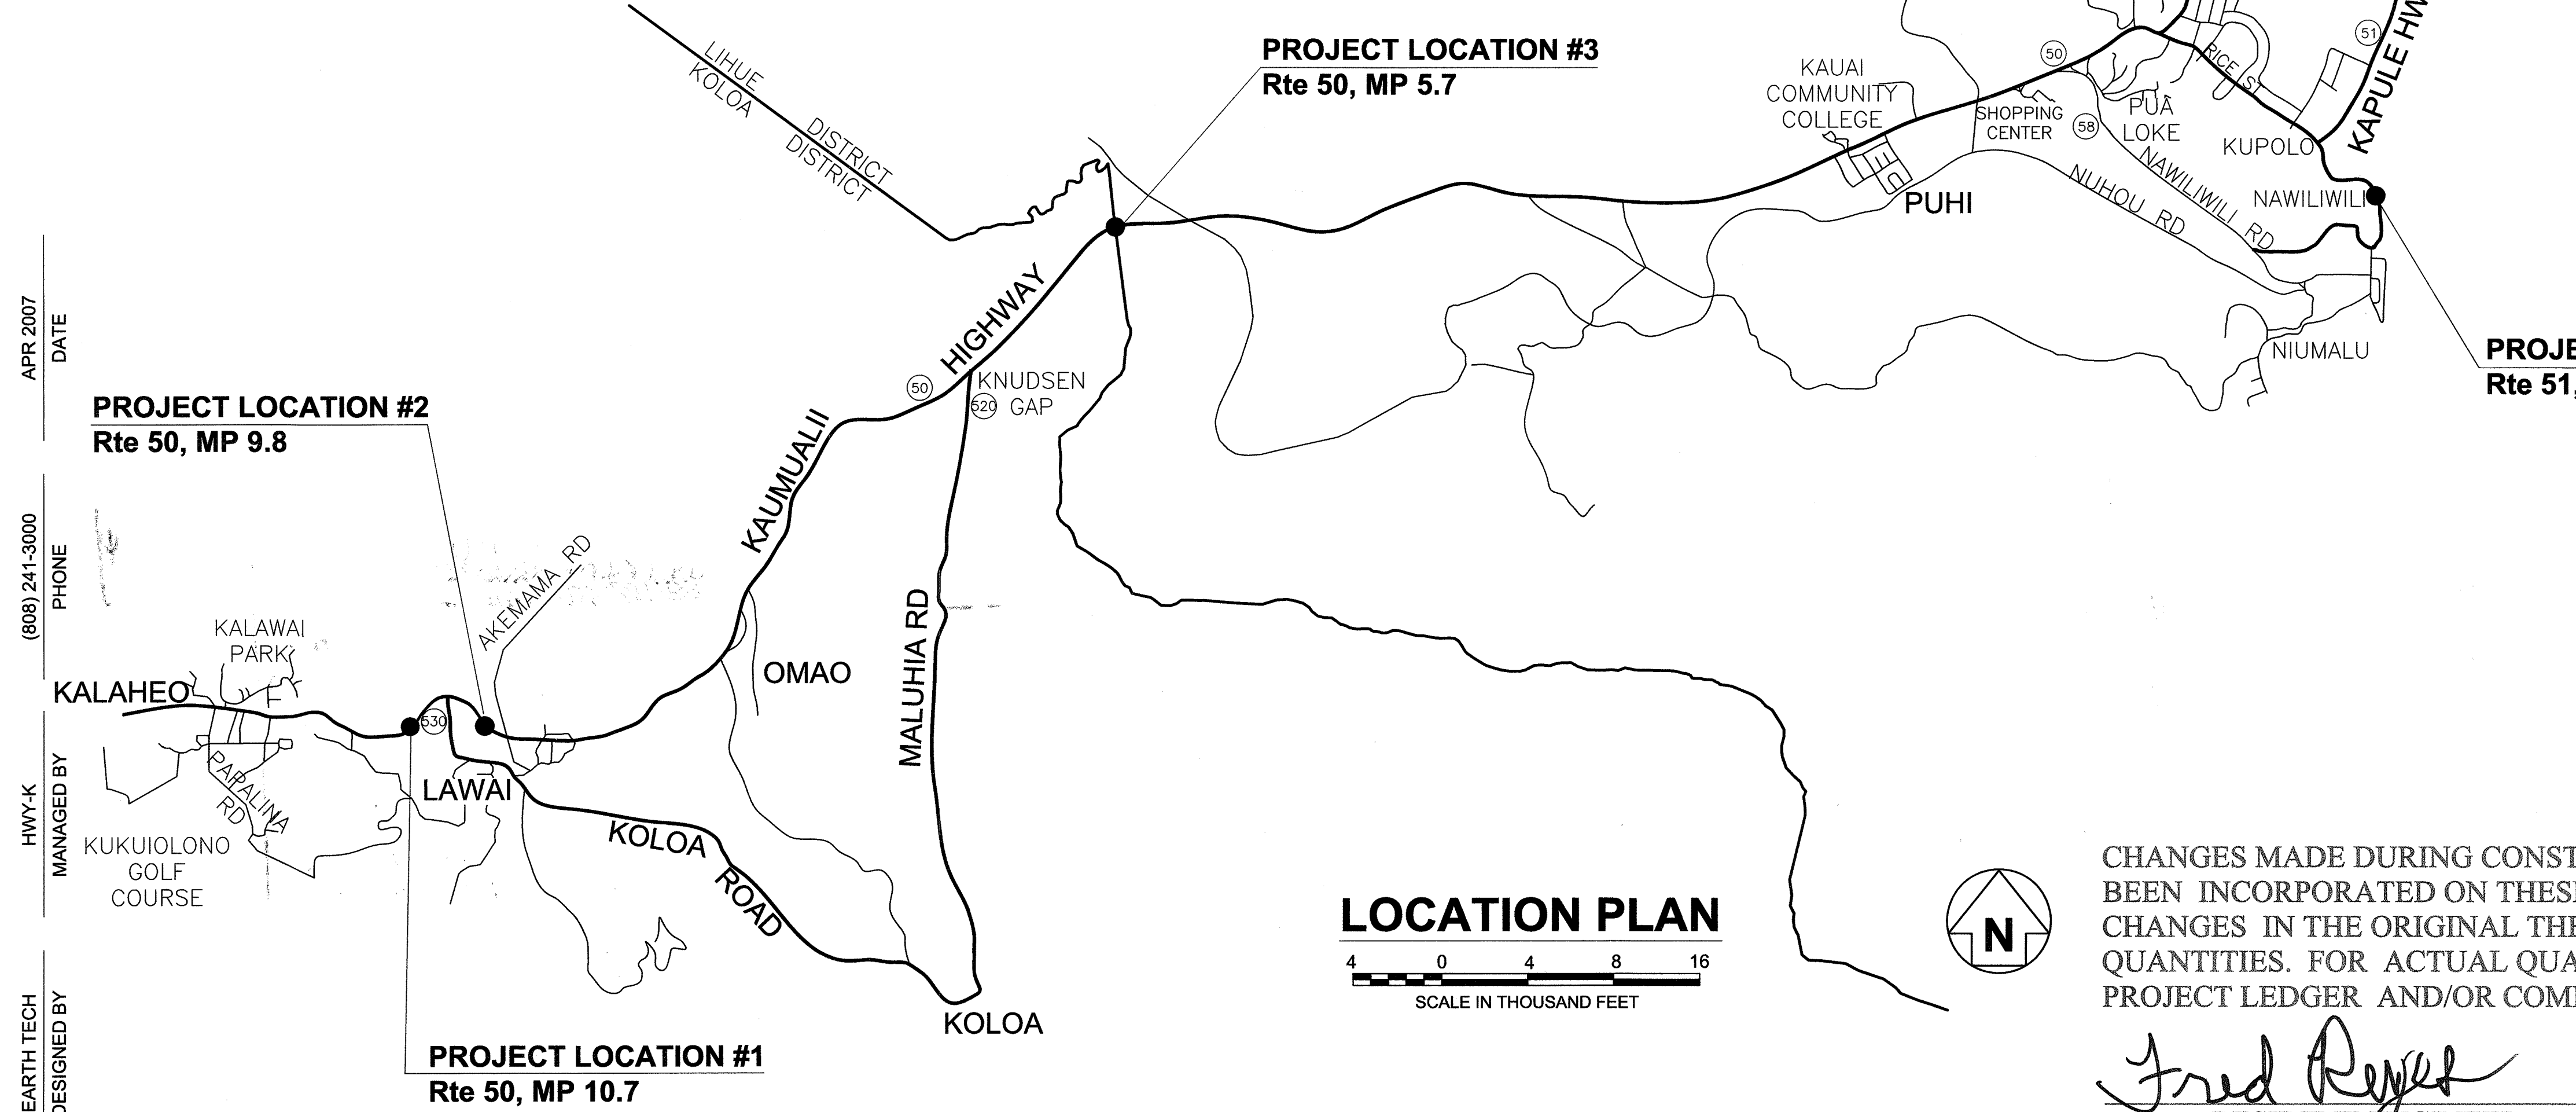

CHANGES MADE DURING CONSTRUCTION HAVE BEEN INCORPORATED ON THESE PLANS EXCEPT CHANGES IN THE ORIGINAL THEORETICAL QUANTITIES. FOR ACTUAL QUANTITIES, REFER TO PROJECT LEDGER AND/OR COMPUTATION BOOK.

Fred Reyes
RESIDENT ENGINEER

10/25/11
DATE

DEPARTMENT OF TRANSPORTATION STATE OF HAWAII	
APPROVED:	
<i>John A. H.</i>	5/1/17
DIR. OF TRANSPORTATION	DATE

P:\V\06092-007 Kauai Emergency Flood Mitigation\Drawings\As-Built\01 TitleSheet.dwg 09/29/11 3:21 PM Nacashinaki

APR 2007 DATE
(808) 241-3000 PHONE
HWY-K MANAGED BY
EARTH TECH DESIGNED BY