




FED. ROAD DIST. NO.	STATE	FED. AID PROJ. NO.	FISCAL YEAR	SHEET NO.	TOTAL SHEETS
HAWAII	HAW.	STP-0700(063)	2013	6	21

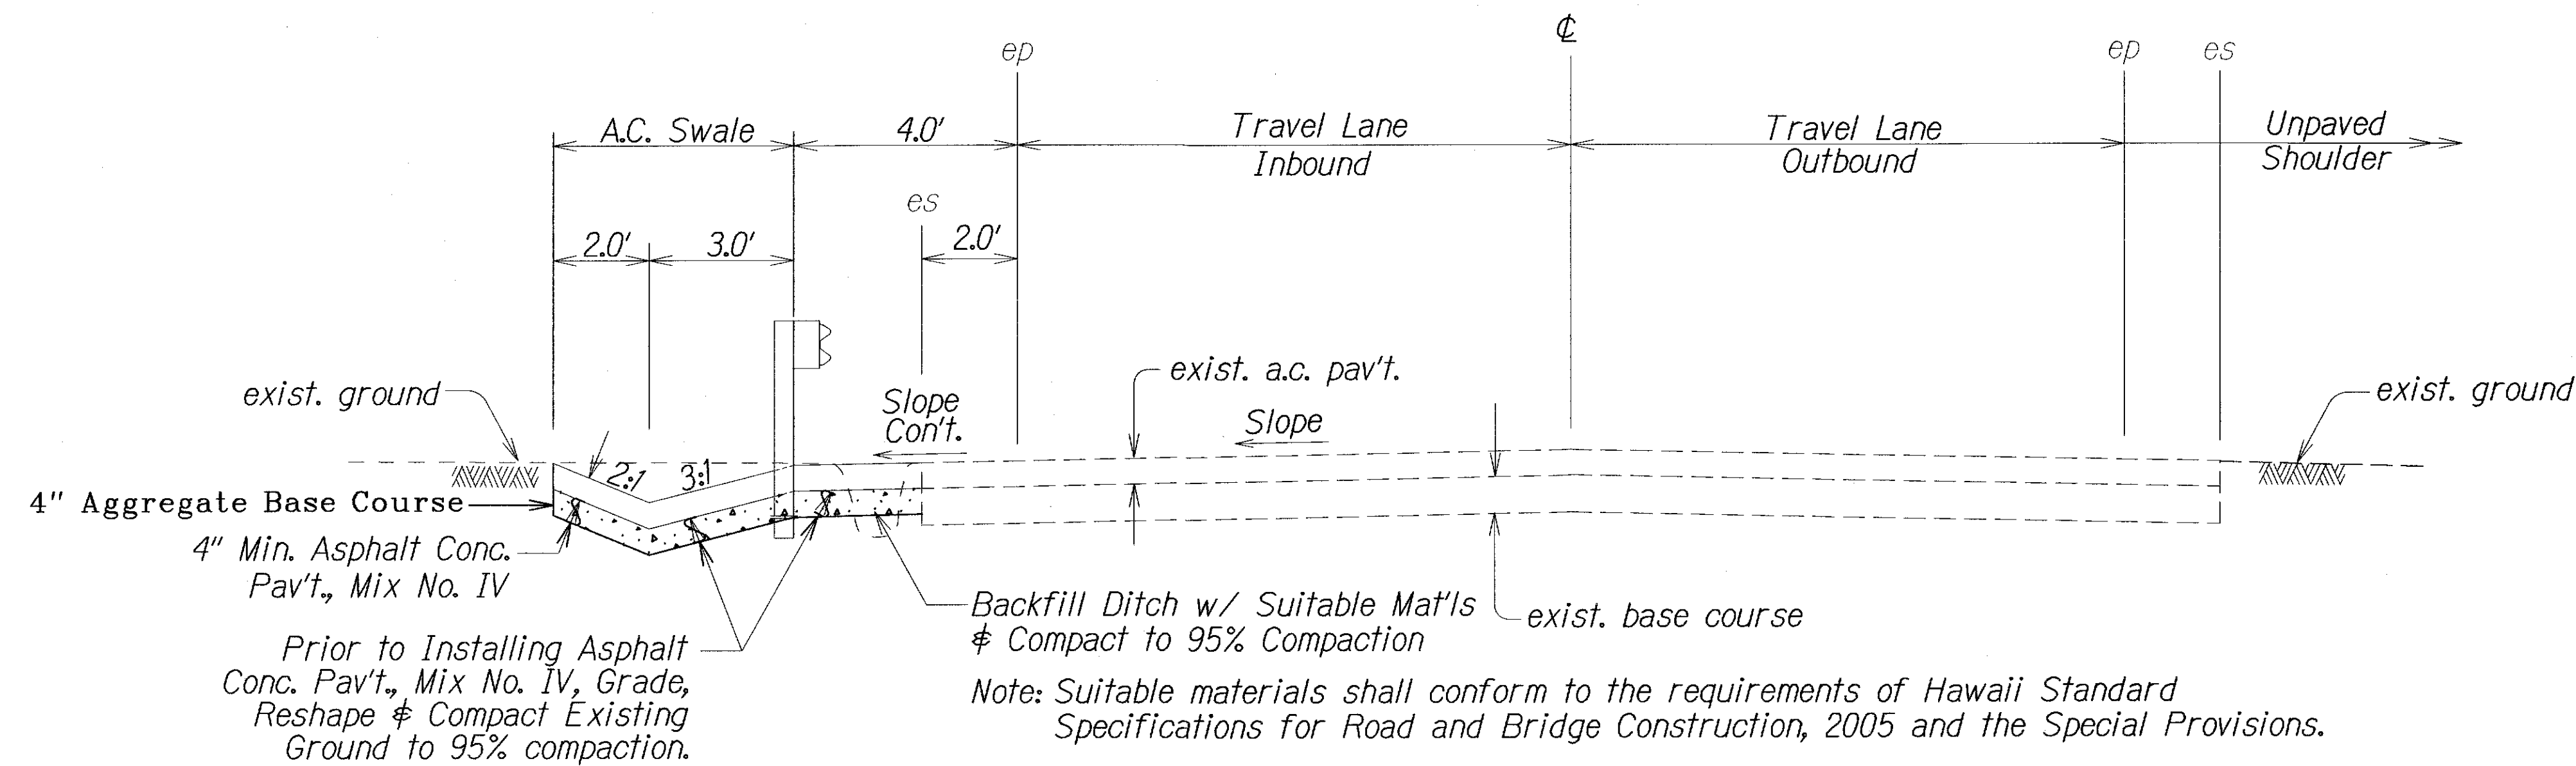


**TYPICAL SECTION FROM STA. 66+61.40± TO STA. 69+00±**  
**KUAMOO ROAD STA. 65+17**

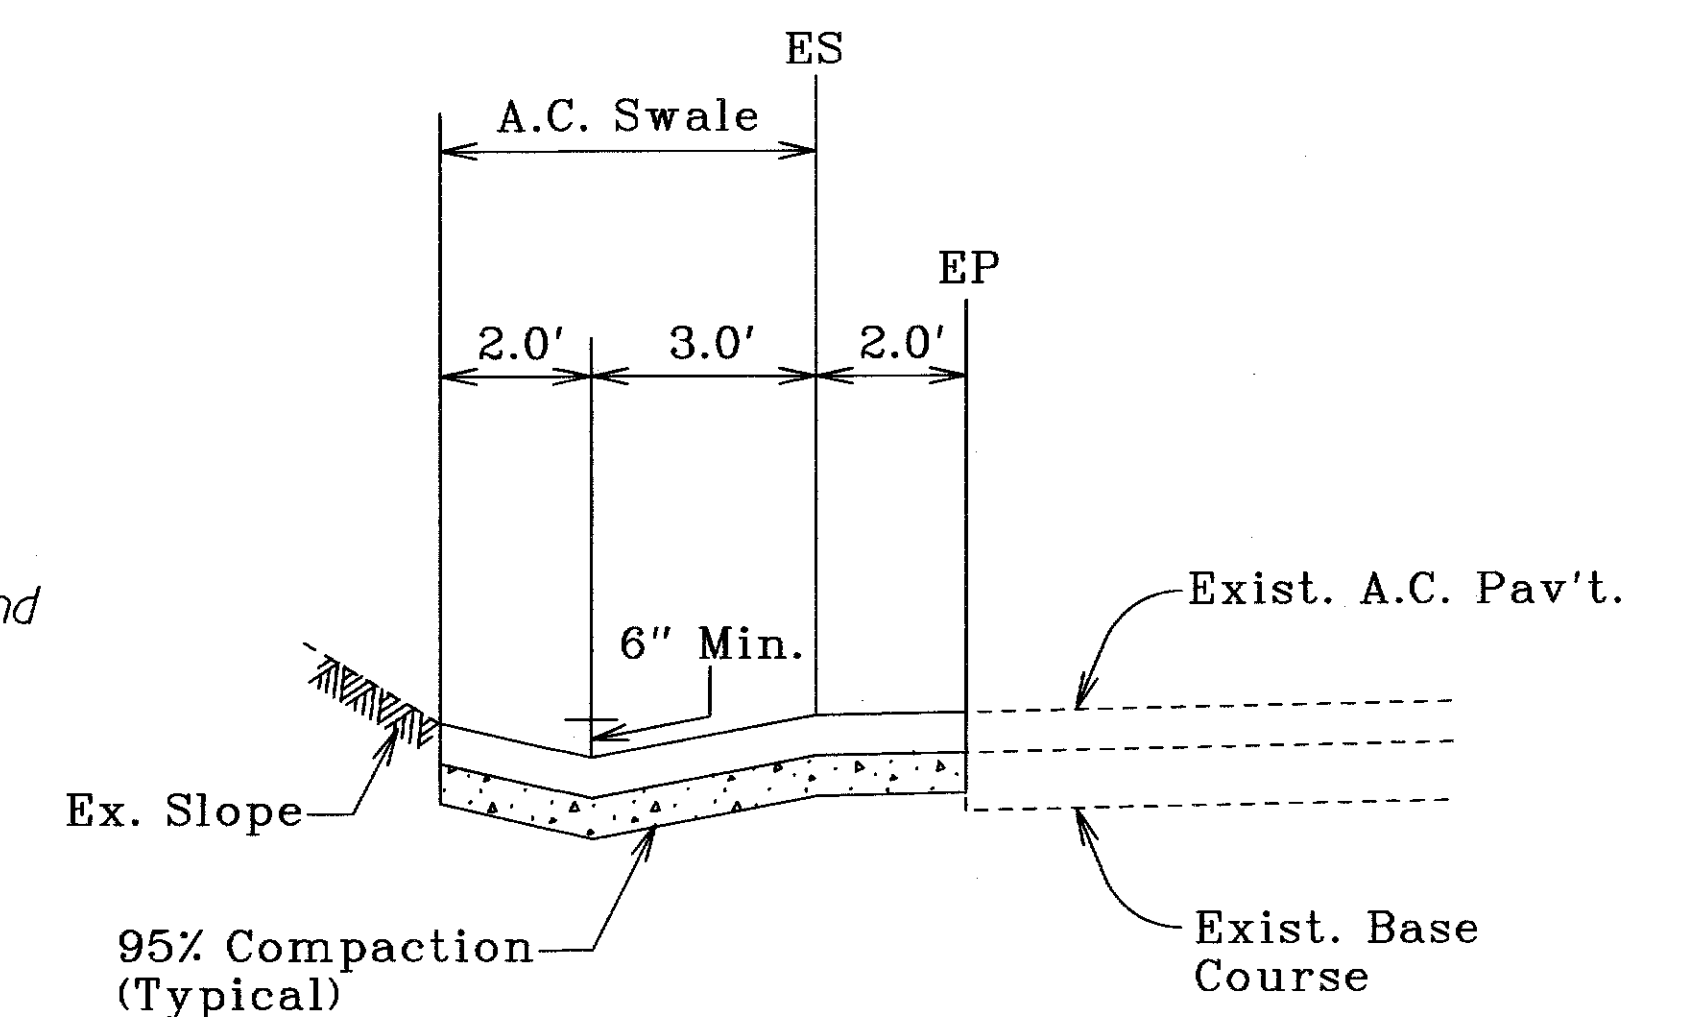

**Typical Section B, STA. 65+17 to 66+17**  
**Kuamoo Road**

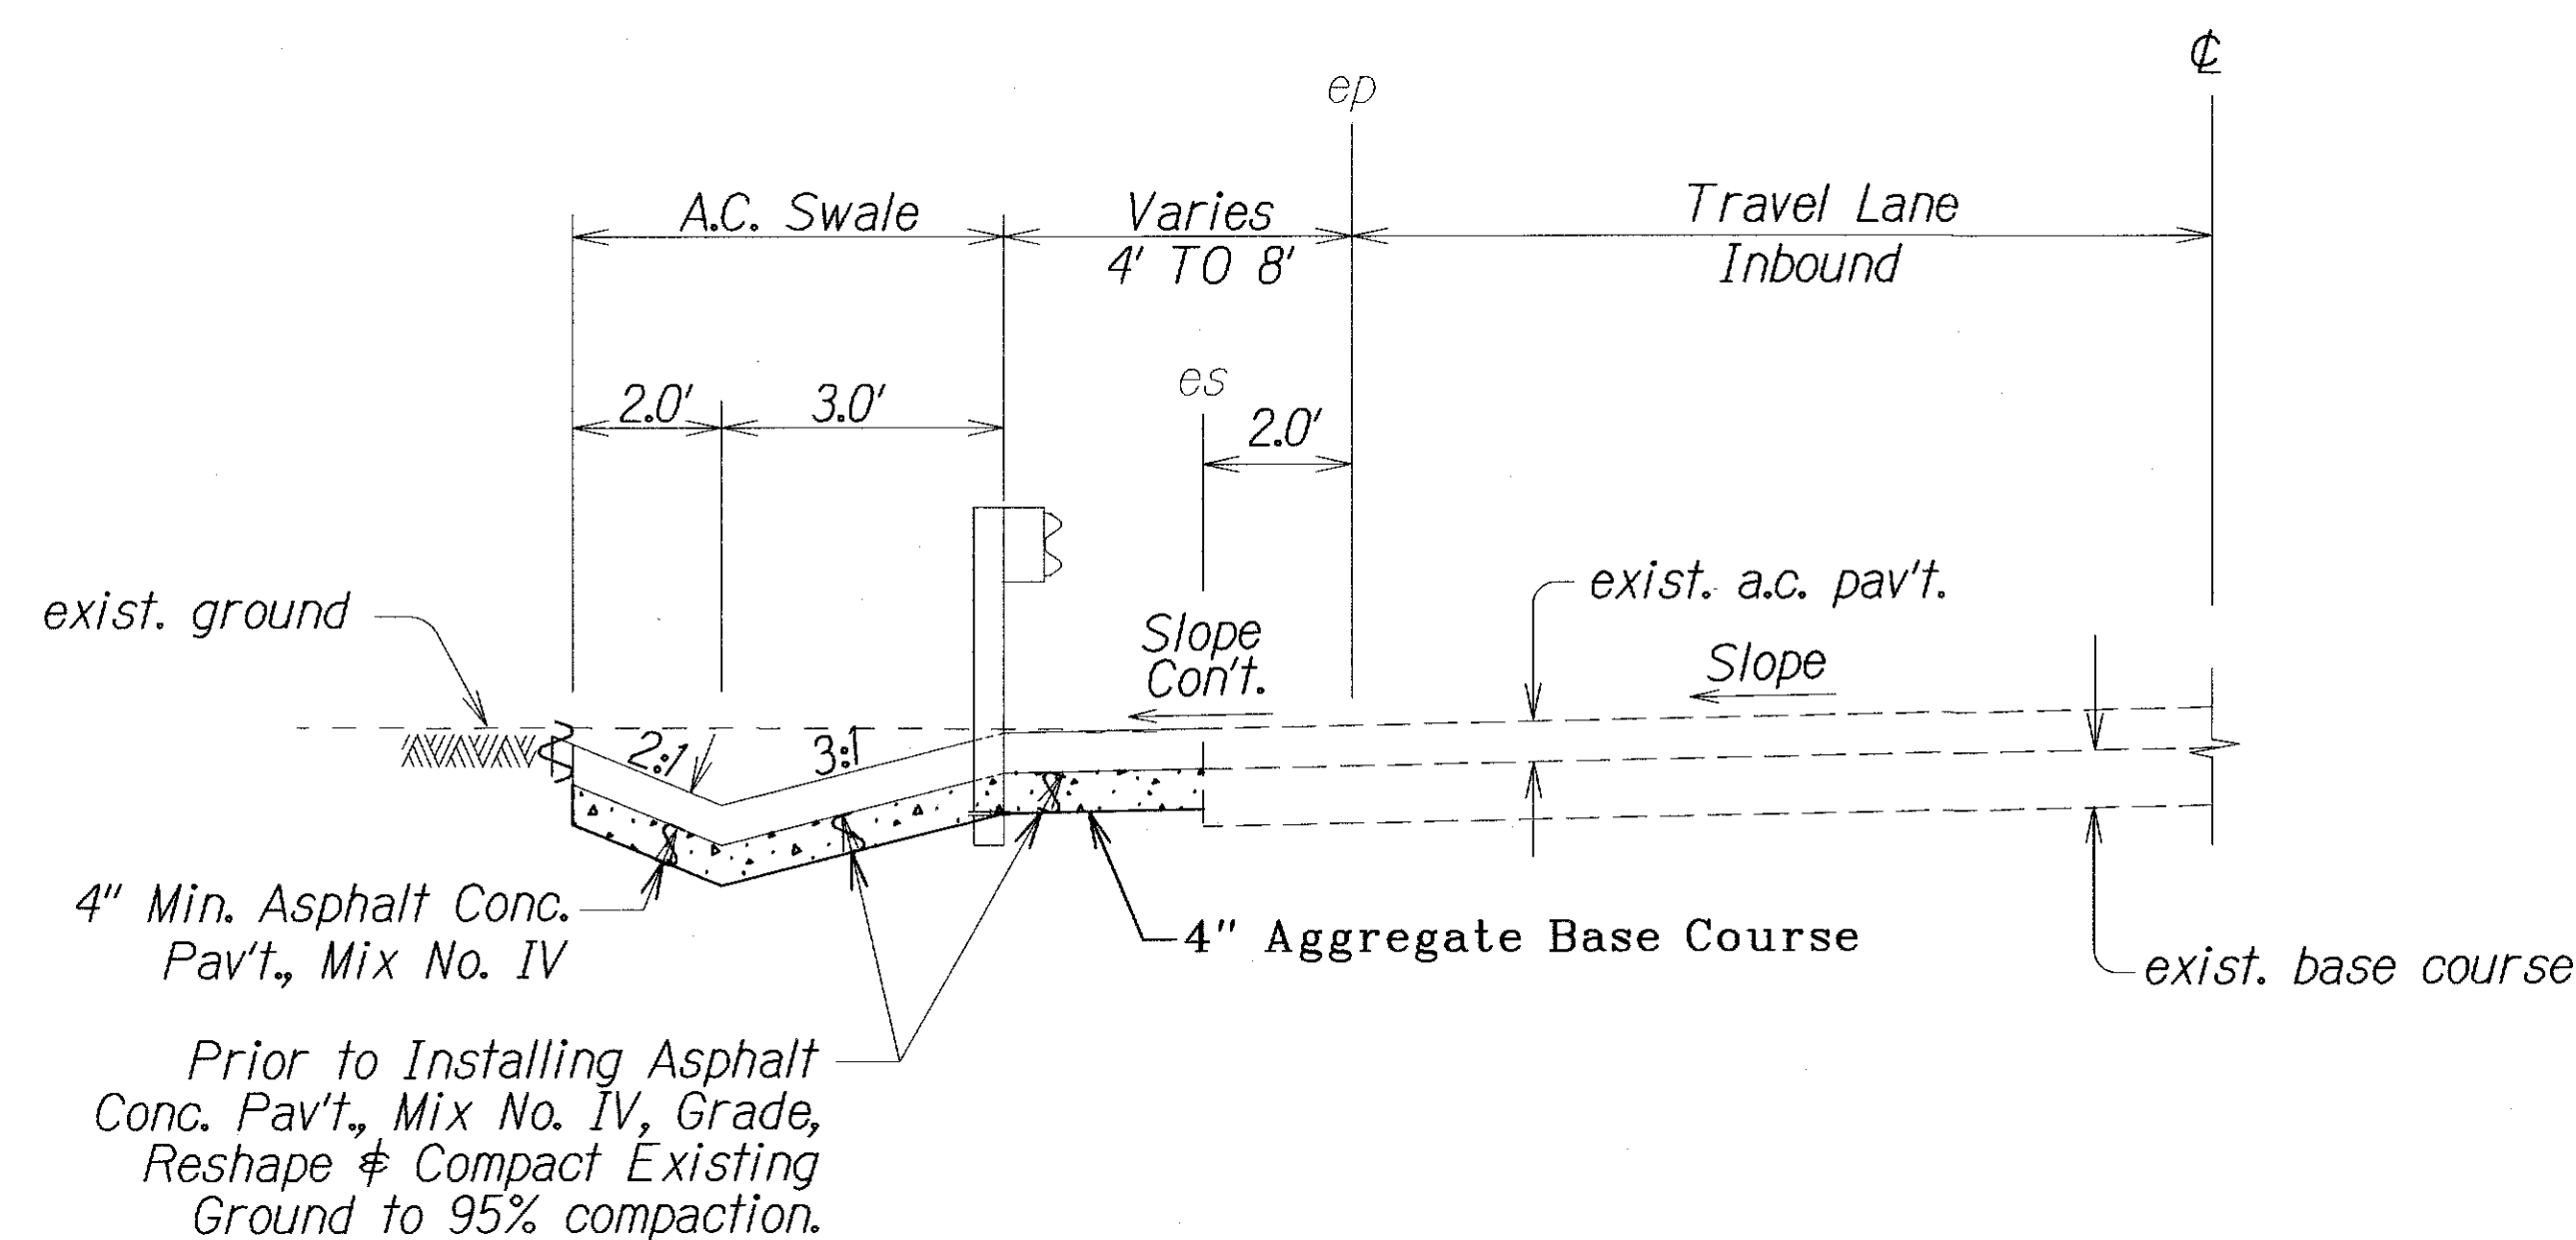

**TYPICAL SECTION @ END TREATMENT (MODIFIED TYPE "G")**  
**KUAMOO ROAD**

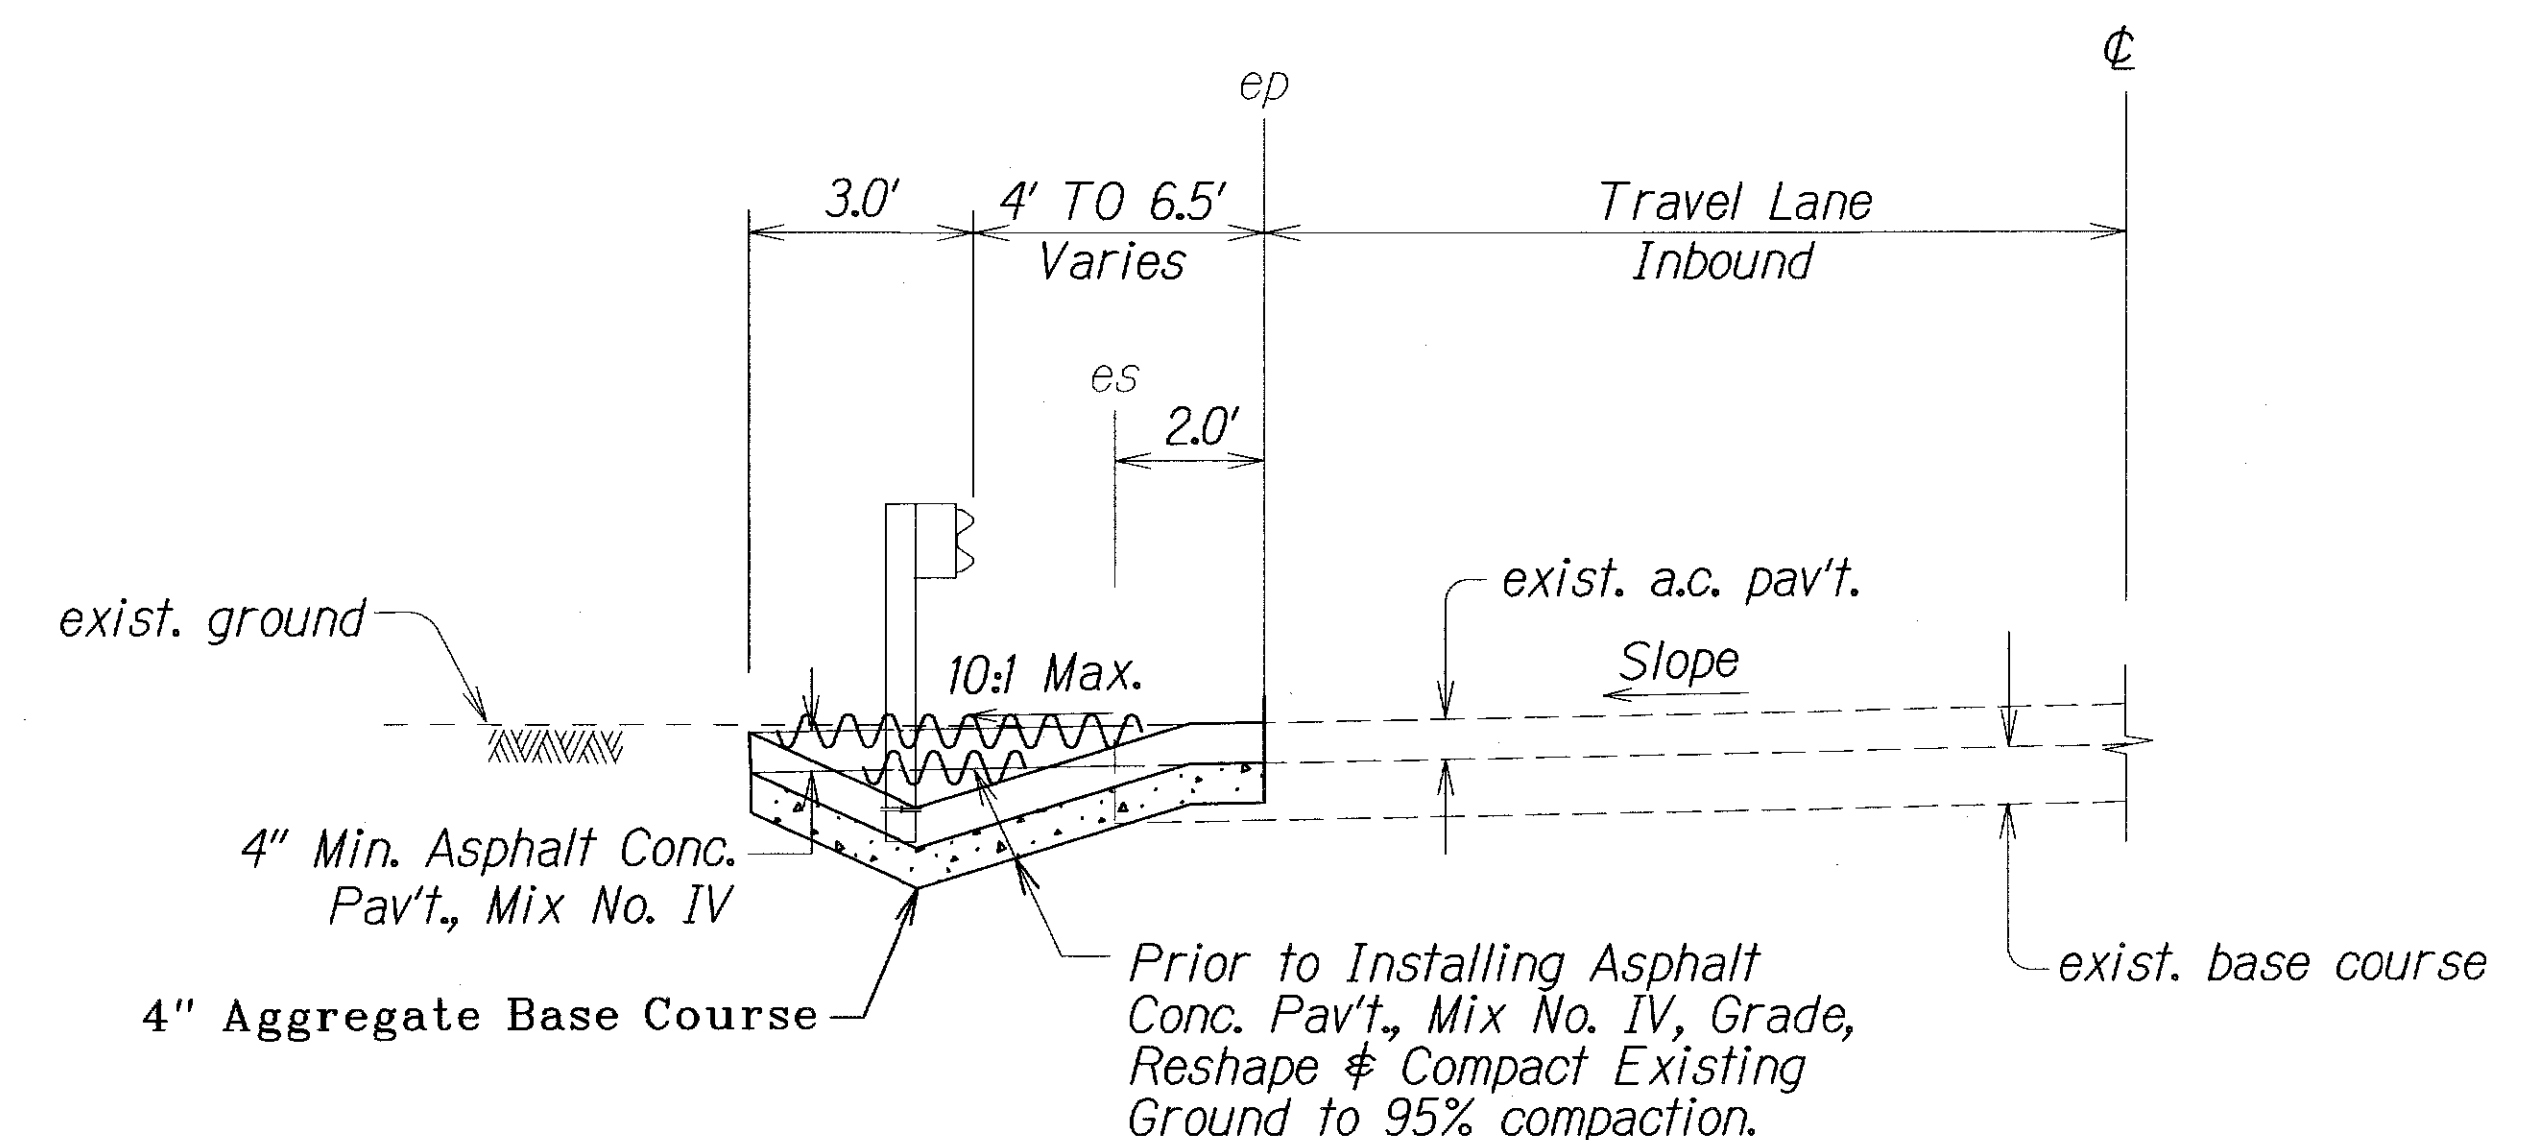

**(Type "A" Terminal End)**  
**TYPICAL SECTION @ END TREATMENT (Type "A" Terminal End)**  
**KUAMOO ROAD**

LEGEND FOR AS-BUILT POSTINGS	
	Squiggly line for as-built deletion
	Double line for as-built deletion
Roadway	Text for as-built posting


APPROVED:

County Engineer Date  
Department of Public Works  
"For Works Within County Right of Way"

STATE OF HAWAII DEPARTMENT OF TRANSPORTATION HIGHWAYS DIVISION	
TYPICAL SECTIONS GUARDRAIL AND SHOULDER IMPROVEMENTS AT VARIOUS LOCATIONS	
Kaunualii Highway and Kuamoo Road Fed-Aid Project No. STP-0700(063)	
Not to Scale	Date: July 2012
SHEET No. 1 OF 3 SHEETS	

"AS-BUILT"


FED. ROAD DIST. NO.	STATE	FED. AID PROJ. NO.	FISCAL YEAR	SHEET NO.	TOTAL SHEETS
HAWAII	HAW.	STP-0700(063)	2013	7	21

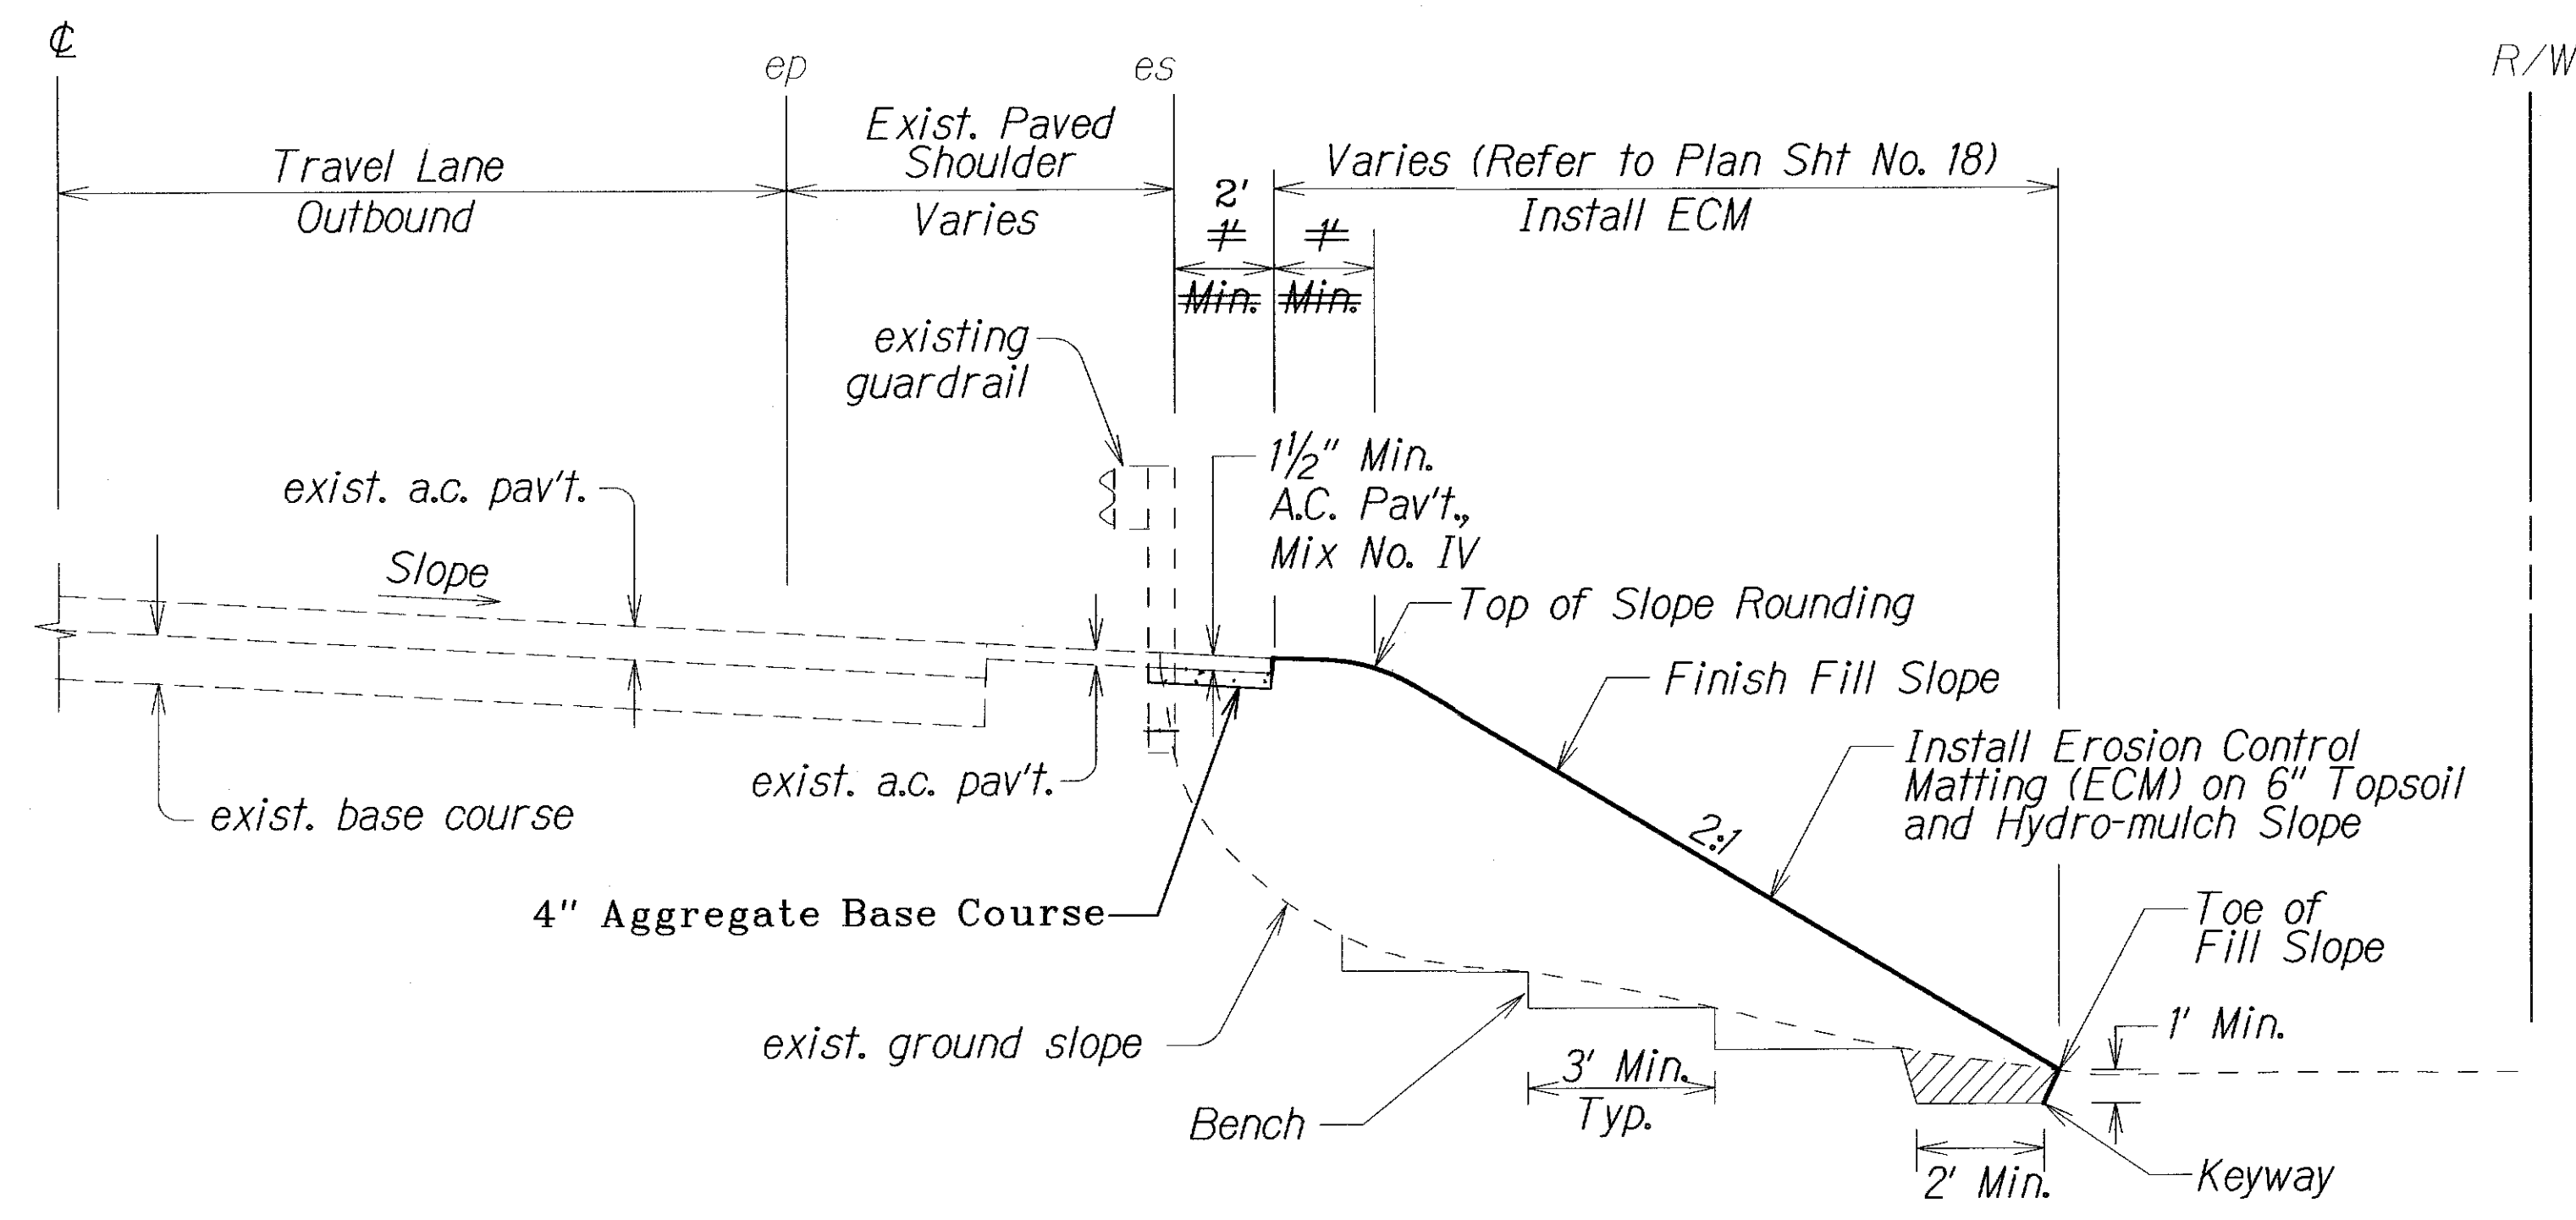

23  
TYPICAL SLOPE PROTECTION SECTION (# STA. 216+00 - # STA. 217+00)  
KAUMUALII HIGHWAY

Notes:

- Slope protection should be established as soon as fill or fill slope is completed to reduce erosion potential.
- The Contractor, at his own expense, shall keep the project area and surrounding area free from dust nuisance.
- No Contractor shall perform any grading operations so as to cause falling rocks, soil or debris in any form to fall, slide or flow onto adjoining properties, streets or natural watercourse.
- No grading work shall be done on Saturdays, Sundays and Holidays.
- Temporary measures to control erosion and other pollutants shall be placed before any earth moving phase of the grading is initiated. Temporary erosion controls shall not be removed before permanent erosion controls are in placed and established. Temporary erosion control procedures shall be submitted to the Engineer for review and approval. This work shall be considered incidental to various contract items.
- All trees encountered during grading operation are to remain and shall be protected from damages during the entire course of the project.
- Fill materials shall conform to the requirements of Hawaii Standard Specification for Road and Bridges, 2005 and the Special Provisions.

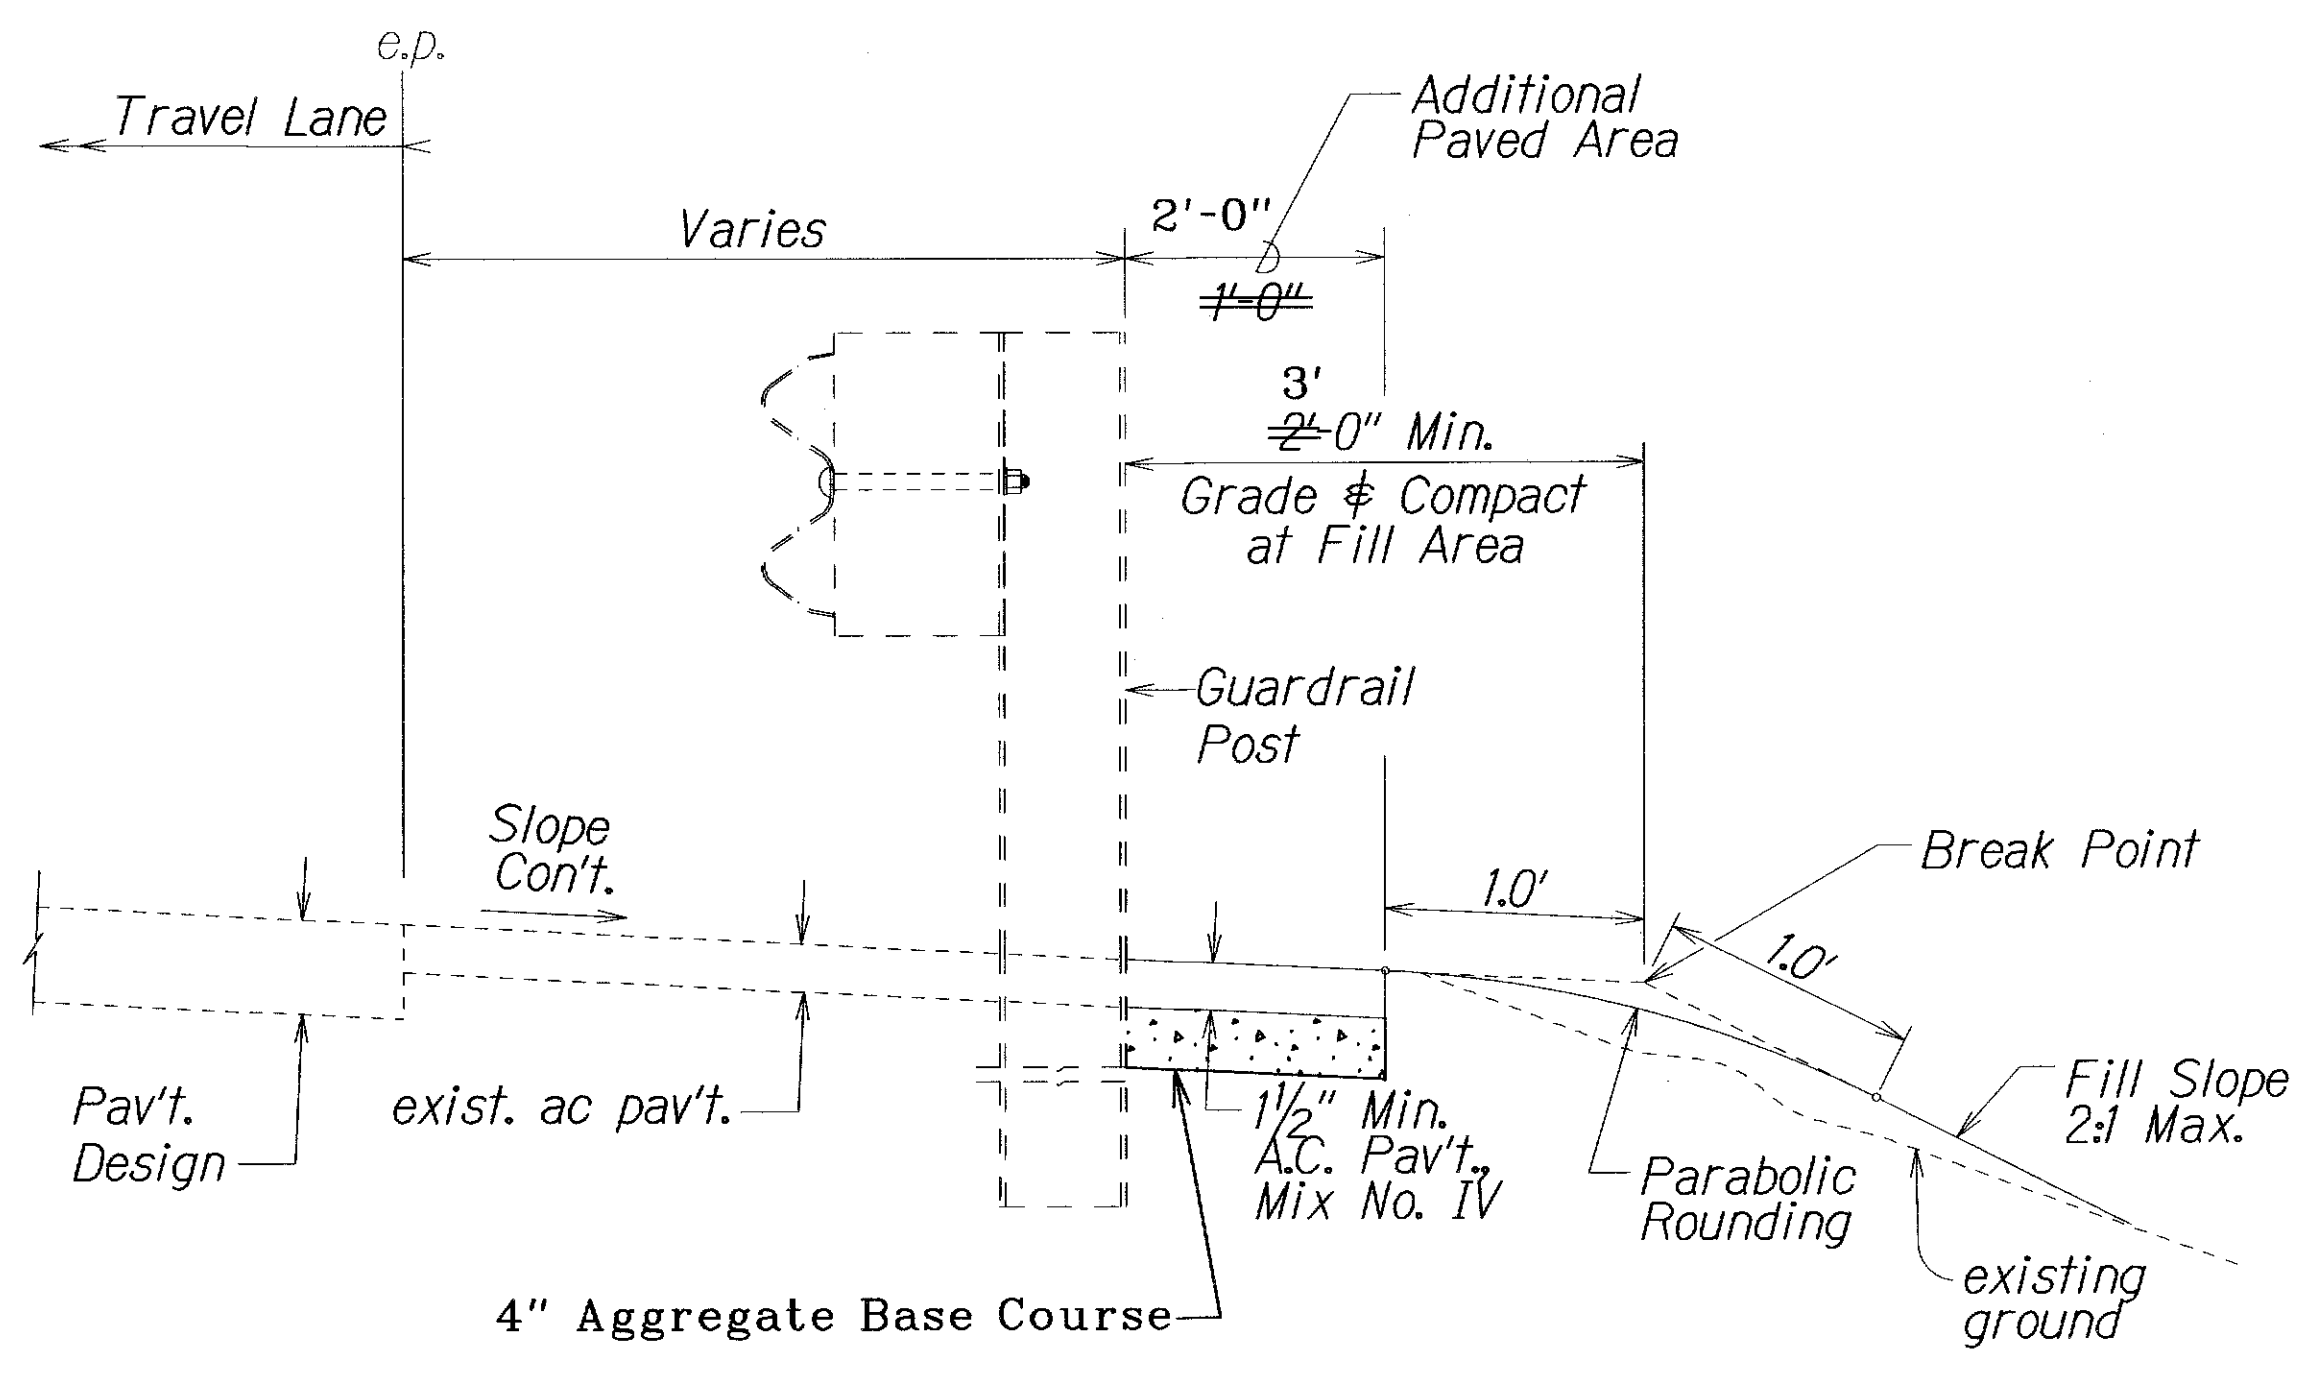

23  
TYPICAL SECTION (# STA 217+00 - # STA. 218+96.5)  
KAUMUALII HIGHWAY


- Notes:
- When standards for the fill slope area cannot be met, a site specific, engineer approved design may be used.
  - Dress and hydro-mulch fill slope areas.
  - Prior to installing asphalt concrete pavement Mix No. IV, level and remove vegetation and compact existing ground to 95% compaction.

ORIGINAL PLAN	SURVEY PLOTTED BY	DATE
DRAWN BY		
TRACED BY		
CHECKED BY		
NOTED BY		
QUANTITIES BY		
CHECKED BY		

LEGEND FOR AS-BUILT POSTINGS	
	Squiggly line for as-built deletion
	Double line for as-built deletion
Roadway	Text for as-built posting

STATE OF HAWAII  
DEPARTMENT OF TRANSPORTATION  
HIGHWAYS DIVISION  
  
**TYPICAL SECTIONS**  
GUARDRAIL AND SHOULDER IMPROVEMENTS  
AT VARIOUS LOCATIONS  
Kaumualii Highway and Kuamoo Road  
Fed-Aid Project No. STP-0700(063)  
Not to Scale  
Date: July 2012  
  
SHEET No. 2 OF 3 SHEETS

FED. ROAD DIST. NO.	STATE	FED. AID PROJ. NO.	FISCAL YEAR	SHEET NO.	TOTAL SHEETS
HAWAII	HAW.	STP-0700(063)	2013	8	21

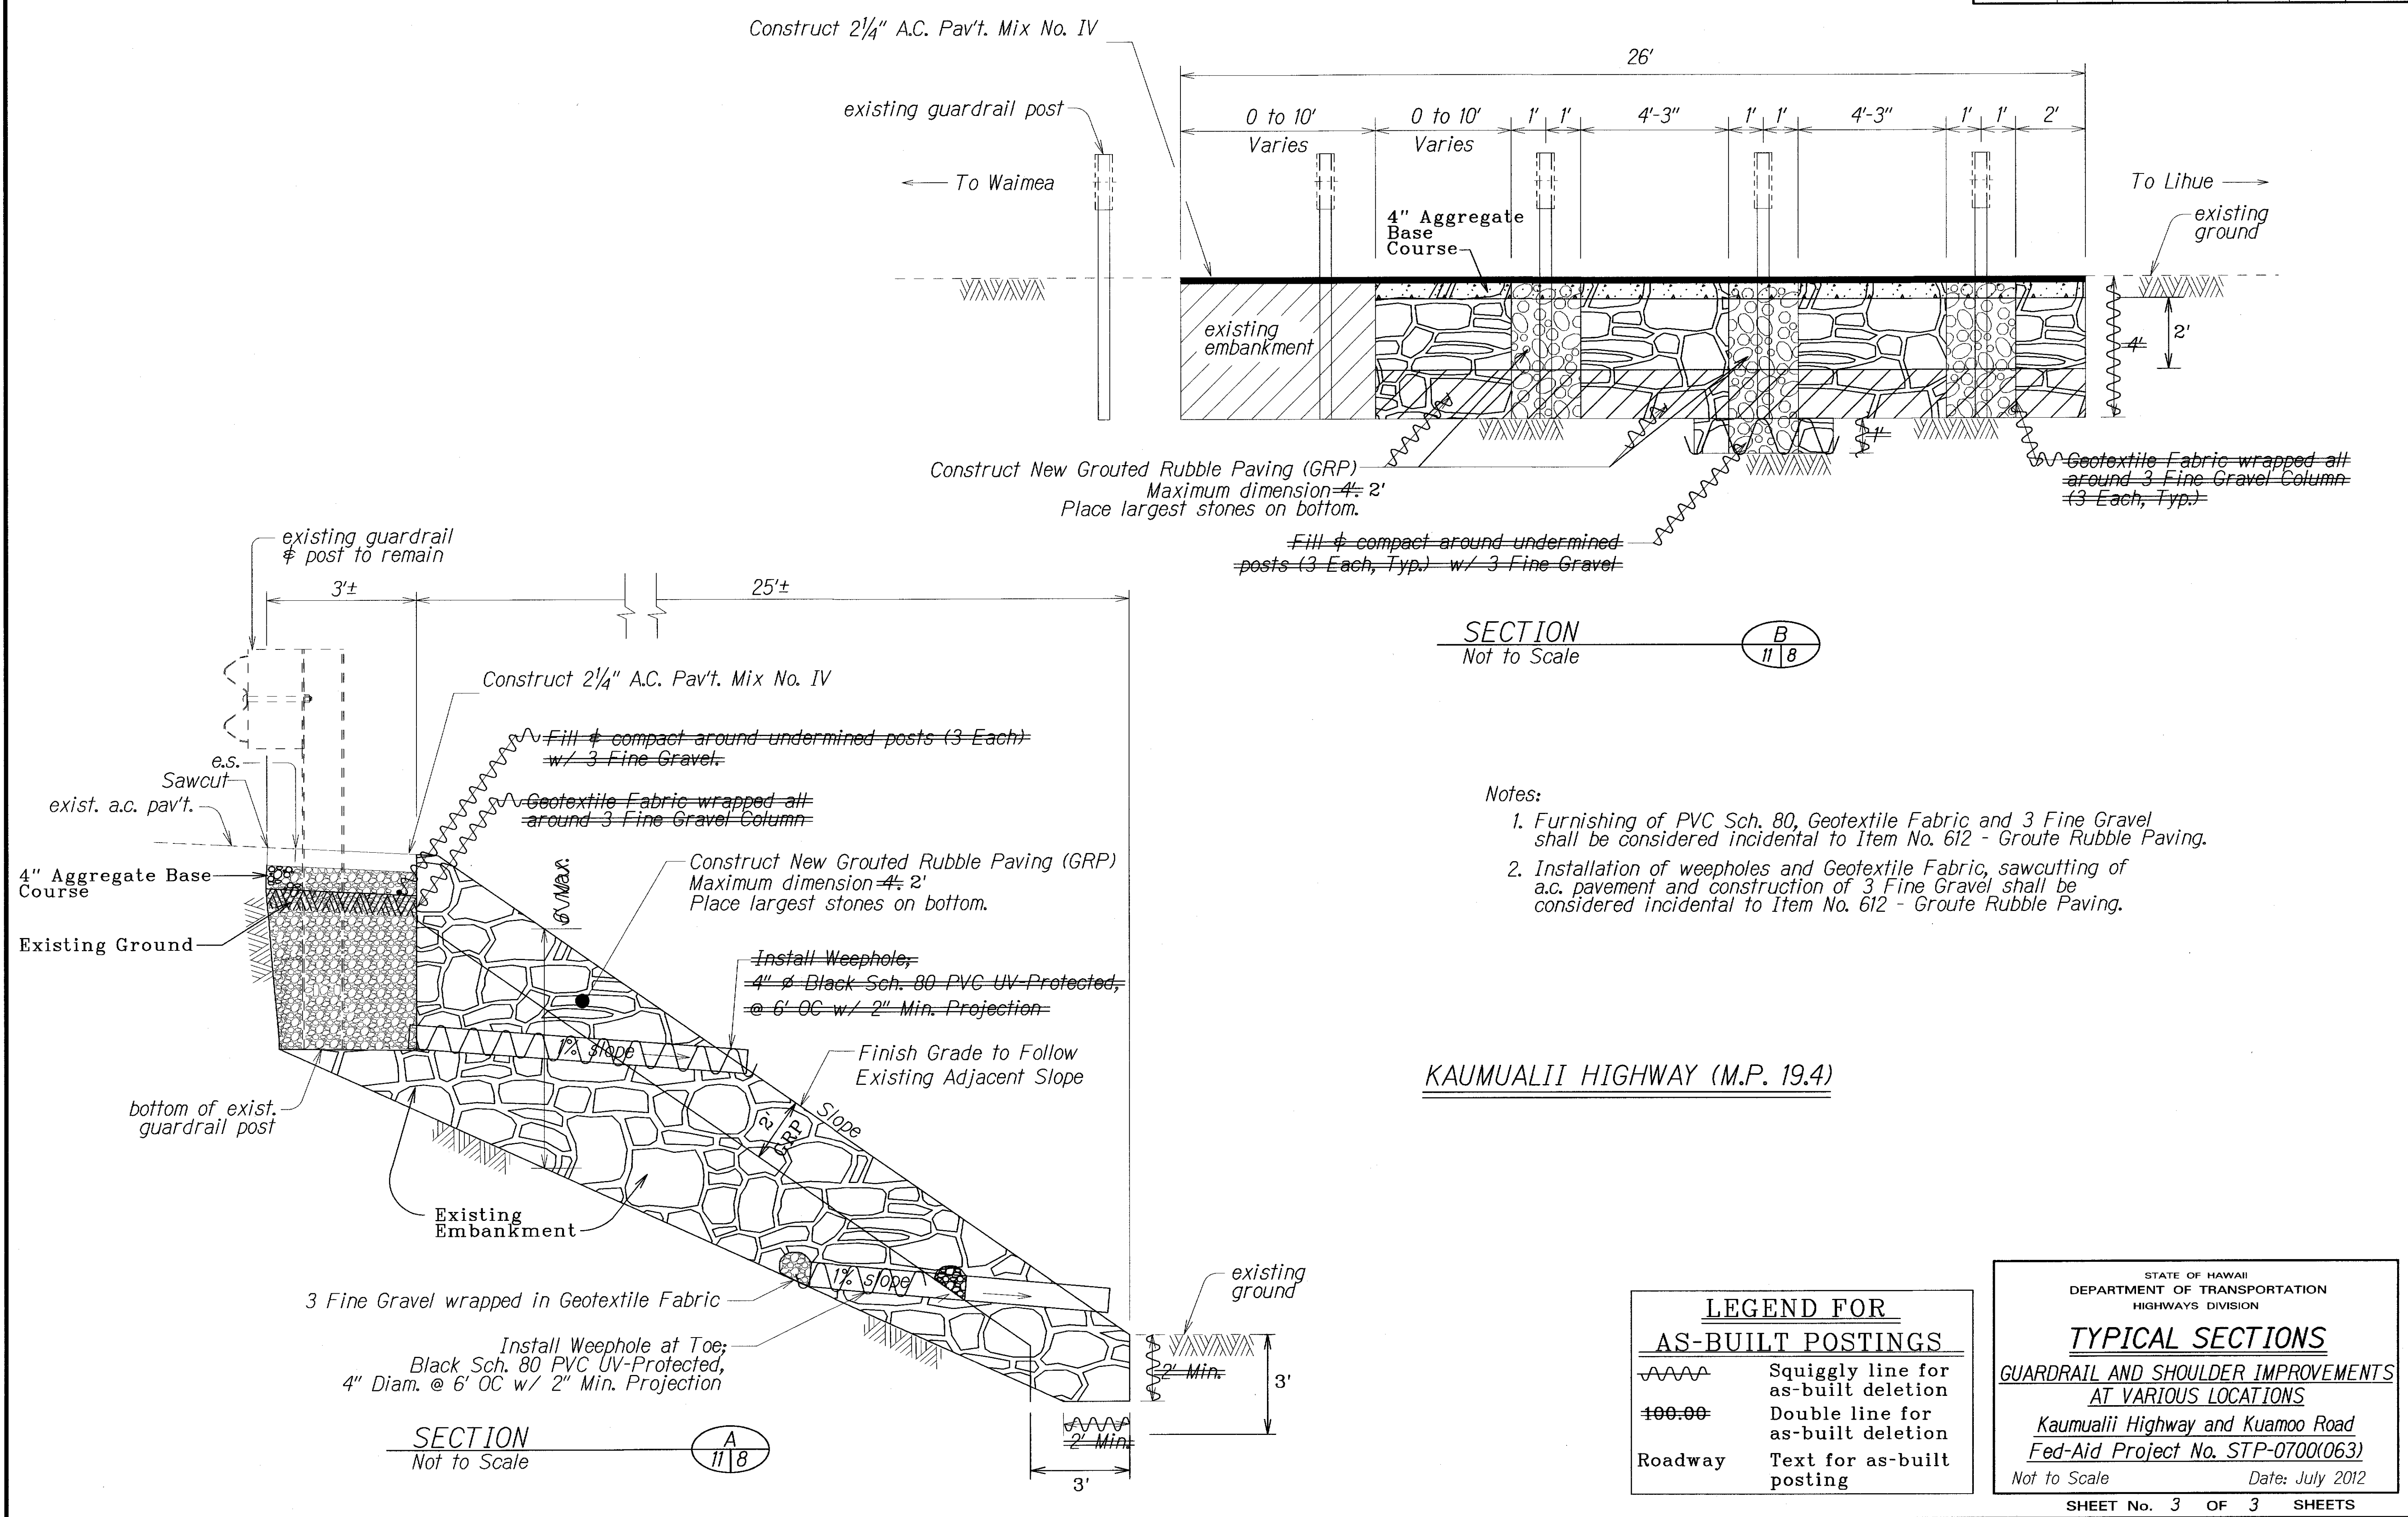

"AS-BUILT"