


FED. ROAD DIST. NO.	STATE	FED-AID PROJ. NO.	FISCAL YEAR	SHEET NO.	TOTAL SHEETS
HAWAII	HAW.	STP-0700(067)	2016	14	17

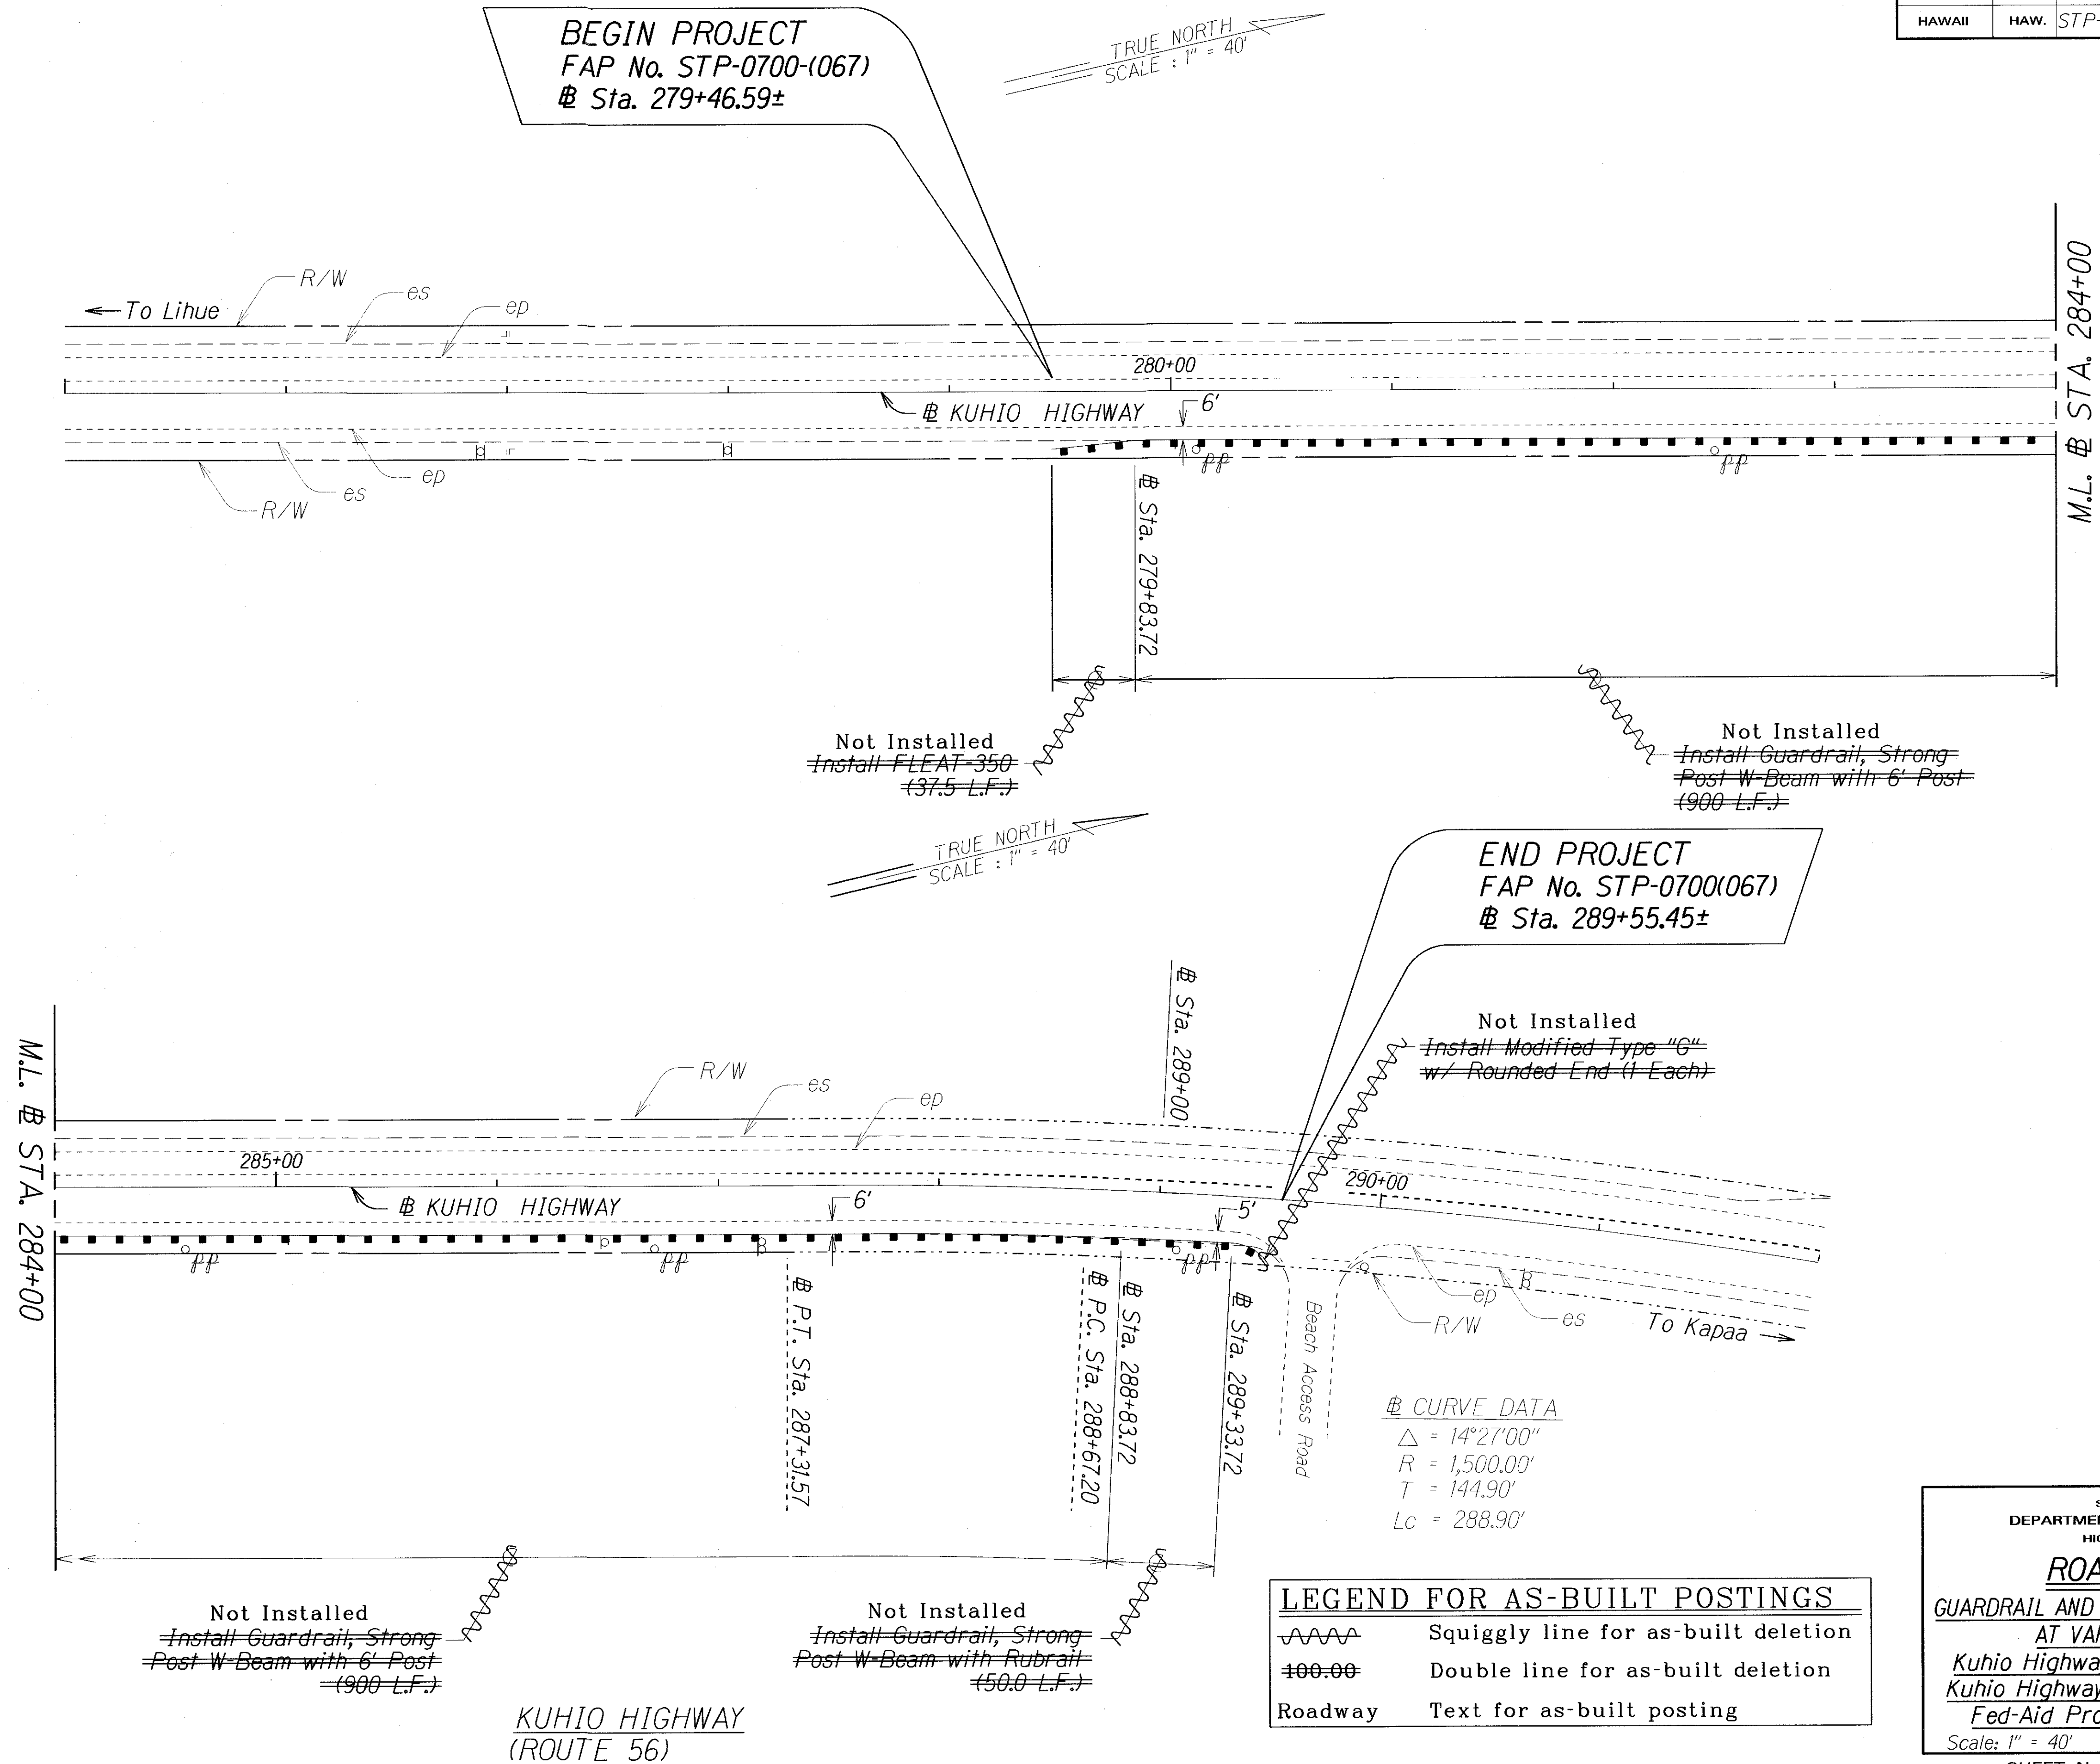

SURVEY PLOTTED BY	DATE
DRAWN BY	
DESIGNED BY	
QUANTITIES BY	
CHECKED BY	
ORIGINAL PLAN	
NOTE BOOK	
DATE	
NO.	


LEGEND FOR AS-BUILT POSTINGS	
	Squiggly line for as-built deletion
	Double line for as-built deletion
Roadway	Text for as-built posting

STATE OF HAWAII
DEPARTMENT OF TRANSPORTATION
HIGHWAYS DIVISION

ROADWAY PLAN
GUARDRAIL AND SHOULDER IMPROVEMENTS
AT VARIOUS LOCATIONS
Kuhio Highway, ROUTE 56 (M.P. 3.70)
Kuhio Highway, ROUTE 560 (M.P. 6.25)
Fed-Aid Proj. No. STP-0700(067)
Scale: 1" = 40' Date: October 2015

SHEET No. 1 OF 2 SHEETS

FED. ROAD DIST. NO.	STATE	FED-AID PROJ. NO.	FISCAL YEAR	SHEET NO.	TOTAL SHEETS
HAWAII	HAW.	STP-0700(067)	2016	15	17

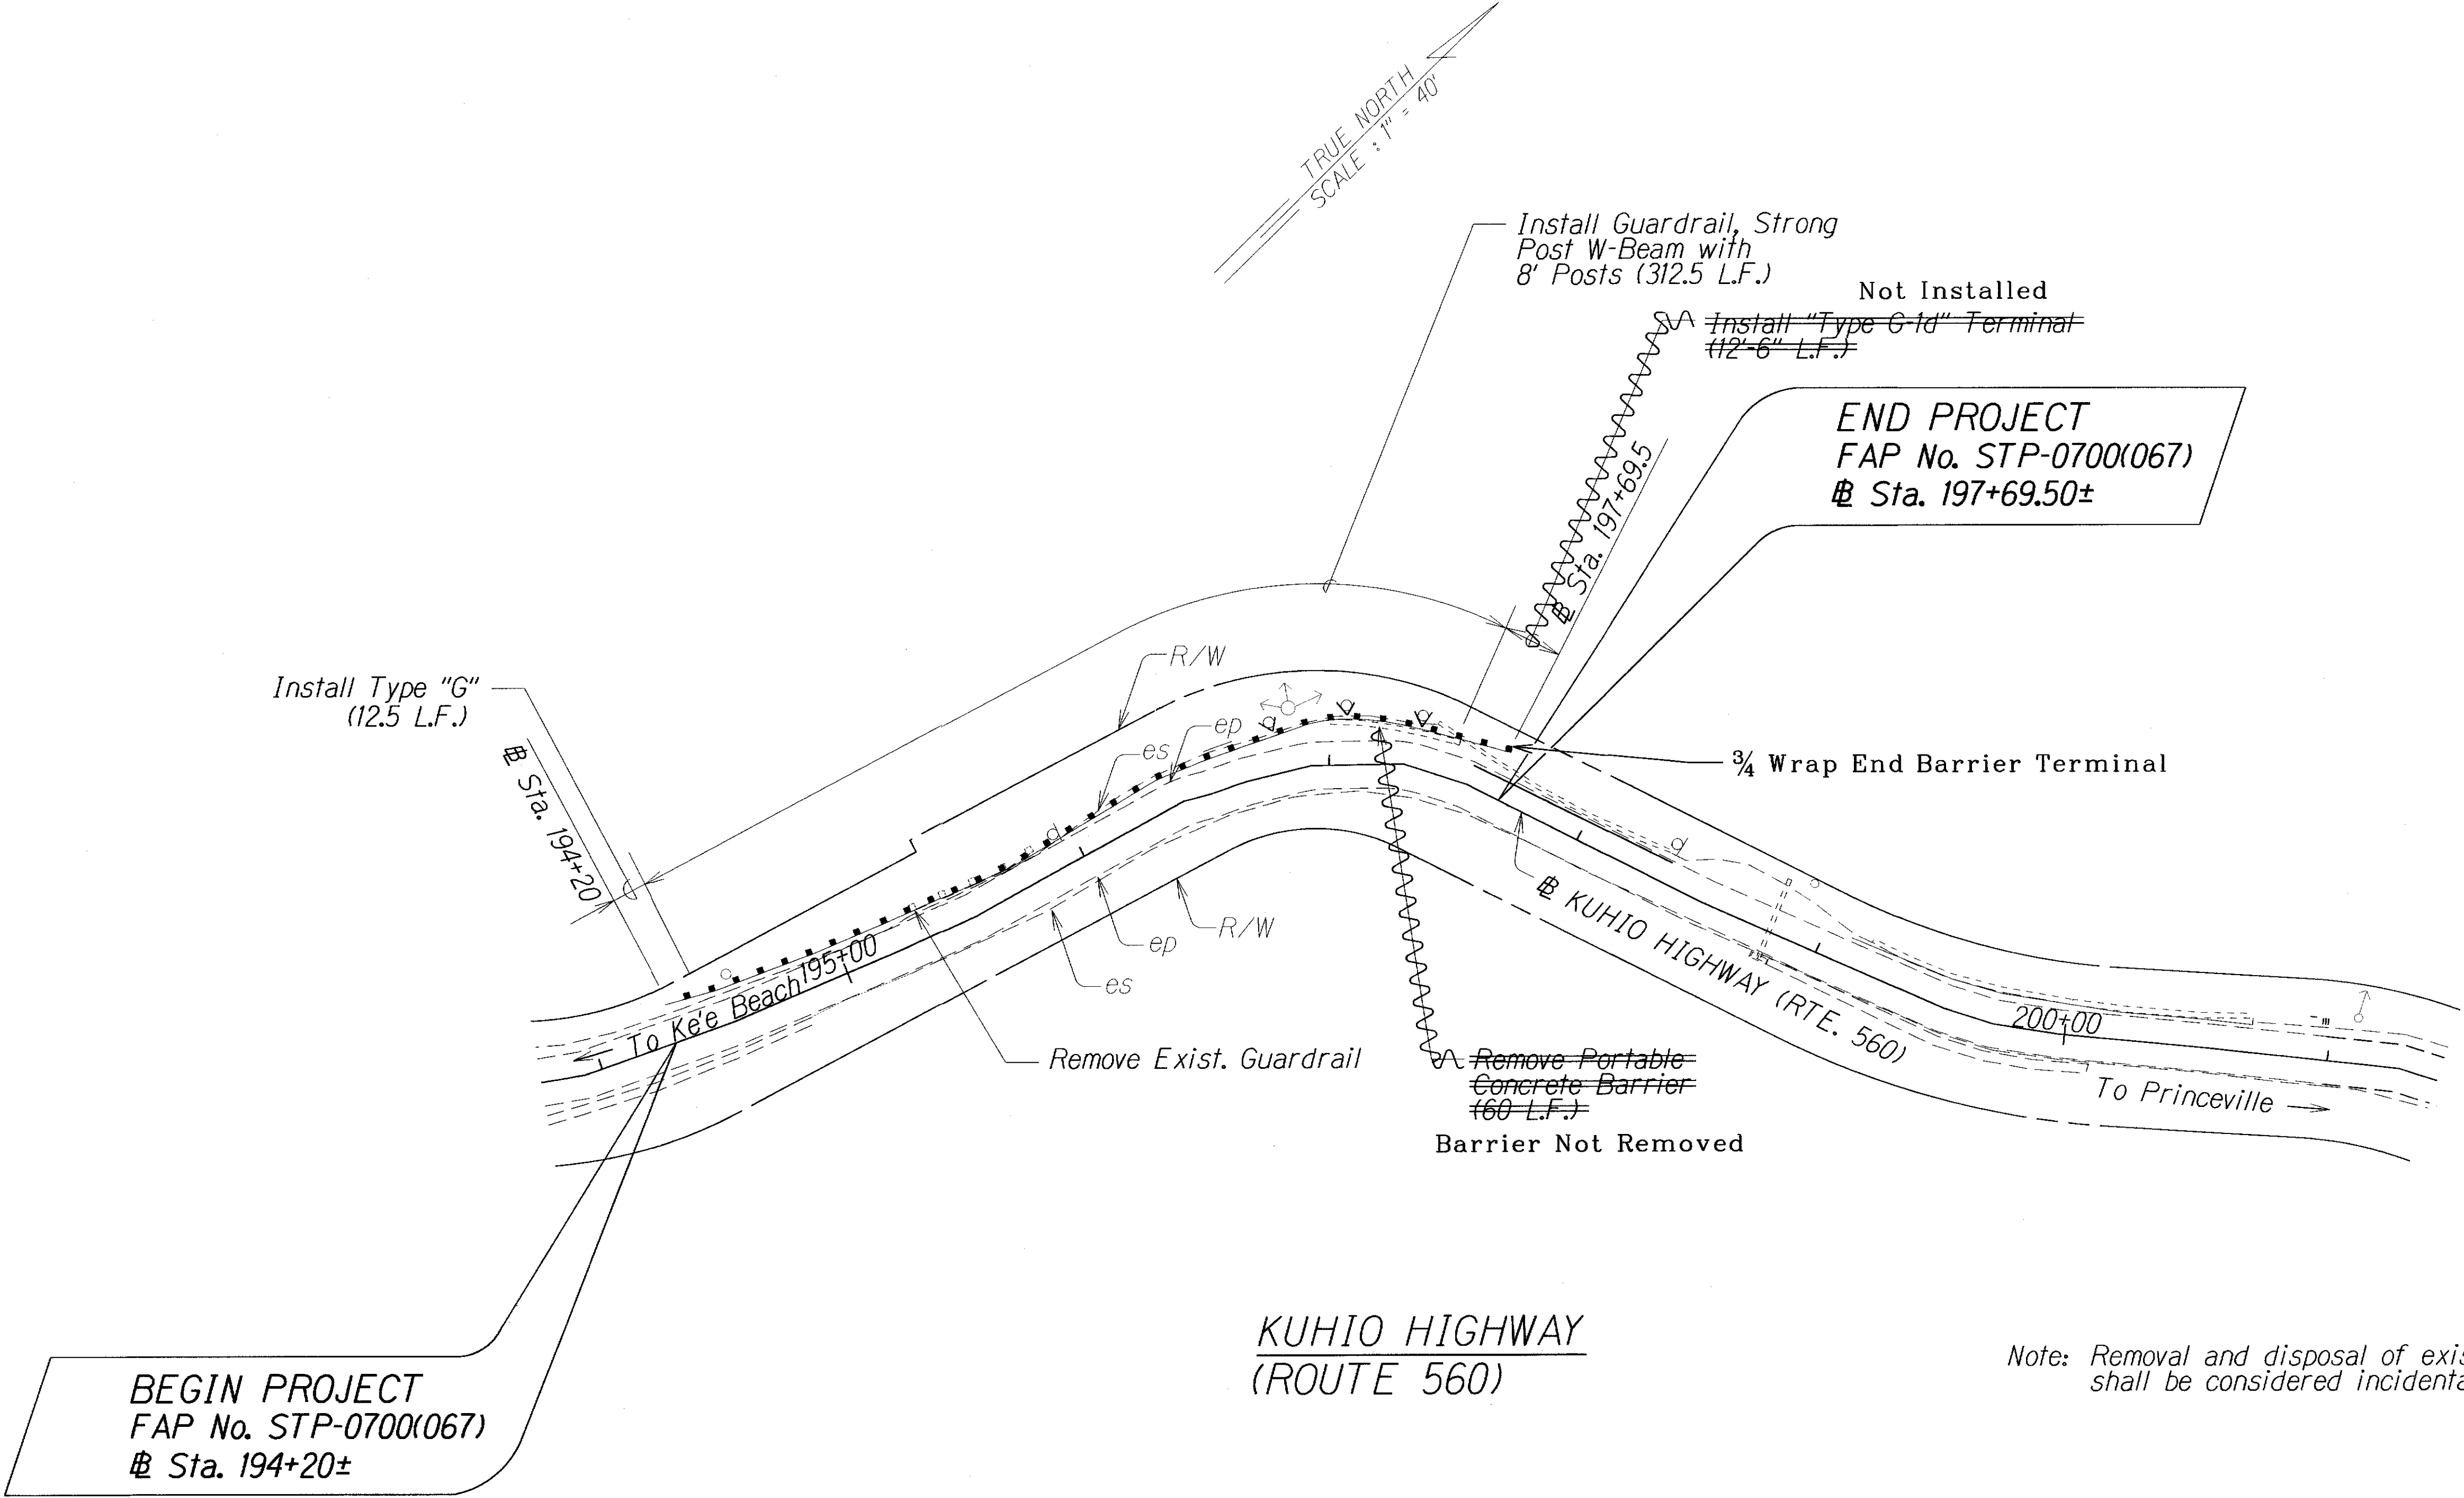

ORIGINAL PLAN	SURVEY PLOTTED BY	DATE
NOTE BOOK	DESIGNED BY	
	QUANTITIES BY	
	CHECKED BY	

LEGEND FOR AS-BUILT POSTINGS	
	Squiggly line for as-built deletion
	Double line for as-built deletion
Roadway	Text for as-built posting

STATE OF HAWAII
DEPARTMENT OF TRANSPORTATION
HIGHWAYS DIVISION
ROADWAY PLAN
GUARDRAIL AND SHOULDER IMPROVEMENTS
AT VARIOUS LOCATIONS
Kuhio Highway, ROUTE 56 (M.P. 3.70)
Kuhio Highway, ROUTE 560 (M.P. 6.25)
Fed-Aid Proj. No. STP-0700(067)
Scale: 1" = 40' Date: October 2015
SHEET No. 2 OF 2 SHEETS

"AS-BUILT"