

INDEX TO DRAWINGS	
SHEET NO.	DESCRIPTION
1	TITLE SHEET
2	STANDARD PLANS SUMMARY
3	GENERAL NOTES & LEGEND
4 – 6	WATER POLLUTION AND EROSION CONTROL NOTES
7 – 8	GUARDRAIL WORK ITEMS
9	MISCELLANEOUS DETAILS
10	GUARDRAIL DETAILS & NOTES
11	31" W-BEAM GUARDRAIL WITH STANDARD 8" OFFSET BLOCK
12	MIDWEST GUARDRAIL SYSTEM WITH NO BLOCKOUTS
13	MGS LONG SPAN LSC-2
14	MGS TRANSITION TO STRONG POST GUARDRAIL
15	LOW SPEED UNDIVIDED HIGHWAY WORK ZONE SIGNING PLAN, NOTES & DETAILS
16	LOW SPEED DIVIDED HIGHWAY WORK ZONE SIGNING PLAN, NOTES & DETAILS
17	HIGH SPEED UNDIVIDED HIGHWAY WORK ZONE SIGNING PLAN, NOTES & DETAILS

AS-BUILT DRAWINGS

This Certifies That The dimensions and details shown on this sheet reflect the dimensions and details and specifications as constructed in the field.

GLOBAL SPECIALTY CONTRACTORS, INC


Signature Date

MAY 2021 DATE
241-3000 PHONE
HVVY-KE MANAGED BY
HVVY-K DESIGNED BY

STATE OF HAWAII
DEPARTMENT OF TRANSPORTATION
HIGHWAYS DIVISION
HONOLULU, HAWAII
"AS-BUILT"
PLANS FOR
GUARDRAIL AND SHOULDER IMPROVEMENTS
AT VARIOUS LOCATIONS, PART 6
PROJECT NO. STP-0700(086)



DISTRICTS OF KOLOA, LIHUE,
KAWAIHAU AND HANAIEI
ISLAND OF KAUAI

PROJECT LOCATION #5
Kuhio Highway (Rte. 560)

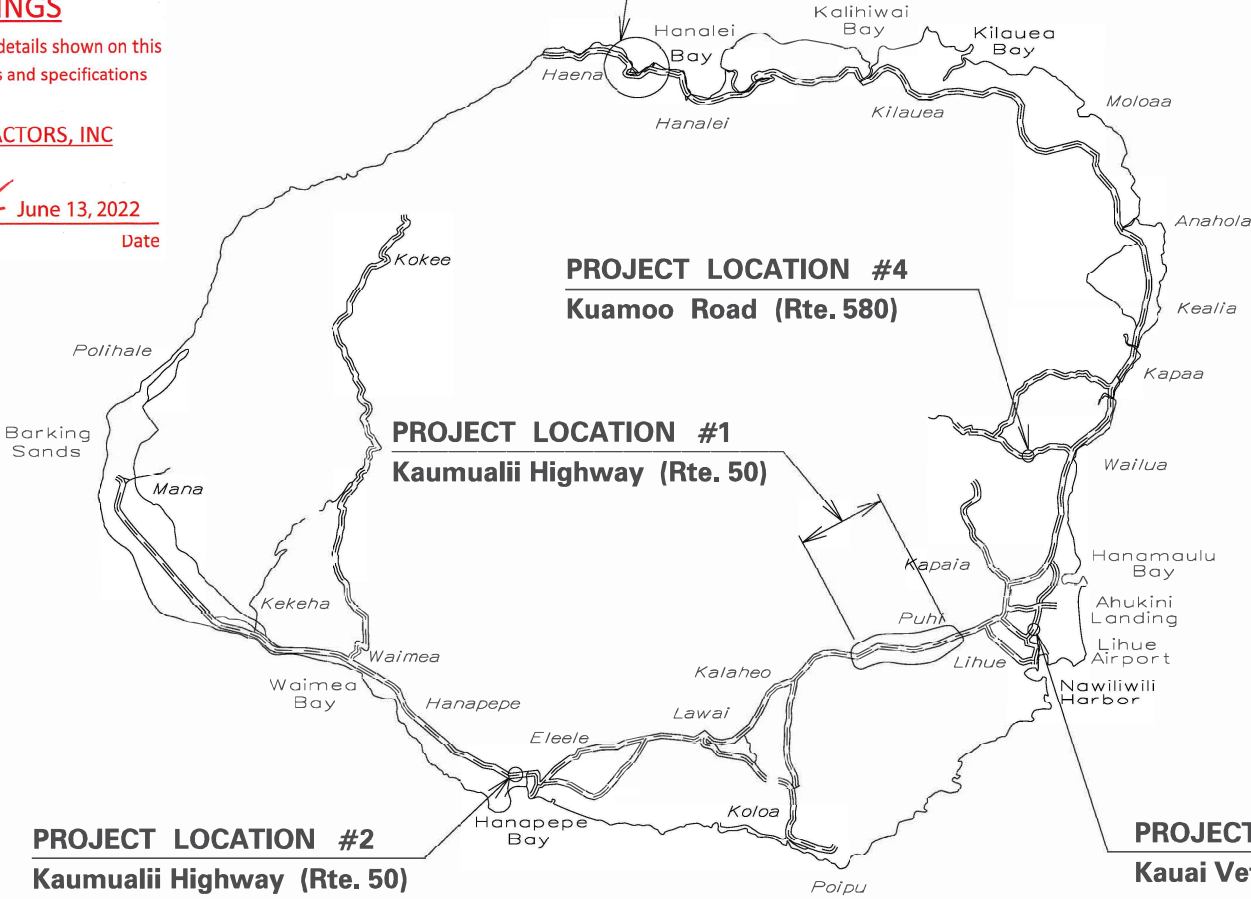

LAYOUT PLAN
NOT TO SCALE

FED. ROAD DIST. NO.	STATE	PROJ. NO.	FISCAL YEAR	SHEET NO.	TOTAL SHEETS
HAWAII	HAW.	STP-0700(086)	2021	1	17

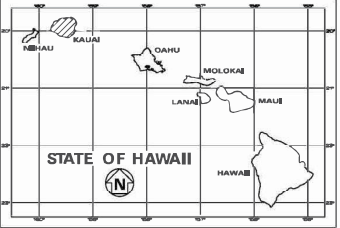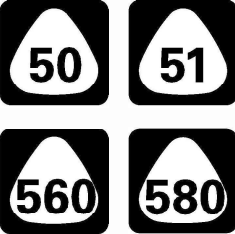

FEDERAL AID PROJECTS PREVIOUSLY CONSTRUCTED OR UNDER CONSTRUCTION

MILE POST 1.84 TO MILE POST 3.57 (RTE. 50)

MILE POST 16.95 (RTE. 50)

MILE POST 1.24 (RTE. 51)

MILE POST 2.51 (RTE. 580)

MILE POST 6.96 TO MILE POST 7.03 (RTE. 560)

DESIGN DESIGNATION

KAUMUALII HIGHWAY (Rte 50)		
	MP 1.84 to 3.70 Anonui St. to Cane Haul Rd.	MP 15.95 to 17.05 Waialo Rd. to Lele Rd.
2021 ADT	30,500	21,100
2031 ADT	34,500	25,700
2031 DHV	2,930	2,180
Design K	8.5	8.5
Design D	60/40	55/45
Design T	4.5	4.0
T24	5.0	5.5

KAUAI VETERANS MEMORIAL HIGHWAY (Rte 51)	
	MP 0.90 to 1.95 Rice St/Kapule Hwy. to Ahukini Rd.
2021 ADT	19,400
2031 ADT	23,600
2031 DHV	2,010
Design K	8.5
Design D	55/45
Design T	5.0
T24	5.5

KUHIO HIGHWAY (Rte 560)	
	MP 3.39 to 8.05 Waioli Br. to E. of Wainiha Powerhouse Rd.
2021 ADT	5,300
2031 ADT	6,400
2031 DHV	640
Design K	10.0
Design D	55/45
Design T	3.5
T24	3.5

KUAMOO ROAD (Rte 580)	
	Ohelo Rd. to Mala St. (MP 2.51)
2021 ADT	9,600
2031 ADT	10,700
2031 DHV	860
Design K	8.0
Design D	65/35
Design T	3.0
T24	3.0

DEPARTMENT OF TRANSPORTATION STATE OF HAWAII	
APPROVED:	Jul 19, 2021
for DIR. OF TRANSPORTATION	DATE