



FED. ROAD DIST. NO.	STATE	FED. AID PROJ. NO.	FISCAL YEAR	SHEET NO.	TOTAL SHEETS
KAUAI	HAW.	HWY-K-02-23M	2023	ADD.18	41

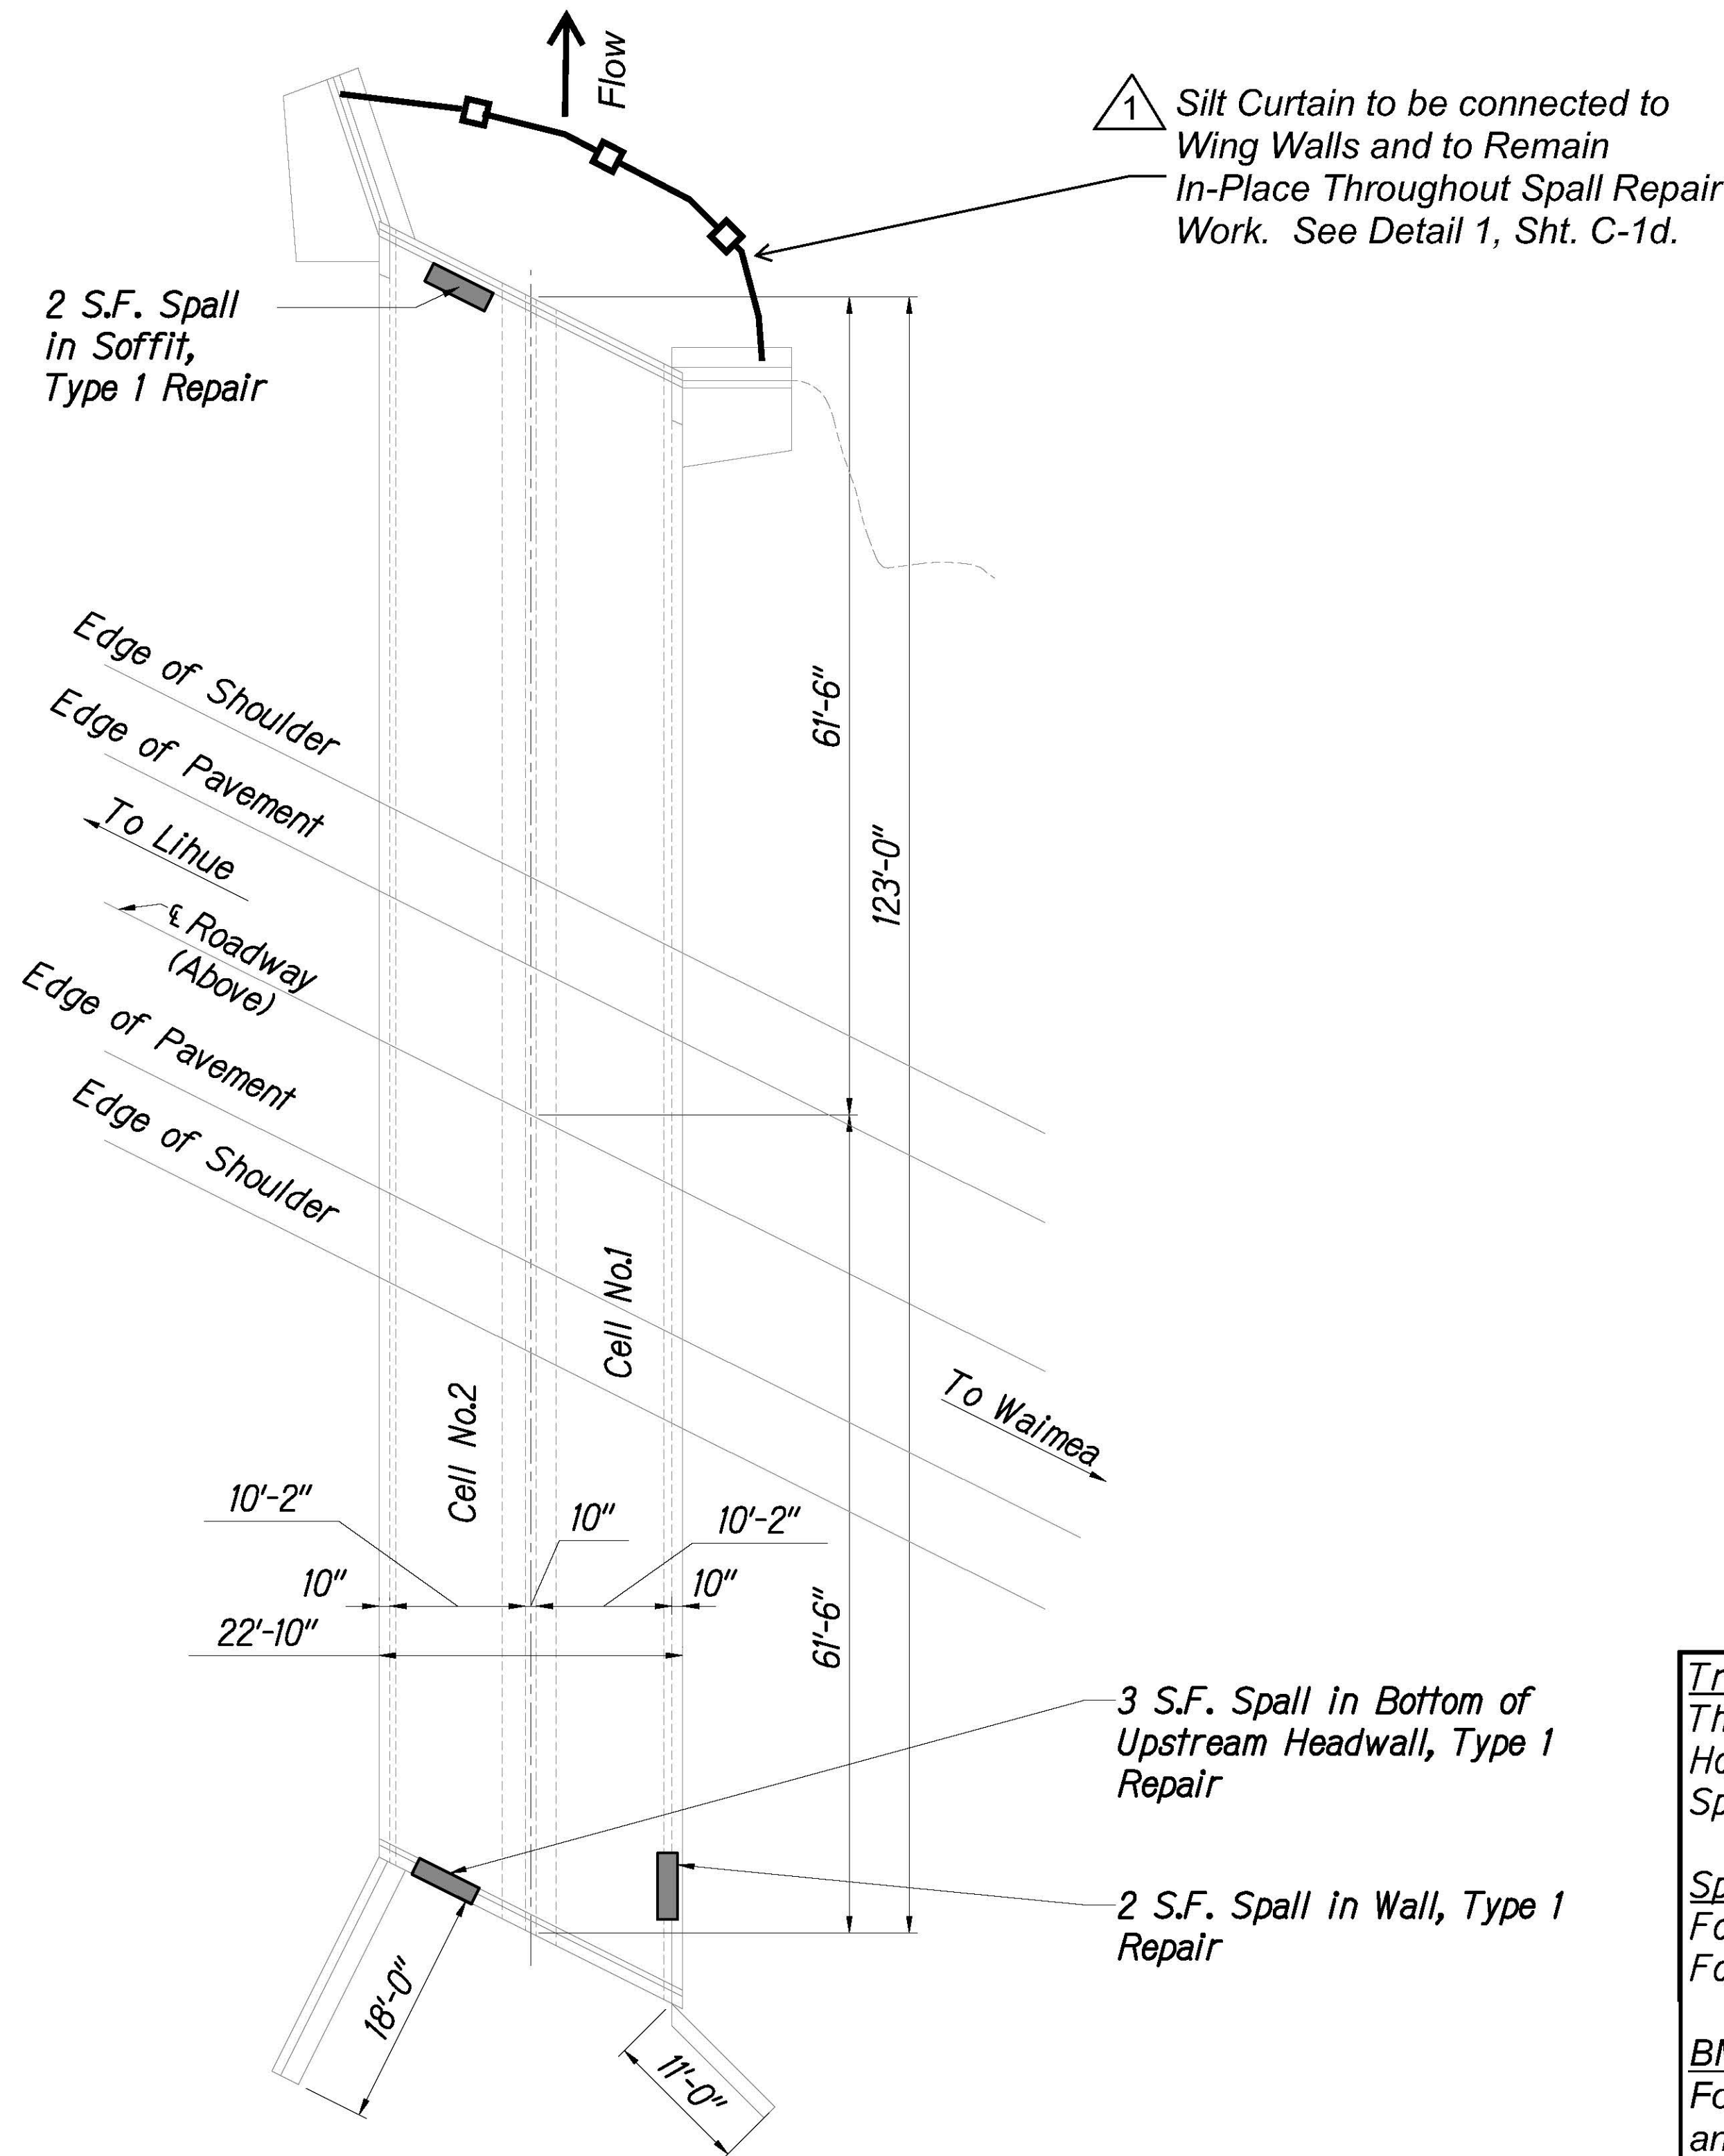

LAYOUT PLAN
Scale: 1" = 10'-0"

1
C-8 | C-8

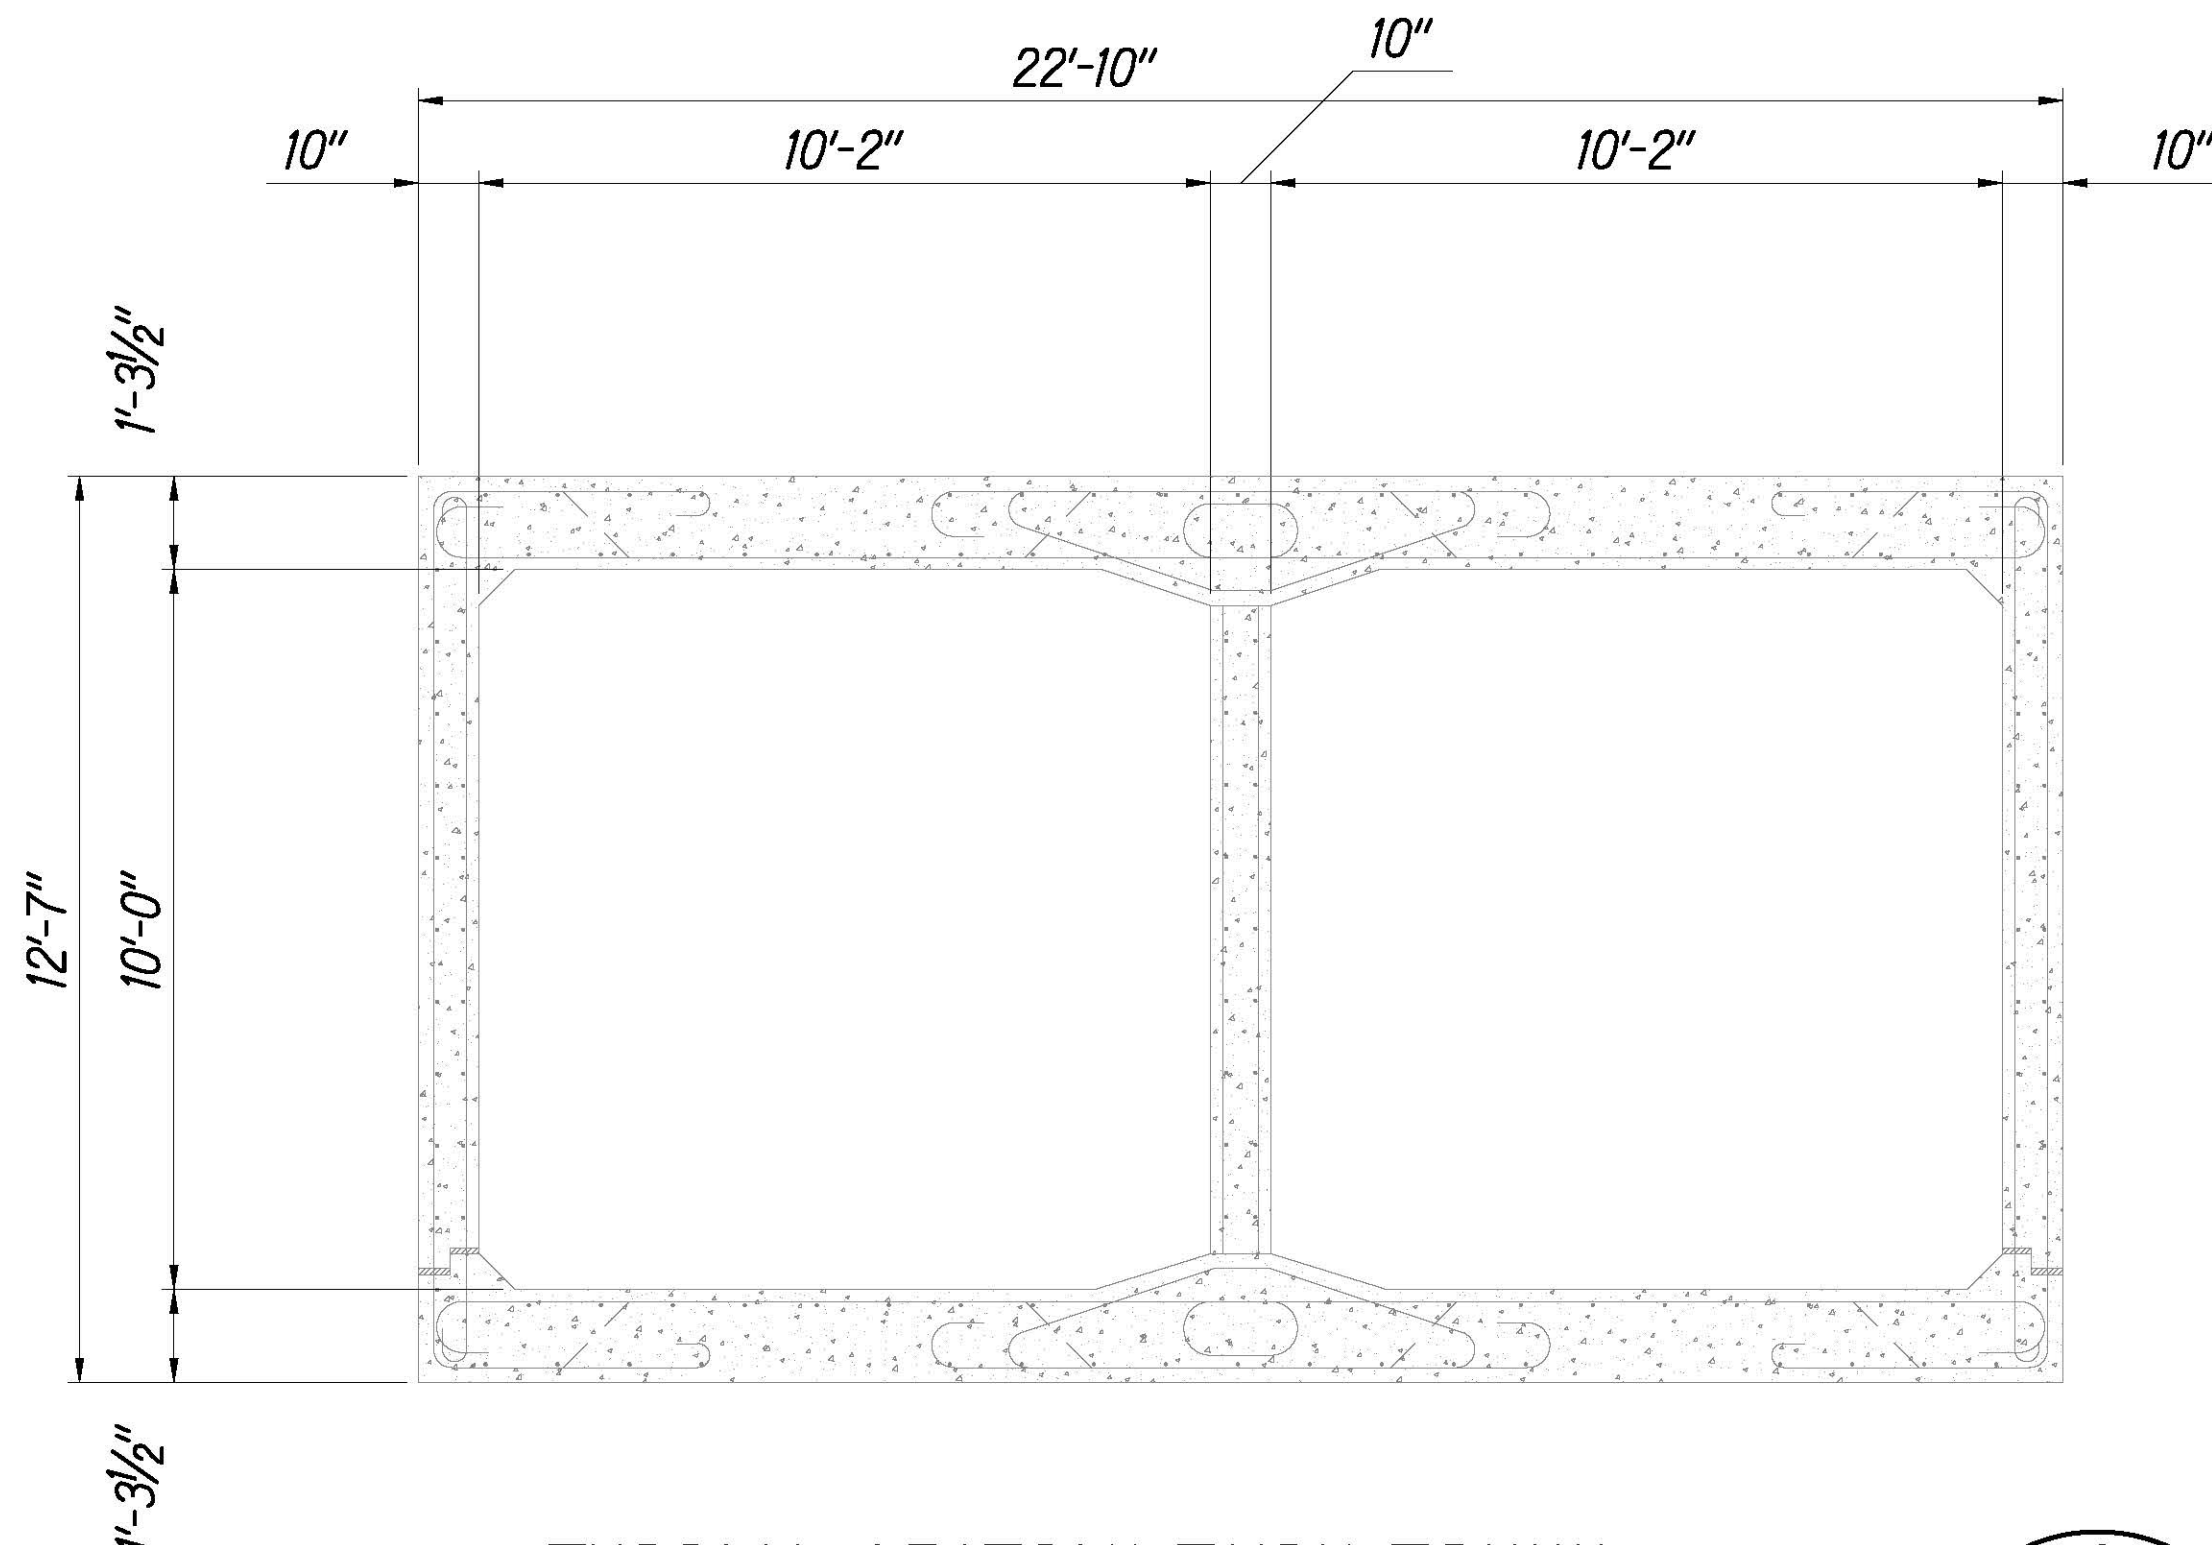

TYPICAL SECTION THRU TRUNK
Scale: 3/8" = 1'-0"

2
C-8 | C-8

Traffic Control:
The Contractor is Allowed to Place Traffic Controls for One Hour or Less at a Time. Refer to HDOT Standard Specification Section 645 for Applicable Traffic Control Plan.

Spall Repairs:
For Spall Repair Notes, See Sheet C-1E.
For Spall Repair Details, See Sheet C-1F.

BMP's:
For Water Pollution and Erosion Control Notes, See Sht. C-1c and Sht. C-1d.
For BMP Details, See Sht. C-1d.

ORIGINAL PLAN	SURVEY PLOTTED BY	DATE
NOTE BOOK	DRAWN BY	
	TRACED BY	
	DESIGNED BY	
	CHECKED BY	



6/9/23	- Added Details
DATE	REVISION
STATE OF HAWAII DEPARTMENT OF TRANSPORTATION HIGHWAYS DIVISION HOINAKAUNALEHUA STREAM BRIDGE MINOR BRIDGE REPAIRS AT VARIOUS LOCATIONS, PART 1 KAUAI, HAWAII PROJECT NO. HWY-K-02-23M Scale: As Shown Date: May 2023	
C-8	SHEET No. 18 OF 41 SHEETS