
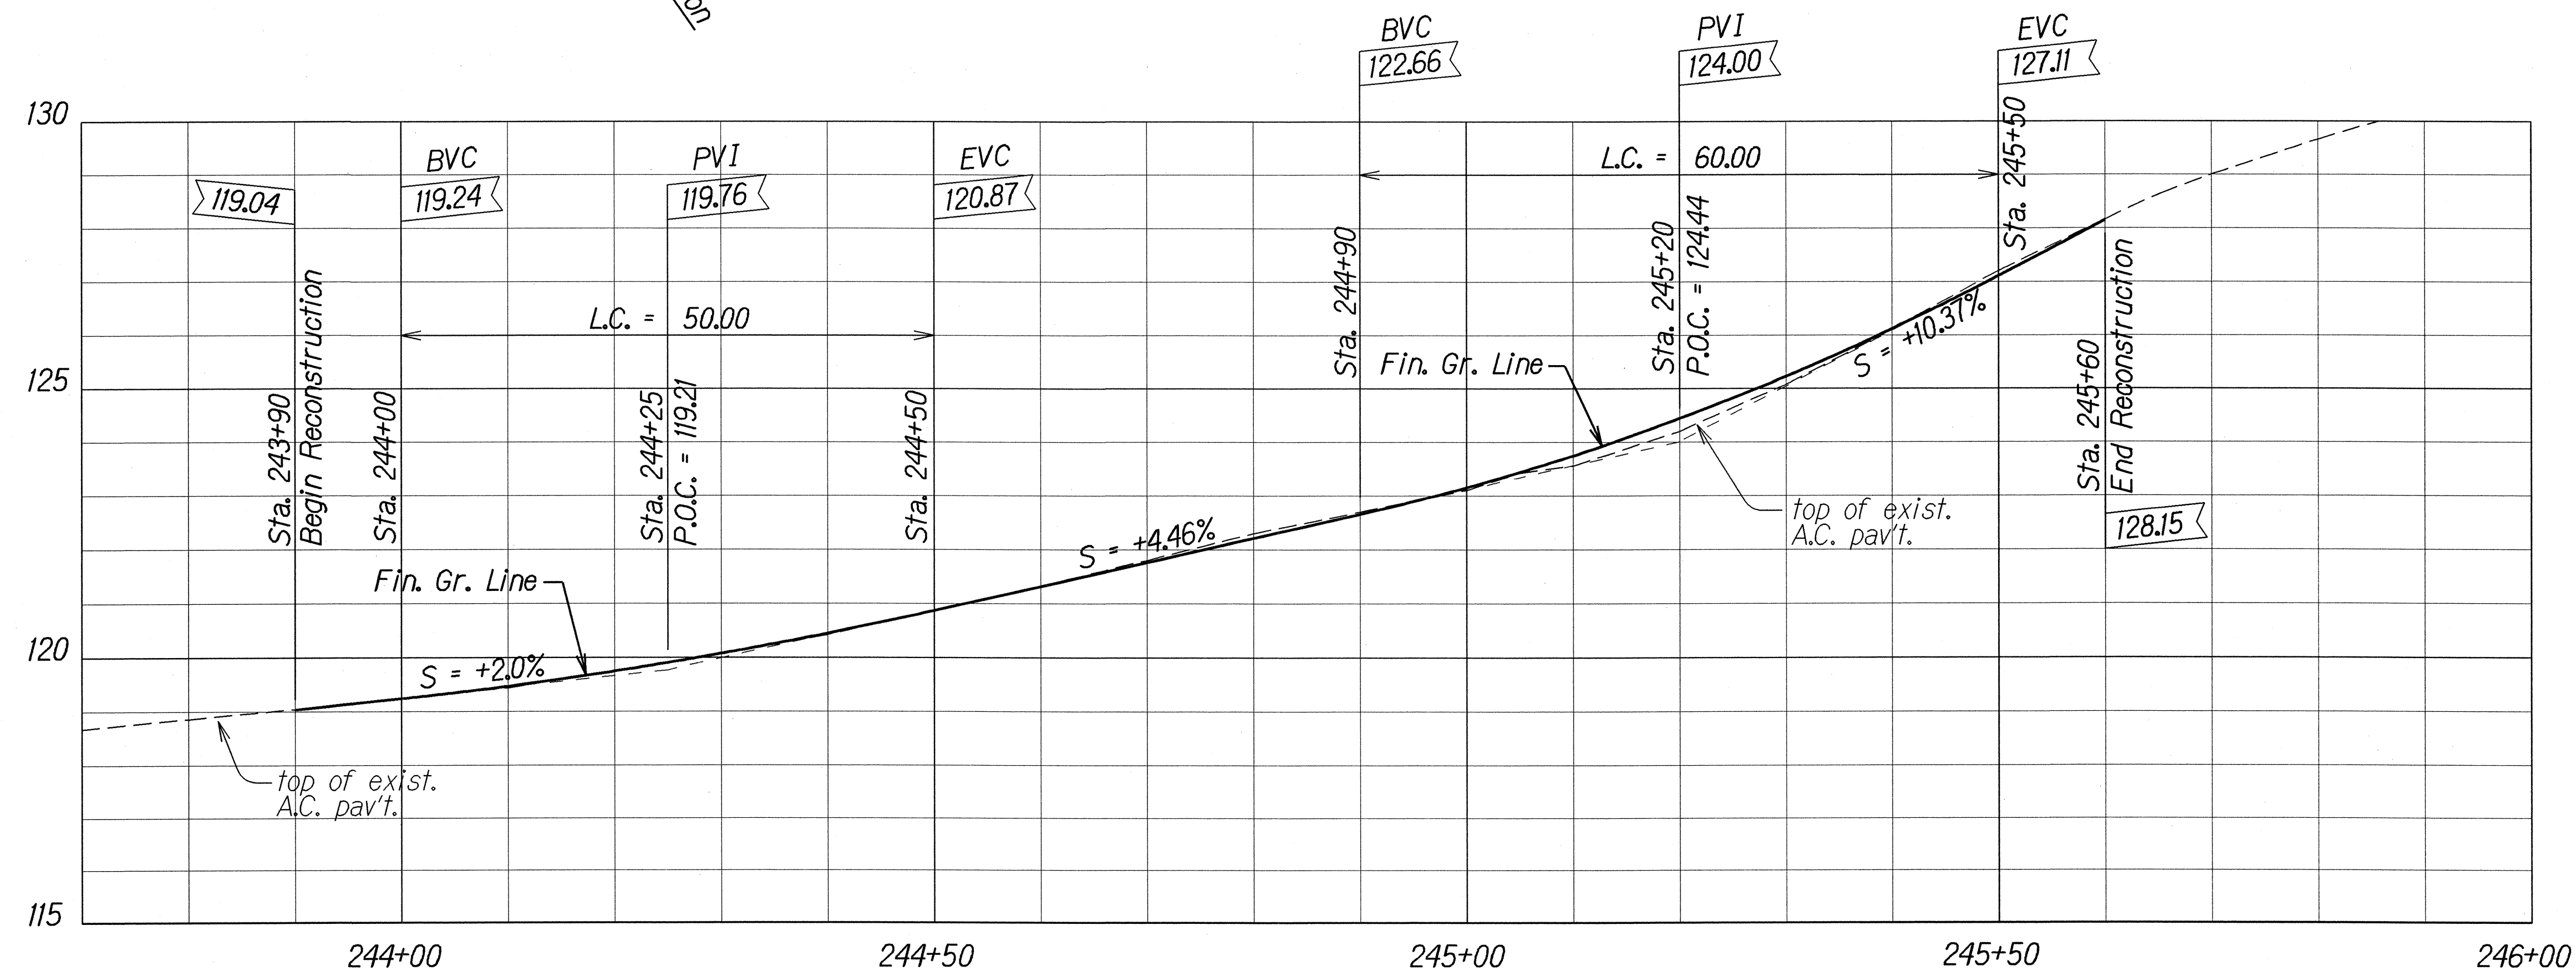


FED. ROAD DIST. NO.	STATE	PROJ. NO.	FISCAL YEAR	SHEET NO.	TOTAL SHEETS
HAWAII	HAW.	HWY-K-03-04M	2004	14	20

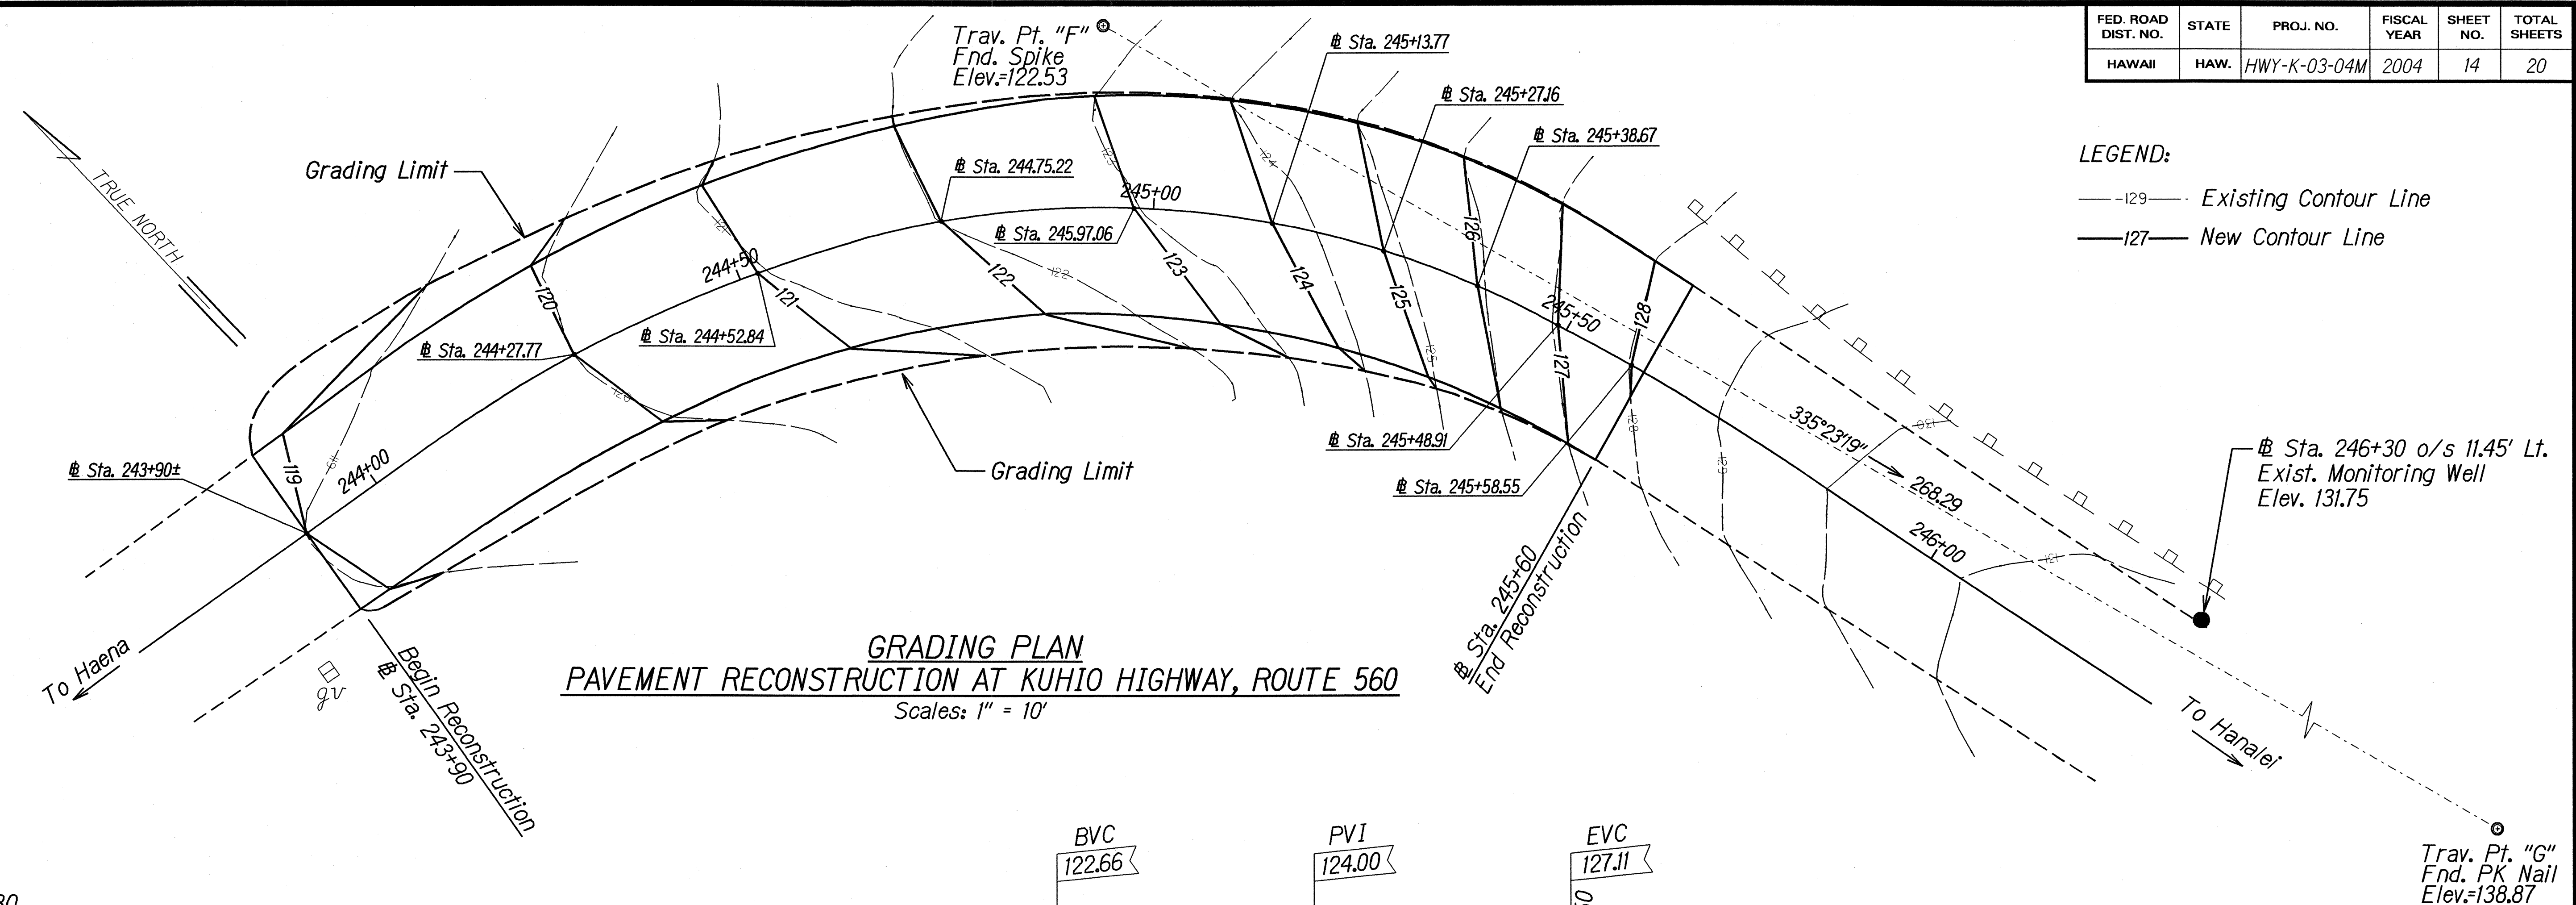

BENCHMARK:
Trav. Pt. "G" (Fnd. PK Nail) located at the widened A.C. pavement, in front of lookout at east side of travel way. Elev.=138.87

DESIGNED BY	DATE
DRAWN BY	2/25/04
CHECKED BY	
NOTED BY	
QUANTITIES BY	
CHECKED BY	

STATE OF HAWAII
DEPARTMENT OF TRANSPORTATION
HIGHWAYS DIVISION

GRADING PLAN & PROFILE
KAUMUALII HIGHWAY & KUHIO HIGHWAY
Miscellaneous Pavement Reconstruction/
Resurfacing at Various Locations
Project No. HWY-K-03-04M

Scale: As Shown Date: May 2004

SHEET No. 1 OF 1 SHEETS