

INDEX TO DRAWINGS	
SHEET NO.	DESCRIPTION
1	TITLE SHEET
2	TYPICAL ROAD SECTIONS & MISCELL. DET.
3	PLAN & PROFILE
4	CL MON. & GUARD RAIL LOCATION
4	MISCELLANEOUS DETAILS
5	METAL GUARD RAIL DETAILS
6	CROSS SECTIONS

DIST. NO.	STATE	PROJ. NO.	FISCAL YEAR	SHEET NO.	TOTAL SHEETS
HAWAII	HAW	G-3325-02-63	1964	1	6

STATE OF HAWAII

DEPARTMENT OF TRANSPORTATION

HIGHWAYS DIVISION

"AS BUILT"


PLANS OF

POIPU BEACH ROAD


PROJECT NO. G-3325-02-63

DISTRICT OF KOLOA

ISLAND OF KAUAI

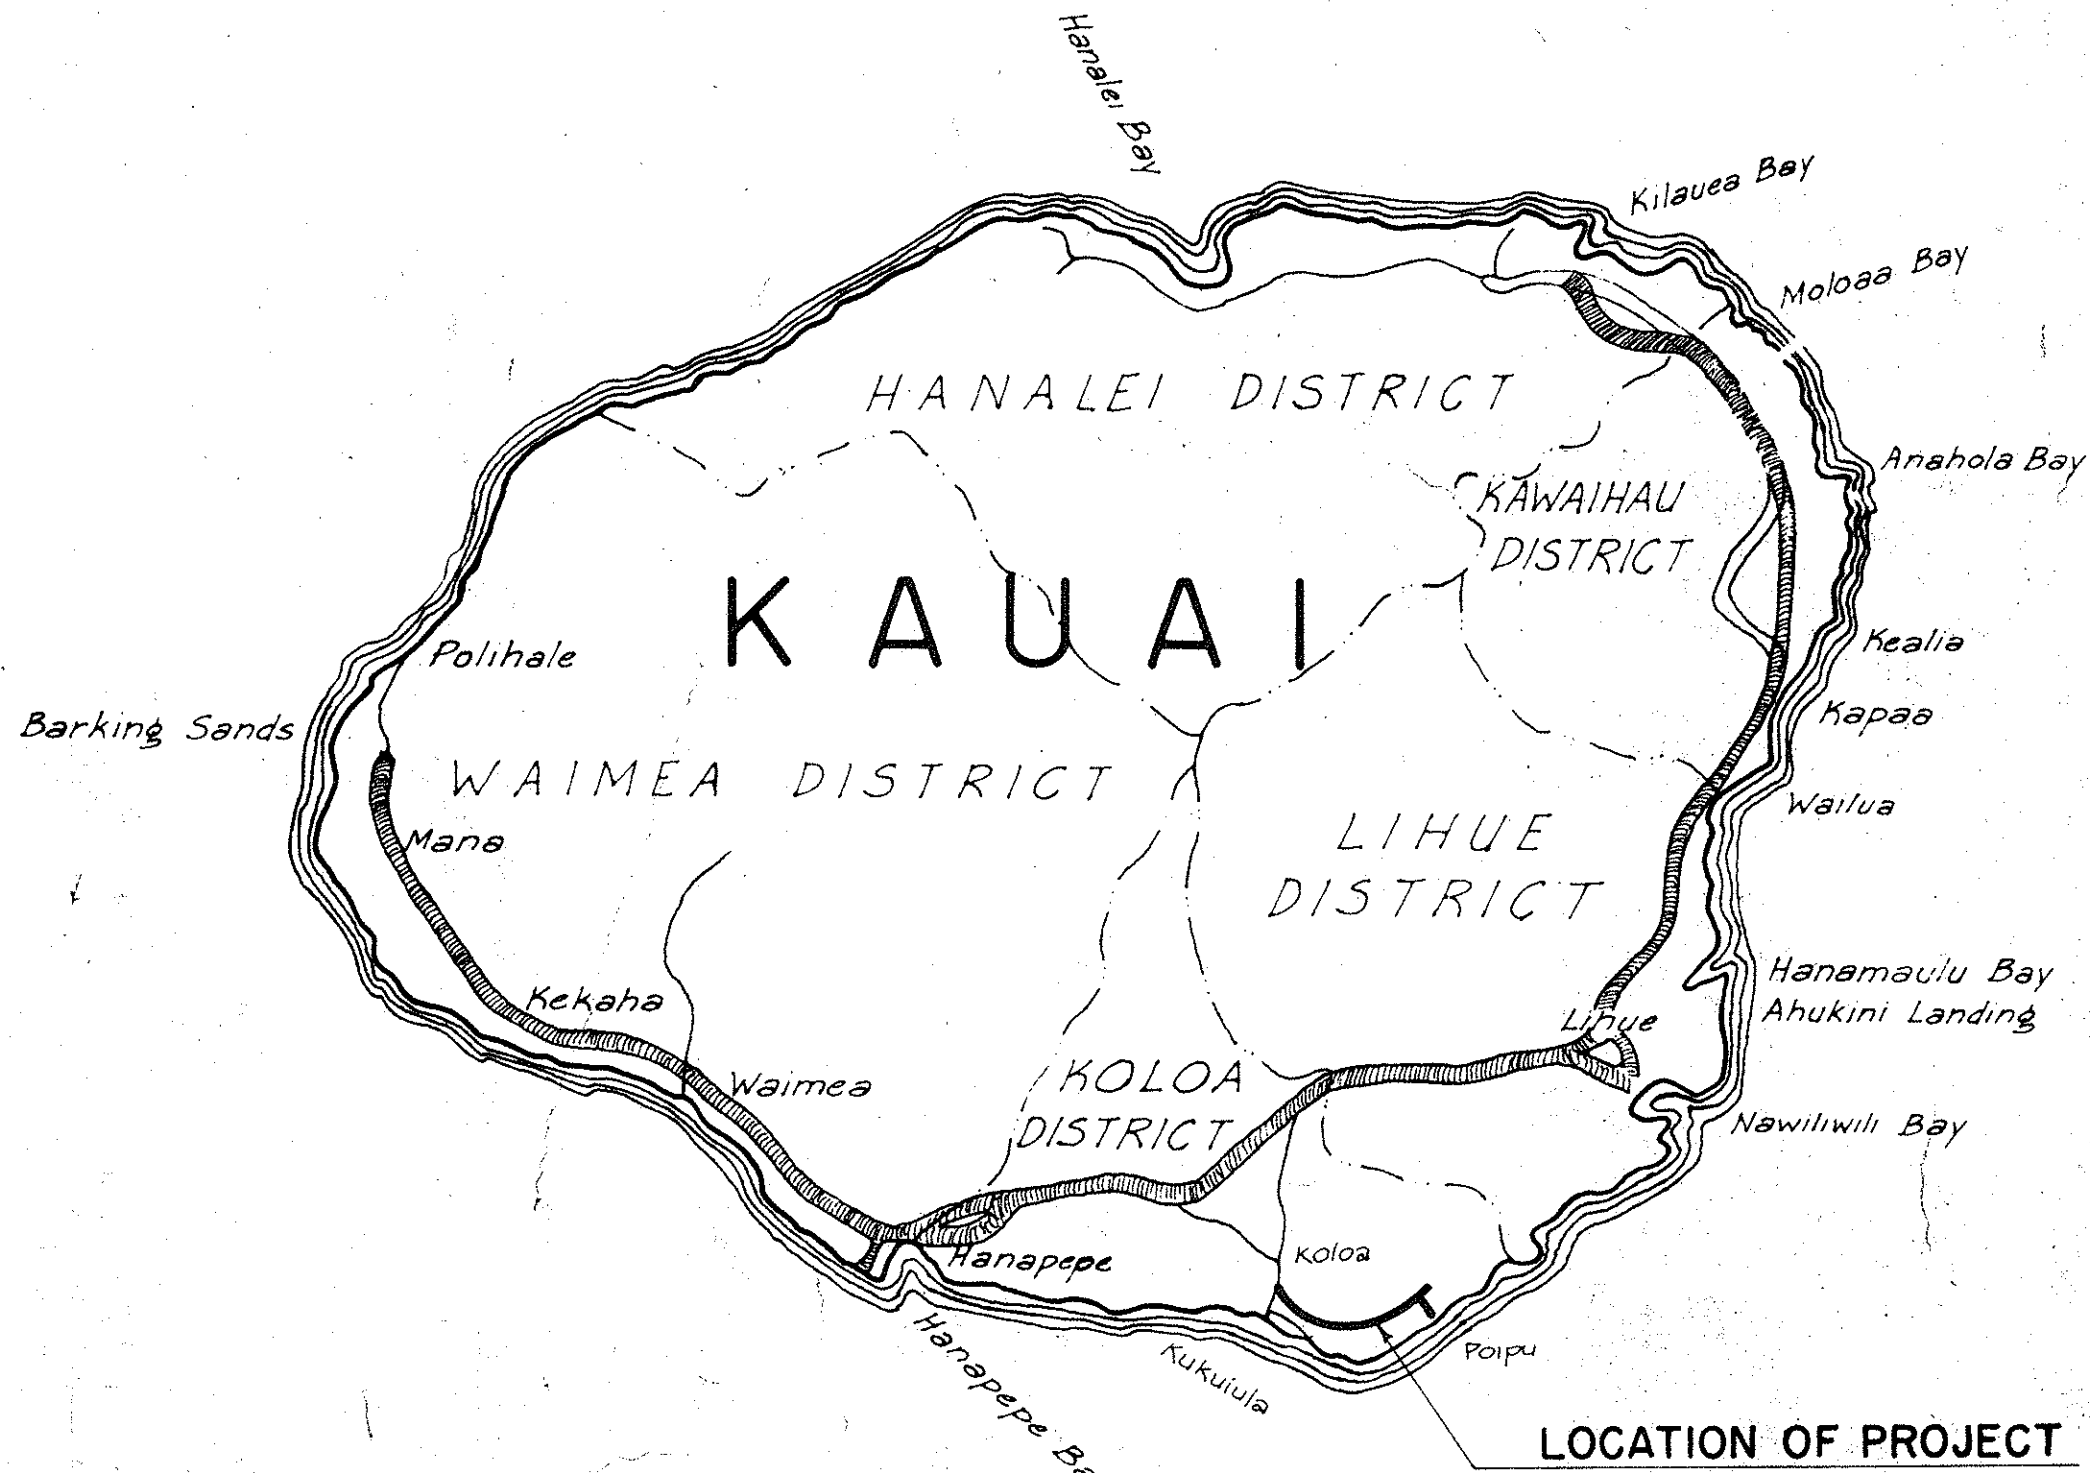

SCALES	
PLAN	1" = 50 FT.
PROFILE	HOR. 1" = 50 FT.
	VERT. 1" = 10 FT.
CROSS SECTION	HOR. 1" = 10 FT.
	VERT. 1" = 10 FT.

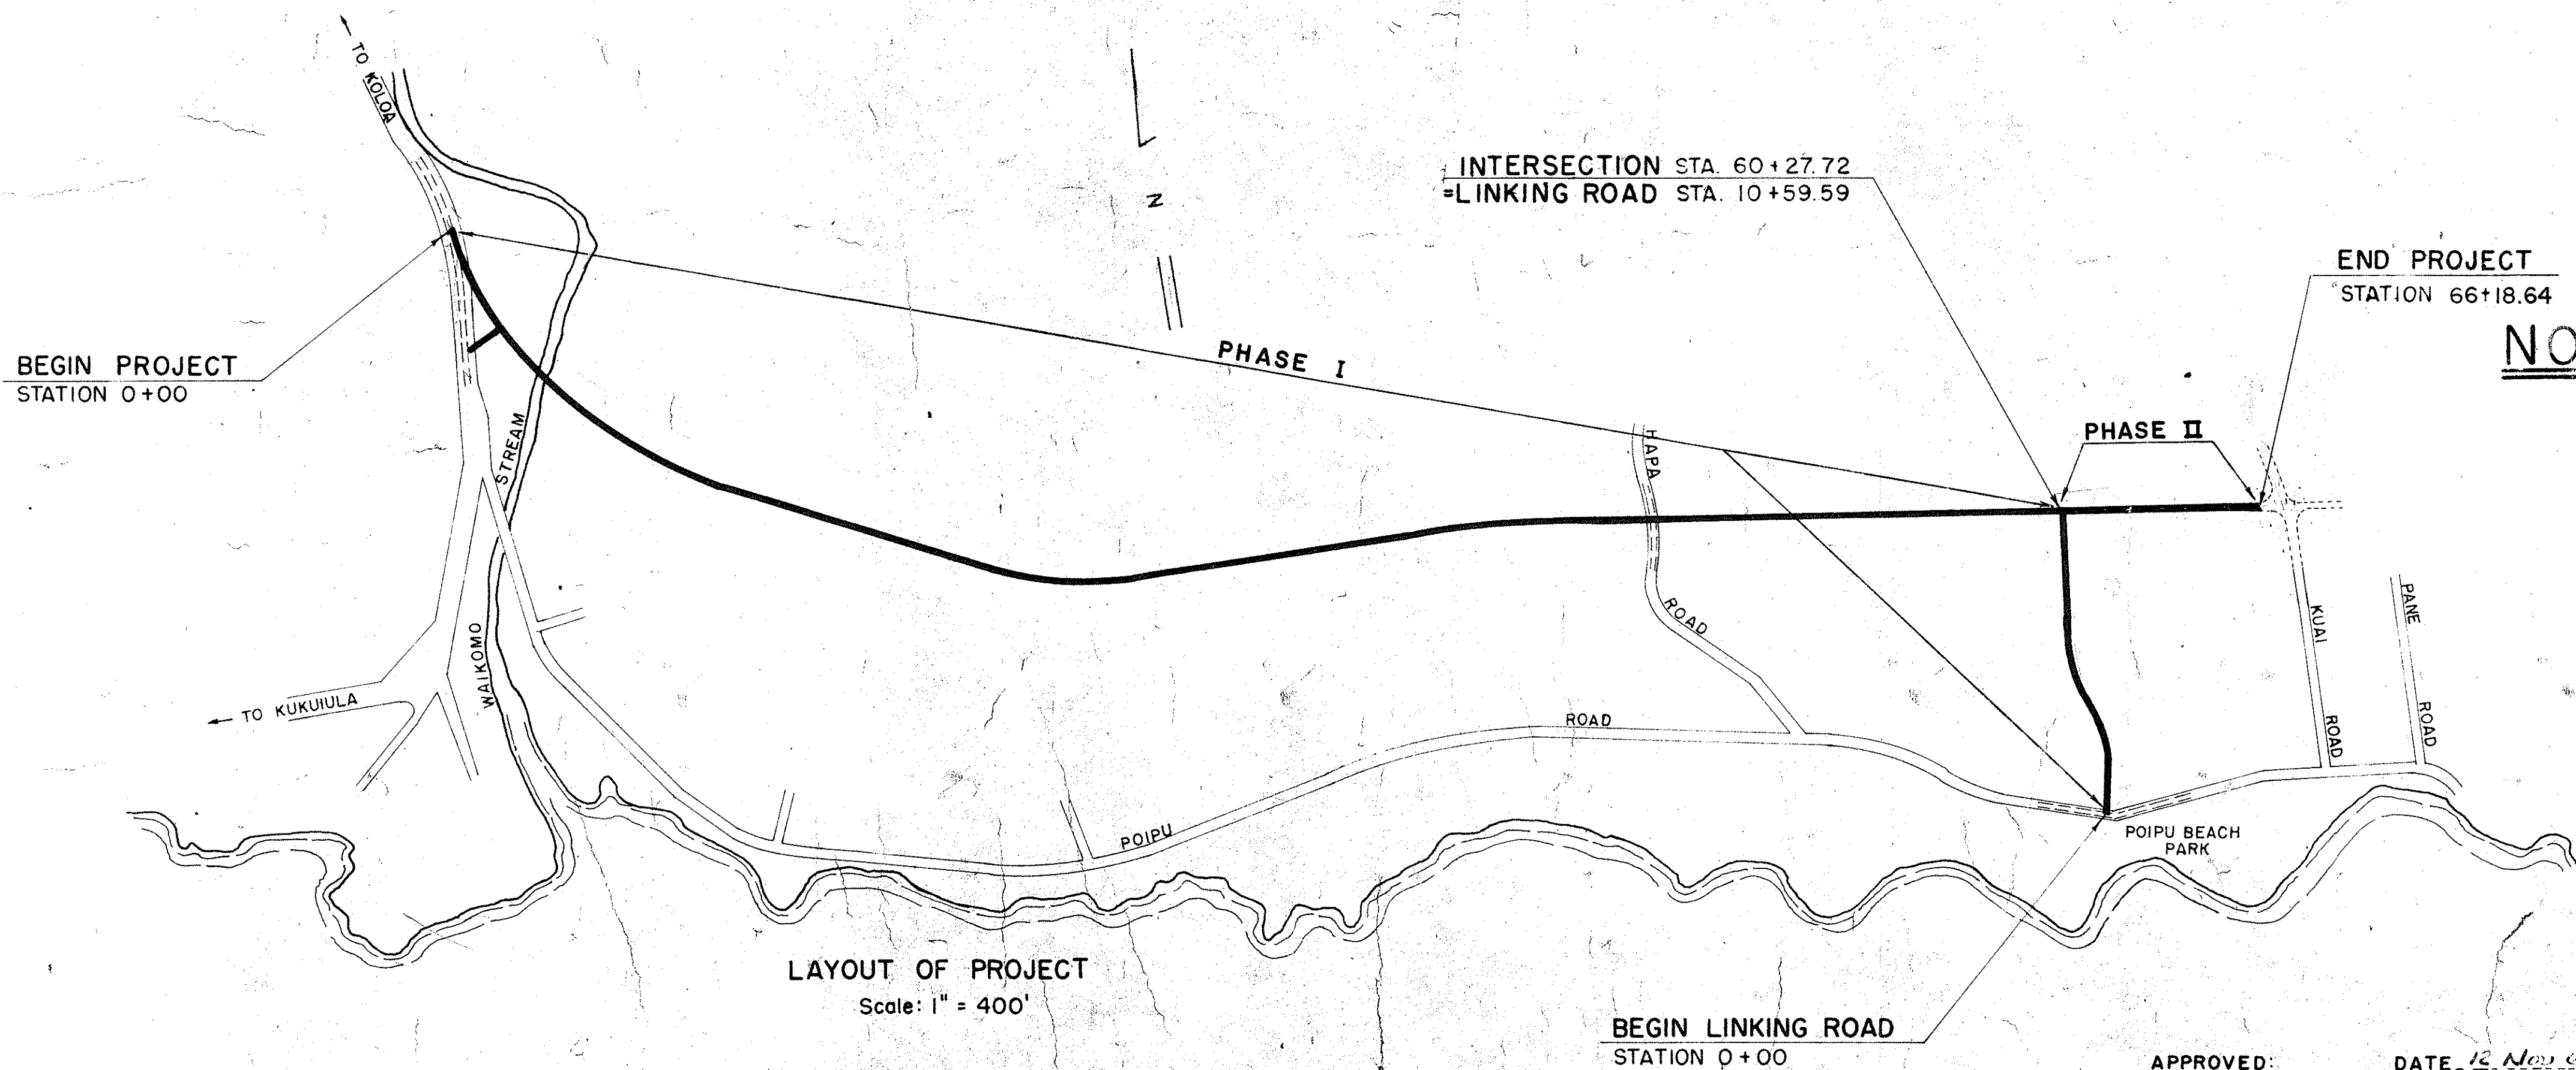

NOTE
ALL CHANGES MADE DURING CONSTRUCTION HAVE BEEN NOTED IN RED ON THESE TRACINGS AND CHECKED BY

Donald Nagamine
PROJECT ENGINEER
9 Mar 67
DATE

JOHN, LOW, TOM & HARA, INC.
CONSULTING ENGINEERS

DESIGN CLASSIFICATION	
A. D. T. (1962)	= 500
A. D. T. (1982)	= 1700
D. H. V.	= 10%
D.	= 60/40
T.	= 2%
V.	= 50 MPH
30 MPH FOR LINKING RD	

LAYOUT OF PROJECT	
Scale: 1" = 400'	
Length of Main Highway	= 1.254 Miles
Length of Linking Road	= 0.201 Miles
Total Length	= 1.455 Miles

BEGIN LINKING ROAD
STATION 0+00

APPROVED: DATE 12 Nov 64

Luigi Matamoros
DIRECTOR, DEPARTMENT OF TRANSPORTATION

DATE