




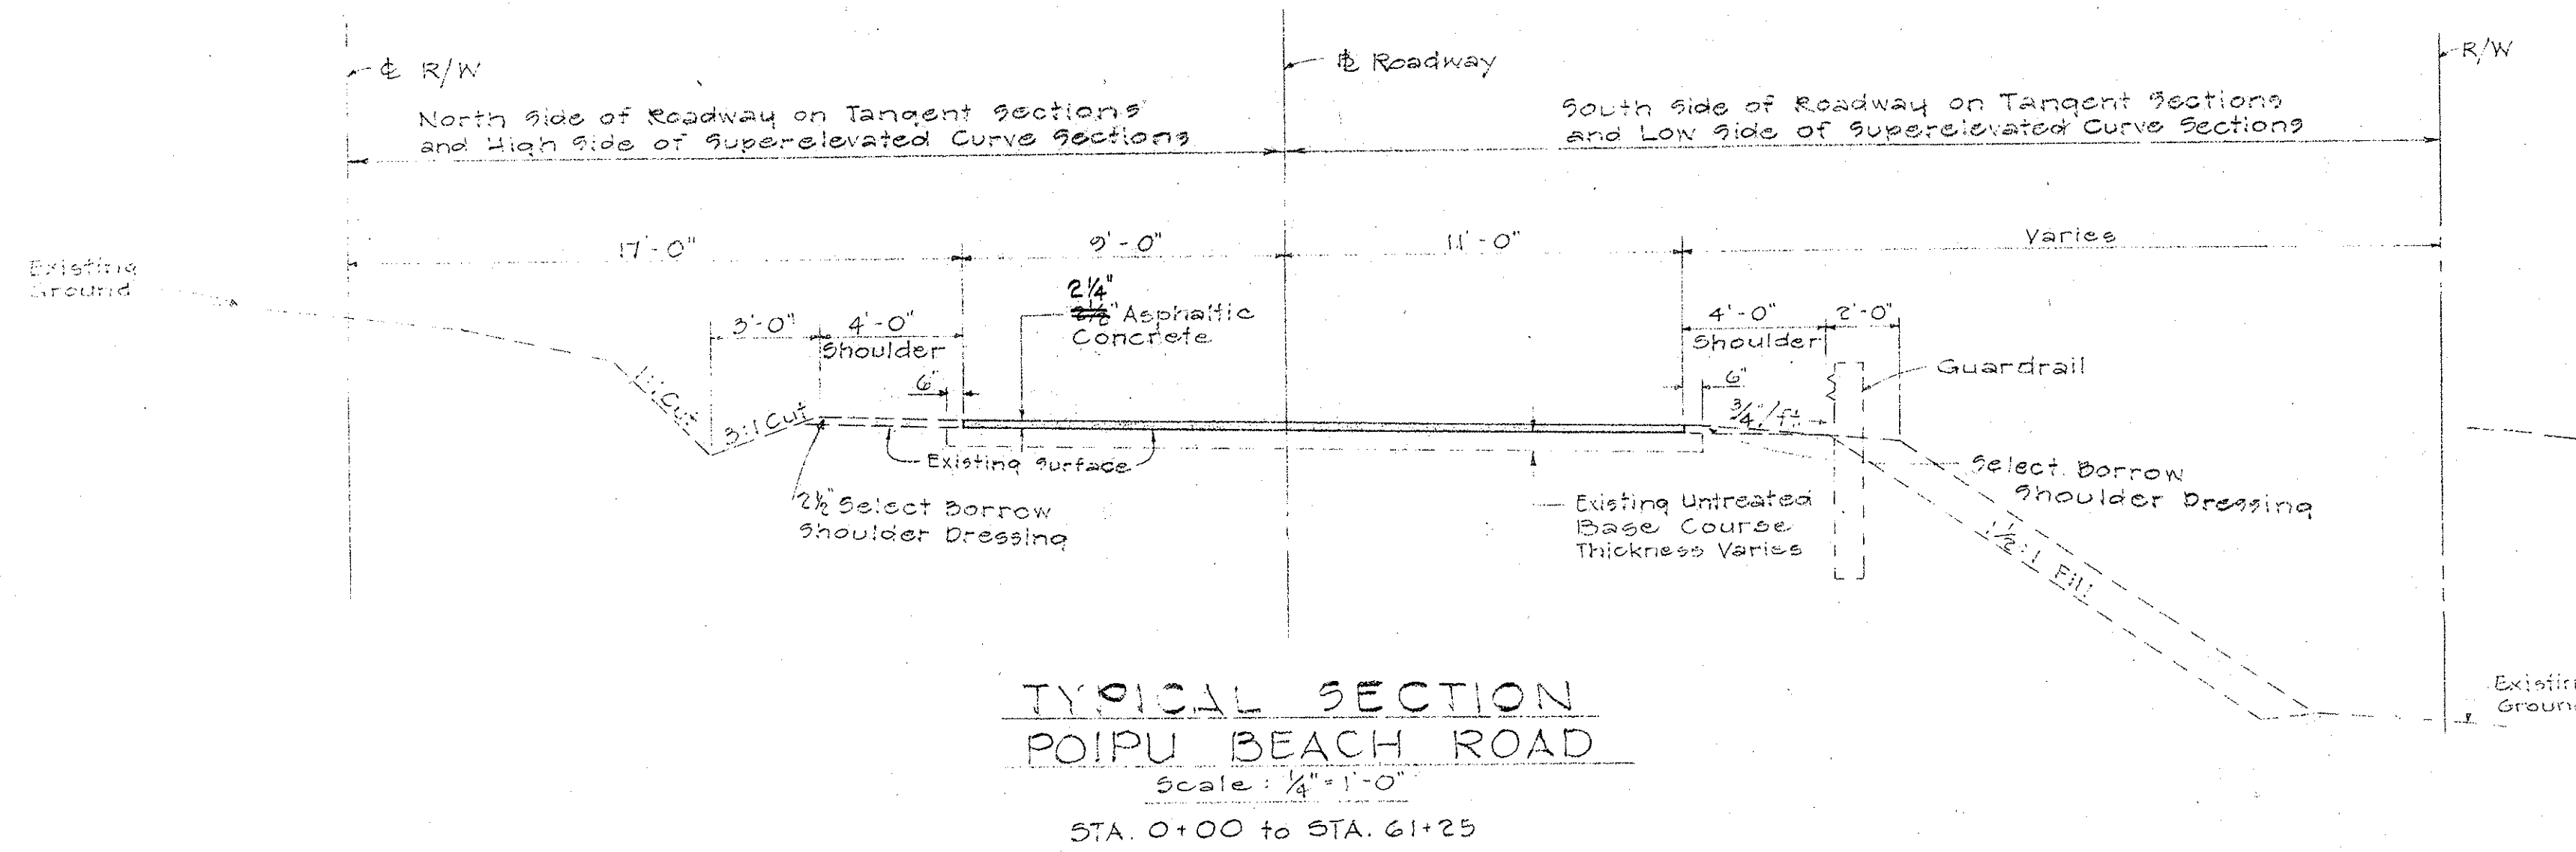


(PHASE I WORK)

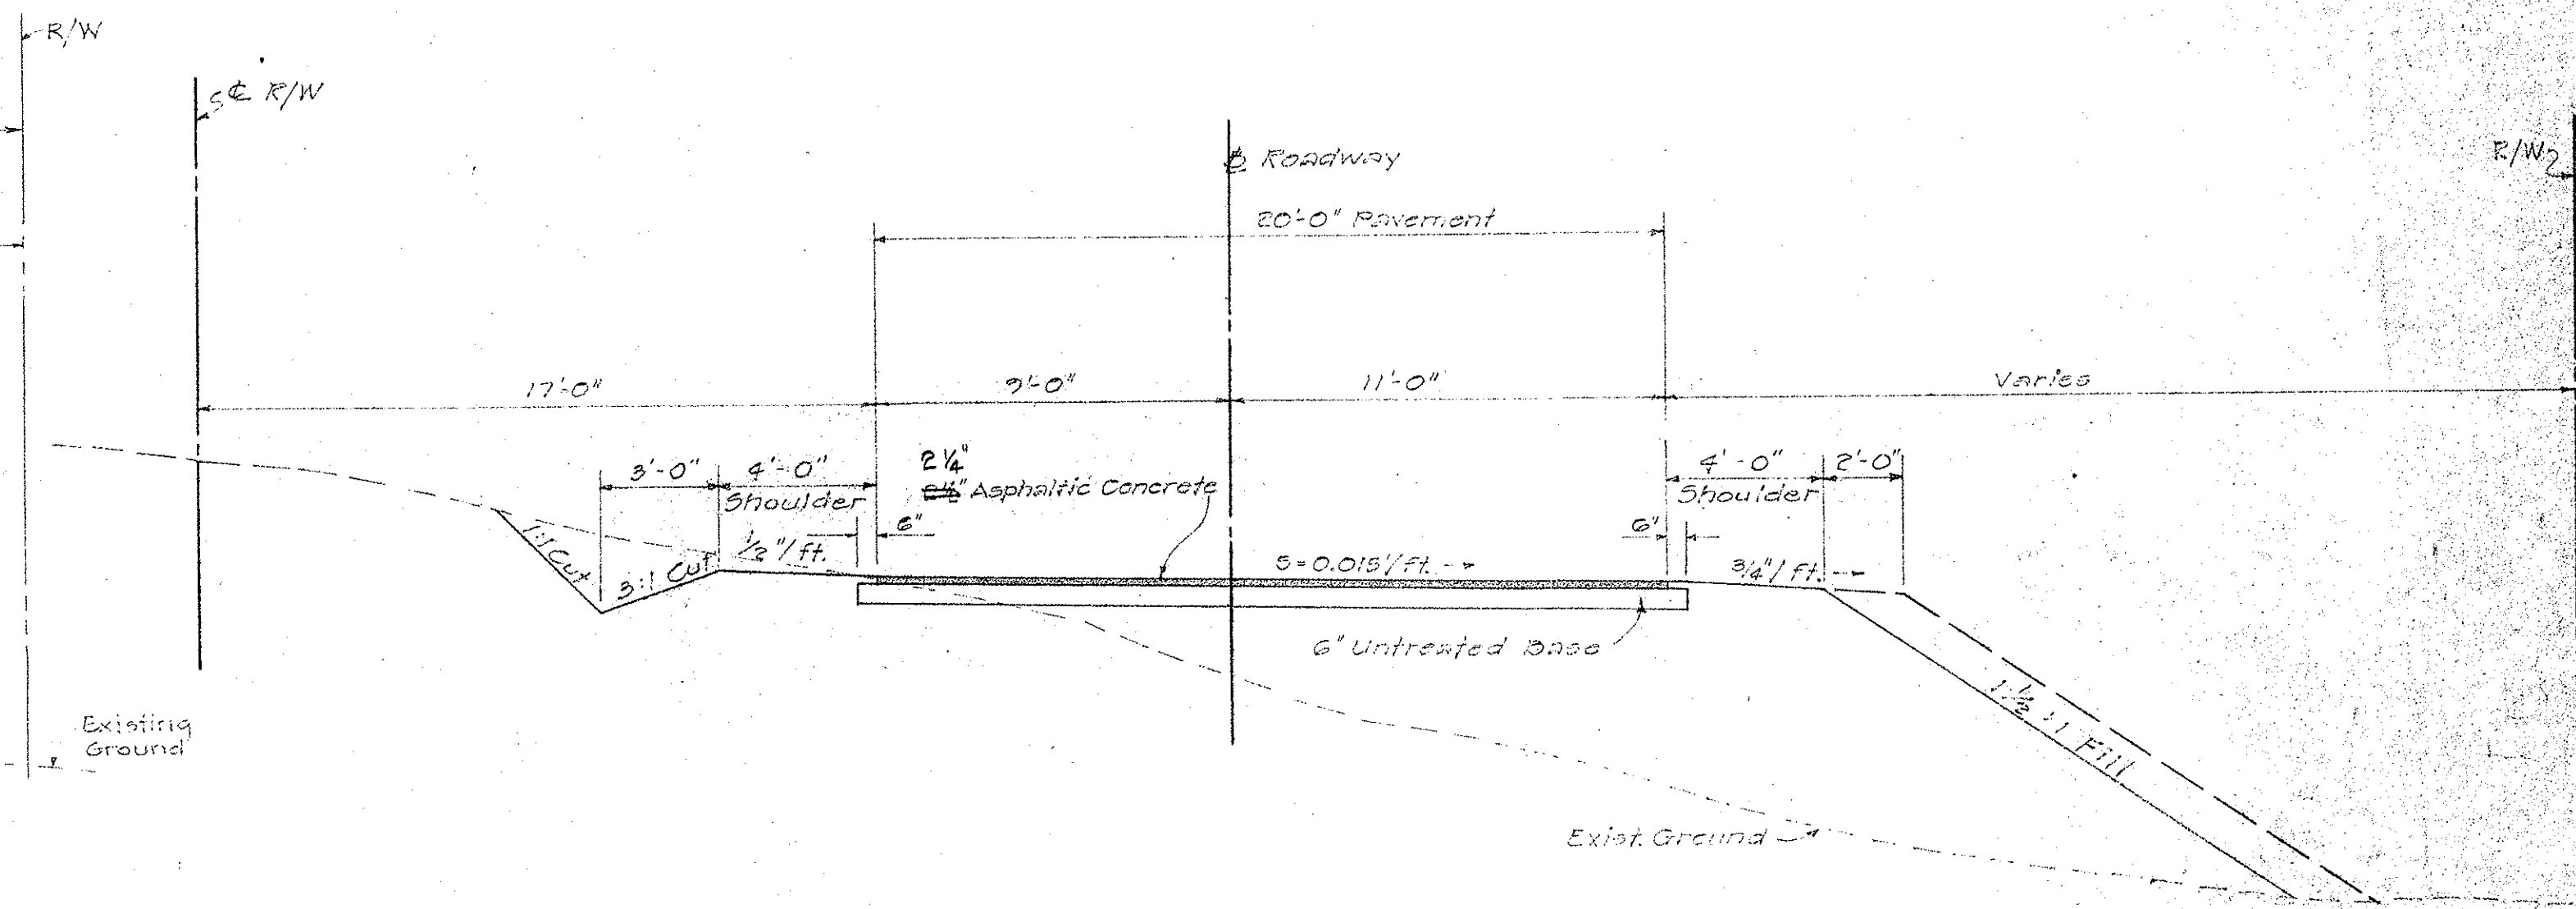

(PHASE II WORK)

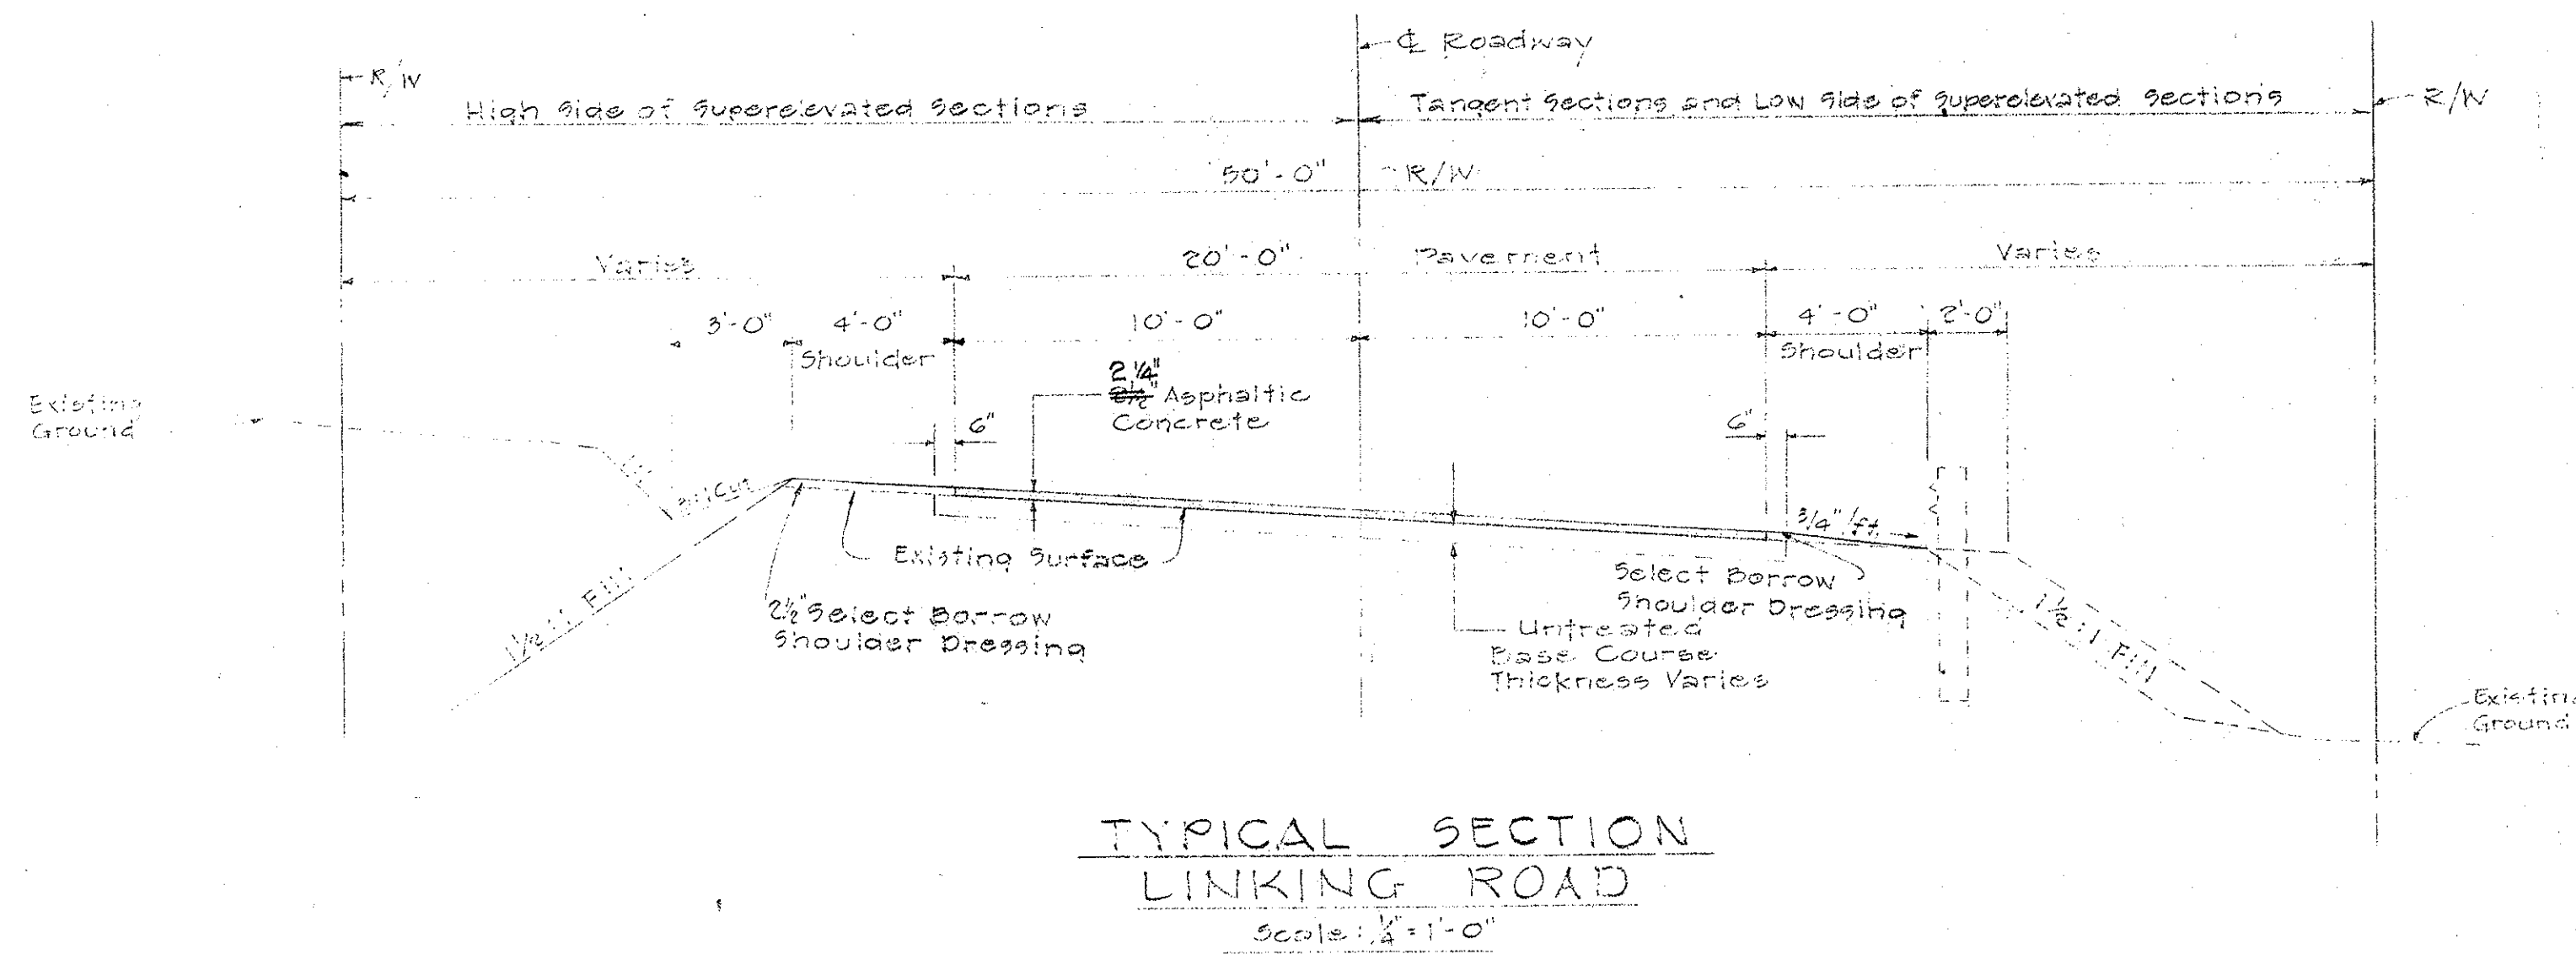

(PHASE I WORK)

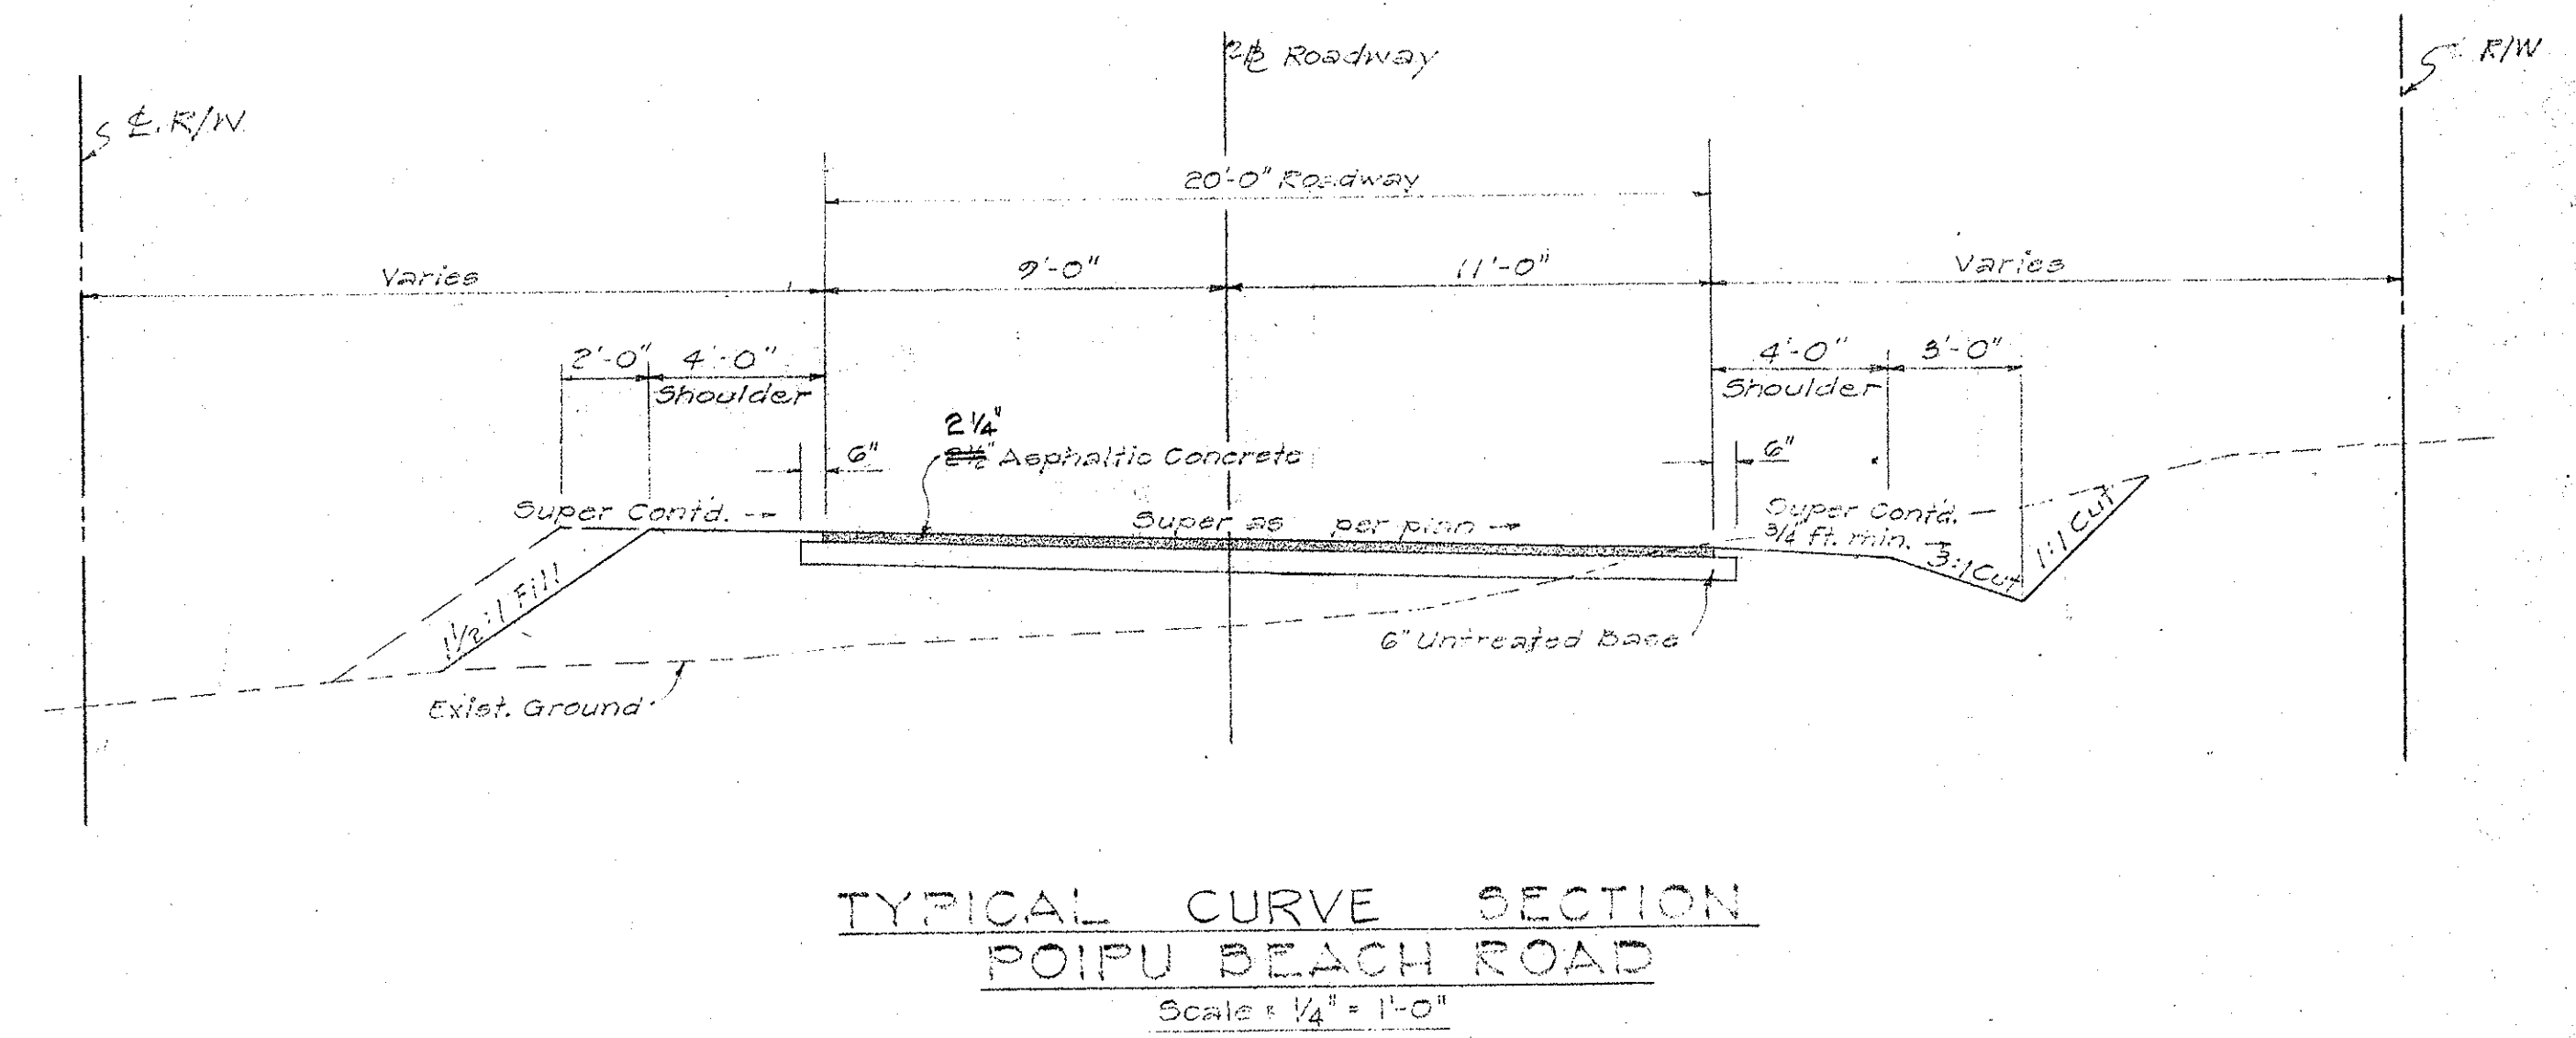

(PHASE II WORK)

GENERAL NOTES

- All Asphaltic Concrete Pavement shall consist of 1 1/2" of A.C. Leveling Course (Mix III) and 2 1/4" of A.C. Surface Course (Mix IV).

DATE	_____
SURVEY PLOTTED BY	_____
DRAWN BY	_____
TRACED BY	_____
DESIGNED BY	_____
CHECKED BY	_____
NOTE BOOK	_____
No.	_____

STATE OF HAWAII
DEPARTMENT OF TRANSPORTATION
HIGHWAYS DIVISION

TYPICAL SECTIONS
PROJECT NO. G-3325-02-63
POIPU BEACH ROAD

Scale: As Shown

Date: July 1964

SHEET No. OF SHEETS