


FINAL SURVEY	SURVEYED PLOTTED	DATE
NOTE BOOK	TEMPLATE	BY
NO.	AREAS CHECKED	

ORIGINAL SURVEY	SURVEYED PLOTTED	DATE
NOTE BOOK	TEMPLATE	BY
NO.	AREAS CHECKED	


FED. ROAD DIST. NO.	STATE	PROJ. NO.	FISCAL YEAR	SHEET NO.	TOTAL SHEETS
HAWAII	HAW.	BD 67-359	1968	9	11

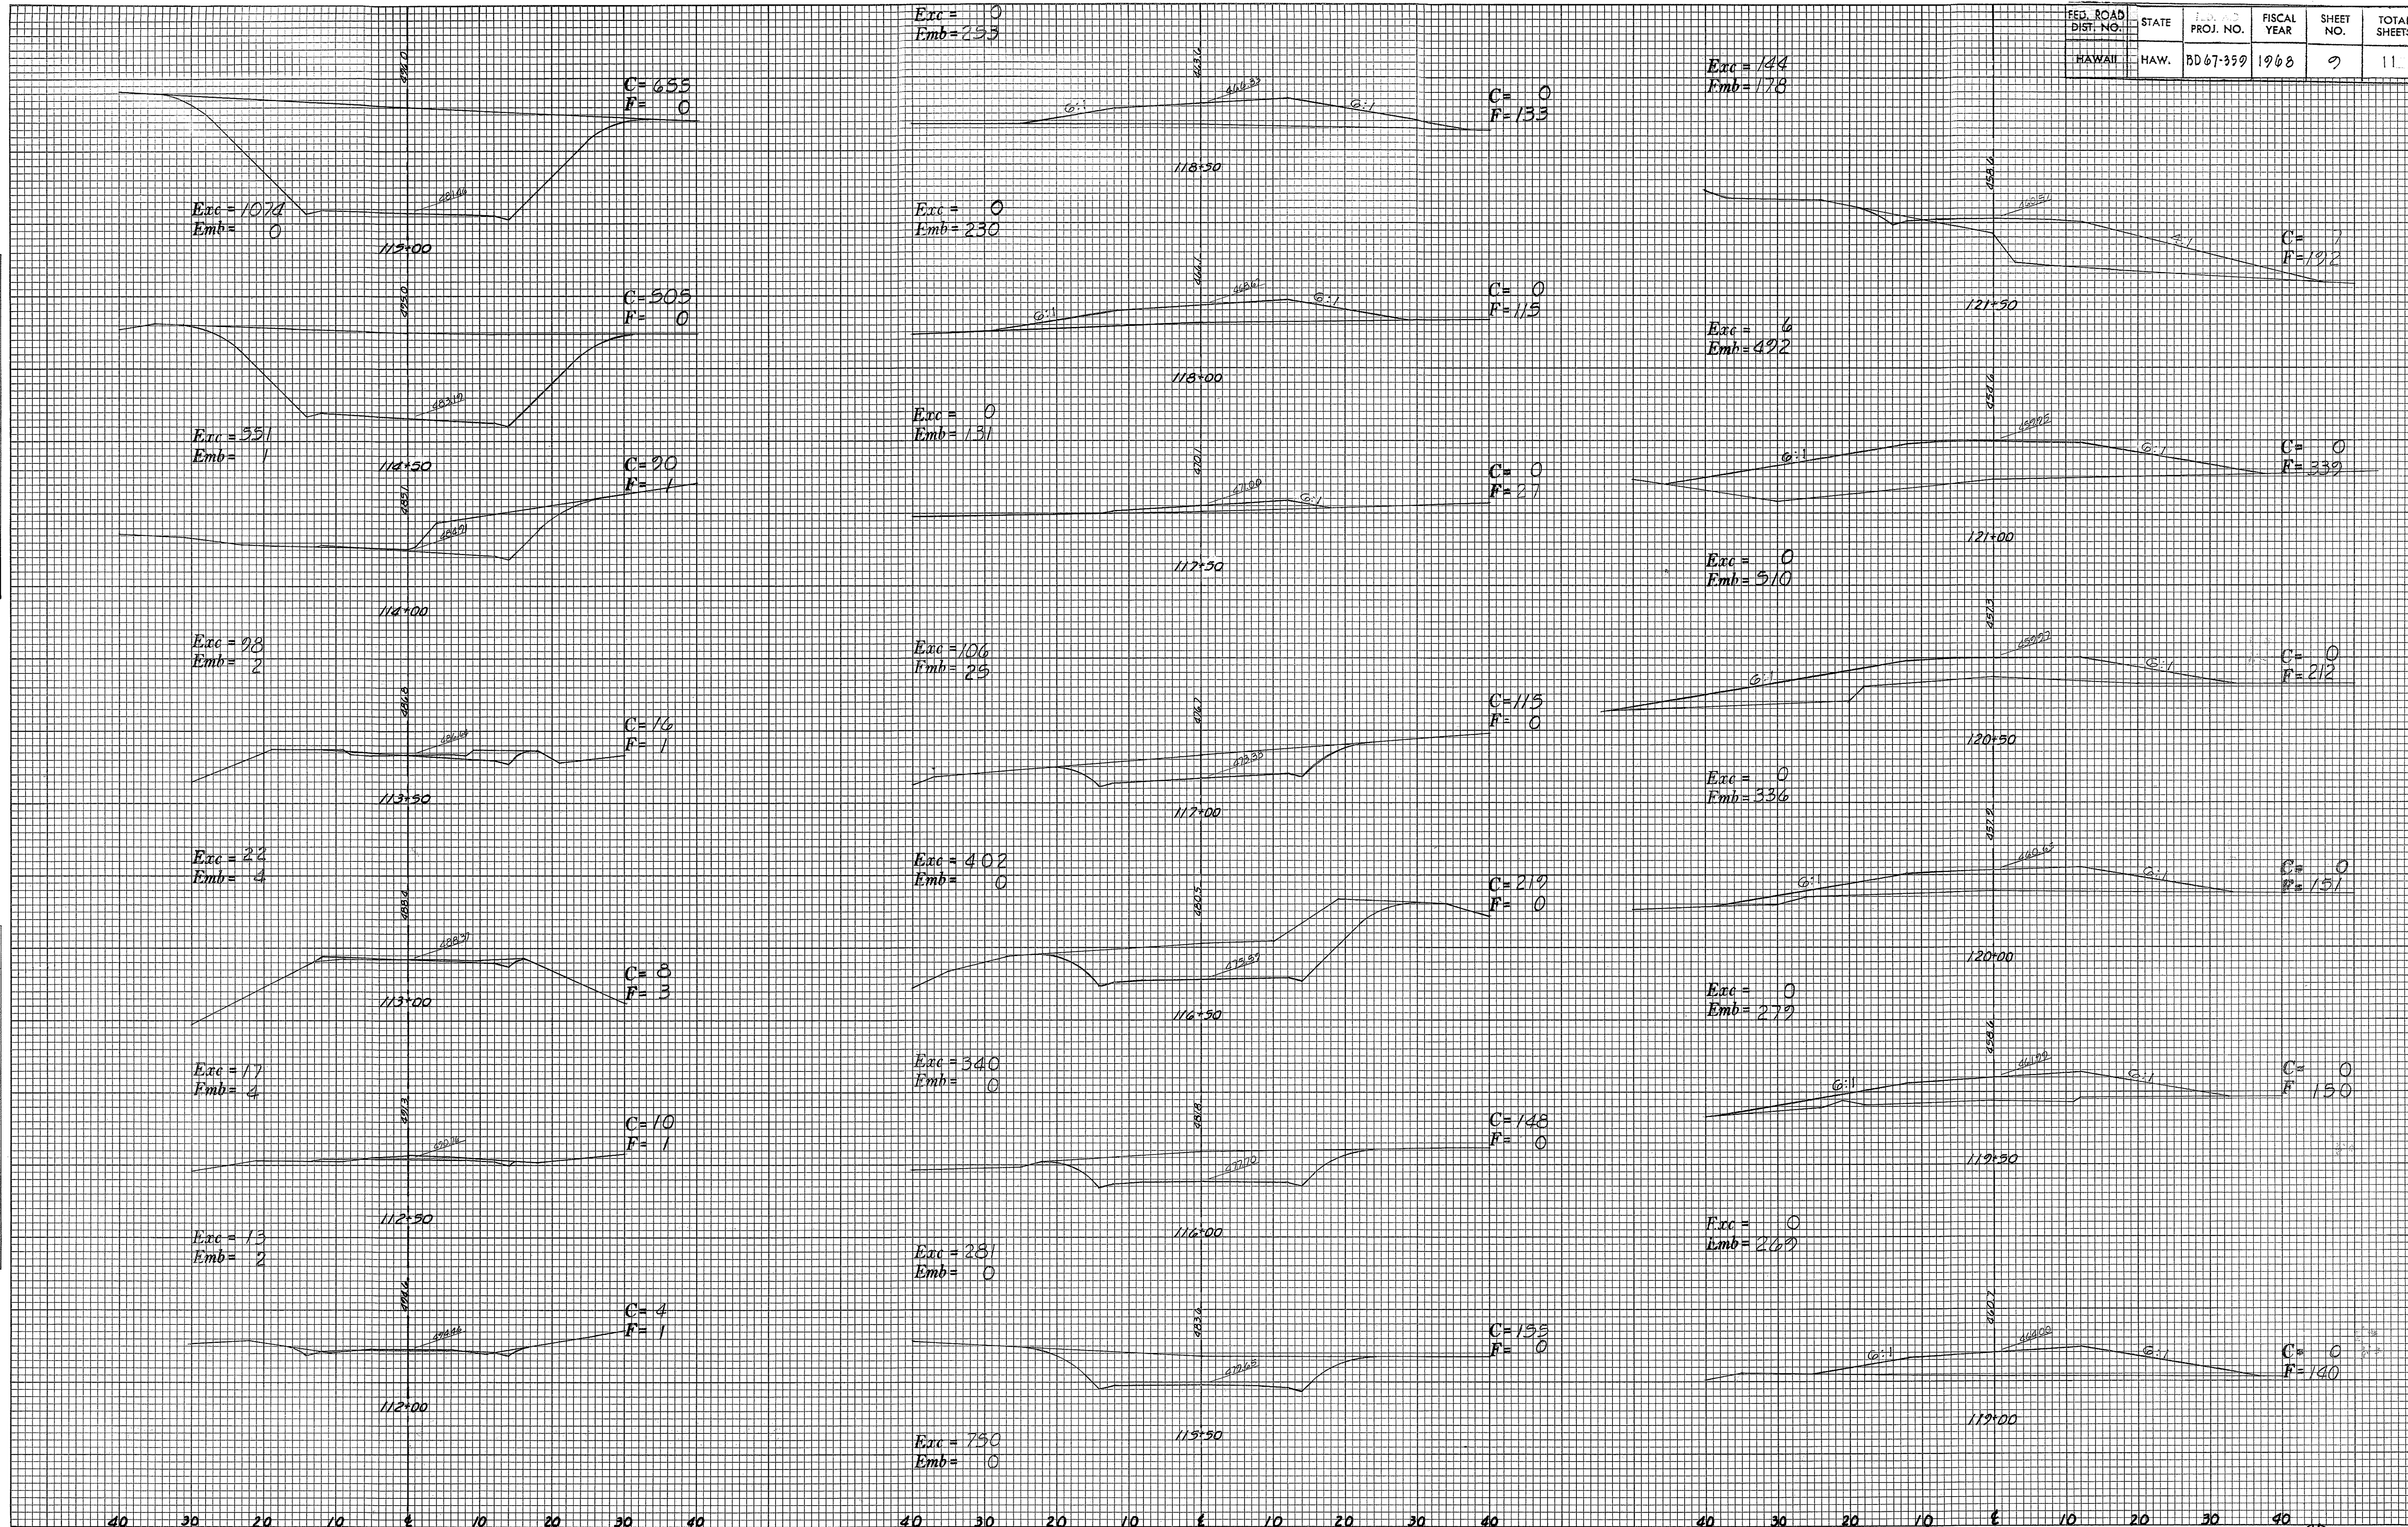

FINAL SURVEY	SURVEYED	DATE
NOTE BOOK	PLOTTED	BY
NO.	AREAS CHECKED	

ORIGINAL SURVEY	SURVEYED	DATE
NOTE BOOK	PLOTTED	BY
NO.	AREAS CHECKED	

ROAD DIST. NO.	STATE	PROJ. NO.	FISCAL YEAR	SHEET NO.	TOTAL SHEETS
HAWAII	HAW.	BD 67-359	1968	10	11

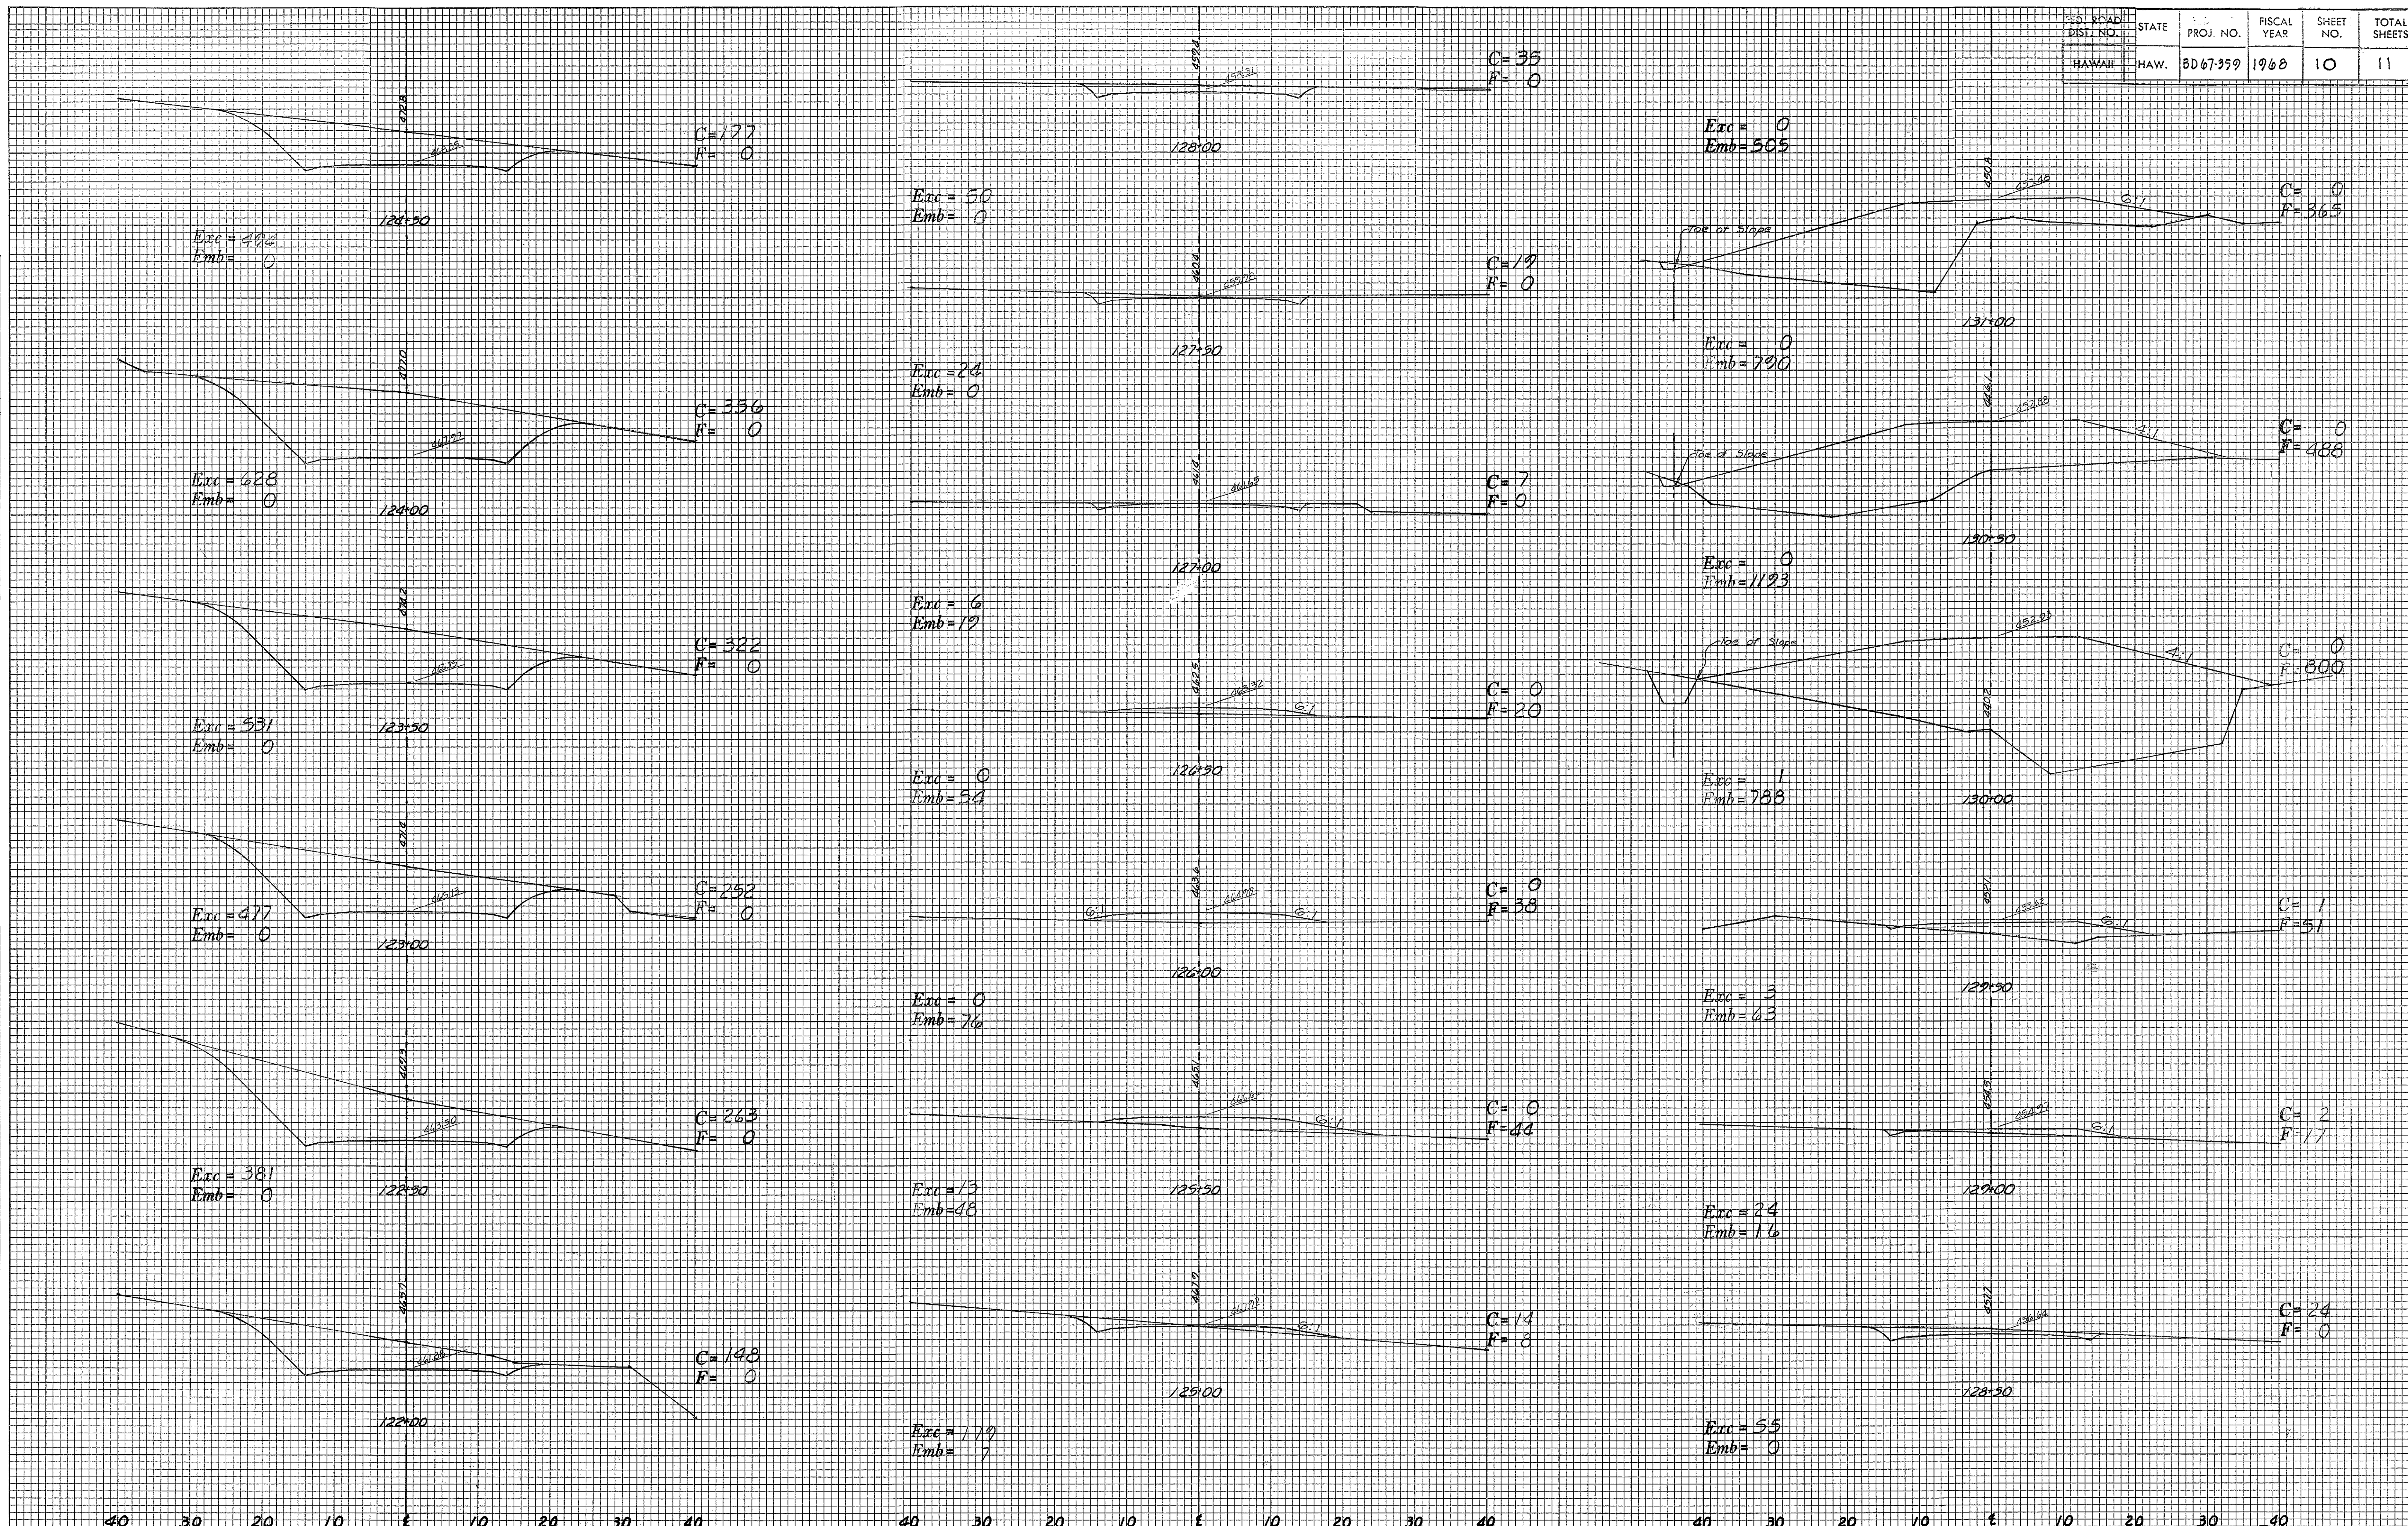


FINAL	SURVEYED	DATE
SURVEY	PLOTTED	BY
NOTE BOOK	REPLATE	
NO.	AREAS CHECKED	


ORIGINAL	SURVEYED	DATE
SURVEY	PLOTTED	BY
NOTE BOOK	REPLATE	
NO.	AREAS CHECKED	

FED. ROAD DIST. NO.	STATE	FED. AID PROJ. NO.	FISCAL YEAR	SHEET NO.	TOTAL SHEETS
HAWAII	HAW.	BD 67-359	1968	11	11


Exc = 0
Emb = 78

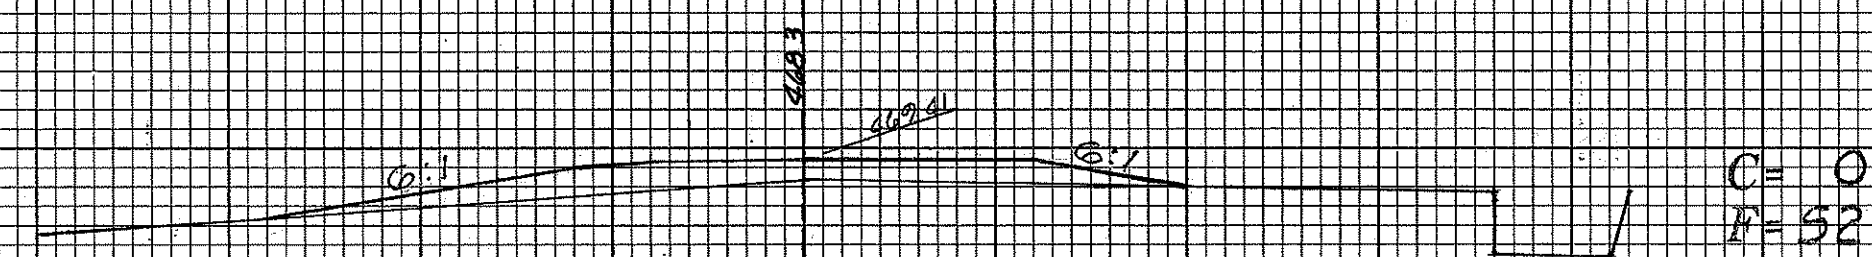


Exc = 0
Emb = 29.4

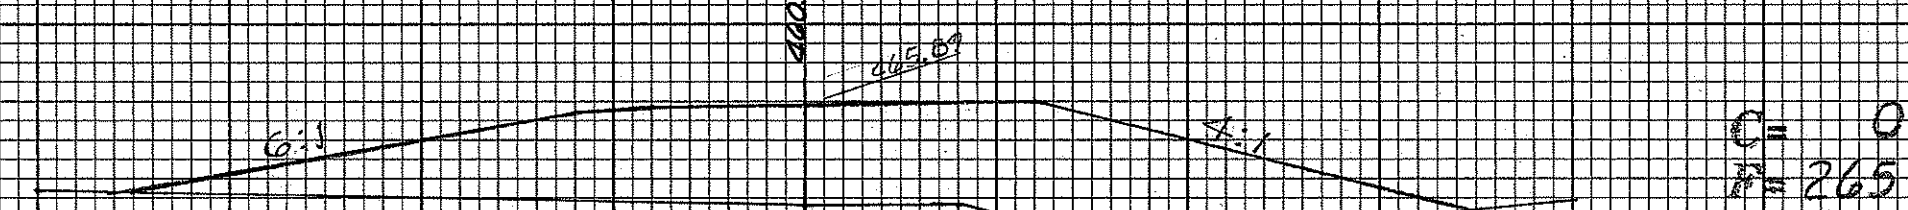


Exc = 0
Emb = 432

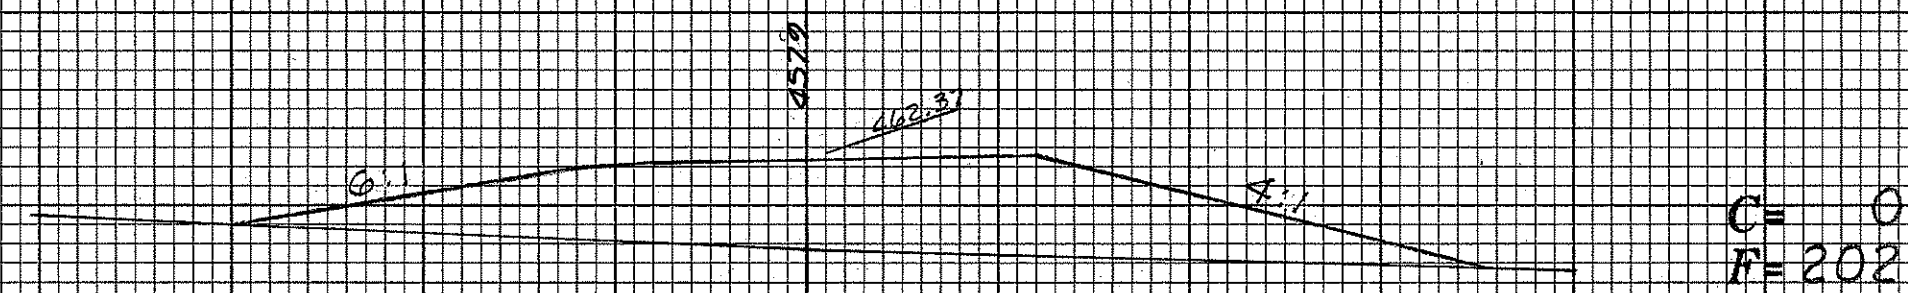


Exc = 0
Emb = 300

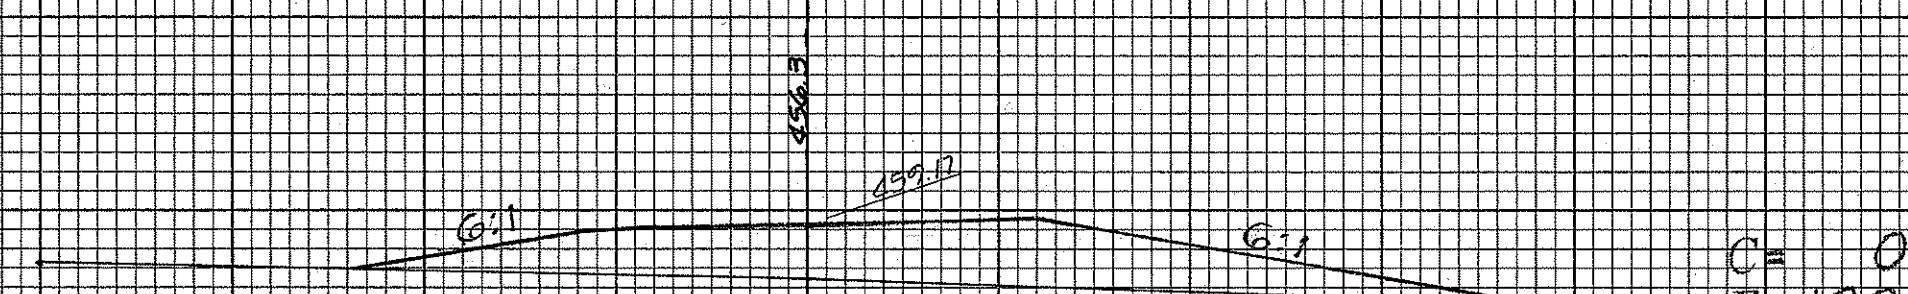


Exc = 0
Emb = 219

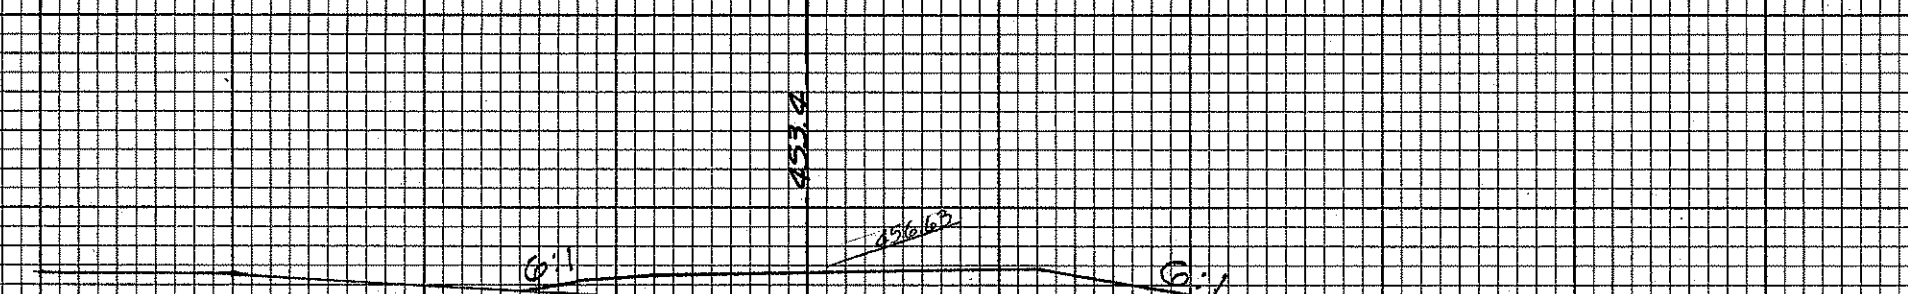


Exc = 0
Emb = 273

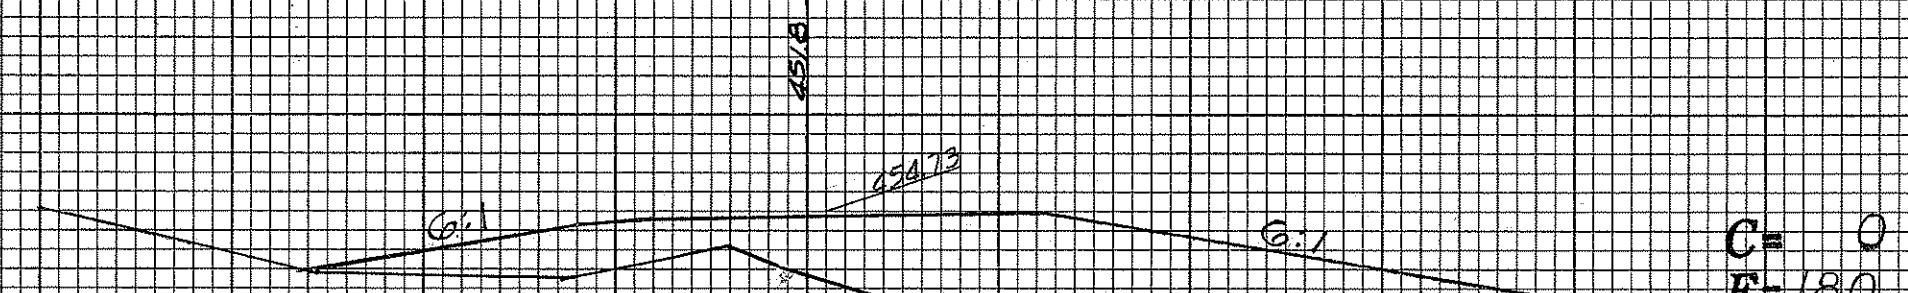


Exc = 359
Emb = 0

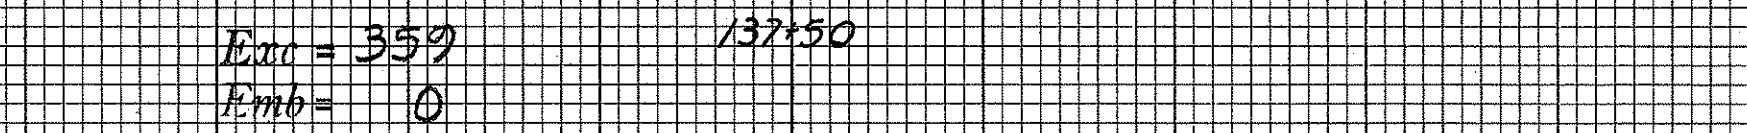


Exc = 292
Emb = 0

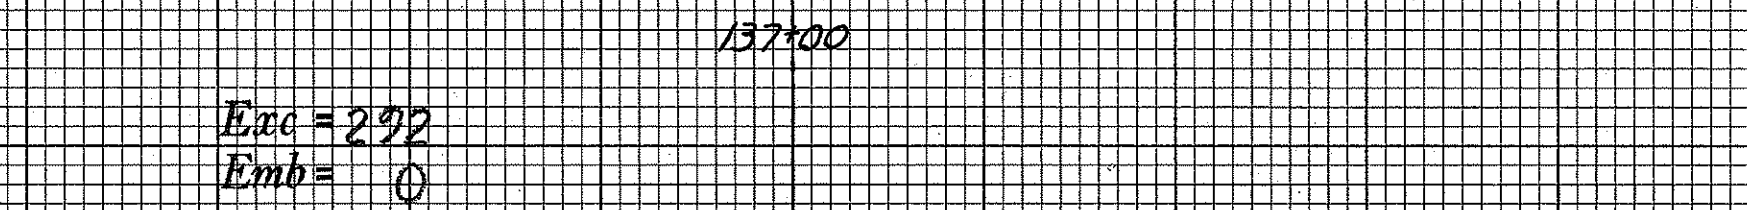


Exc = 212
Emb = 0

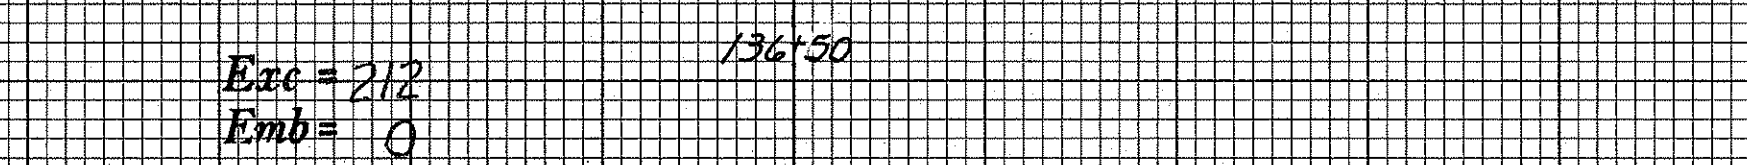


Exc = 28
Emb = 0

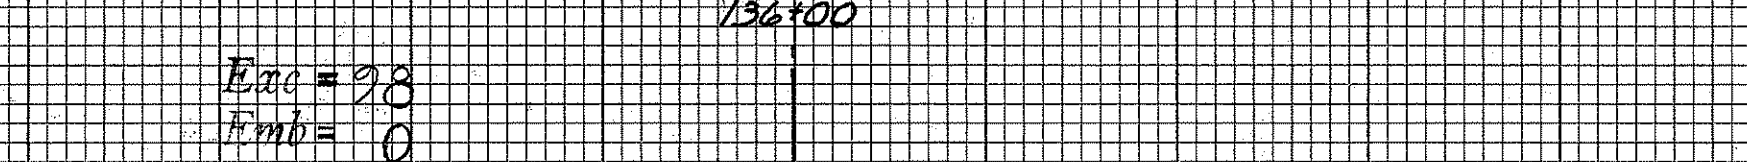


Exc = 14
Emb = 14

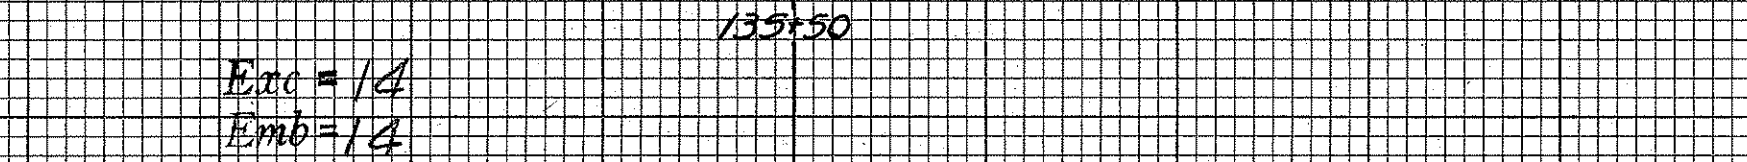

Exc = 1
Emb = 44

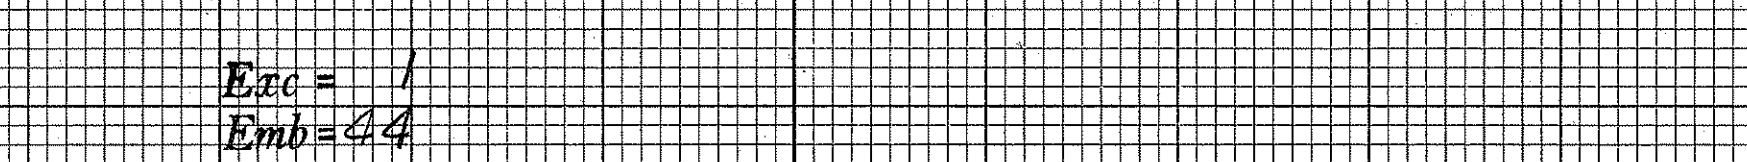

Exc = 0
Emb = 32

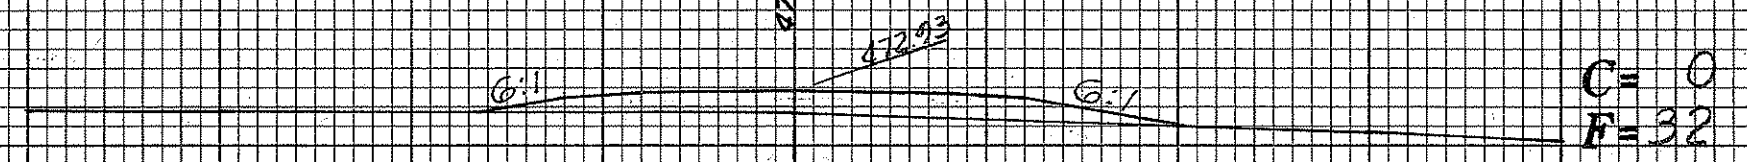

Exc =
Emb =

Exc = 44
Emb = 0

Exc = 76
Emb = 0

Exc = 38
Emb = 0

Exc = 69
Emb = 0

Exc = 37
Emb = 0

Exc = 71
Emb = 0

Exc = 40
Emb = 0

Exc = 112
Emb = 0

Exc = 81
Emb = 0

Exc = 205
Emb = 0

Exc = 140
Emb = 0

Exc = 318
Emb = 0

Exc = 203
Emb = 0

Exc = 382
Emb = 0