

FED. ROAD DIST. NO.	STATE	PROJ. NO.	FISCAL YEAR	SHEET NO.	TOTAL SHEETS
HAWAII	HAW.	BD 67-359	1968	3	11

PLAN	BY	DATE
SURVEYED		
PLOTTED		
CHECKED		
NOTE BOOK		
NO.		

GENERAL NOTES

1. Coral sand, limestone or other calcareous material shall not be used on the roadway.
2. All azimuths are referred to "Pooku" Δ.
3. All elevations are referred to "Mean Sea Level".
4. All work to be coordinated with the Hawaiian Fruit Packers, Ltd., the Linne Plantation Co., Ltd., and the University of Hawaii Agricultural Experiment Station.
5. The scope of this project limits the excavation and embankment of the roadway and approaches to the finished grade only. Disregard notes and details concerning base course and A.C. topping.

Make easy riding connection to existing pavement.


Sta. 112+54 to Sta. 113+04 Both Sides
Relocate existing metal guard rails.
For details, see Typical Section 100
Lin. Ft.

Construct Side Road Approaches as shown.
For detail see Sheet No. 2


STA.	Approx. Width	Exc.	Emb.
114+20 Rt.	12'	612 C.Y.	
116+50 Both Sides	14'	507 C.Y.	
119+50 Rt.	12'		291 C.Y.
122+50 Rt.	12'	115 C.Y.	
125+50 Both Sides	12'	5 C.Y.	20 C.Y.
128+20 Both Sides	12'	36 C.Y.	
133+00 Lt.	10'	286 C.Y.	
133+00 Rt.	10'	314 C.Y.	

Sta. 134+17
Install battery of 2-42" C.G.M.P. Culverts. For details and estimated quantities, see Sheet No. 6

END OF PROJ. NO. BD 67-359
STA. 141+00

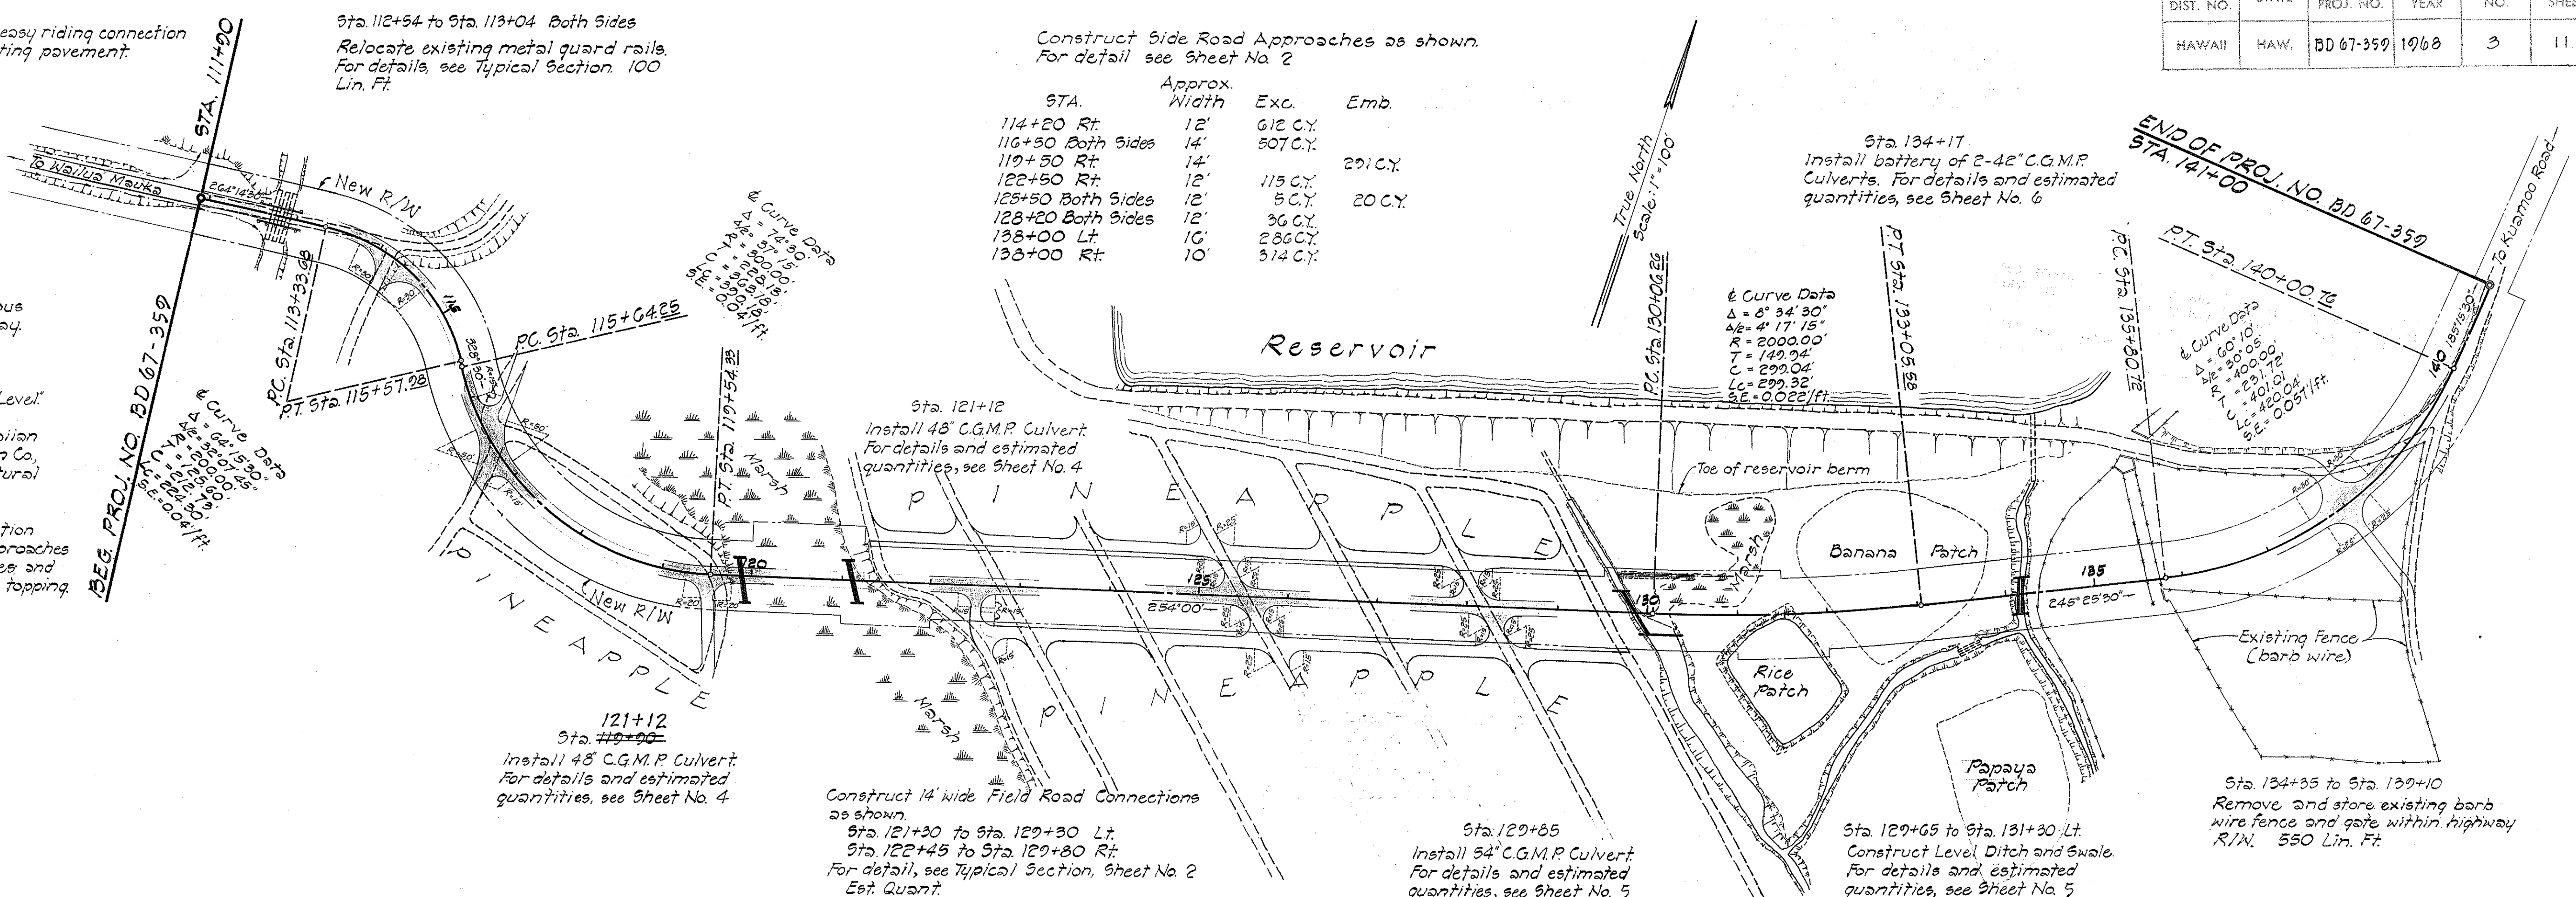

PROFILE	BY	DATE
SURVEYED		
PLOTTED		
CHECKED		
NOTE BOOK		
NO.		

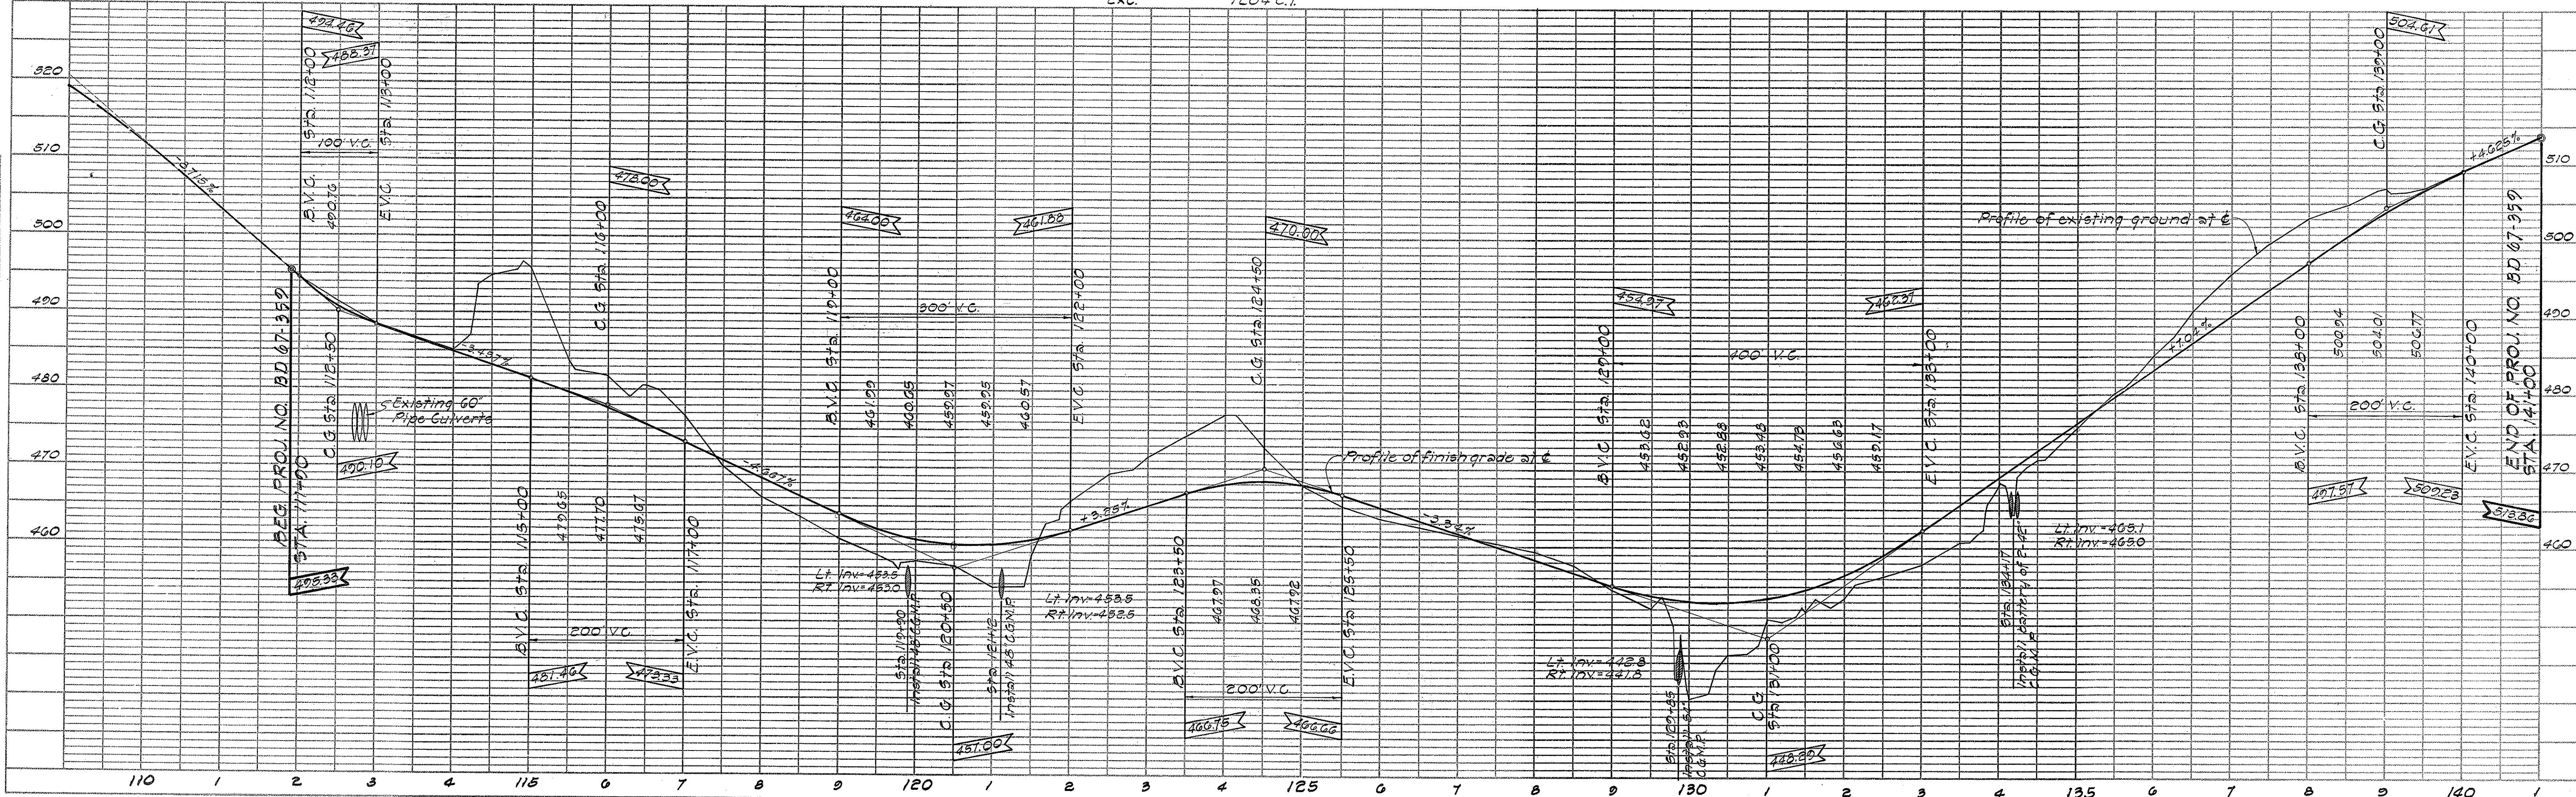

D-7-3