

INDEX TO DRAWINGS	
SHEET NO.	DESCRIPTION
1	TITLE SHEET
2	TYPICAL SECTIONS & MISC.DETAILS
3	PLAN AND PROFILE
4-8	DETAILS FOR DRAINAGE SYSTEM
9-11	CROSS SECTIONS

STATE OF HAWAII

DEPARTMENT OF TRANSPORTATION

HIGHWAYS DIVISION

"AS BUILT" PLANS FOR

LIHUE - WAILUA - PRINCEVILLE SCENIC ROAD


(GRADE AND DRAINS)

PROJECT NO. BD 67-359

DISTRICT OF KAWAIHAU

ISLAND OF KAUAI

FED. ROAD DIST. NO.	STATE	PROJ. NO.	FISCAL YEAR	SHEET NO.	TOTAL SHEETS
HAWAII	HAW.	BD 67-359	1968	1	11

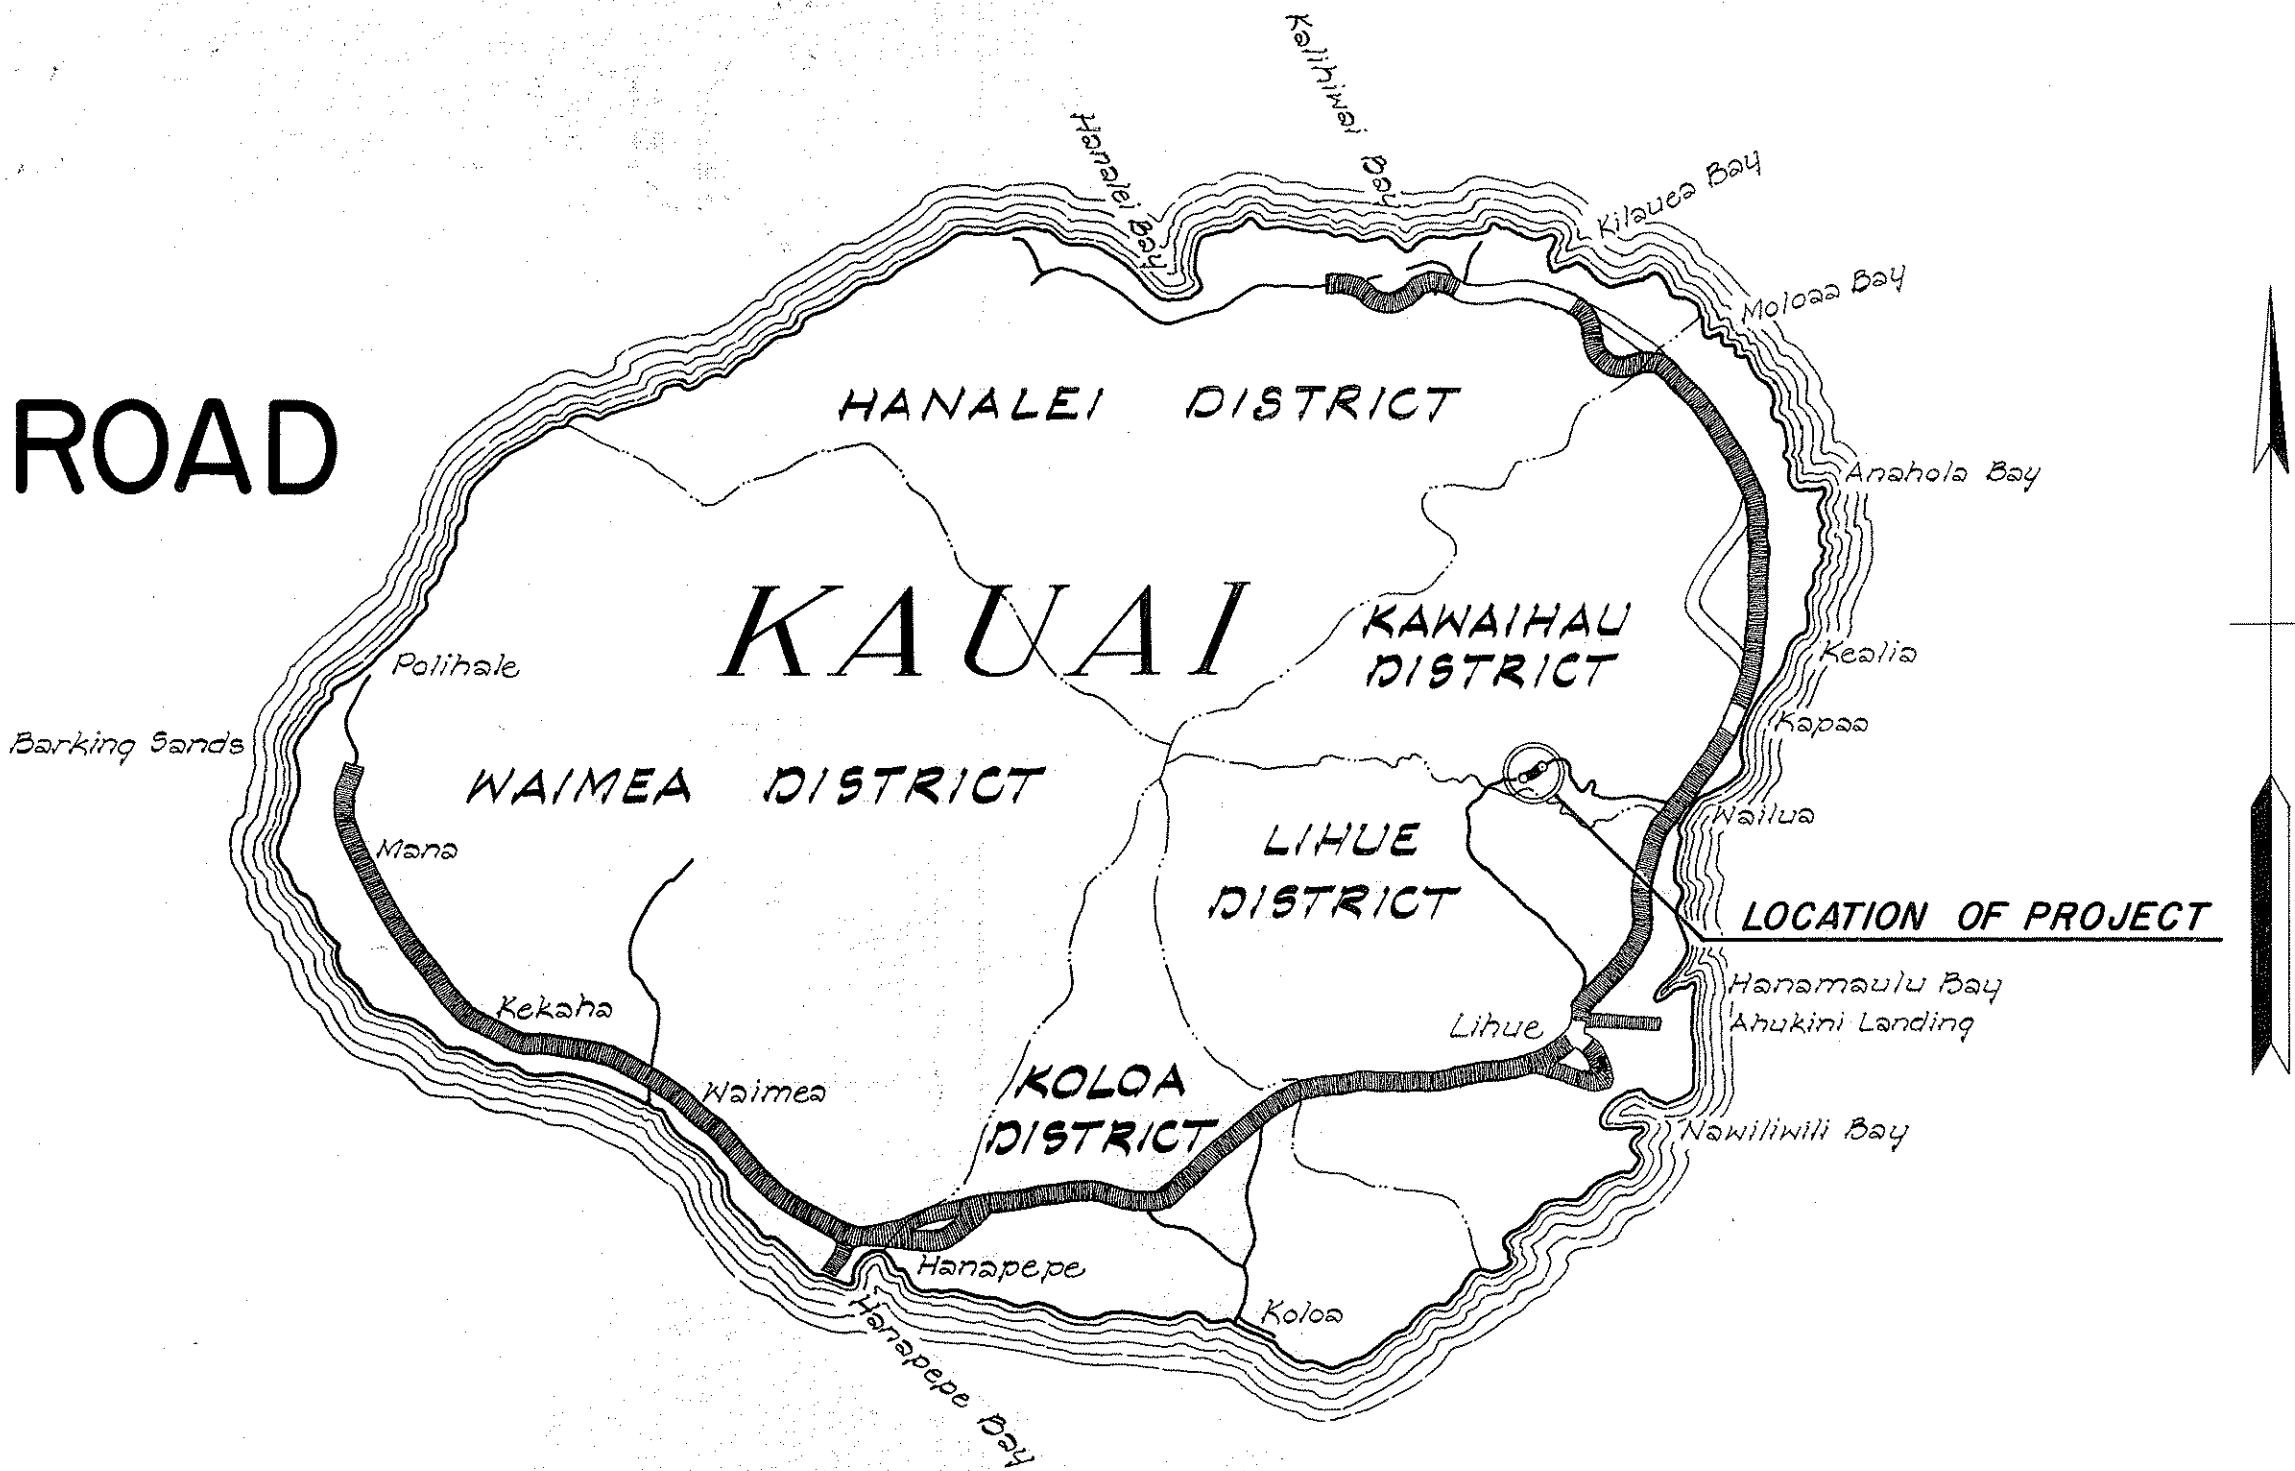

FEDERAL AID PROJECTS PREVIOUSLY CONSTRUCTED OR UNDER CONSTRUCTION


ALL CHANGES MADE DURING CONSTRUCTION
HAVE BEEN INCORPORATED ON THESE PLANS
EXCEPT CHANGES IN THE ORIGINAL THEORETICAL
QUANTITIES

Donald Nagamine

PROJECT ENGINEER

8-11-81

DATE

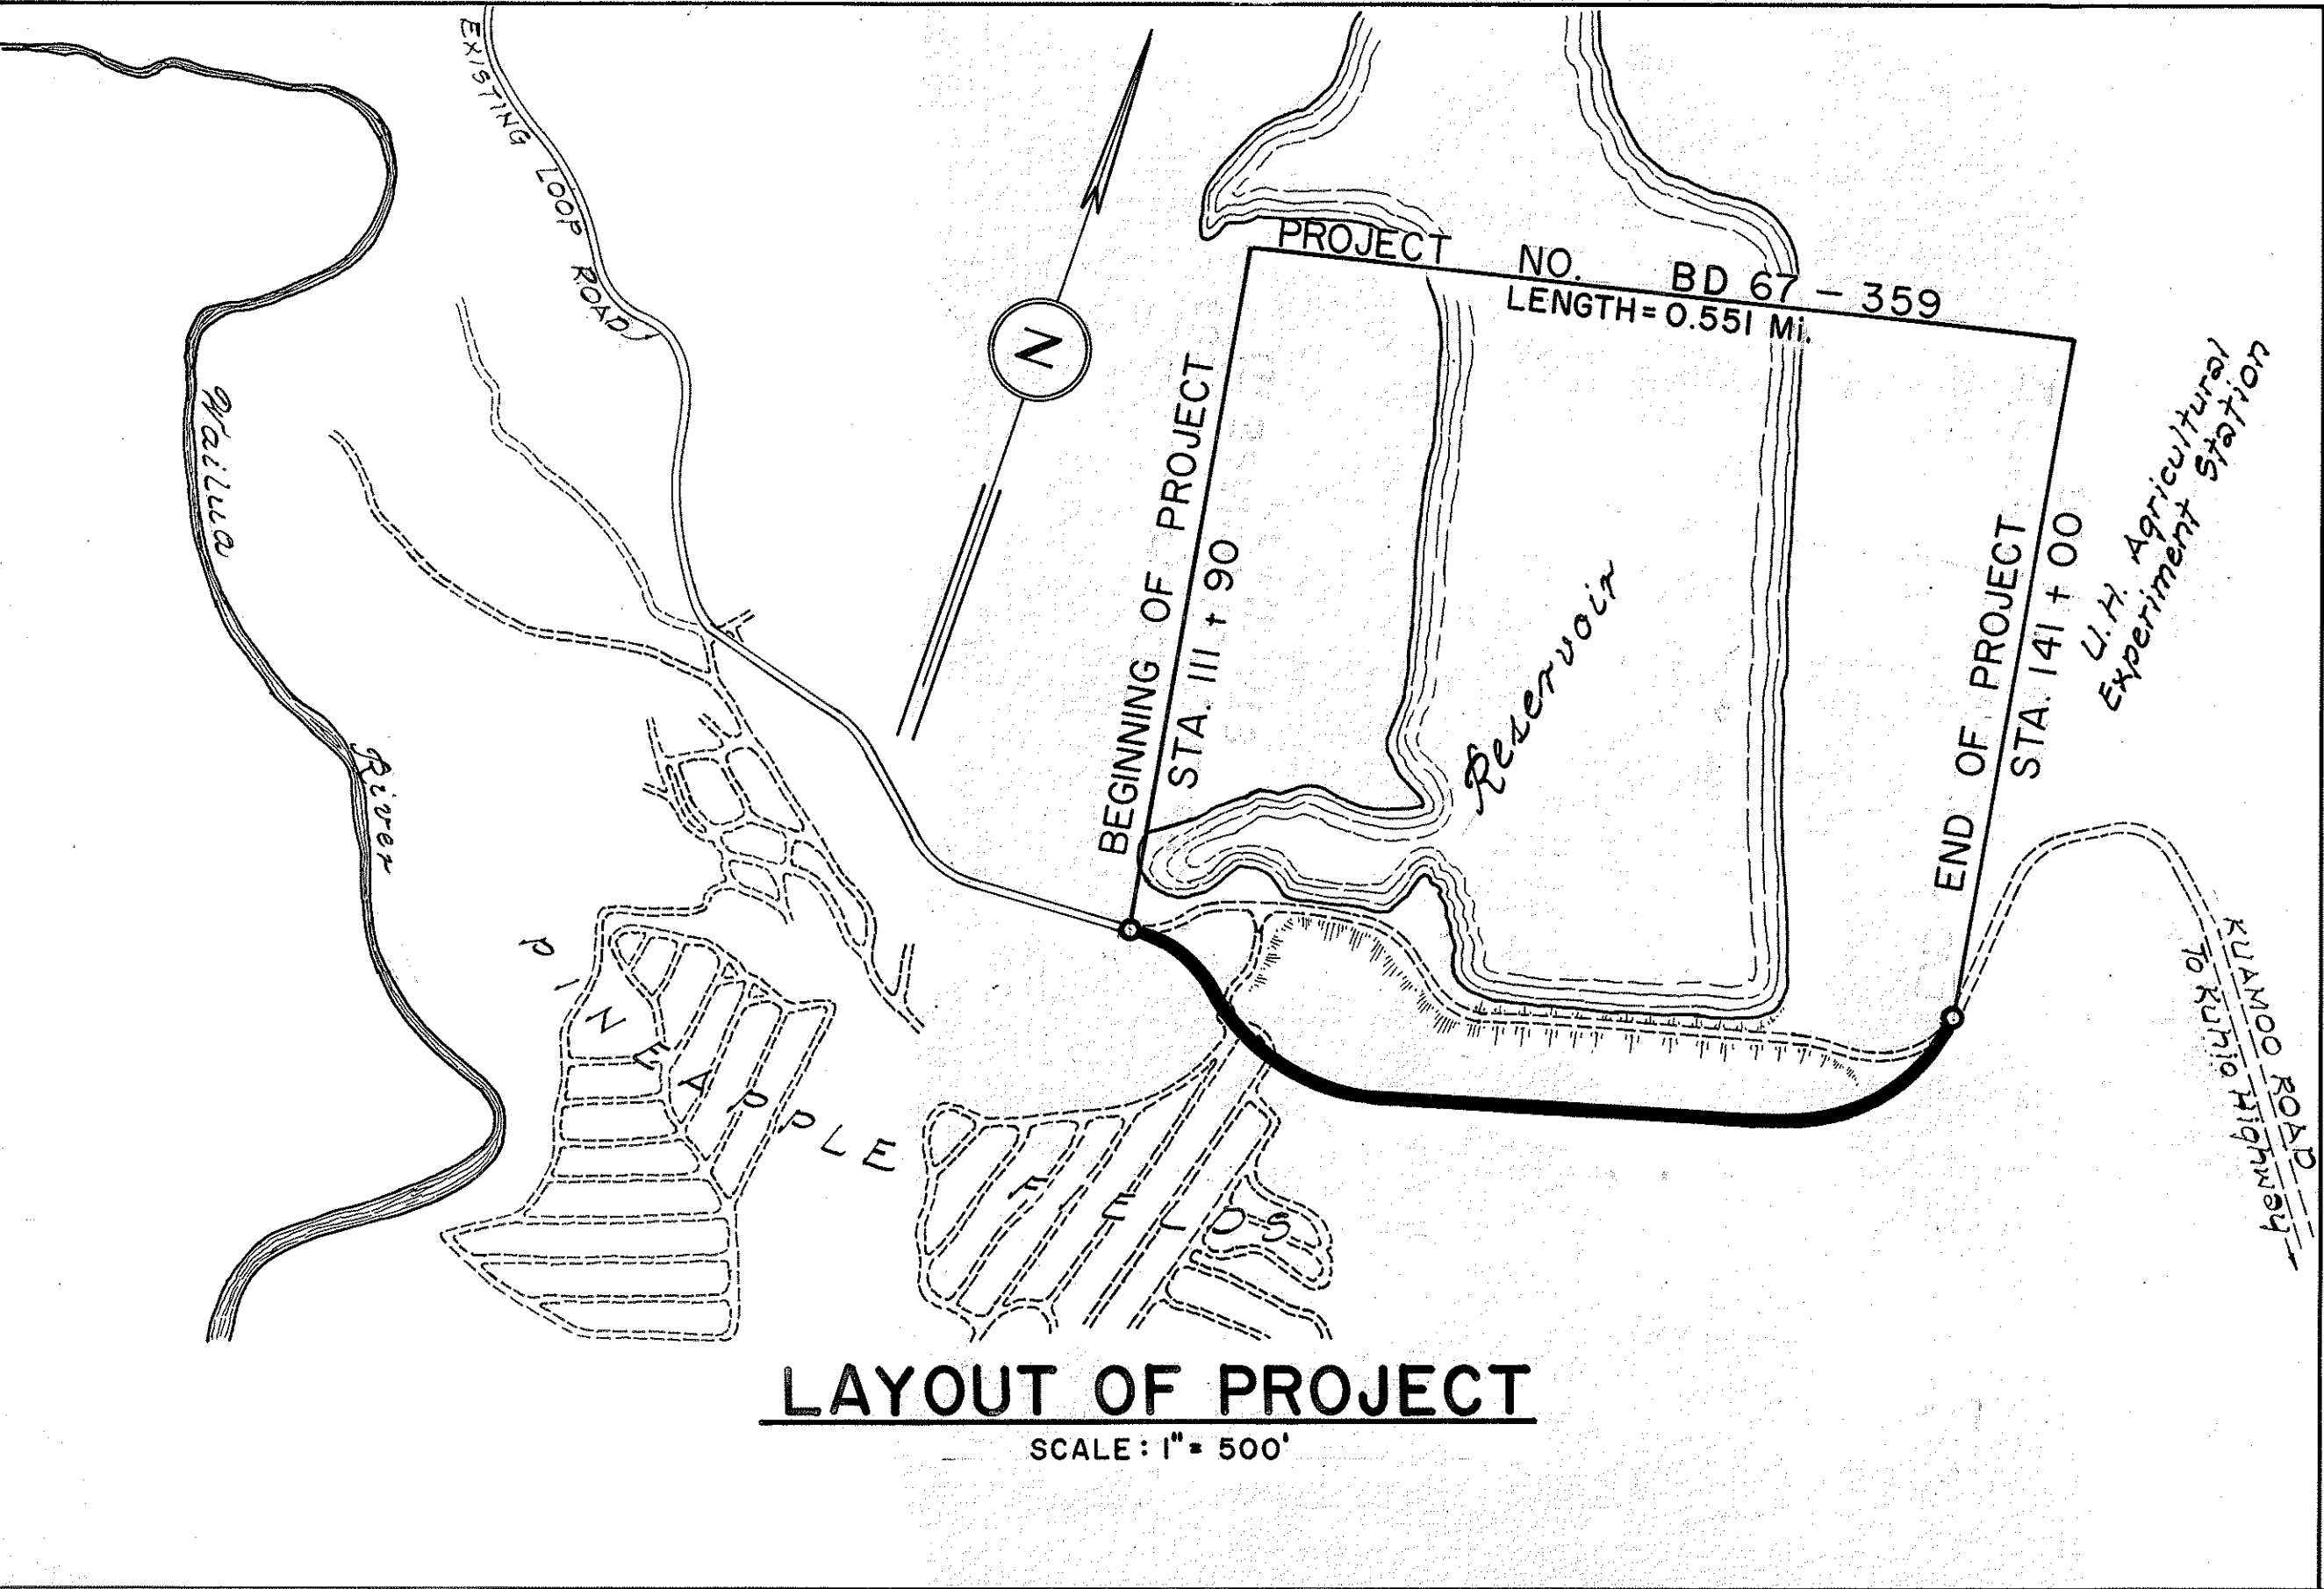

DEPARTMENT OF TRANSPORTATION STATE OF HAWAII	
APPROVED:	
<i>G. Avery Wright</i> for DIR. OF TRANSPORTATION	9/12/68 DATE