


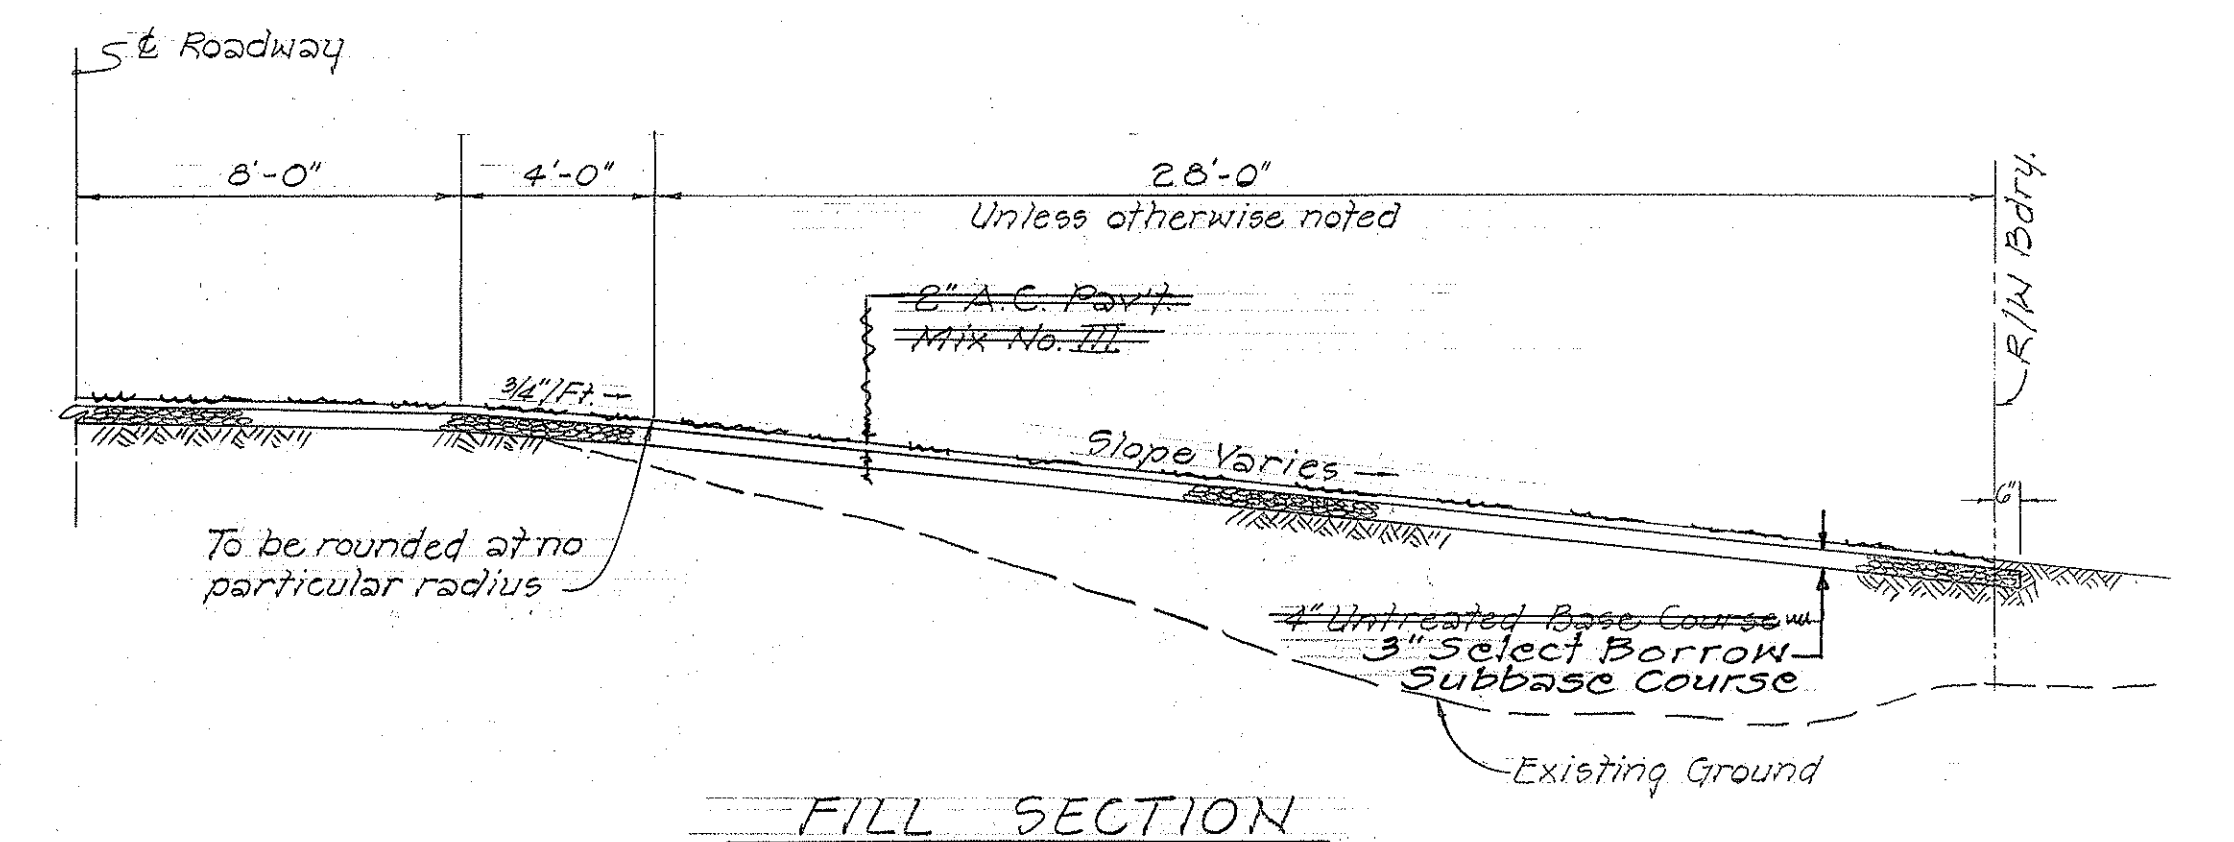
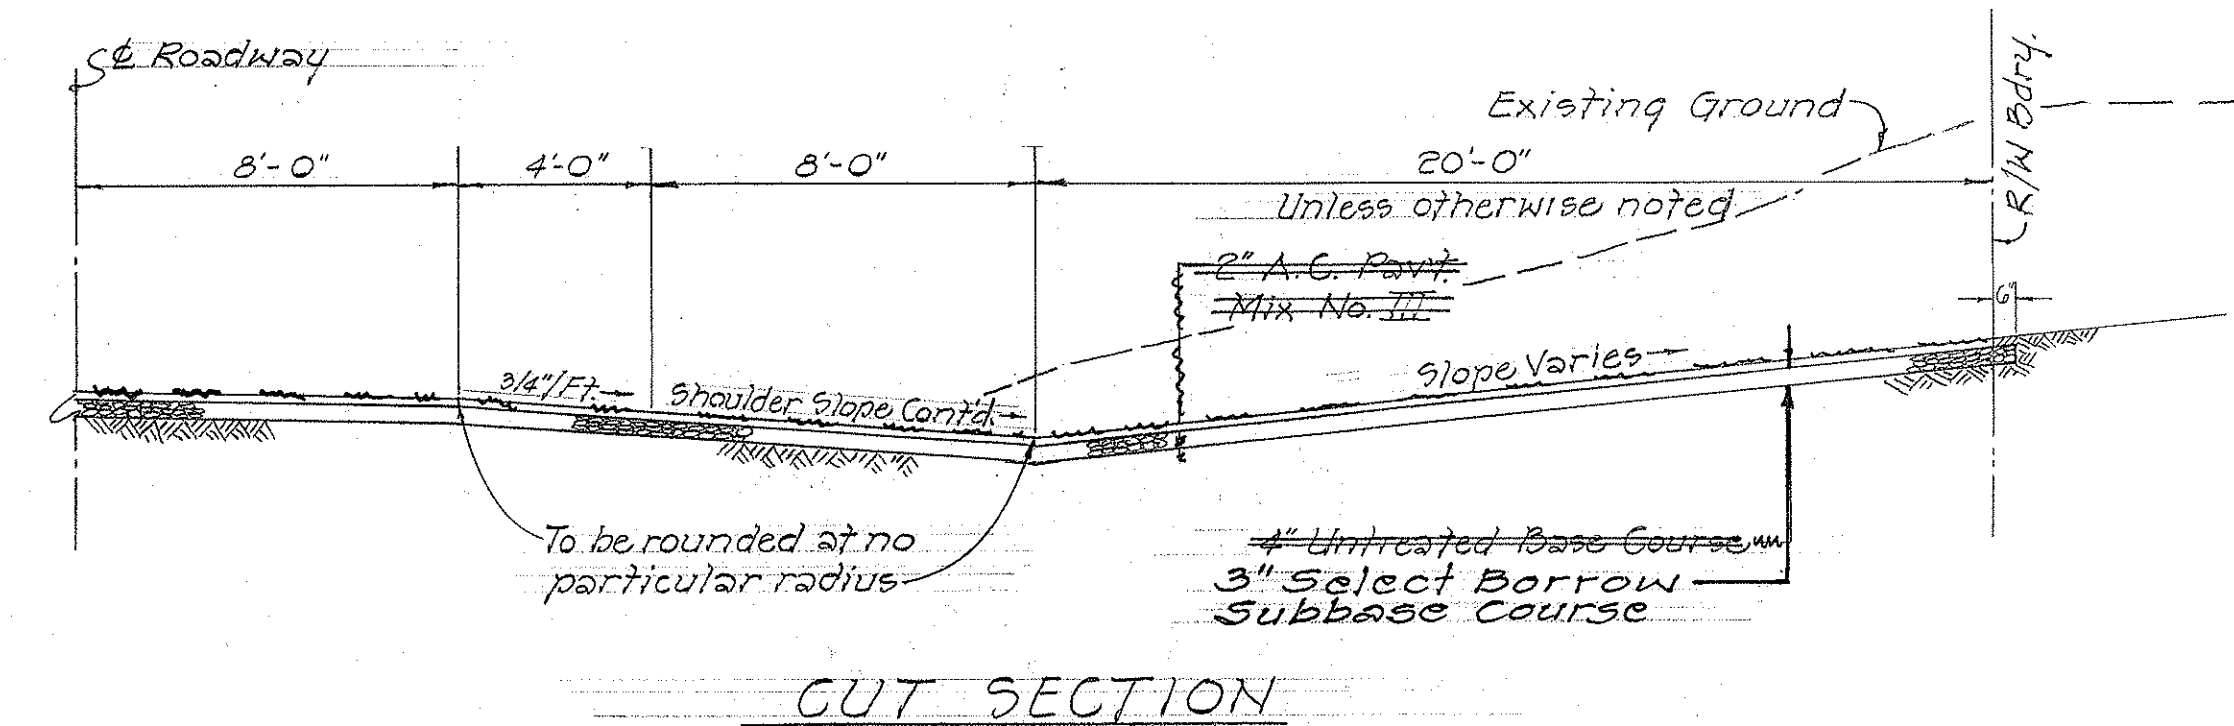


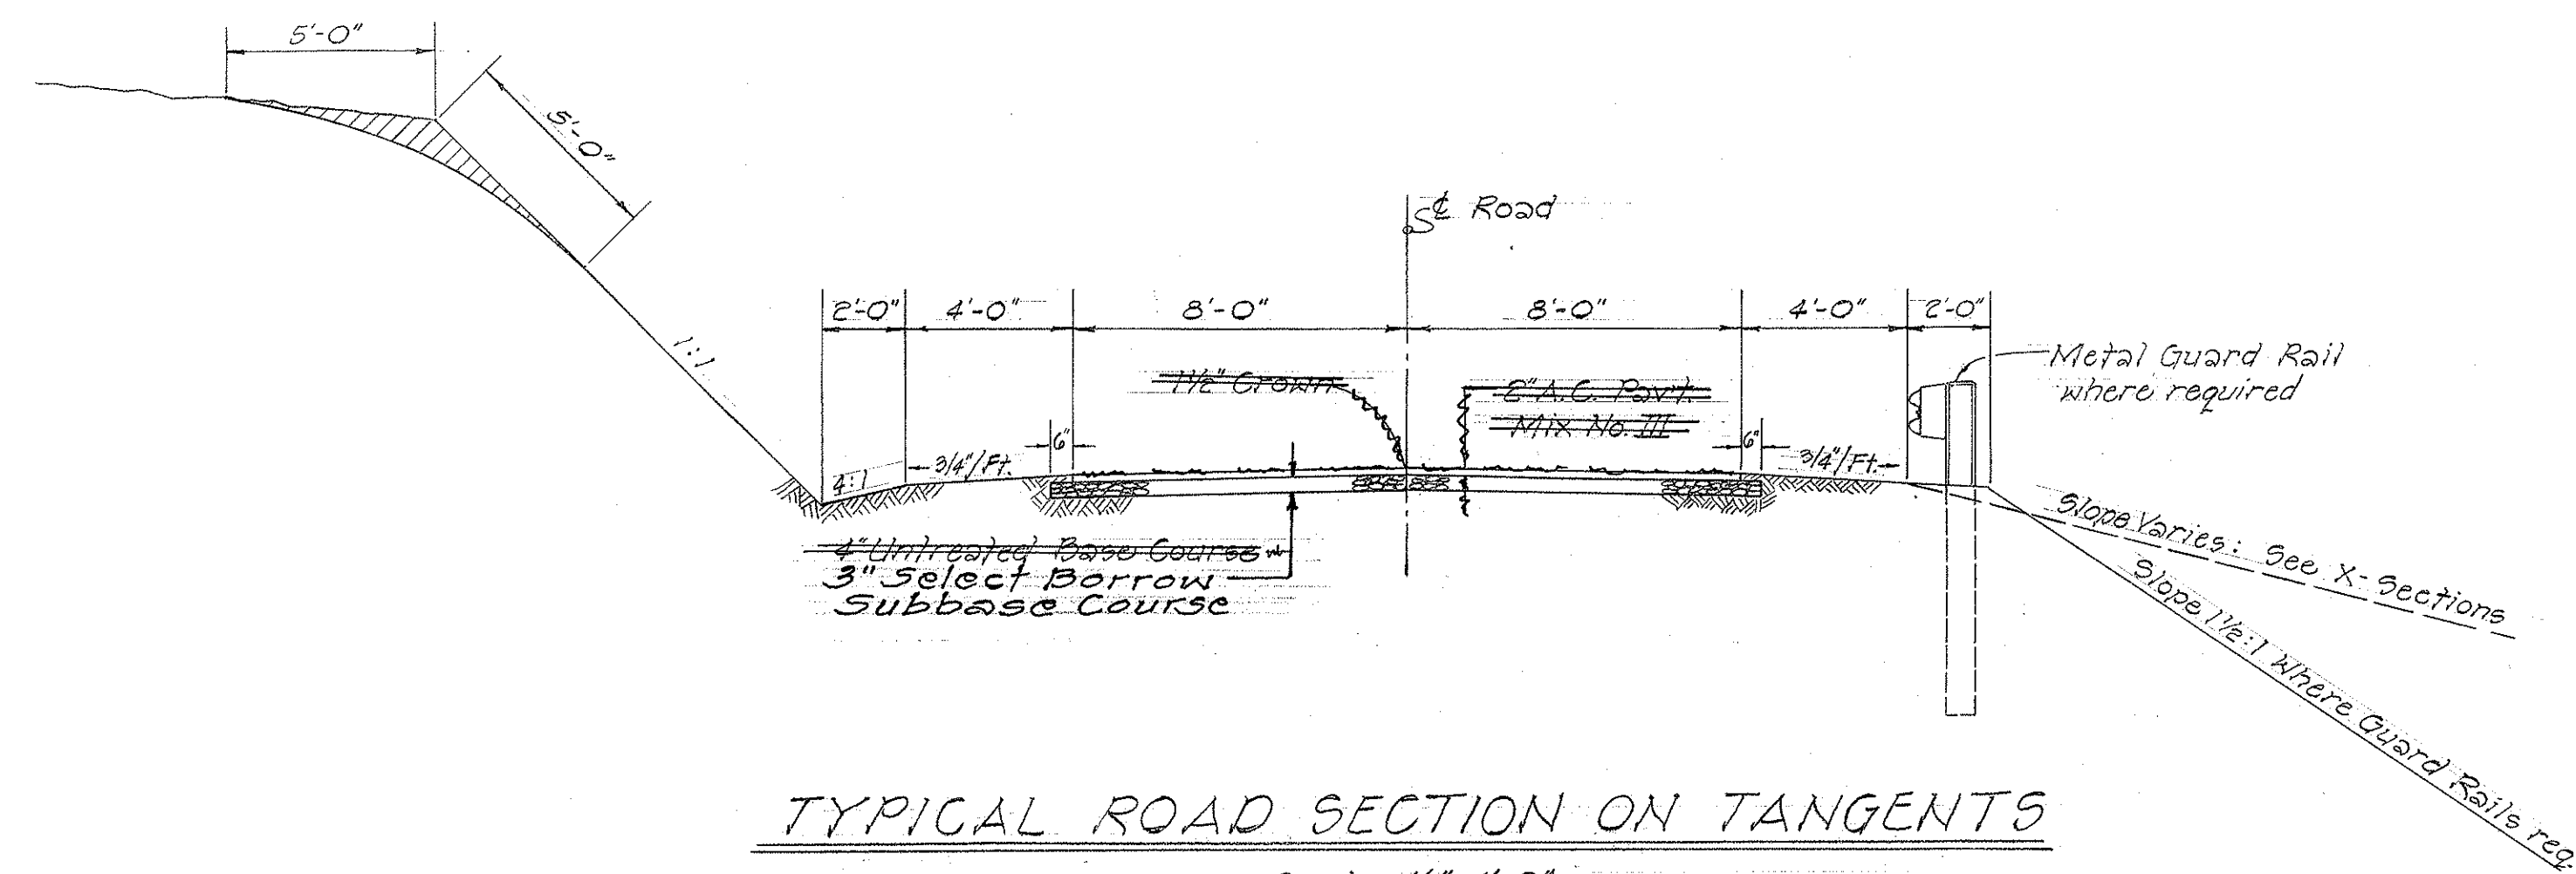

DETAIL OF SIDE ROAD APPROACHES
Scale: 1/4" = 1'-0"

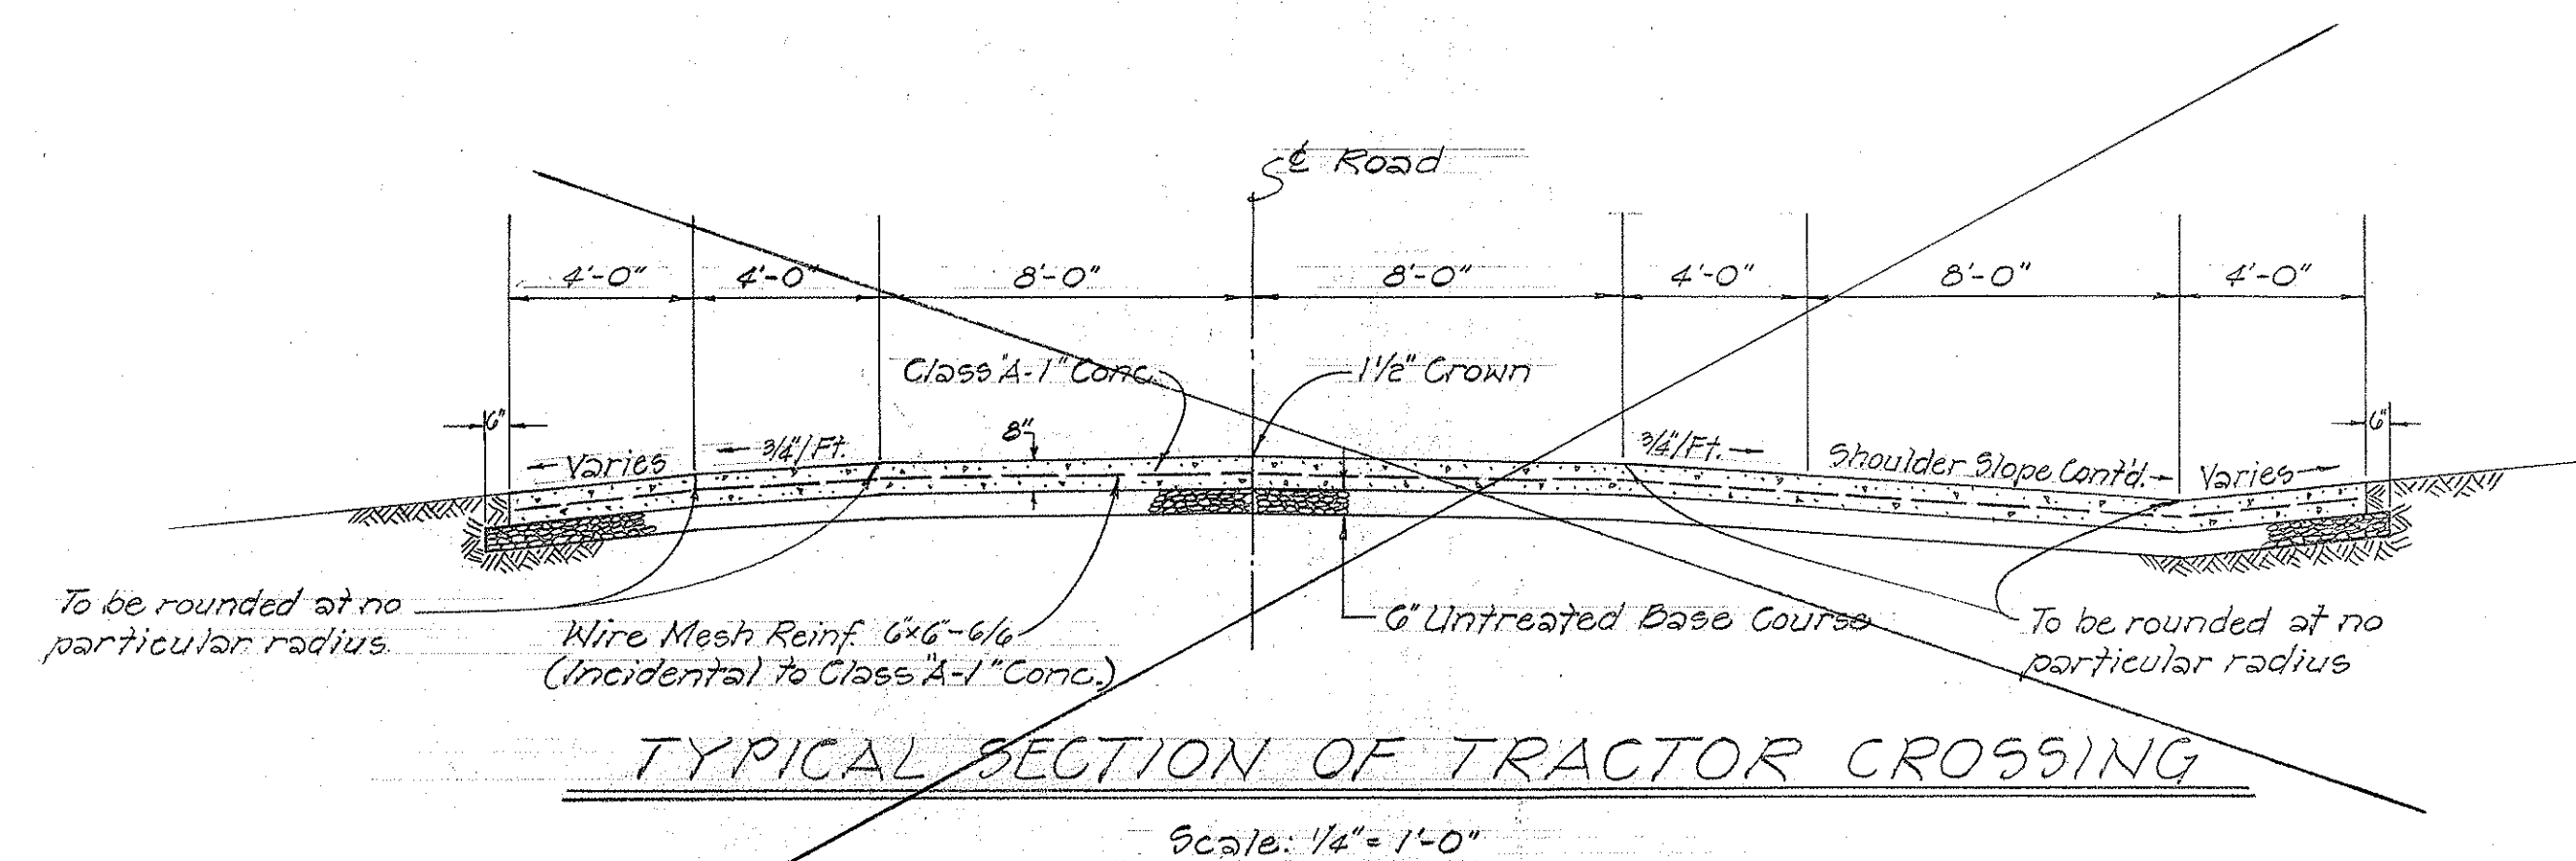

NOTE:
The Typical Sections and Details on this sheet show the ultimate desired effect, however only the slopes, grades and dimensions apply to this project.

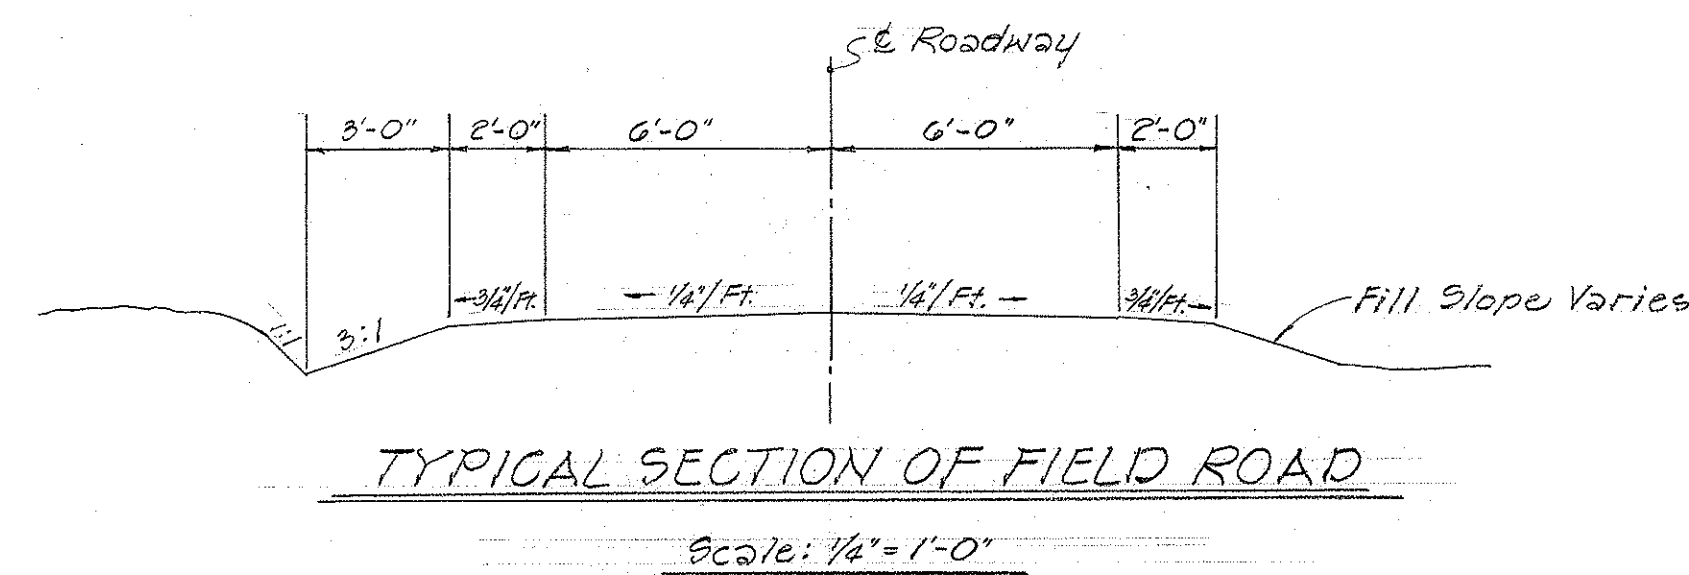

STATE OF HAWAII
DEPARTMENT OF TRANSPORTATION
HIGHWAYS DIVISION

TYPICAL SECTIONS
& MISCELLANEOUS DETAILS

LILUOUE-WAILUA-PRINCEVILLE ROAD
PROJECT NO. BD 67-359

SCALE: AS SHOWN DATE: MAY, 1968

SHEET No. 1 OF 1 SHEETS

ORIGINAL PLAN	DATE
SURVEY PLOTTED BY	
DRAWN BY	
CHECKED BY	
NOTED BY	
QUANTITIES BY	
CHECKED BY	
NO.	