
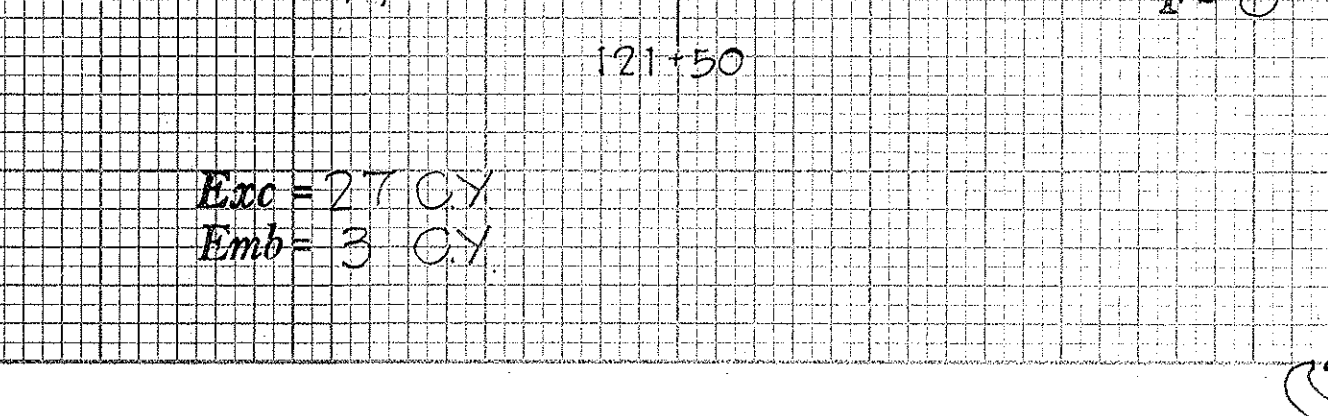
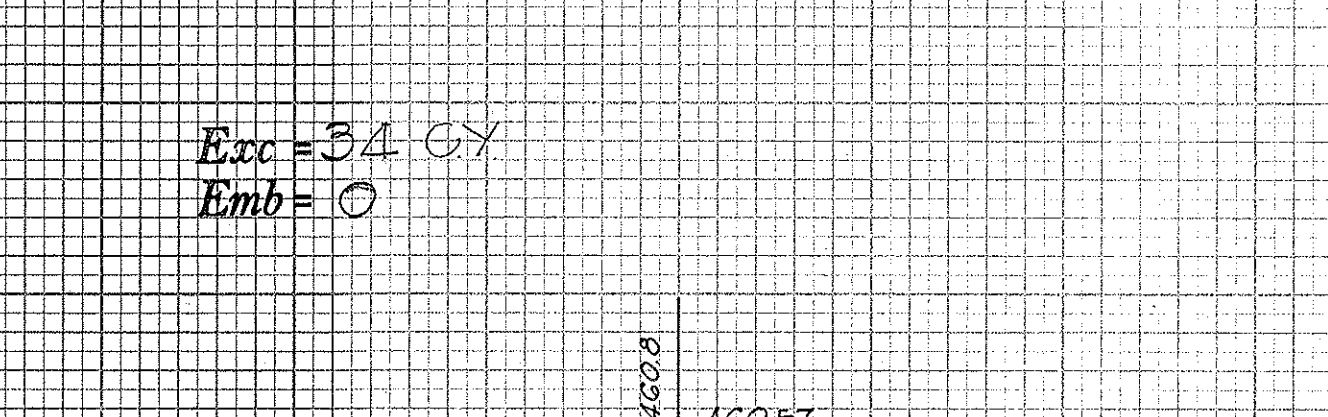
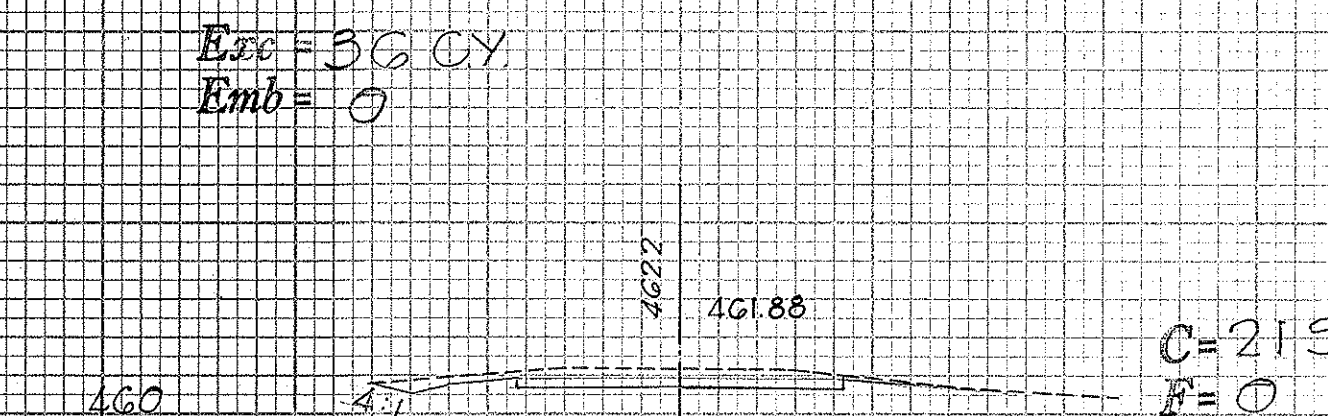
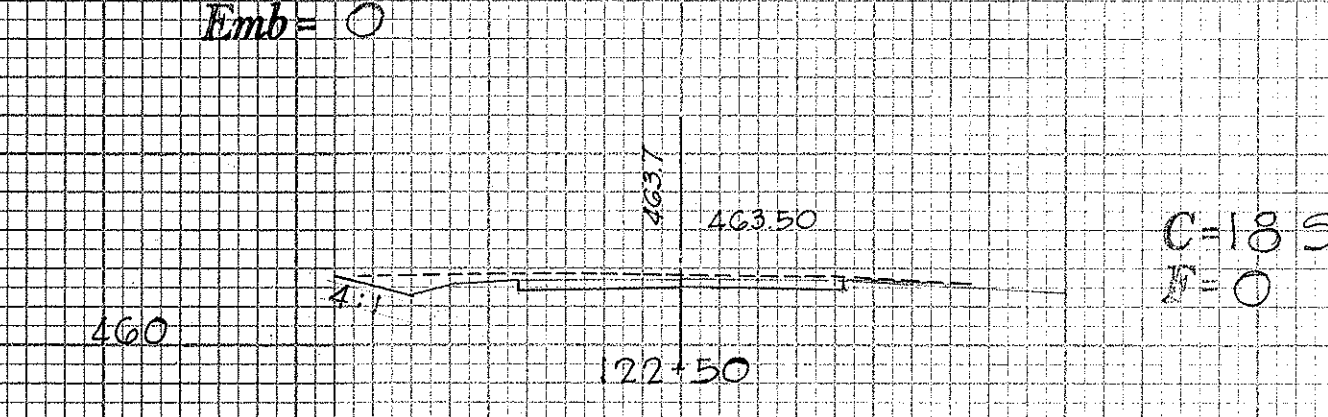
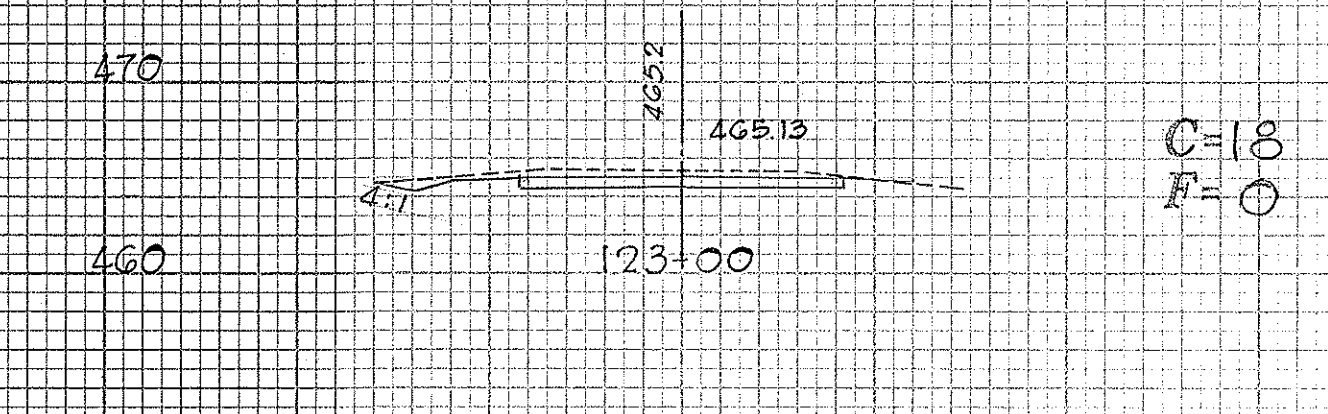
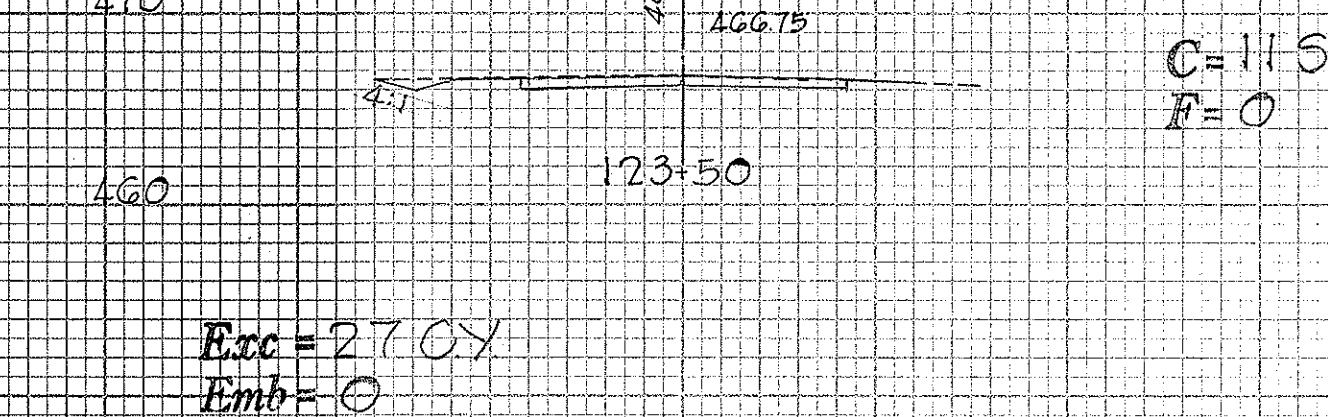
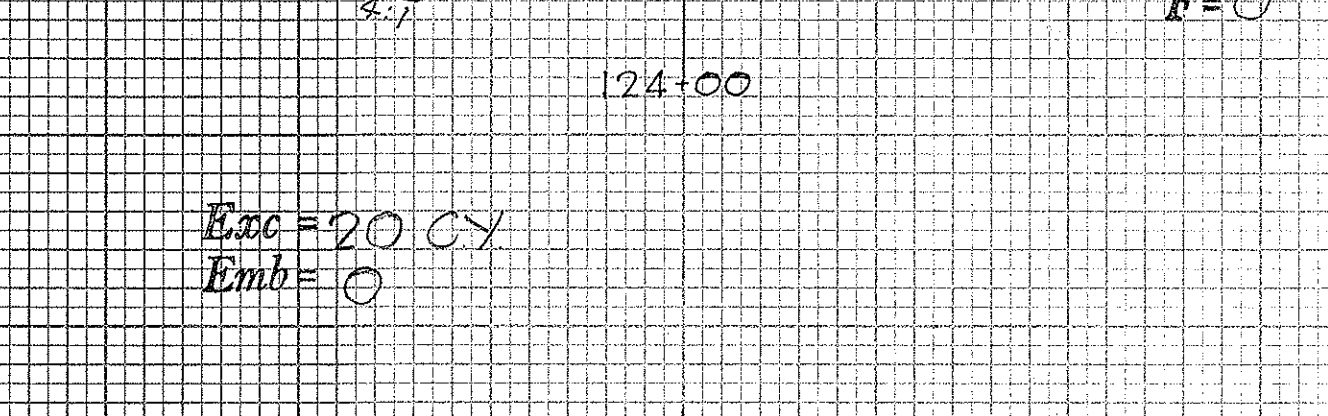
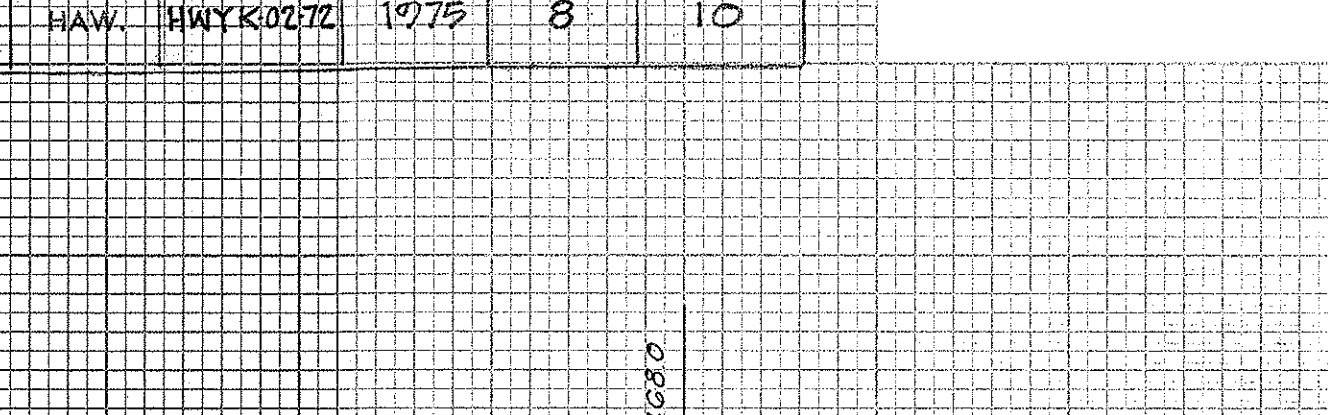
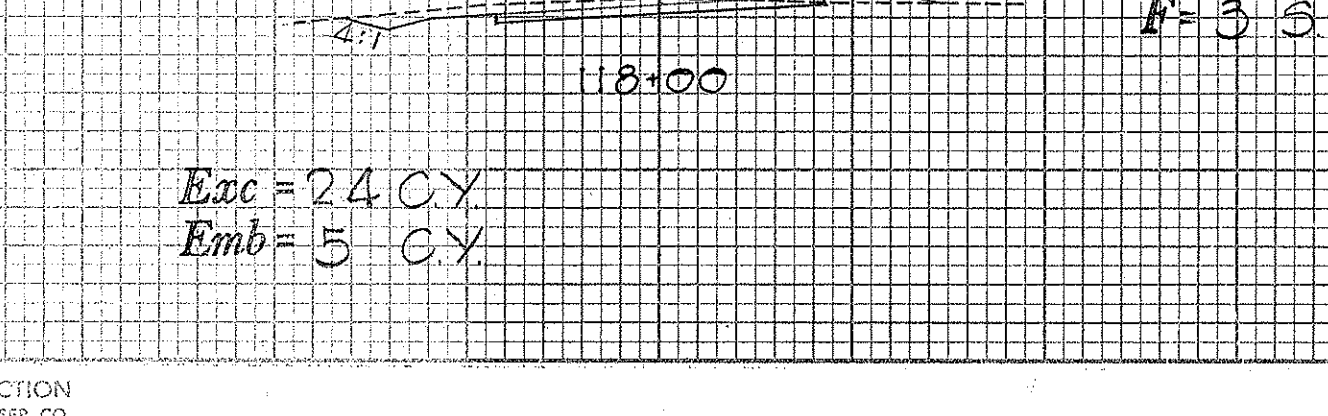
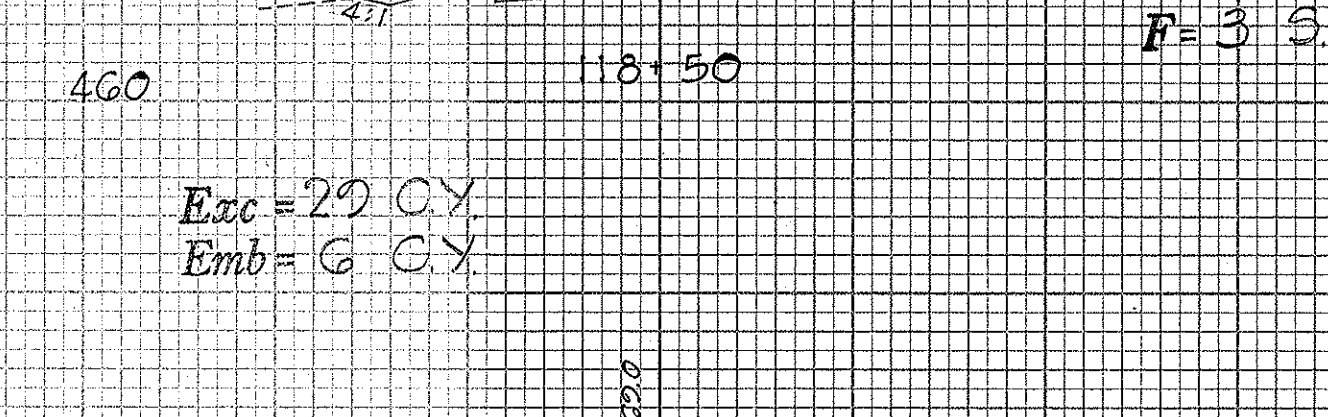
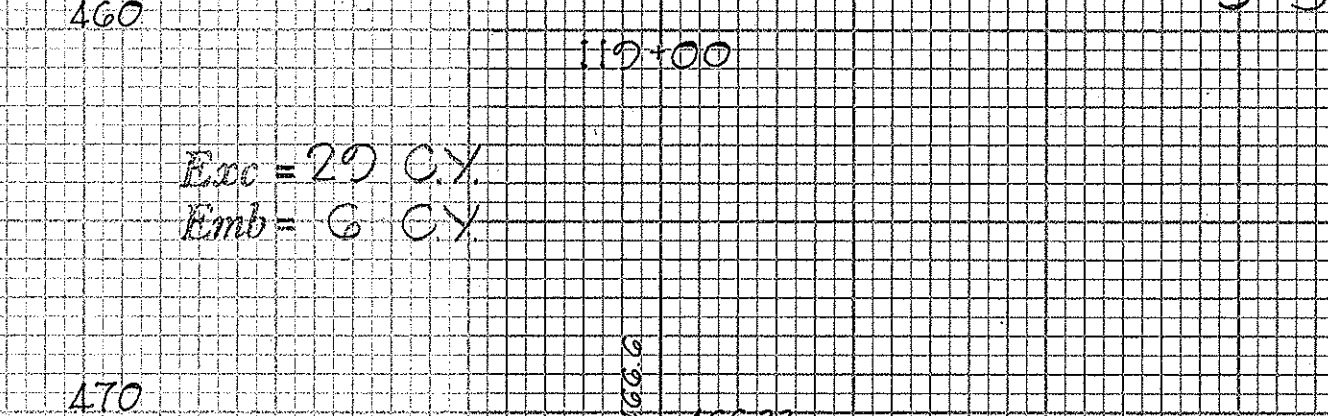
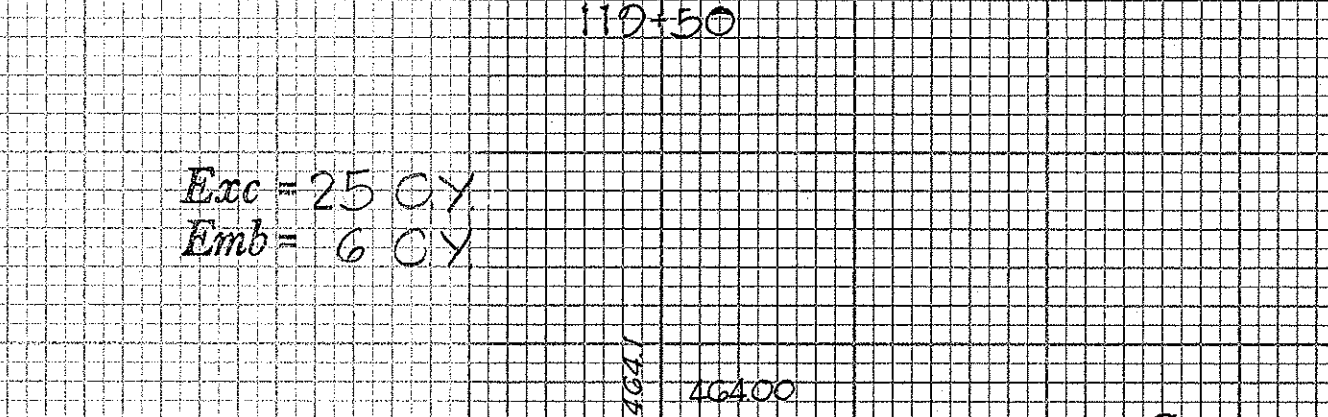
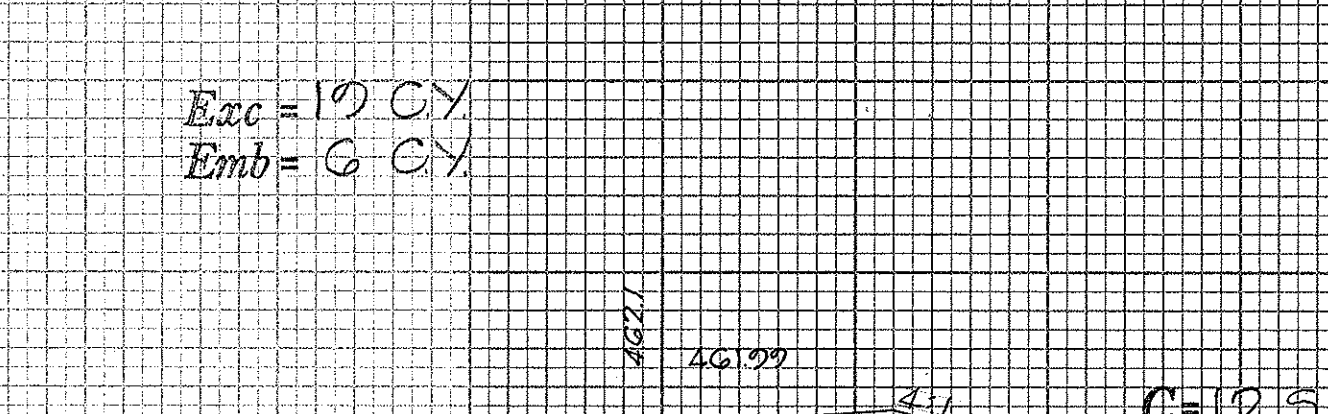
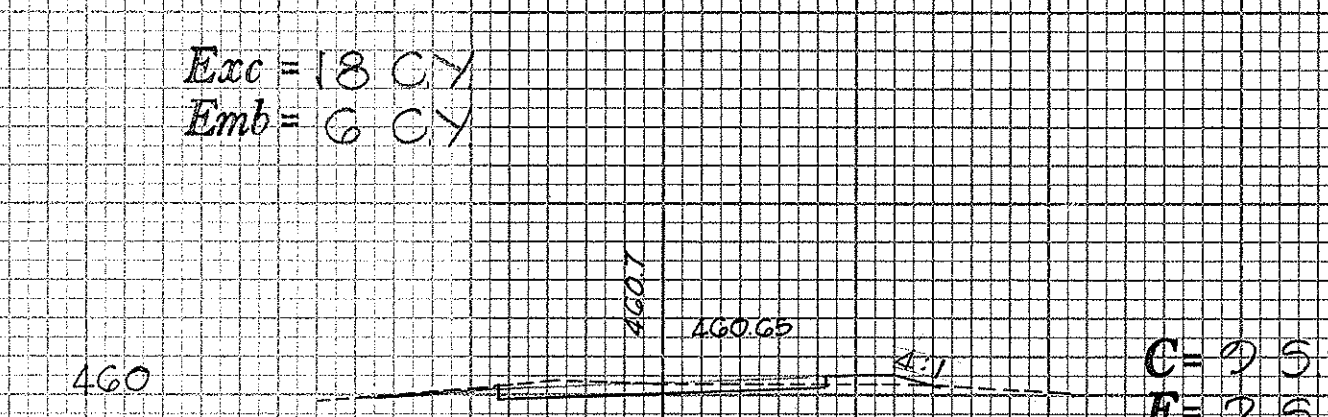
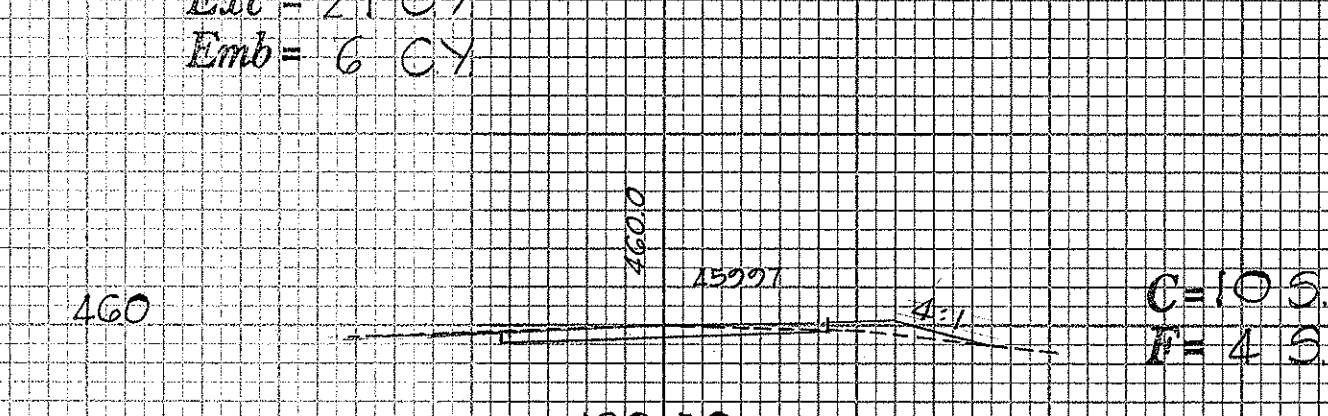
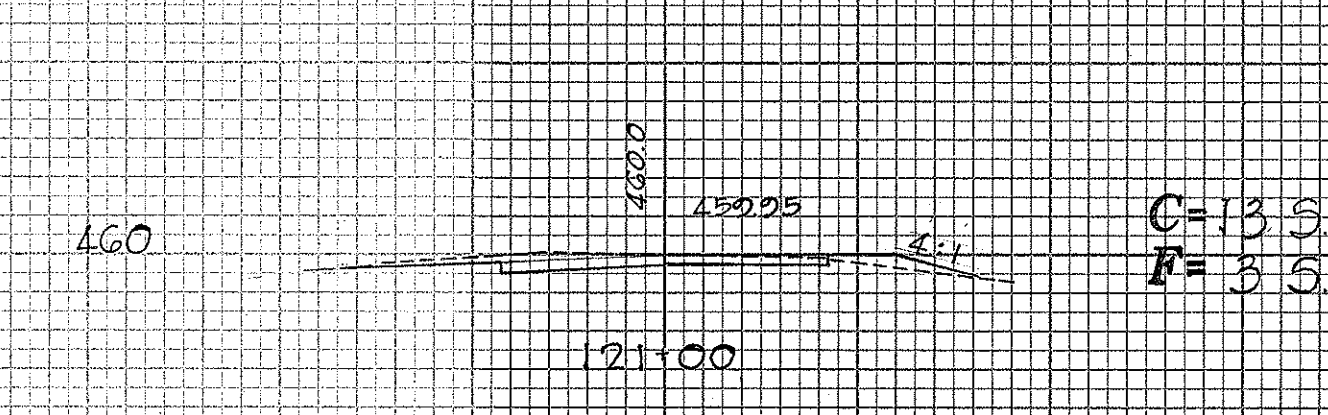
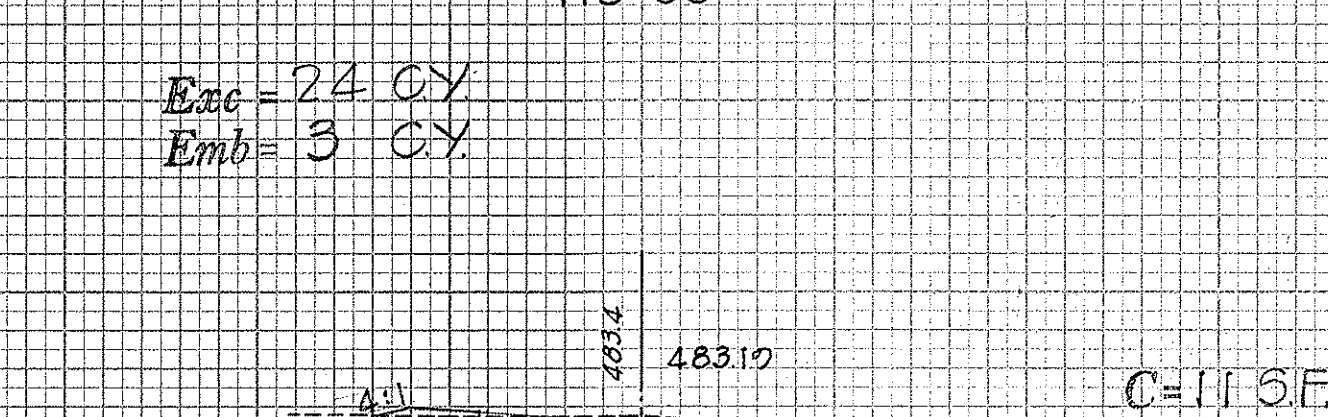
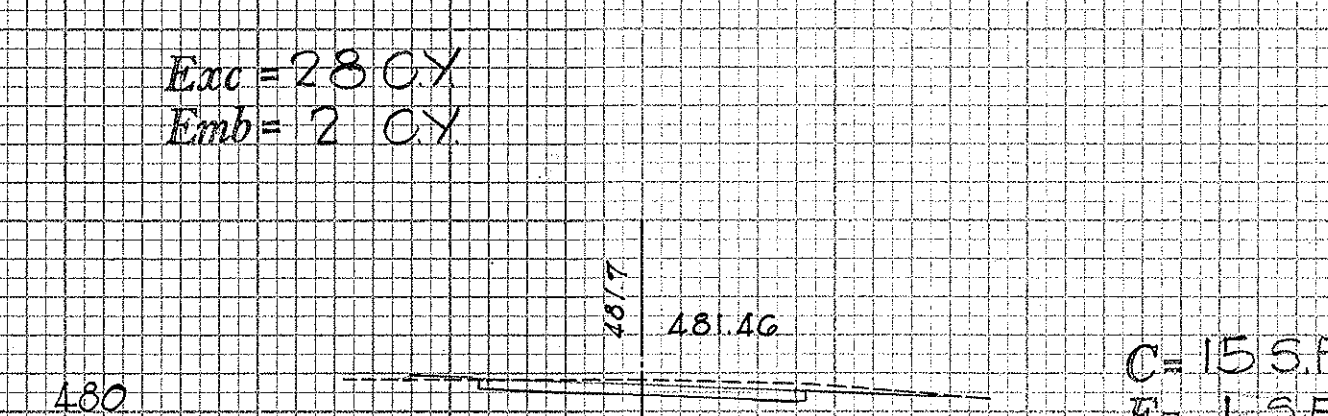
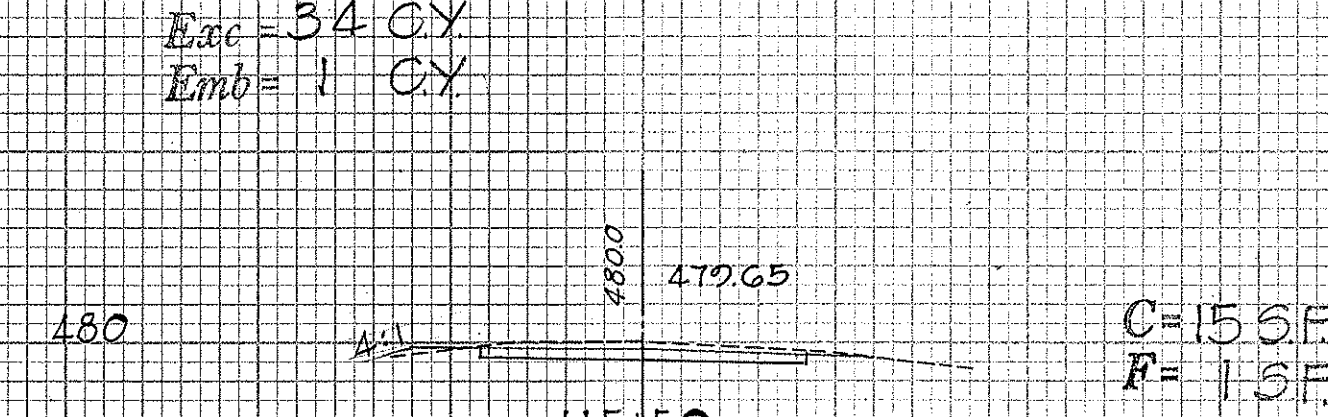
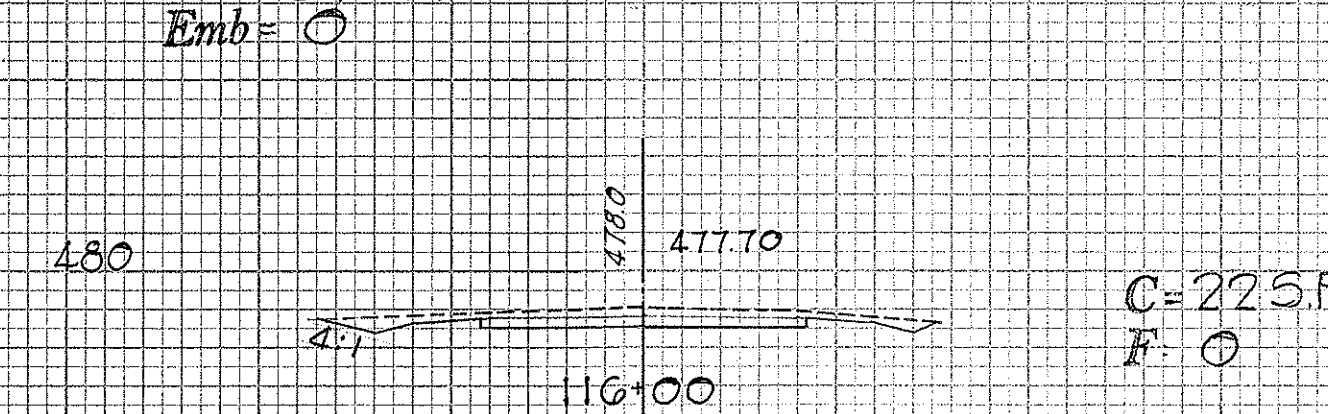
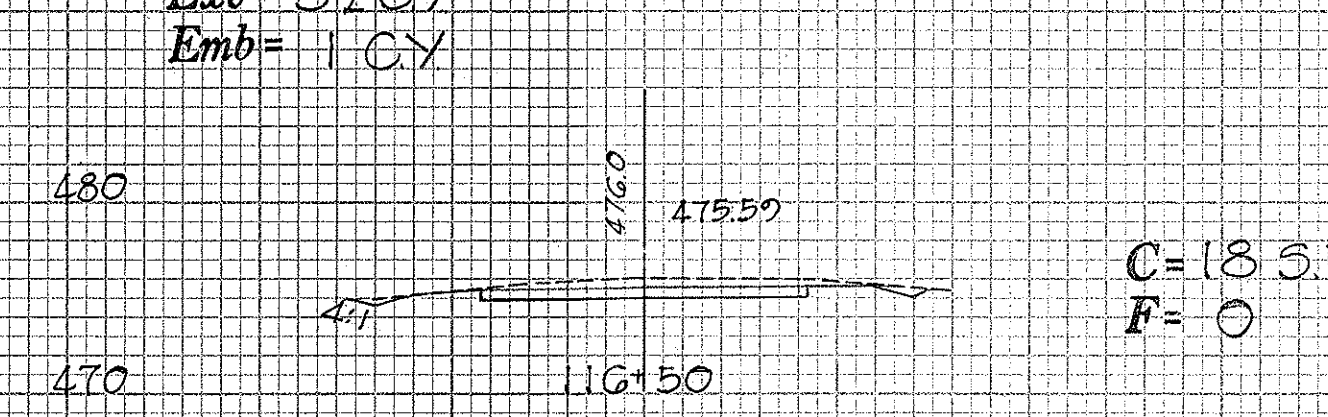
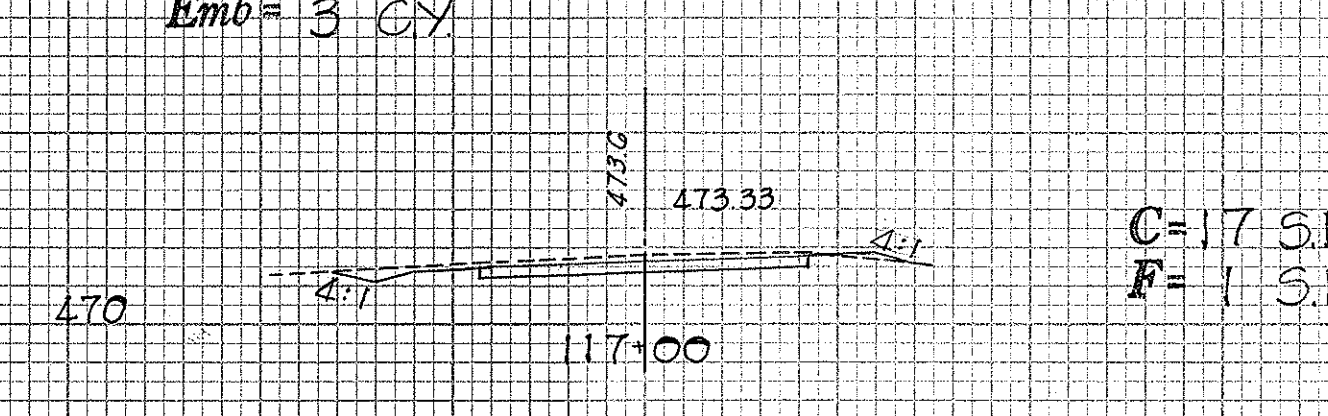
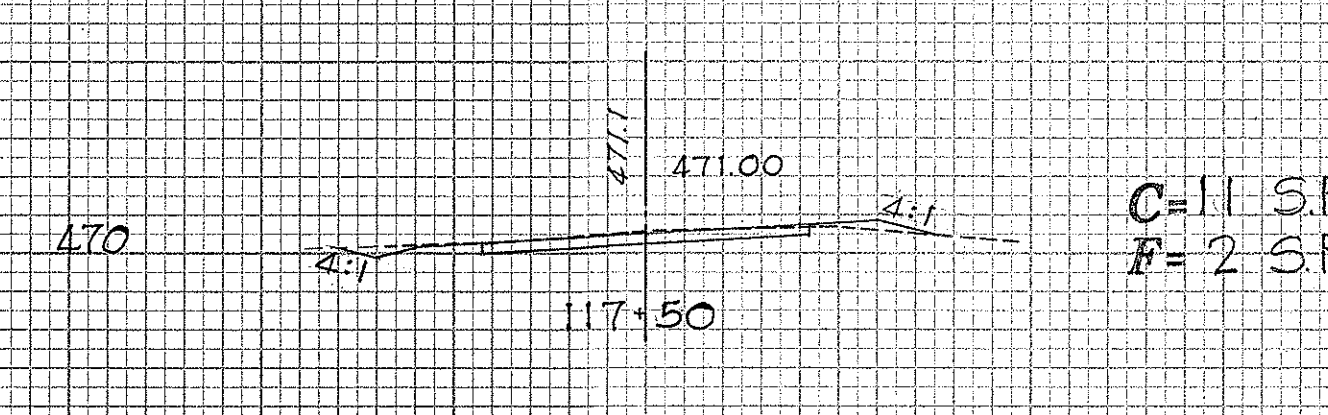
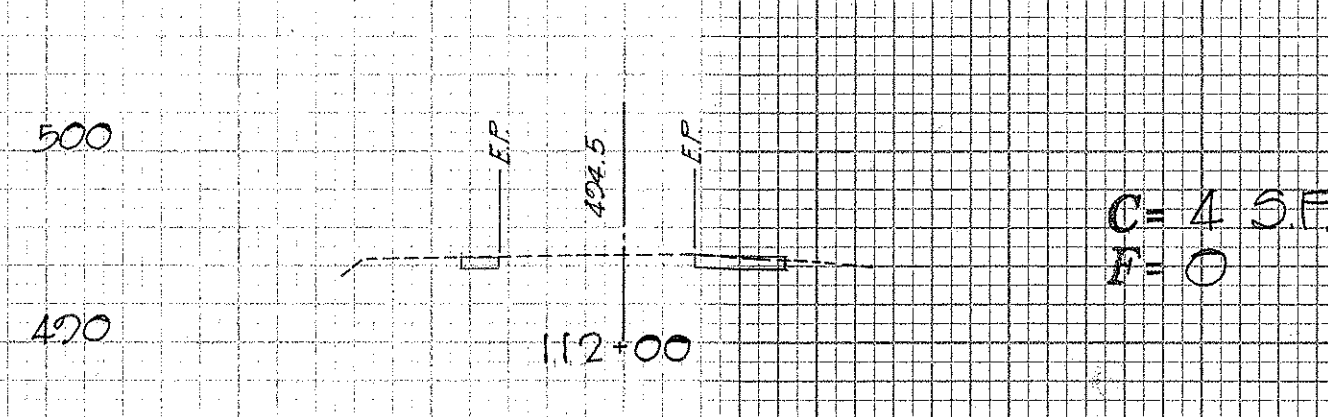
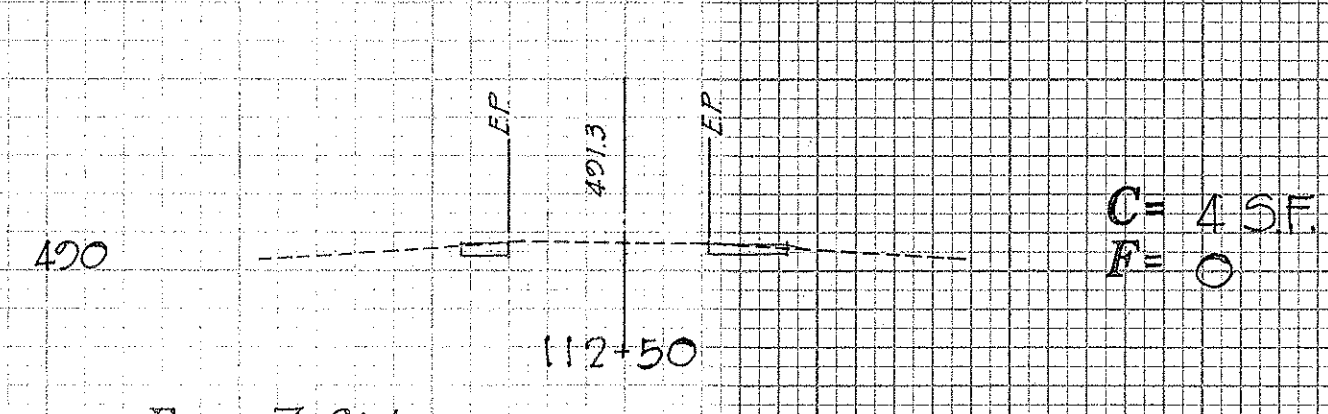
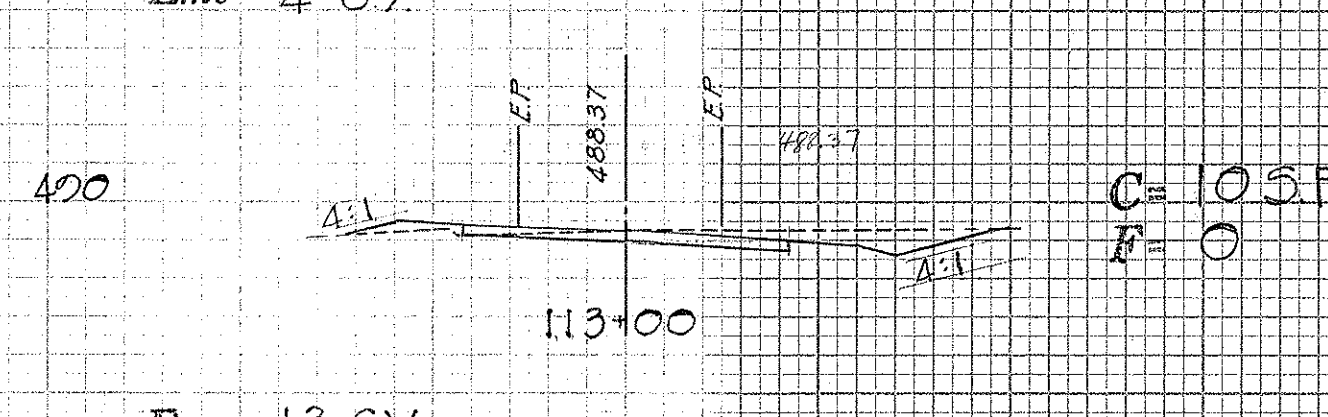
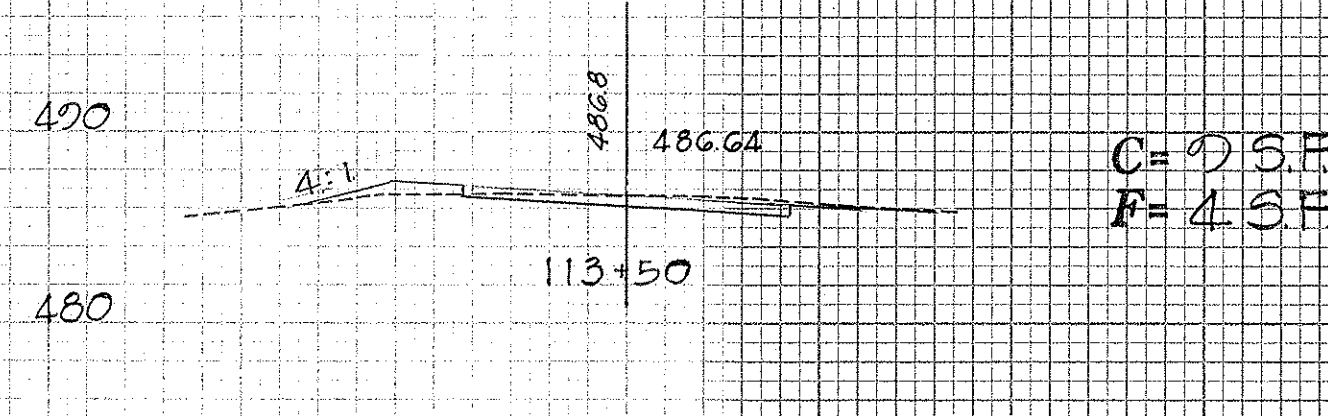


|      |    |              |               |      |    |
|------|----|--------------|---------------|------|----|
| DATE | BY | FINAL SURVEY | PLOTTED       | DATE | BY |
|      |    | NOTE BOOK    | ASSETS        |      |    |
|      |    | NO.          | AREAS CHECKED |      |    |

|      |    |                 |               |      |    |
|------|----|-----------------|---------------|------|----|
| DATE | BY | ORIGINAL SURVEY | PLOTTED       | DATE | BY |
|      |    | NOTE BOOK       | ASSETS        |      |    |
|      |    | NO.             | AREAS CHECKED |      |    |

| RED. ROAD DIST. NO. | STATE | PROJ. NO. | FISCAL YEAR | SHEET NO. | TOTAL SHEETS |
|---------------------|-------|-----------|-------------|-----------|--------------|
| HAWAII              | HAW.  | HWYK0272  | 1975        | 8         | 10           |

Scale: 1"=10' Bothways

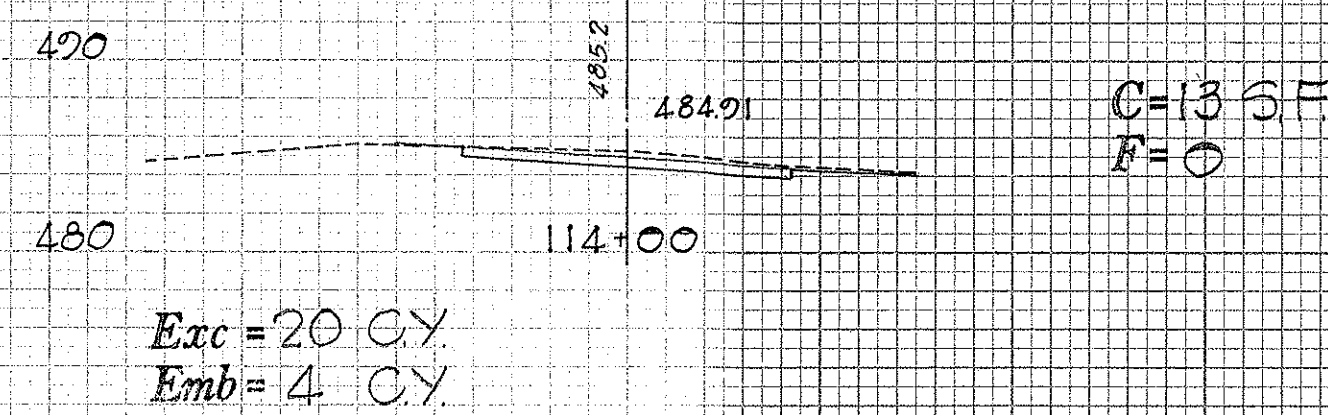




|      |    |                      |                  |      |
|------|----|----------------------|------------------|------|
| DATE | BY | FINAL SURVEY PLOTTED | NOTES BOOK AREAS | INC. |
|      |    |                      |                  |      |

|      |    |                         |                  |      |
|------|----|-------------------------|------------------|------|
| DATE | BY | ORIGINAL SURVEY PLOTTED | NOTES BOOK AREAS | INC. |
|      |    |                         |                  |      |

| FED. ROAD DIST. NO. | STATE | PROJ. NO. | FISCAL YEAR | SHEET NO. | TOTAL SHEETS |
|---------------------|-------|-----------|-------------|-----------|--------------|
| HAWAII              | HAW.  | HWYK02-71 | 1975        | 9         | 10           |

Scale: 1" = 10' Bothways

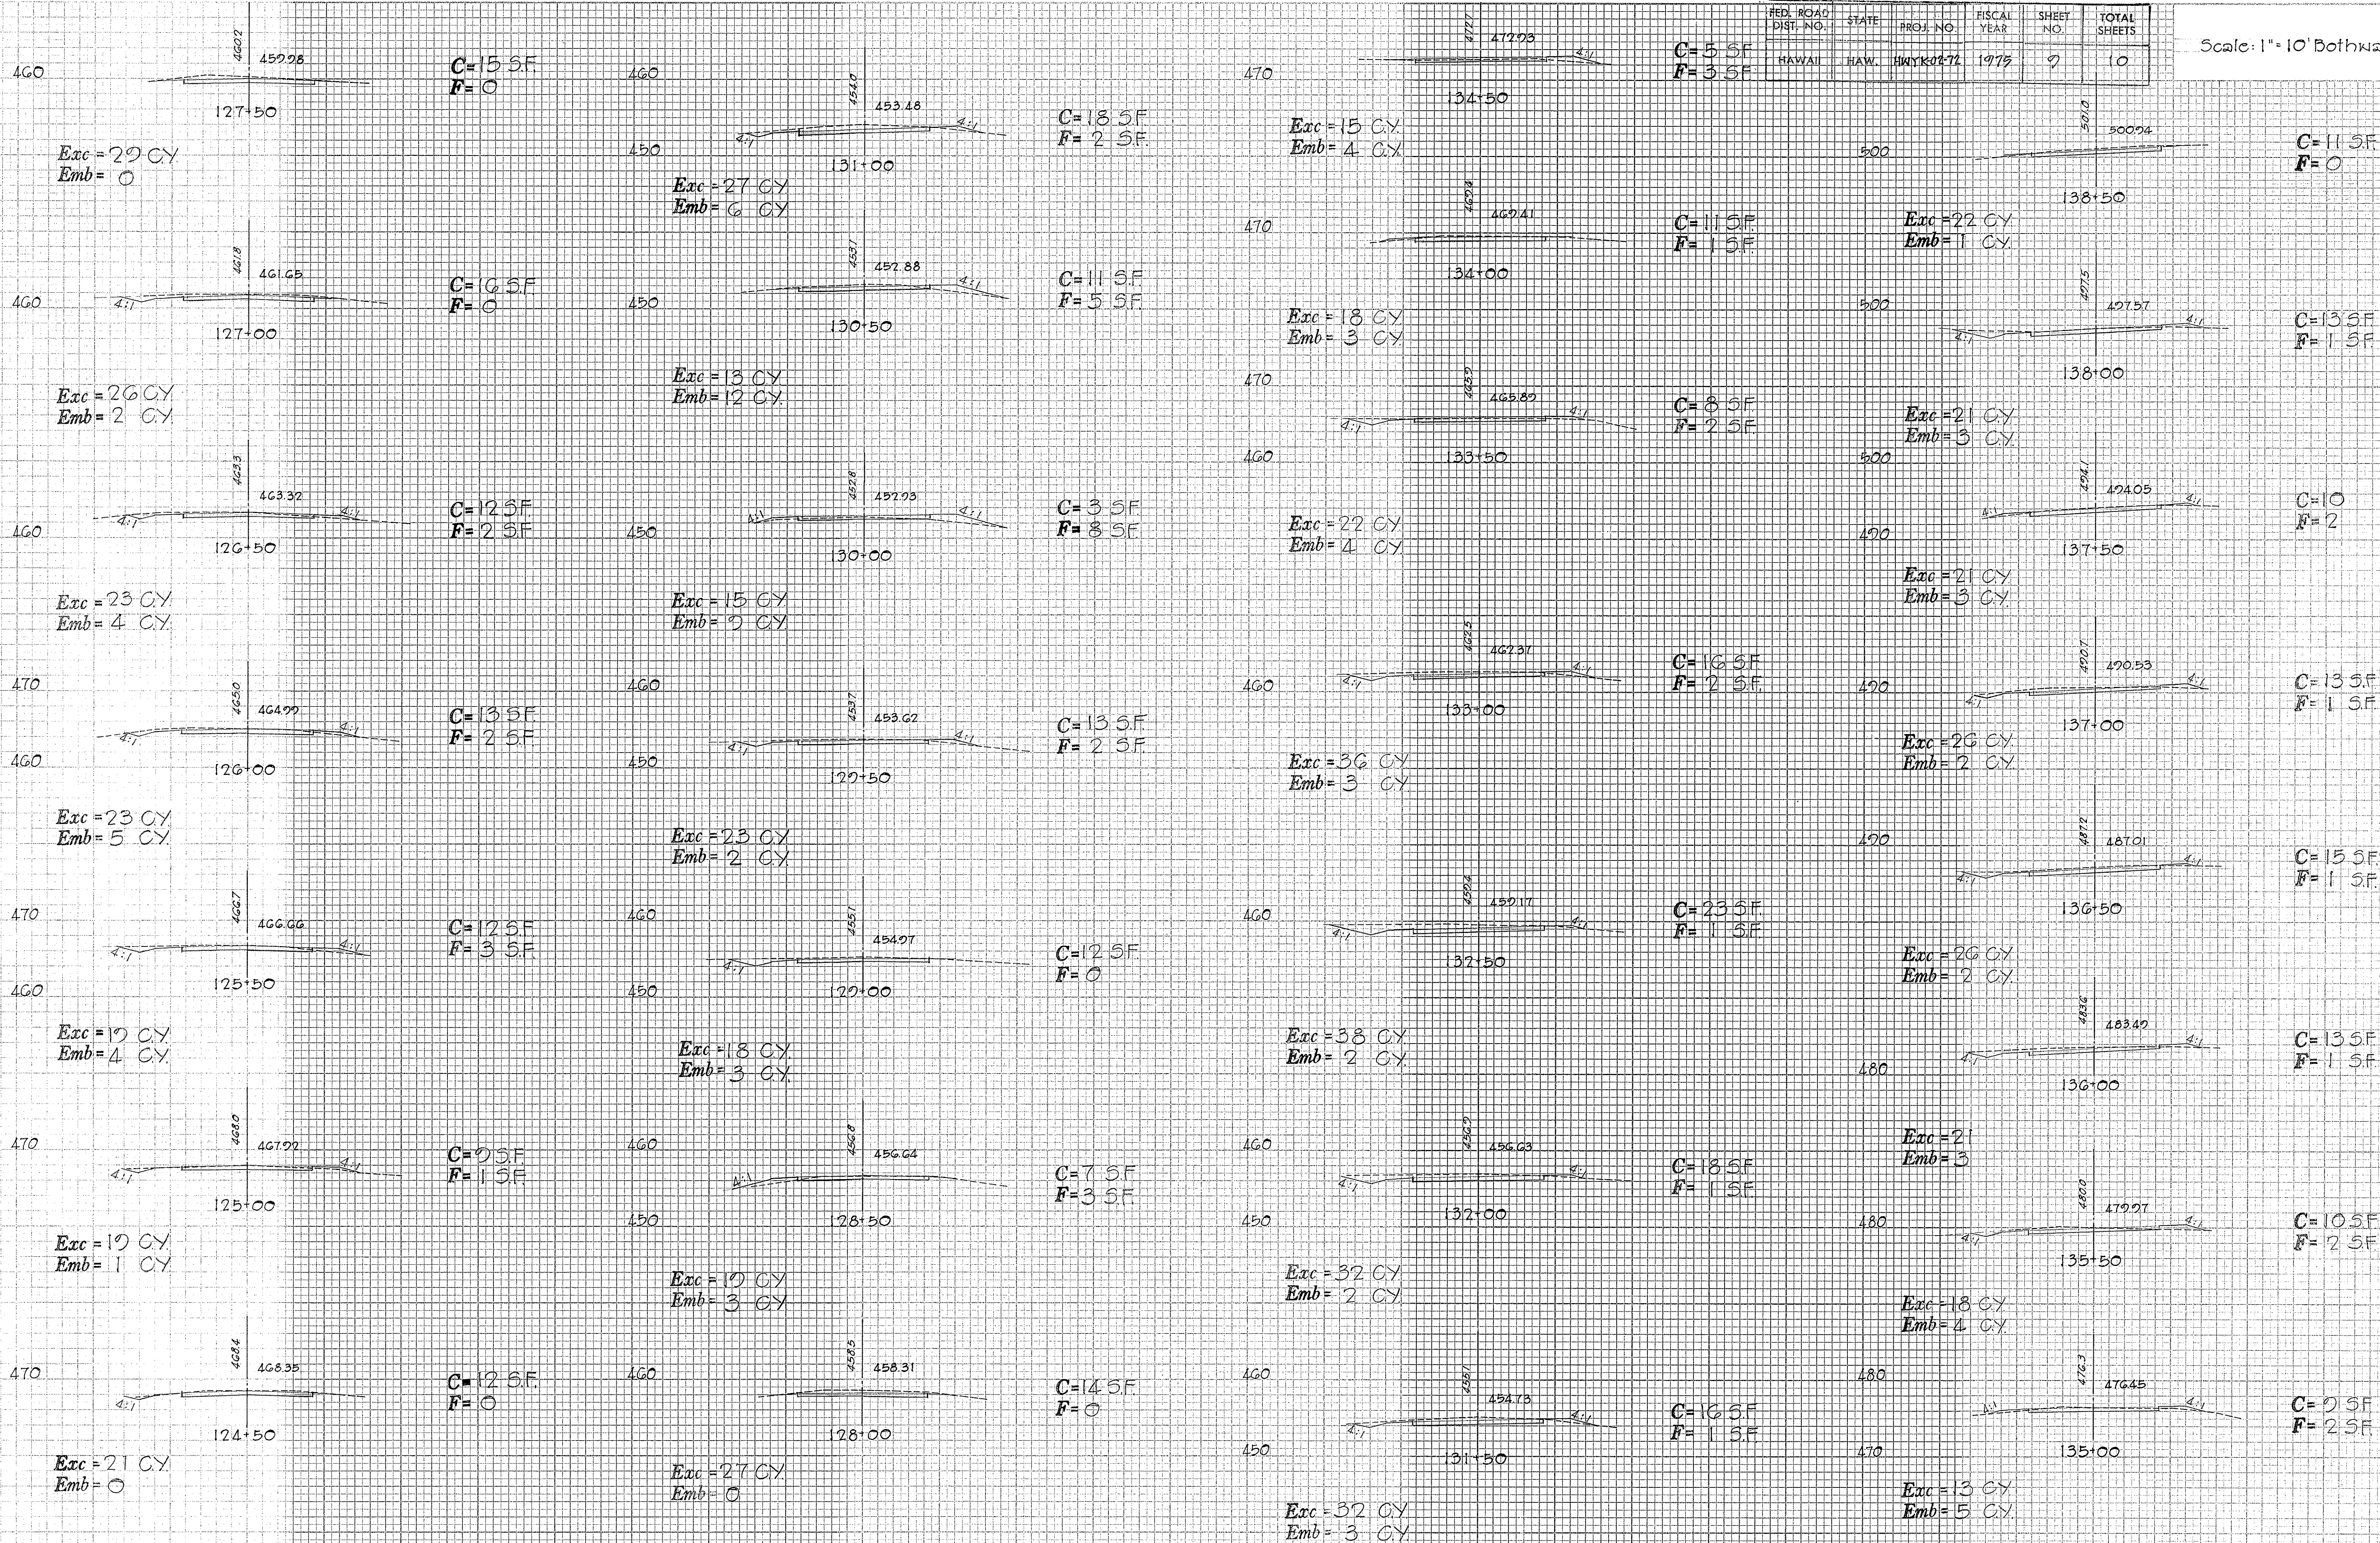




| RED. ROAD<br>DIST. NO. | STATE | PROJ. NO. | FISCAL<br>YEAR | SHEET<br>NO. | TOTAL<br>SHEETS |
|------------------------|-------|-----------|----------------|--------------|-----------------|
| HAWAII                 | HAW.  | HWY K0272 | 1975           | 10           | 10              |


Scale: 1" = 10' Bothways

| DATE | BY | FINAL<br>SURVEY | REVISION<br>PLATE | REVISION<br>NOTE BOOK | REVISION<br>AREAS CHECKED |
|------|----|-----------------|-------------------|-----------------------|---------------------------|
|      |    |                 |                   |                       |                           |


| DATE | BY | ORIGINAL<br>SURVEY | REVISION<br>PLATE | REVISION<br>NOTE BOOK | REVISION<br>AREAS CHECKED |
|------|----|--------------------|-------------------|-----------------------|---------------------------|
|      |    |                    |                   |                       |                           |

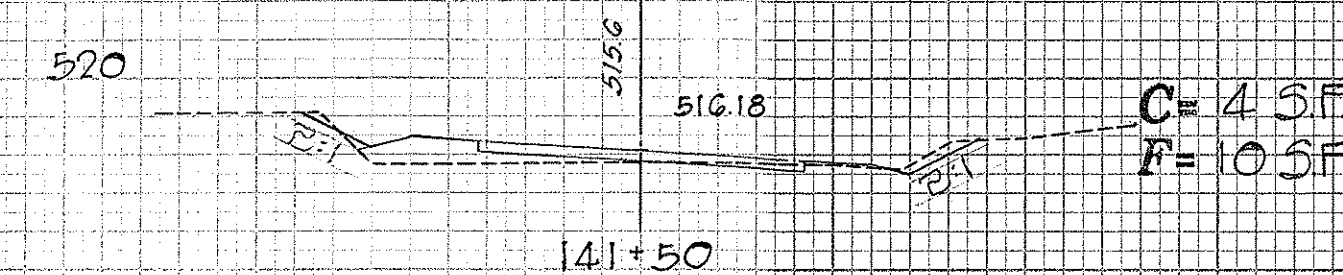


Exc = 17 CY  
Emb = 11 CY

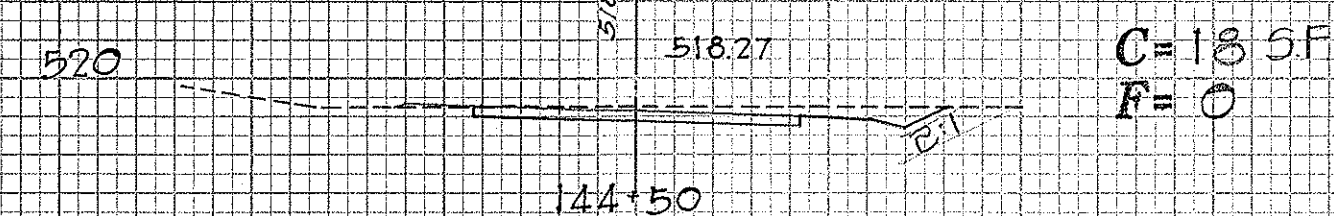


Exc = 17 CY  
Emb = 3 CY

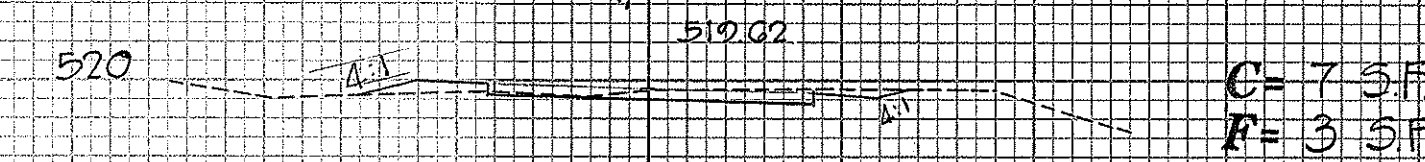


Exc = 18 CY  
Emb = 7 CY

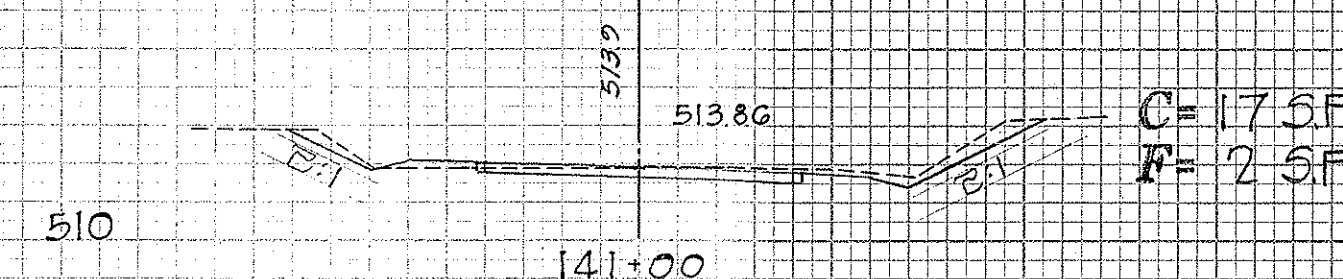


Exc = 44 CY  
Emb = 3 CY

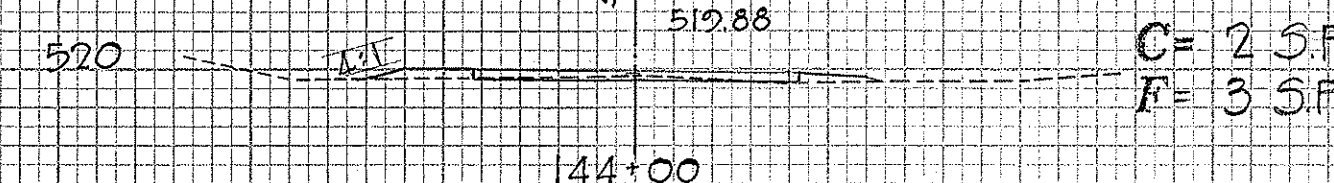


Exc = 2 CY  
Emb = 12 CY

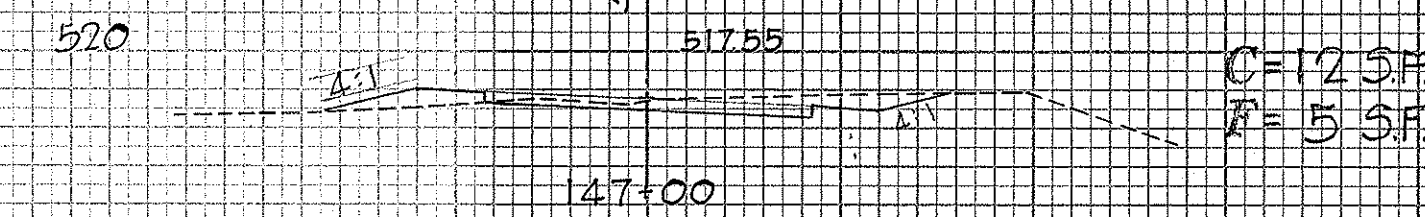


Exc = 15 CY  
Emb = 0 CY

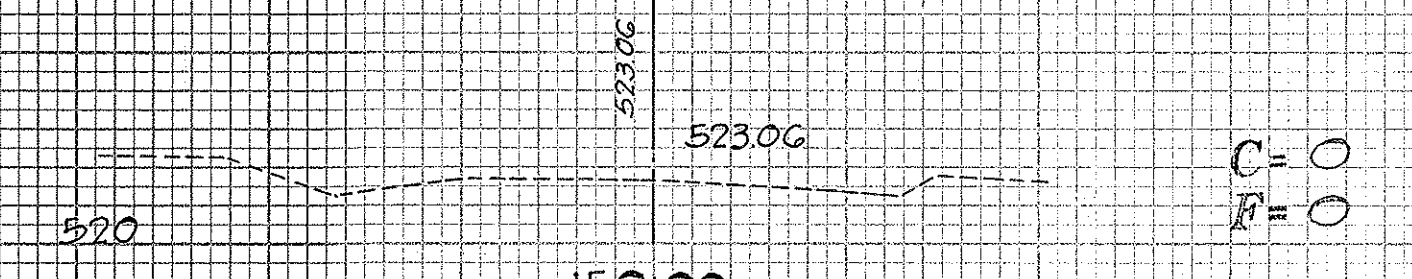


Exc = 8 CY  
Emb = 0 CY

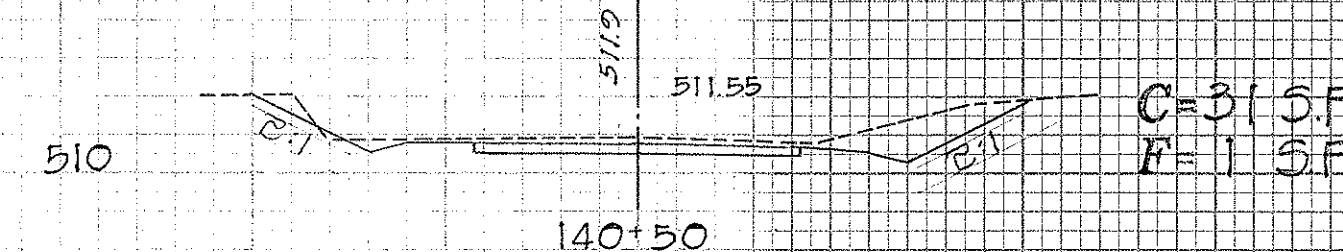


Exc = 46 CY  
Emb = 4 CY

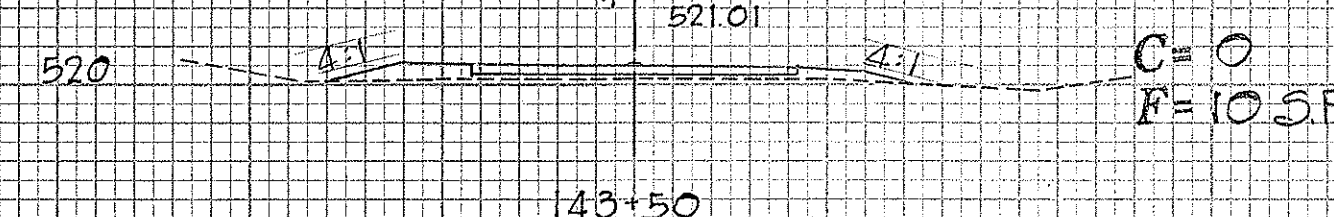


Exc = 0  
Emb = 40 CY

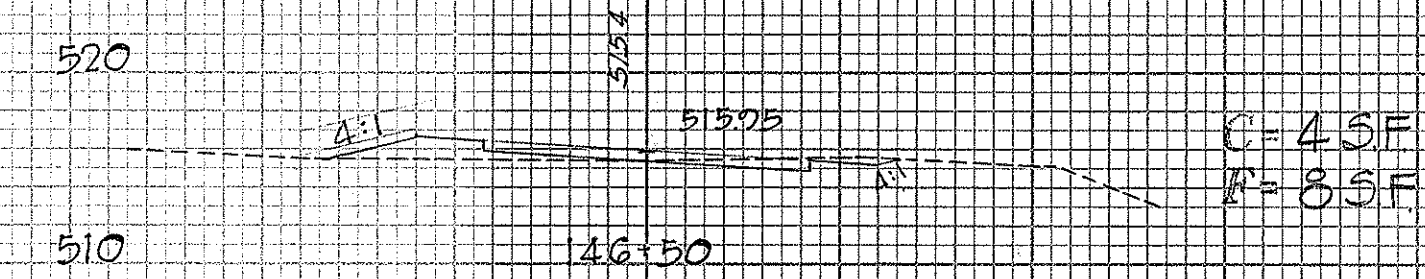


Exc = 4 CY  
Emb = 40 CY

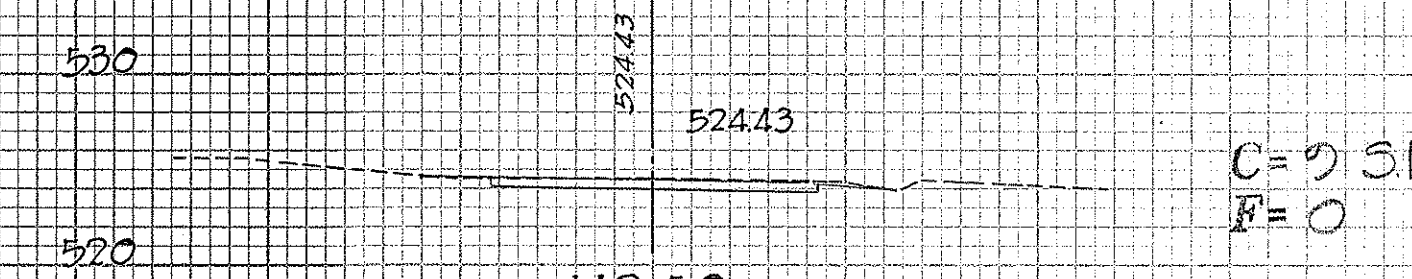


Exc = 17 CY  
Emb = 1 CY

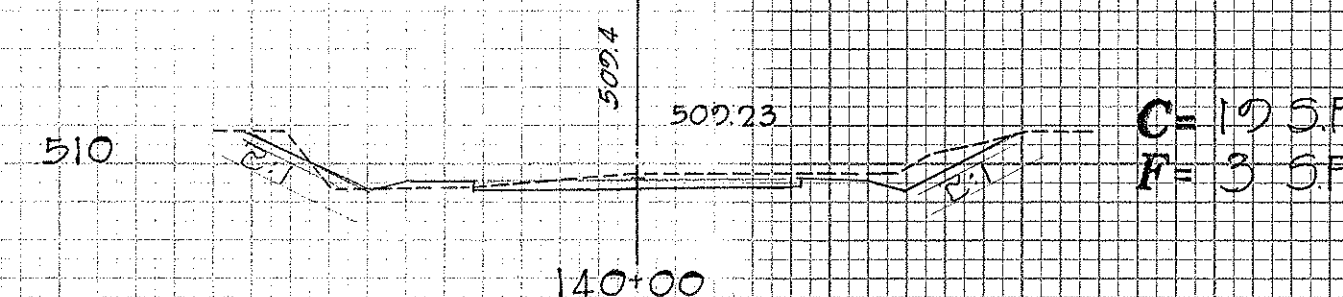


Exc = 36 CY  
Emb = 6 CY

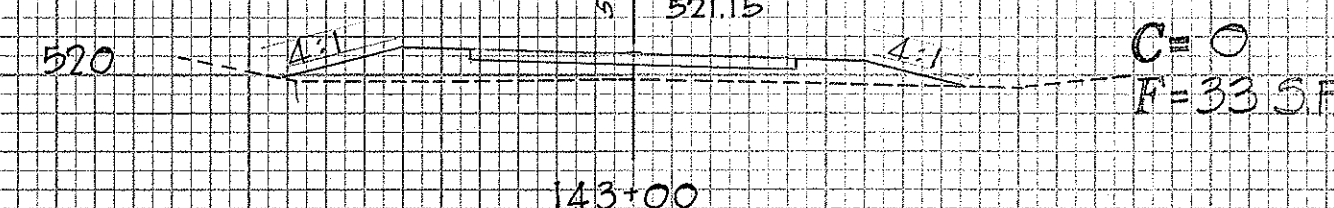


Exc = 0  
Emb = 58 CY

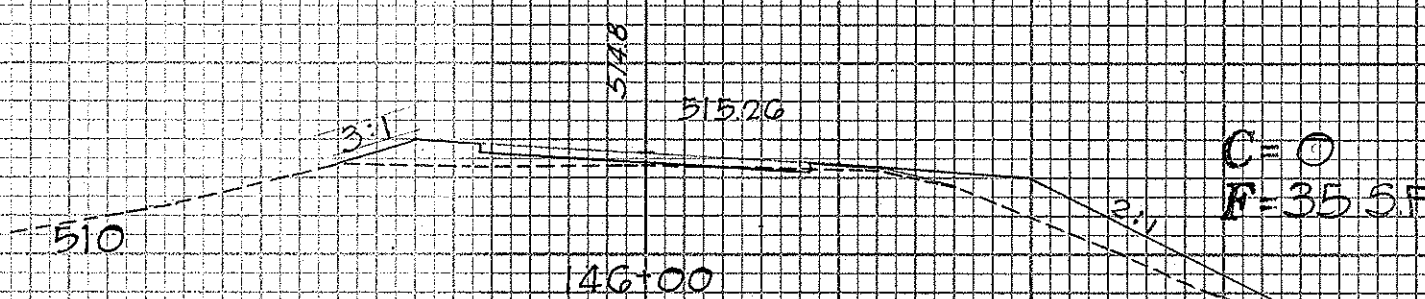


Exc = 6 CY  
Emb = 106 CY

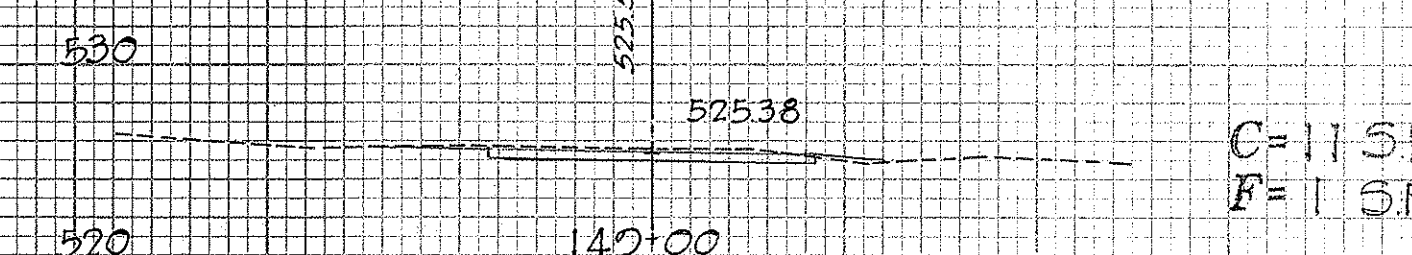


Exc = 18 CY  
Emb = 3 CY

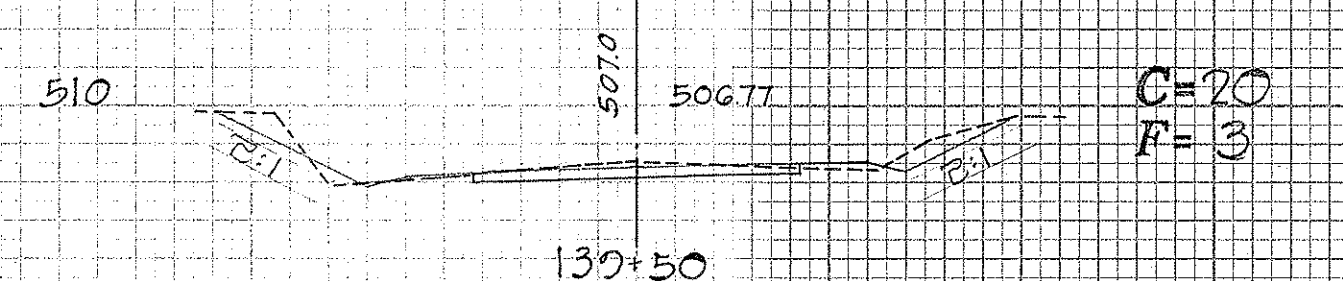


Exc = 36 CY  
Emb = 5 CY

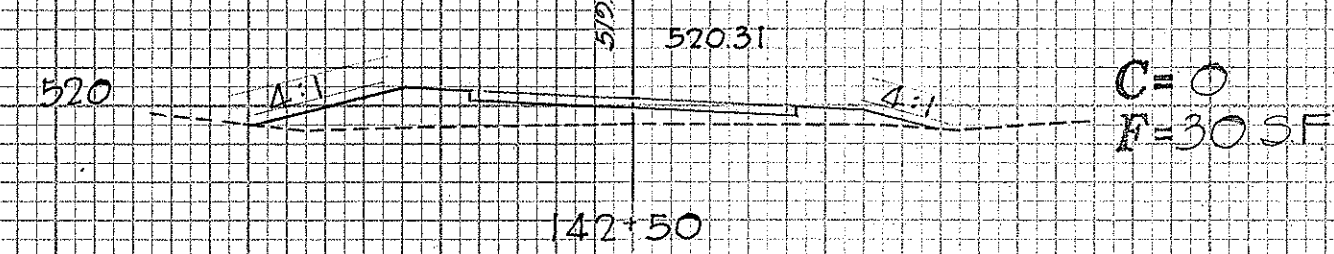


Exc = 0  
Emb = 52 CY

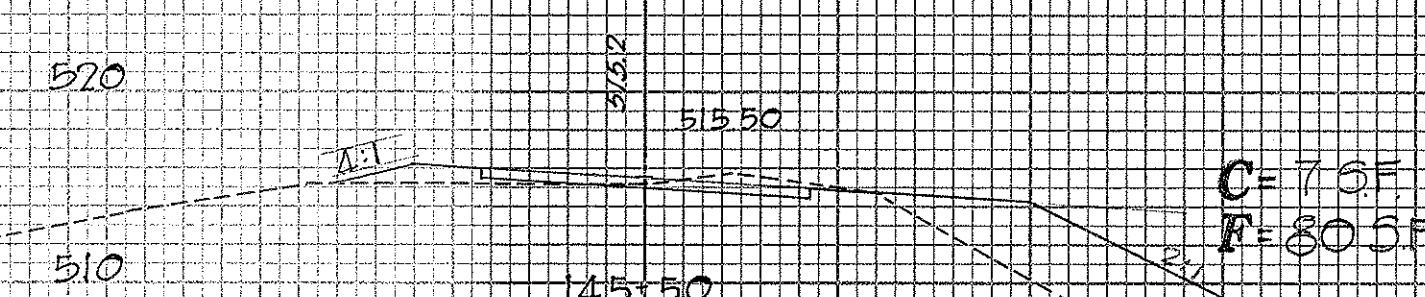


Exc = 26 CY  
Emb = 74 CY

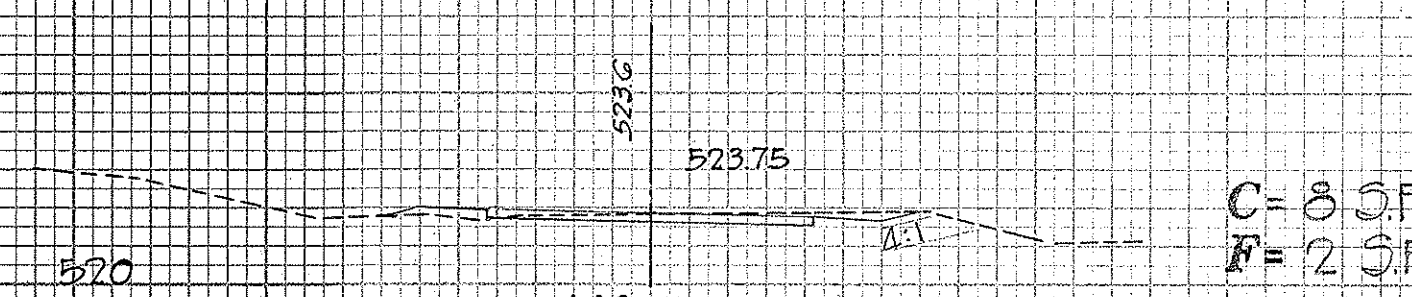


Exc = 12 CY  
Emb = 5 CY

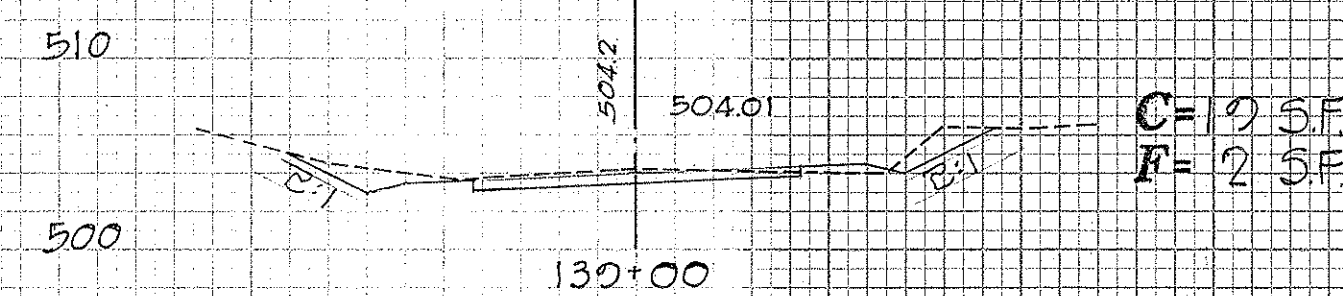


Exc = 28 CY  
Emb = 2 CY

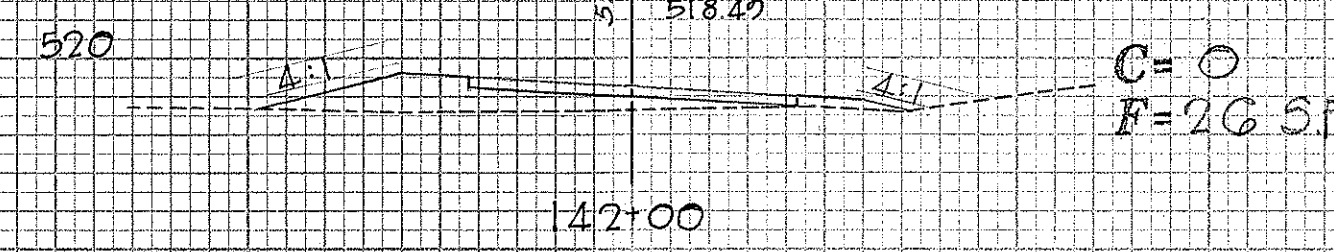

Exc = 4 CY  
Emb = 33 CY

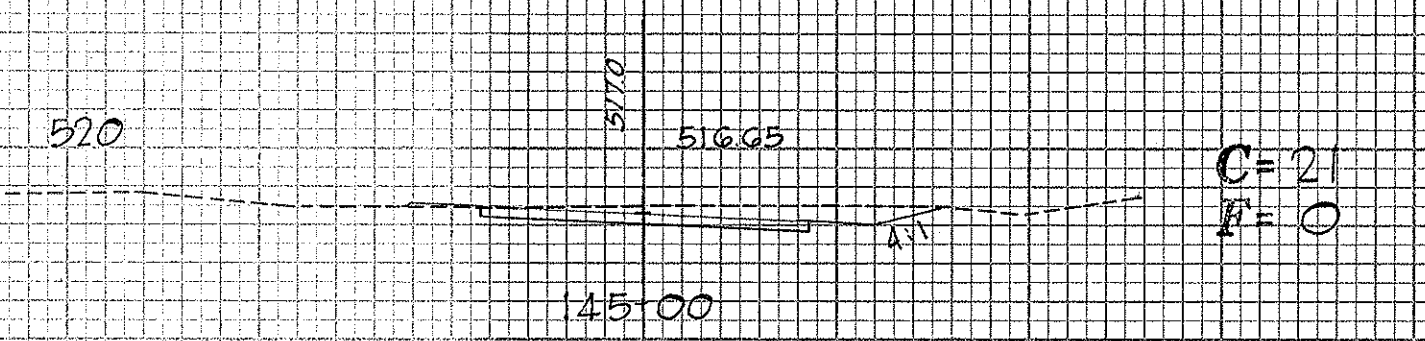

Exc = 36 CY  
Emb = 0 CY

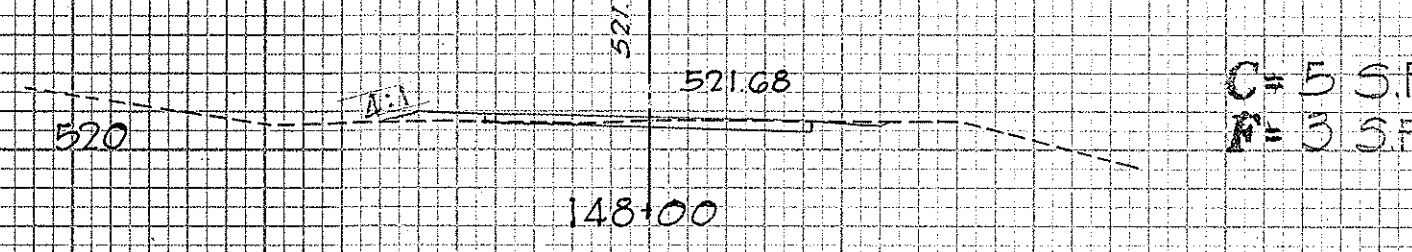

Exc = 11 CY  
Emb = 6 CY