
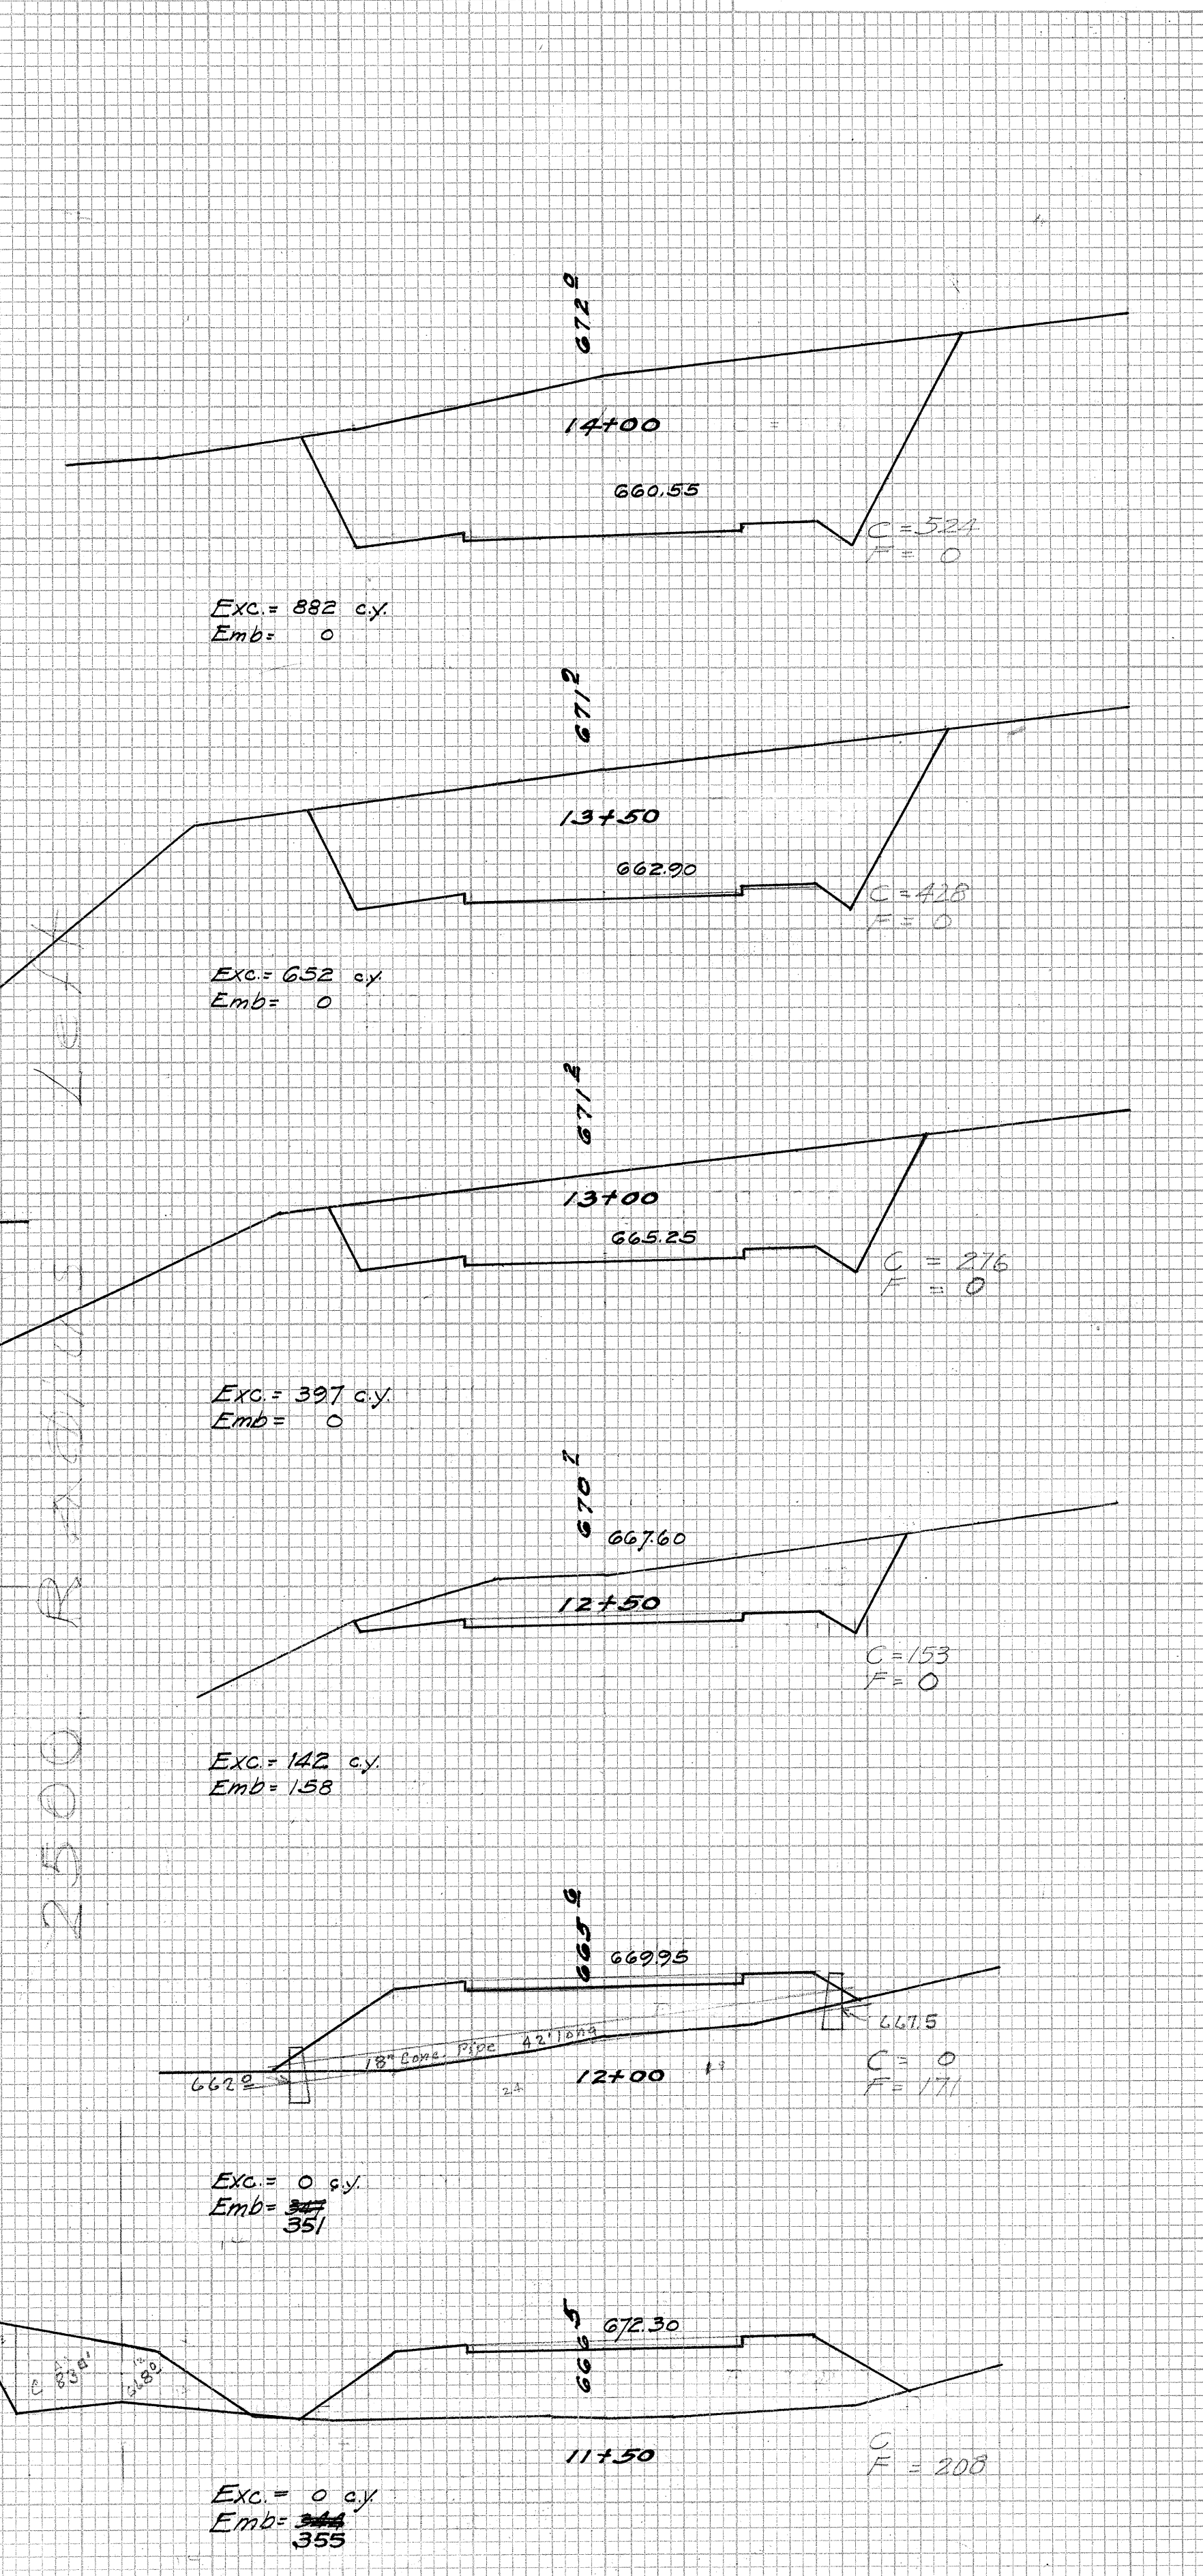
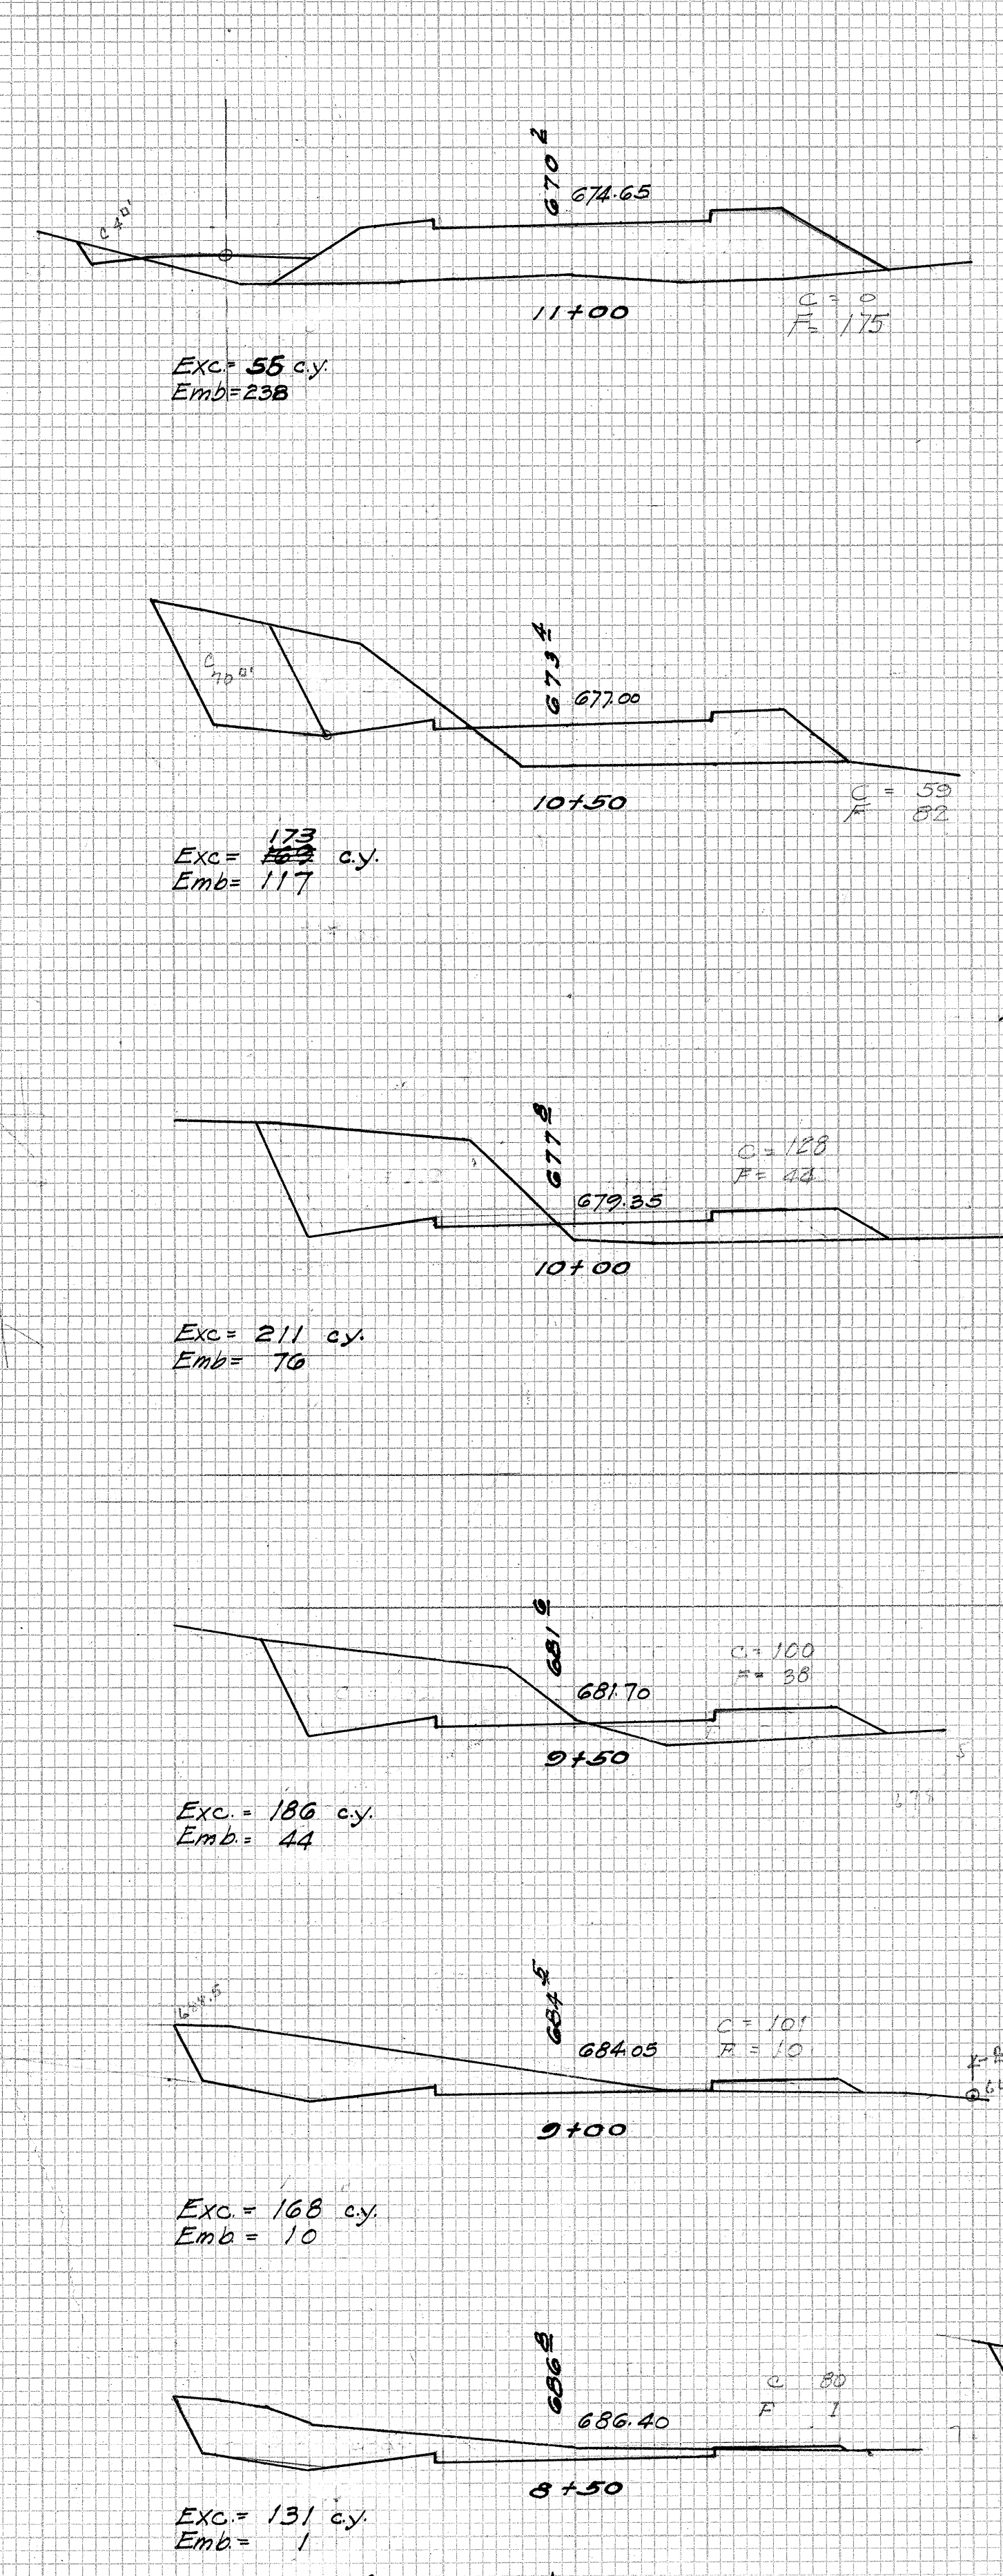
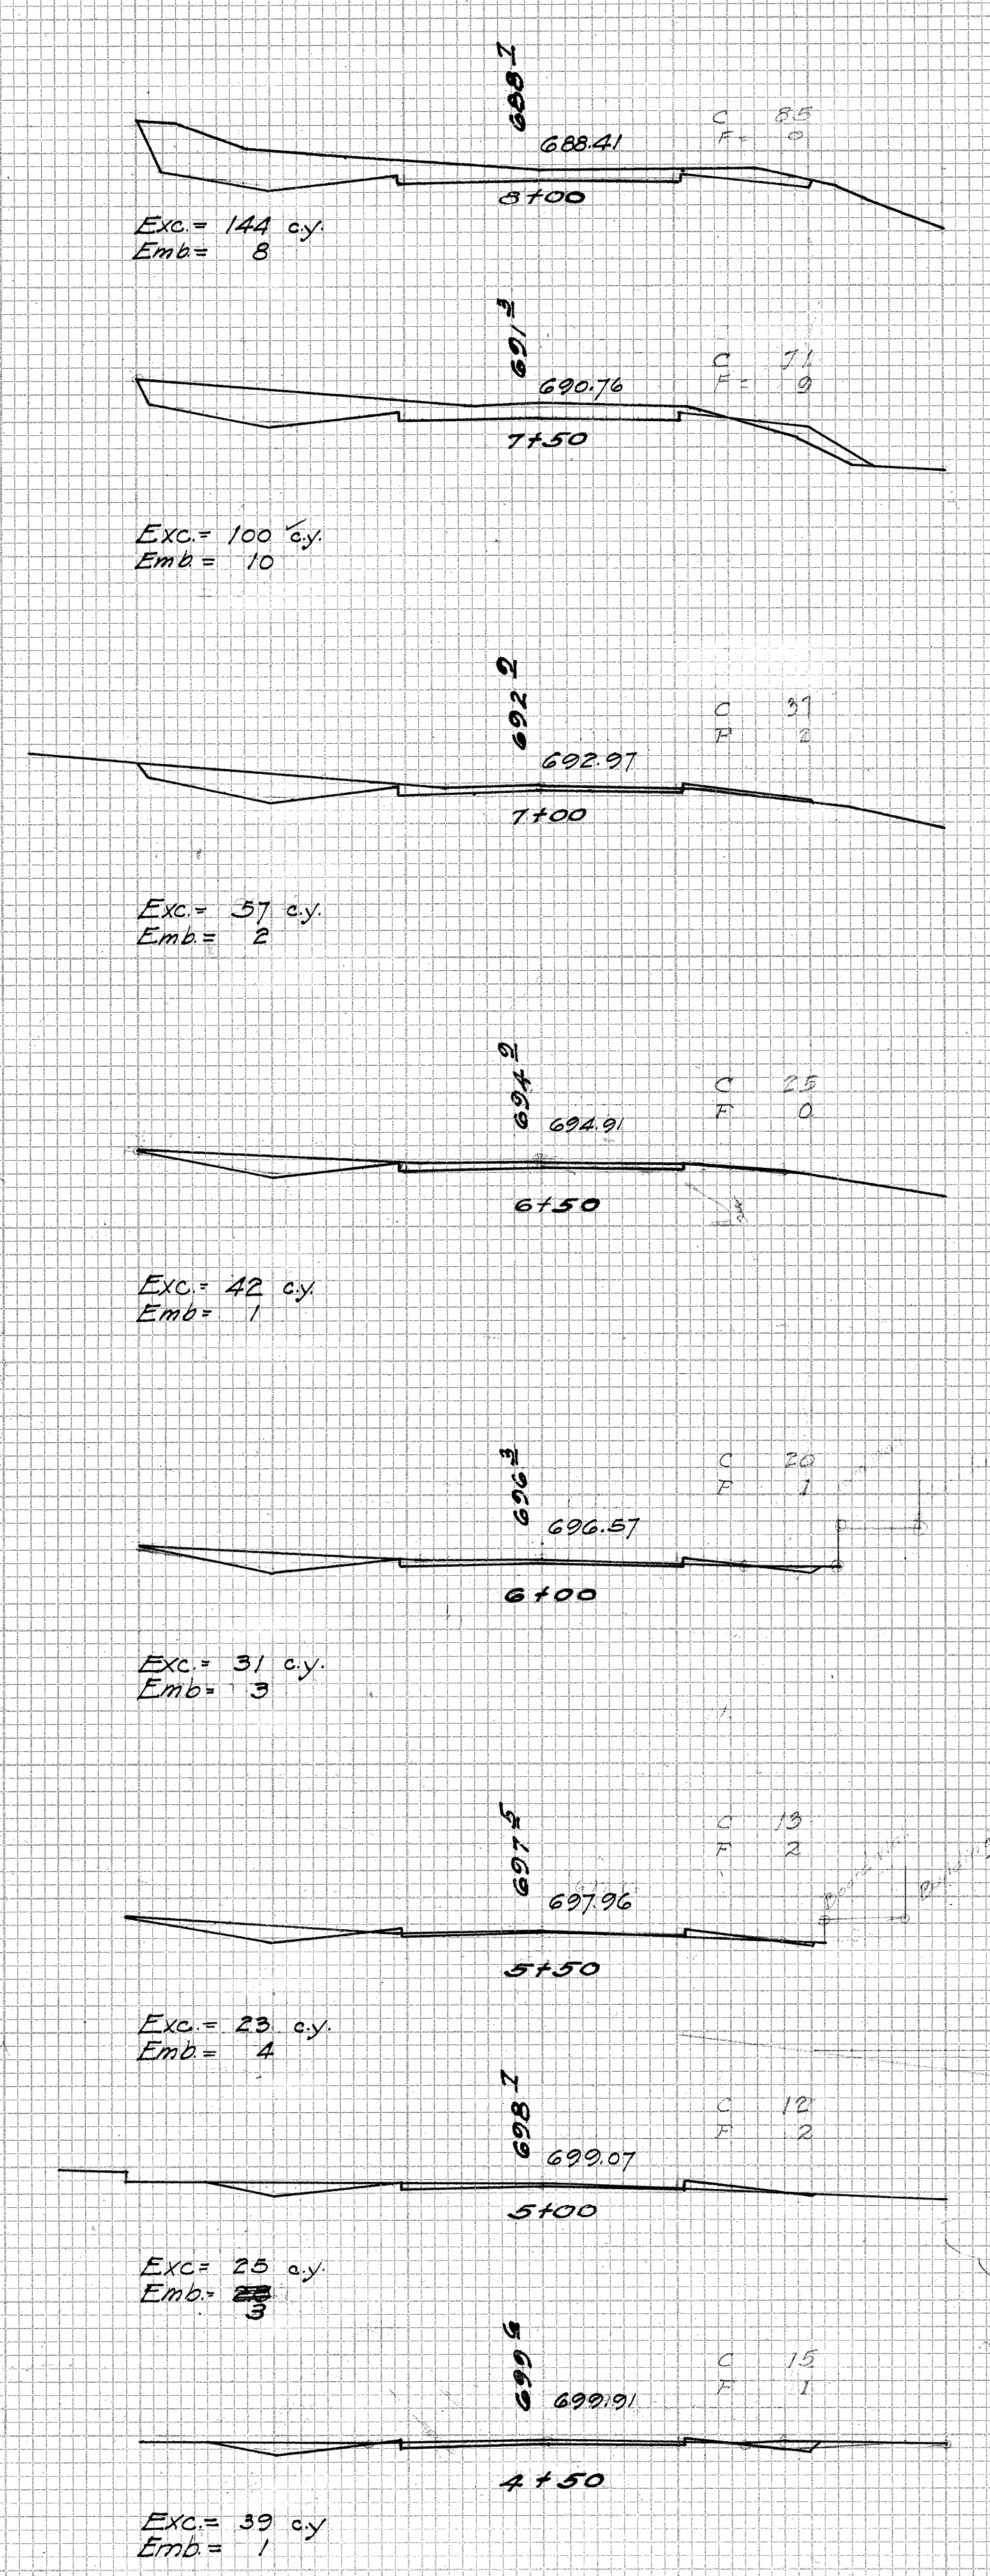


STATE	FED. AID	FISCAL	SHEET	TOTAL
HAWAII	NRH 12 C	1934	10	14

DATE	BY	FINAL SURVEY	NOTES




DATE	BY	ORIGINAL SURVEY	NOTES

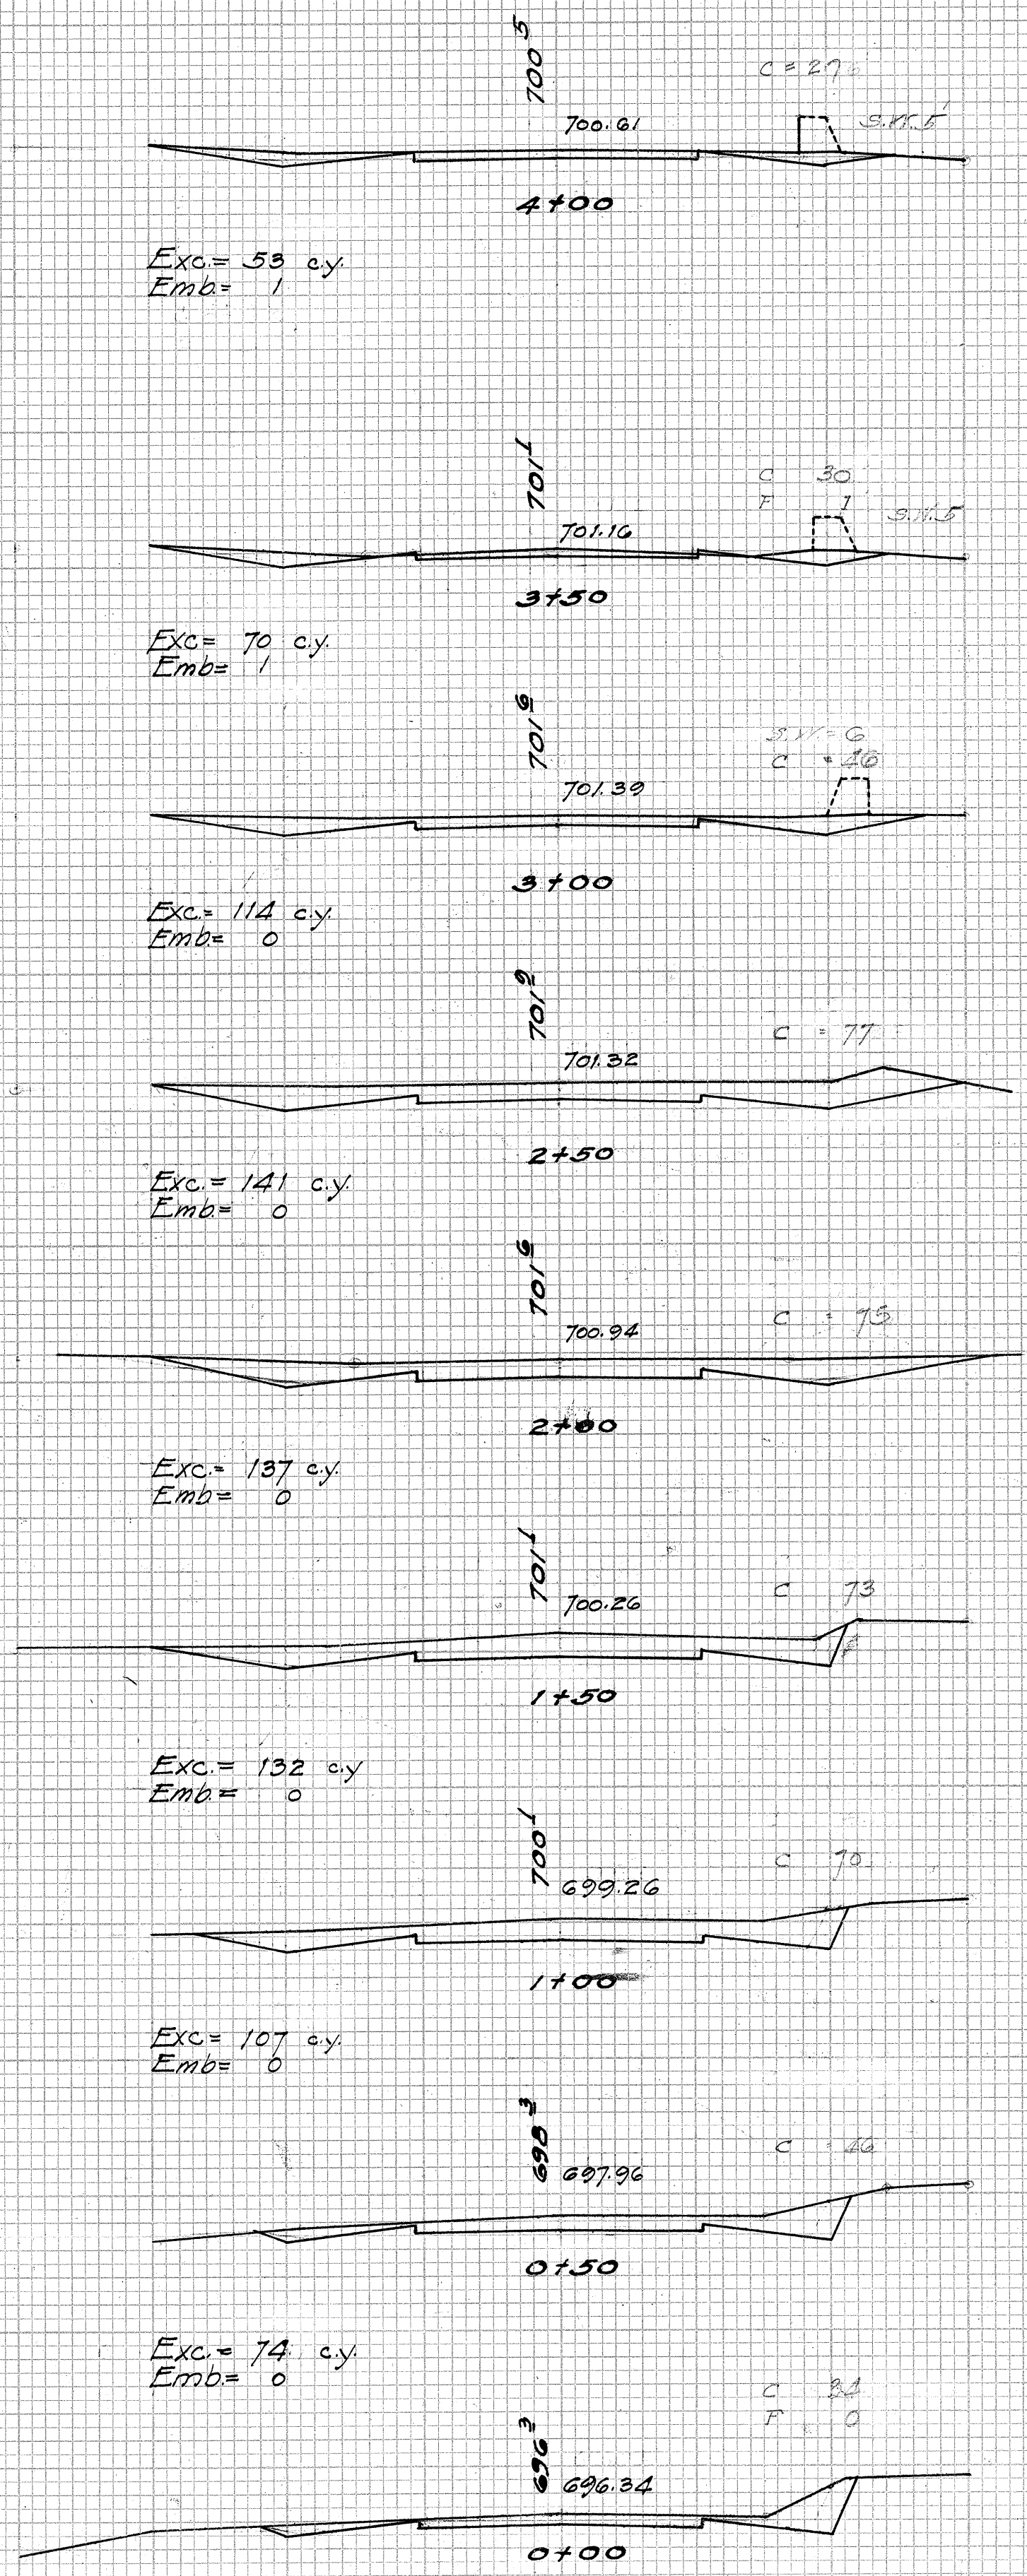

Equation $\left\{ \begin{array}{l} 8+48.00 \\ 8+40.83 \end{array} \right\}$

DATE _____ BY _____
 FINAL SURVEY PLOTTED _____
 NOTE BOOK _____
 NO. _____

DATE _____ BY _____
 ORIGINAL SURVEY PLOTTED _____
 NOTE BOOK _____
 NO. _____

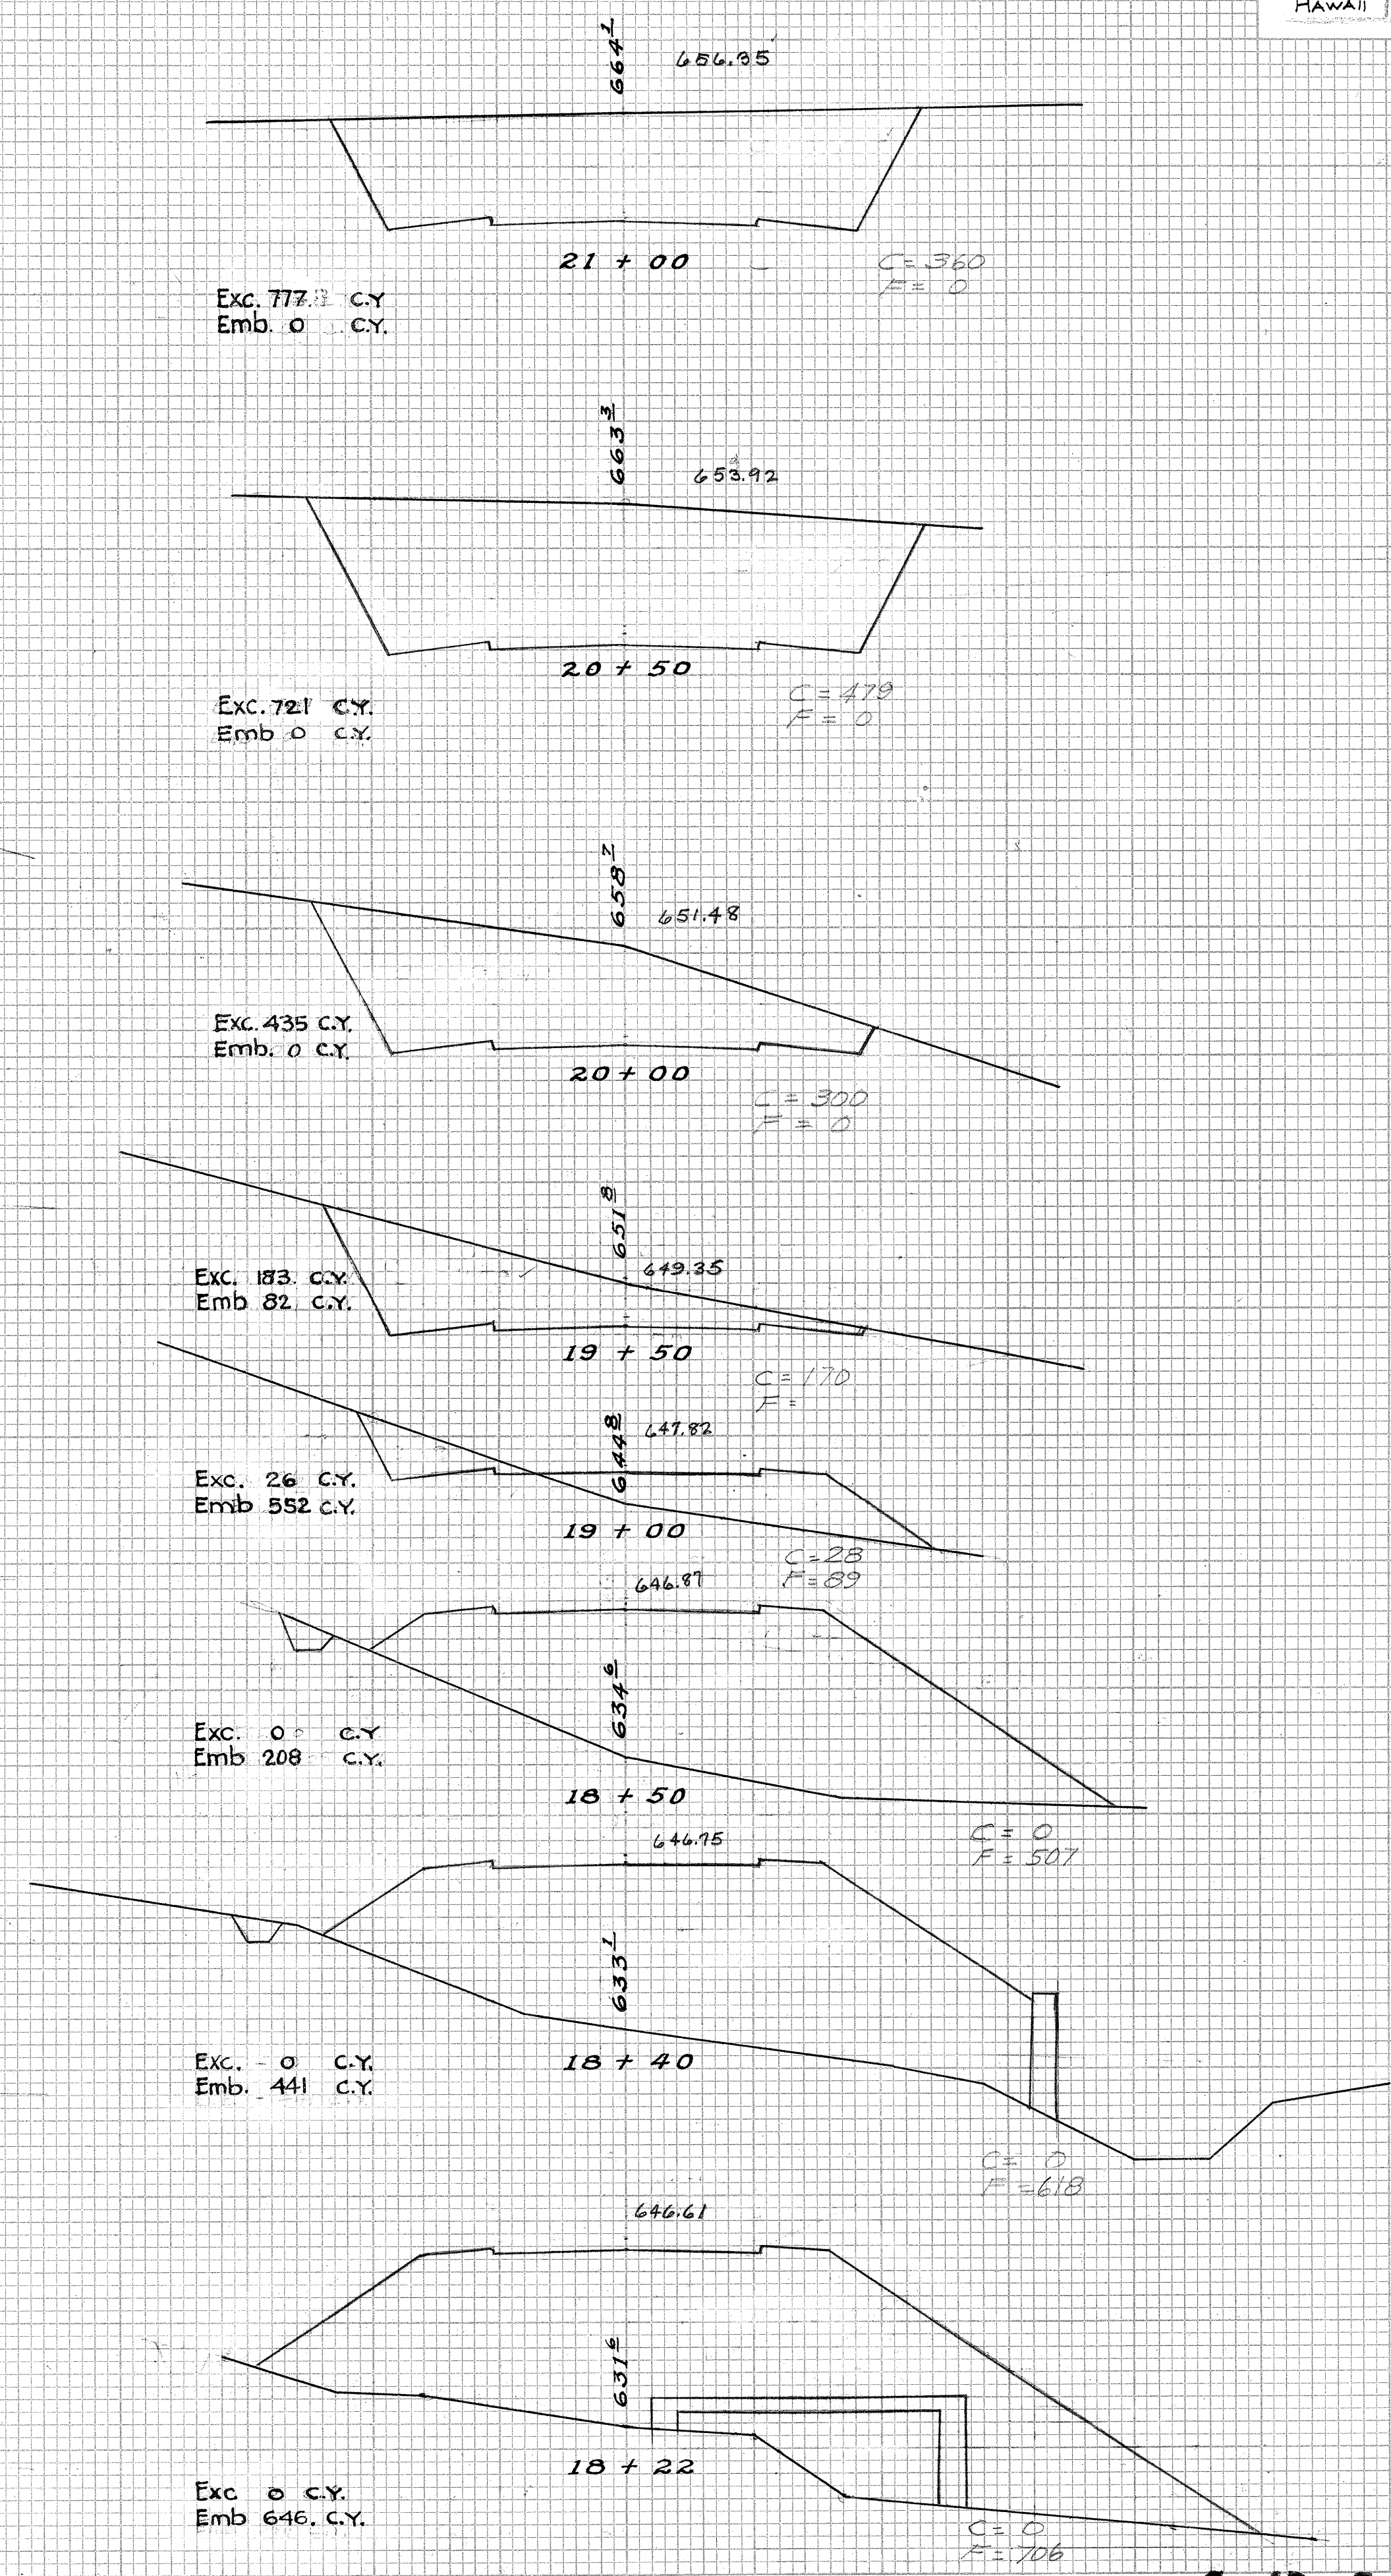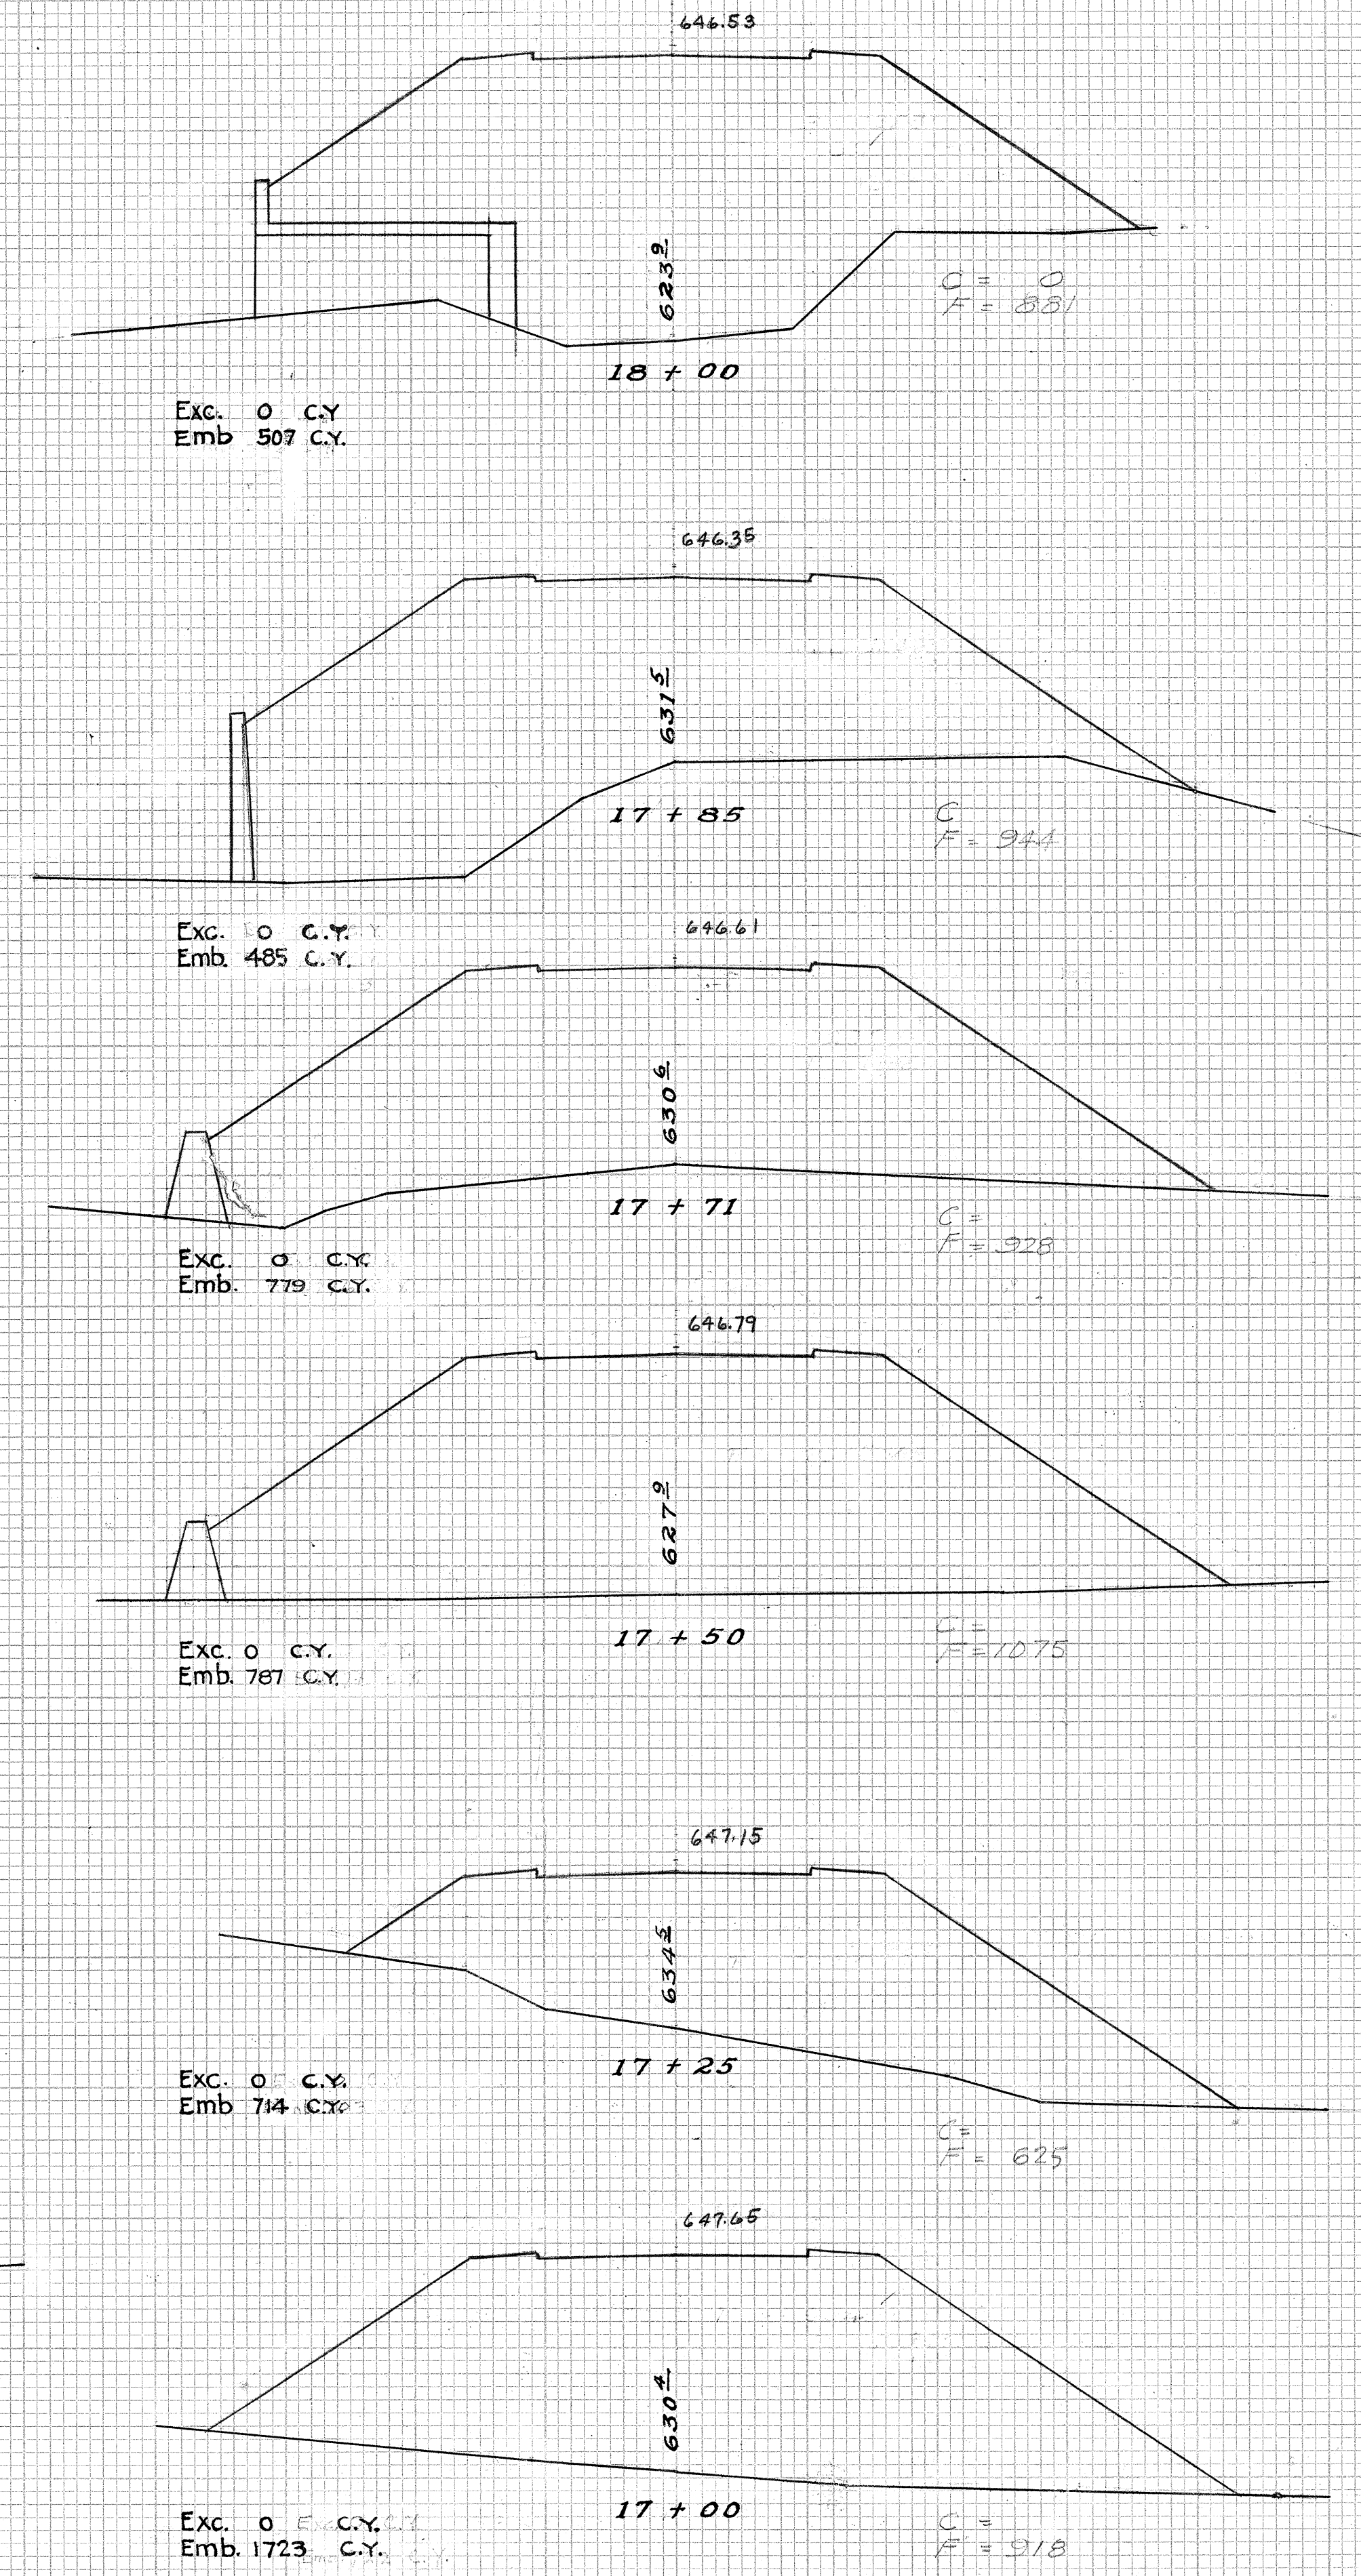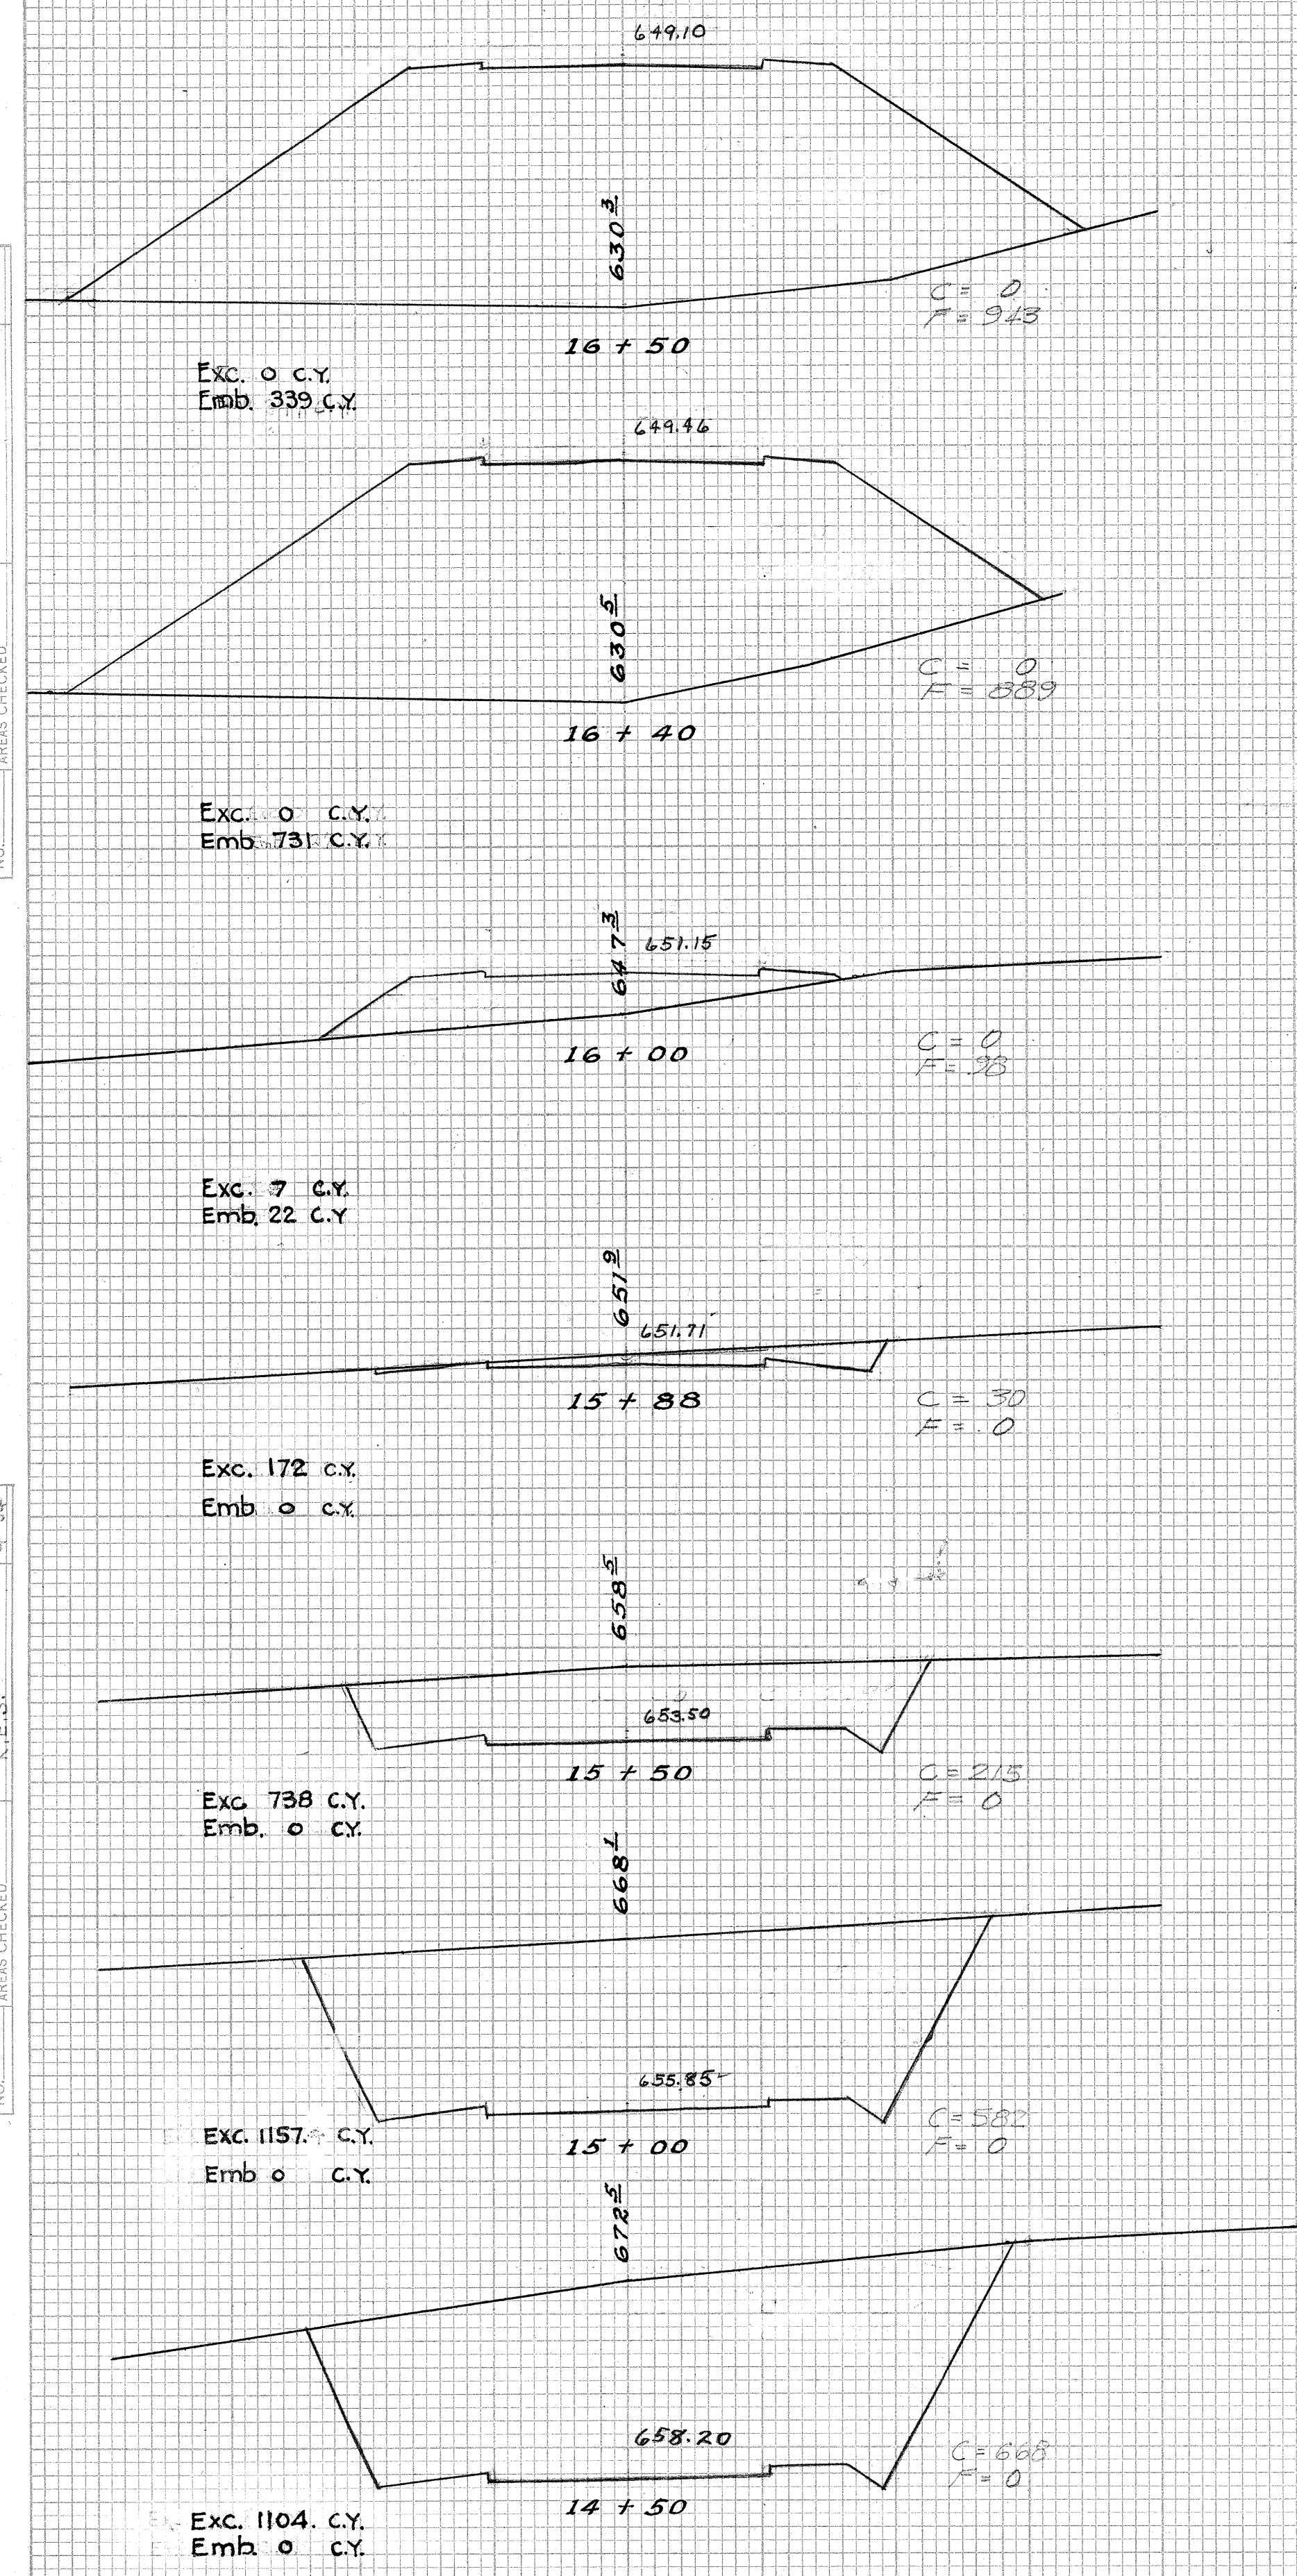

FED. ROAD DIST. NO.	STATE	FED. AID PROJ. NO.	FISCAL YEAR	SHEET NO.	TOTAL SHEETS
HAWAII	HAW	12C	1934	12	14

FINAL SURVEY	SURVEYED	DATE
NOTE BOOK	PLOTTED	BY
NO.	TEMPLATE	
	AREAS CHECKED	





ORIGINAL SURVEY	SURVEYED	DATE
NOTE BOOK	PLOTTED	BY
NO.	TEMPLATE	
	AREAS CHECKED	



STATE	FED. AID PROJ. NO.	FISCAL YEAR	SHEET NO.	TOTAL SHEETS
HAWAII	12 C	1934	13	14

DATE	BY	FINAL SURVEY	SURVEYED	PLOTTED	TEMP. PLATE	NO.

DATE	BY	ORIGINAL SURVEY	SURVEYED	PLOTTED	TEMP. PLATE	NO.

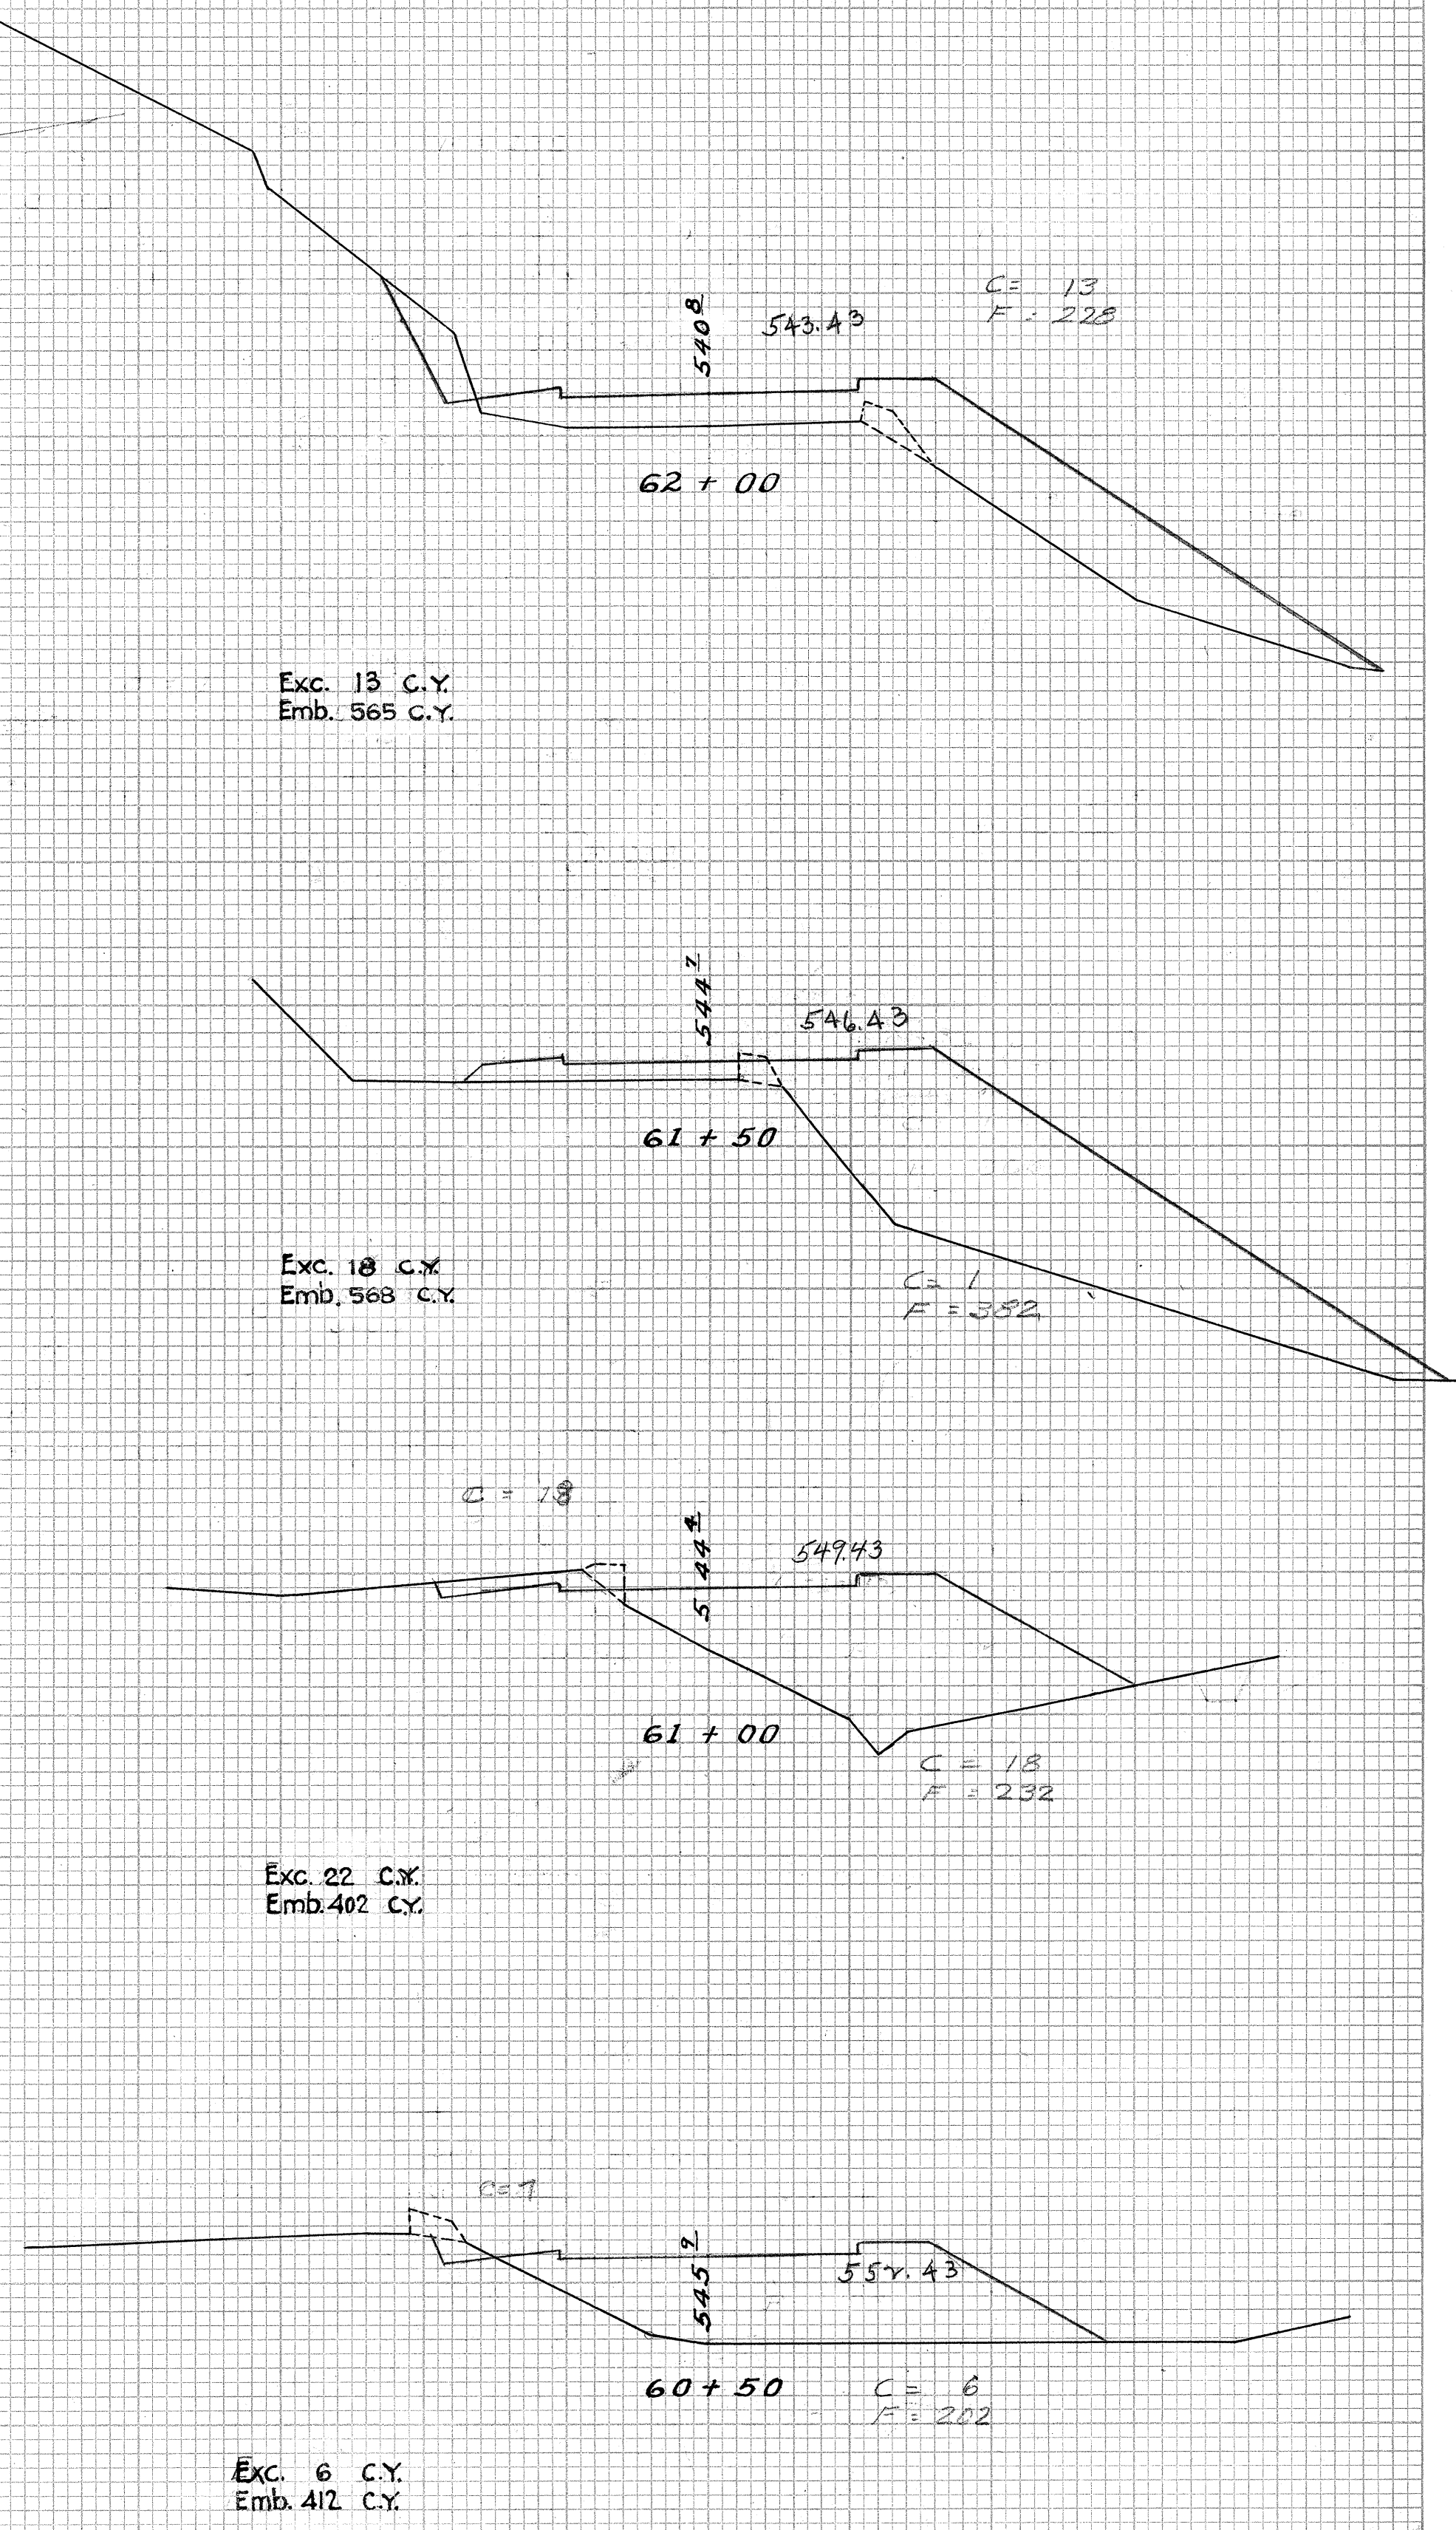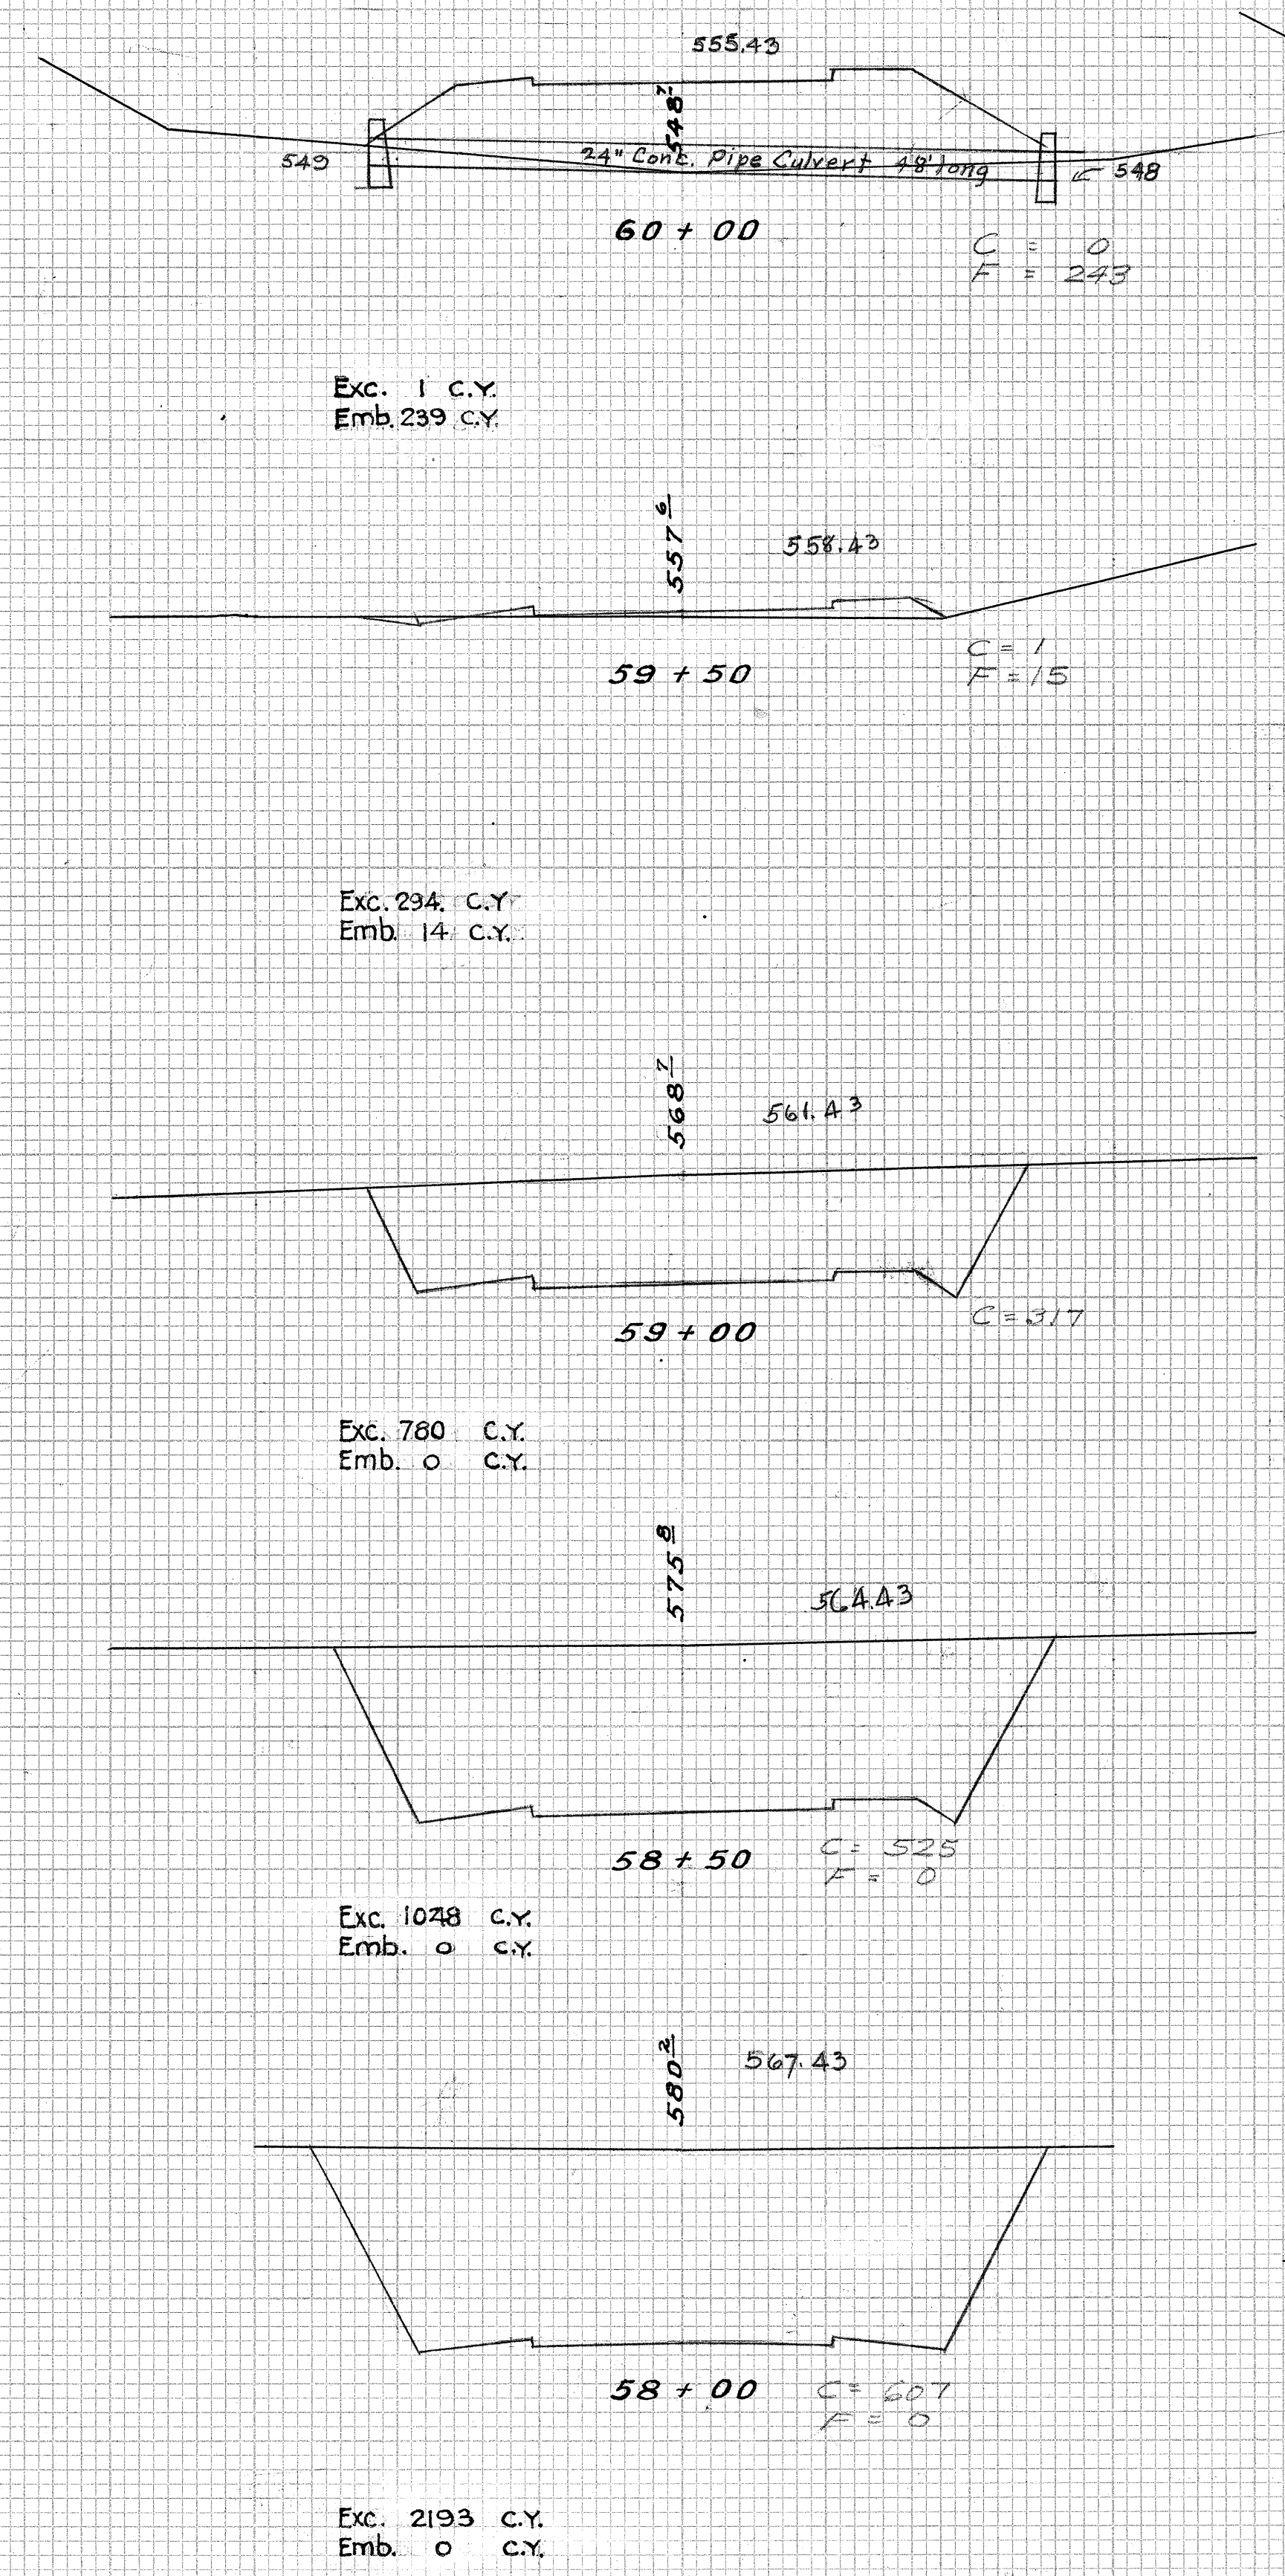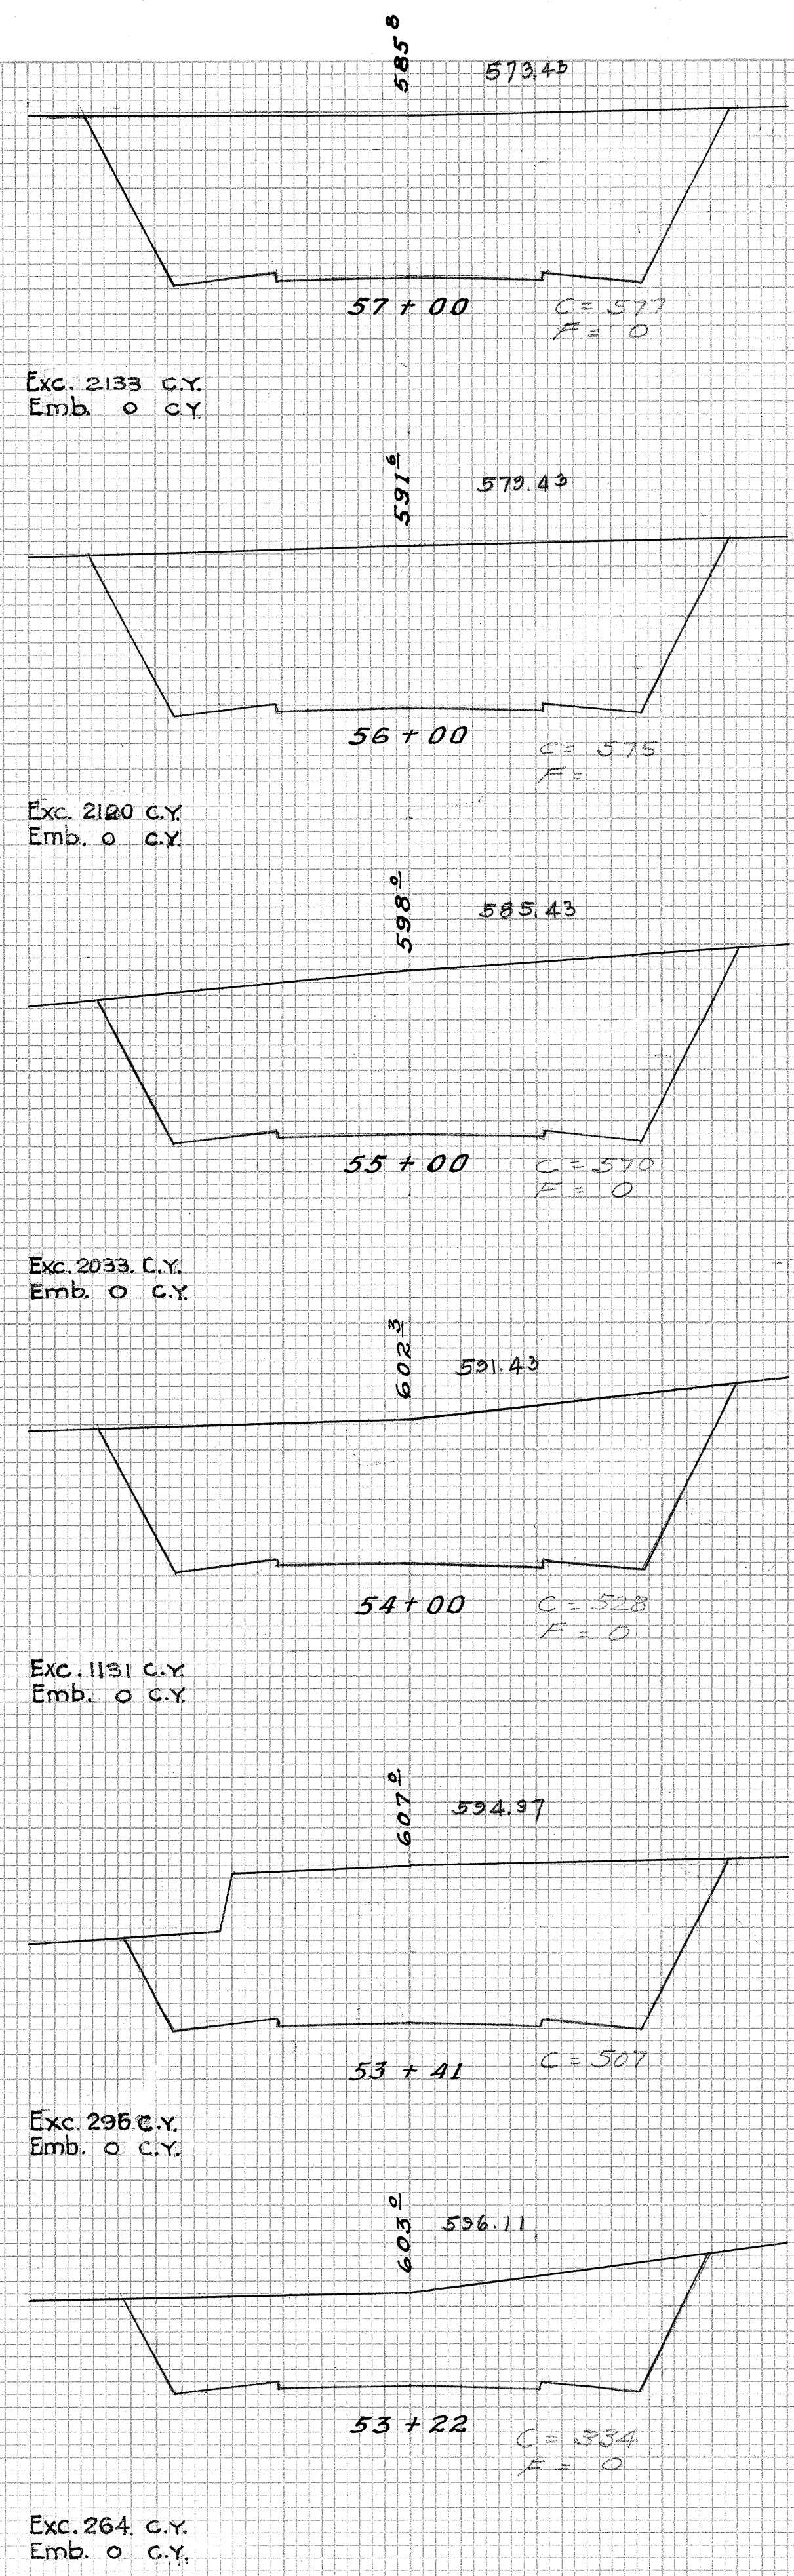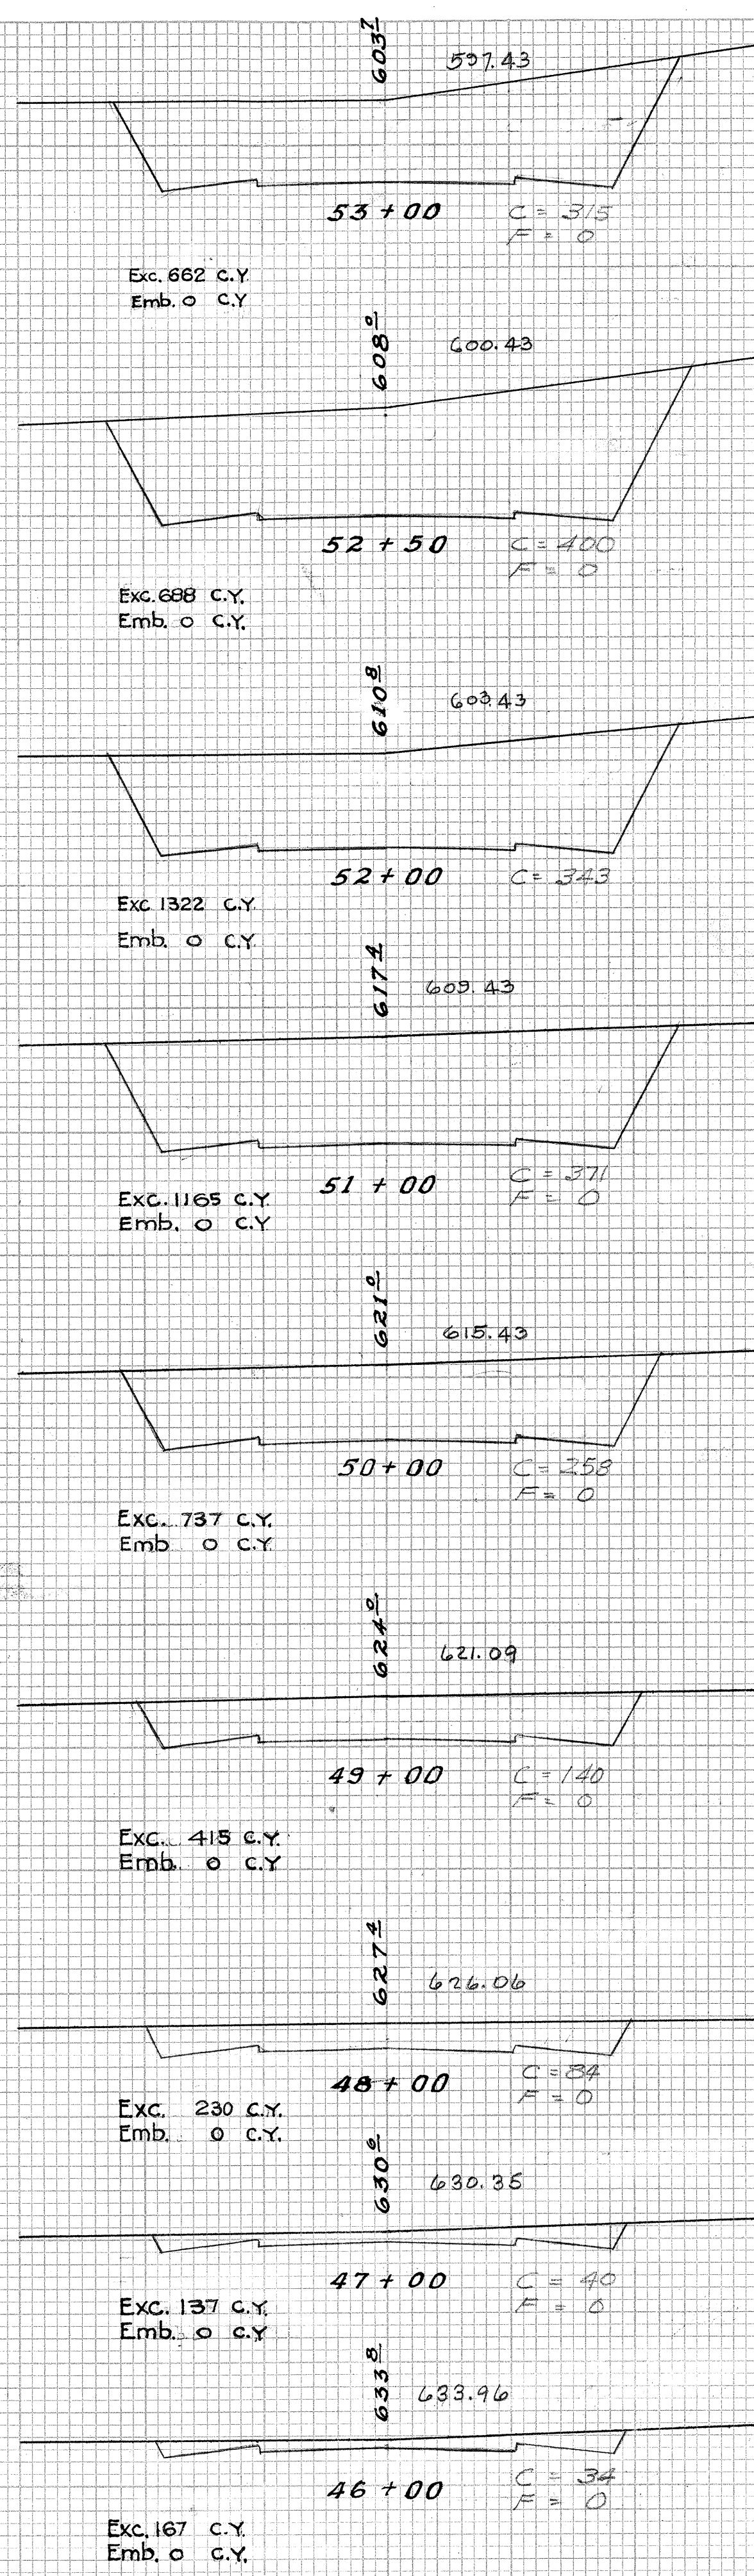




FED. ROAD DIST. NO.	STATE	FISCAL YEAR	SHEET NO.	TOTAL SHEETS
HAWAII	HAW	1934	14	14

FED. ROAD DIST. NO.	STATE	FISCAL YEAR	SHEET NO.	TOTAL SHEETS
HAWAII	HAW	1935	26	35




This sheet is common to both
NRH 12-D & NRH 12-C

FINAL SURVEY	DATE	BY
NOTE BOOK		
NO.		

ORIGINAL SURVEY	DATE	BY
NOTE BOOK		
NO.		

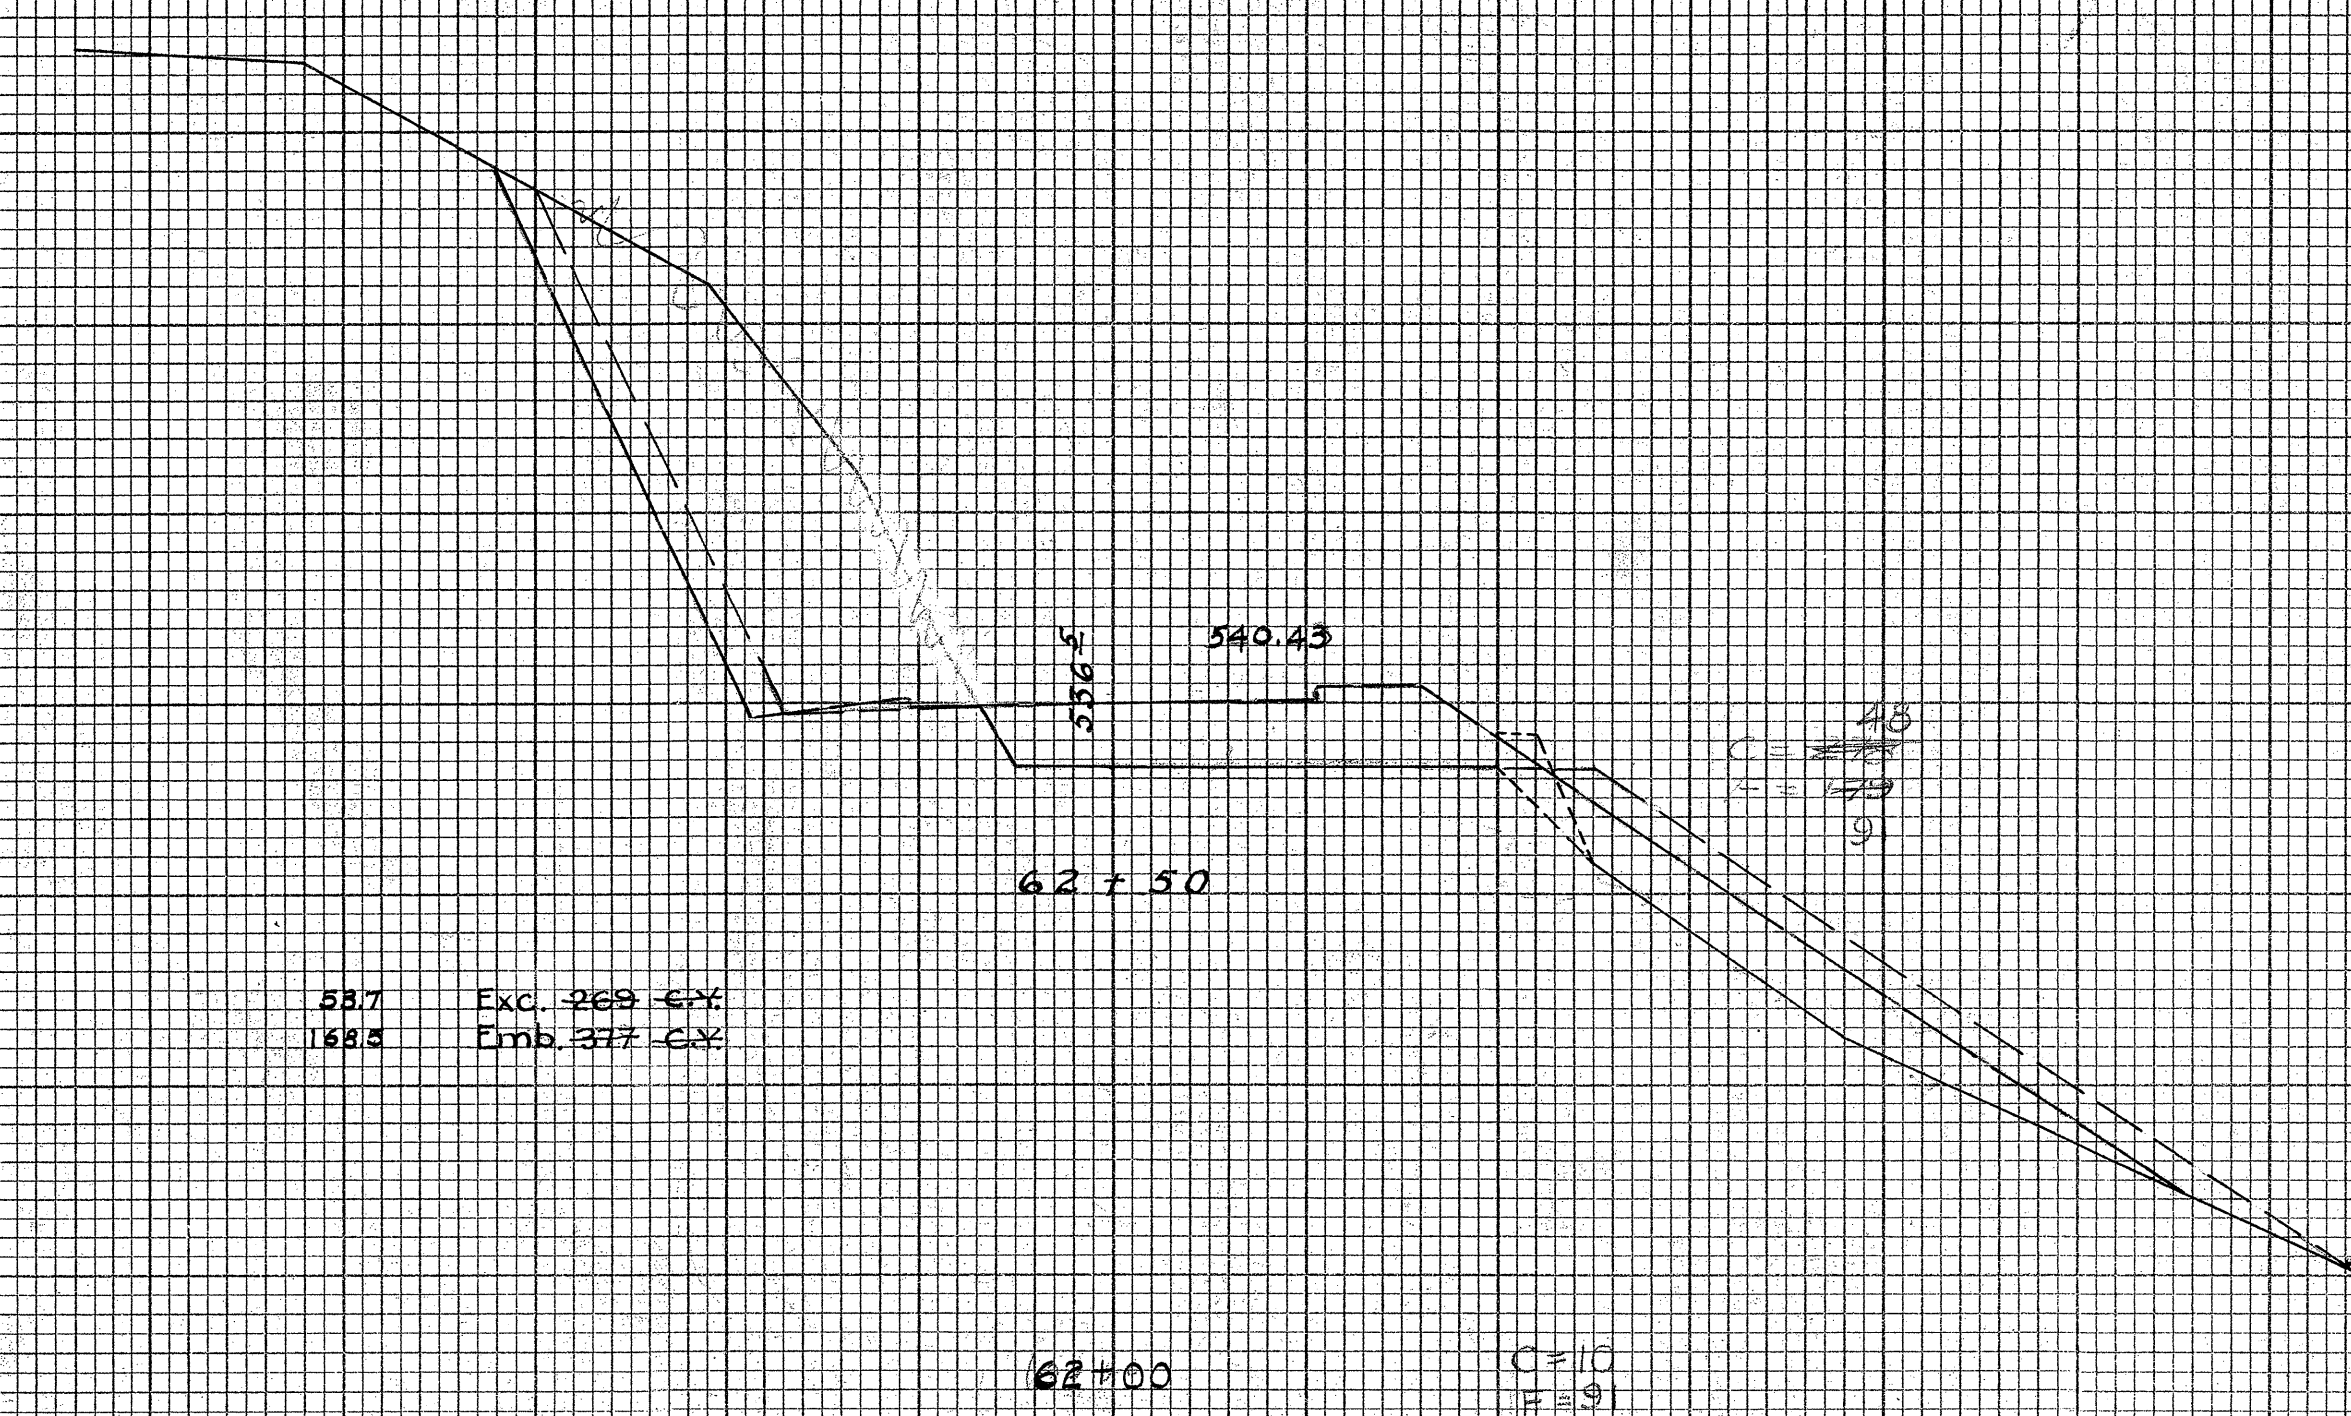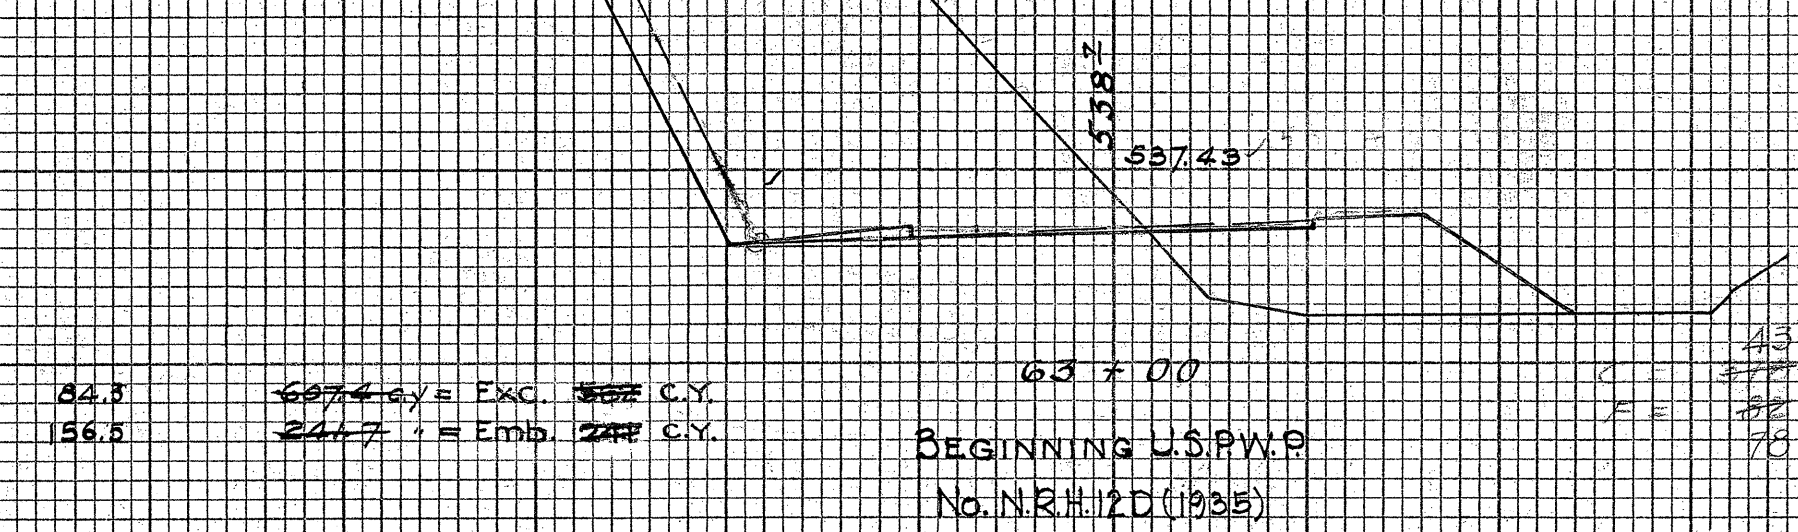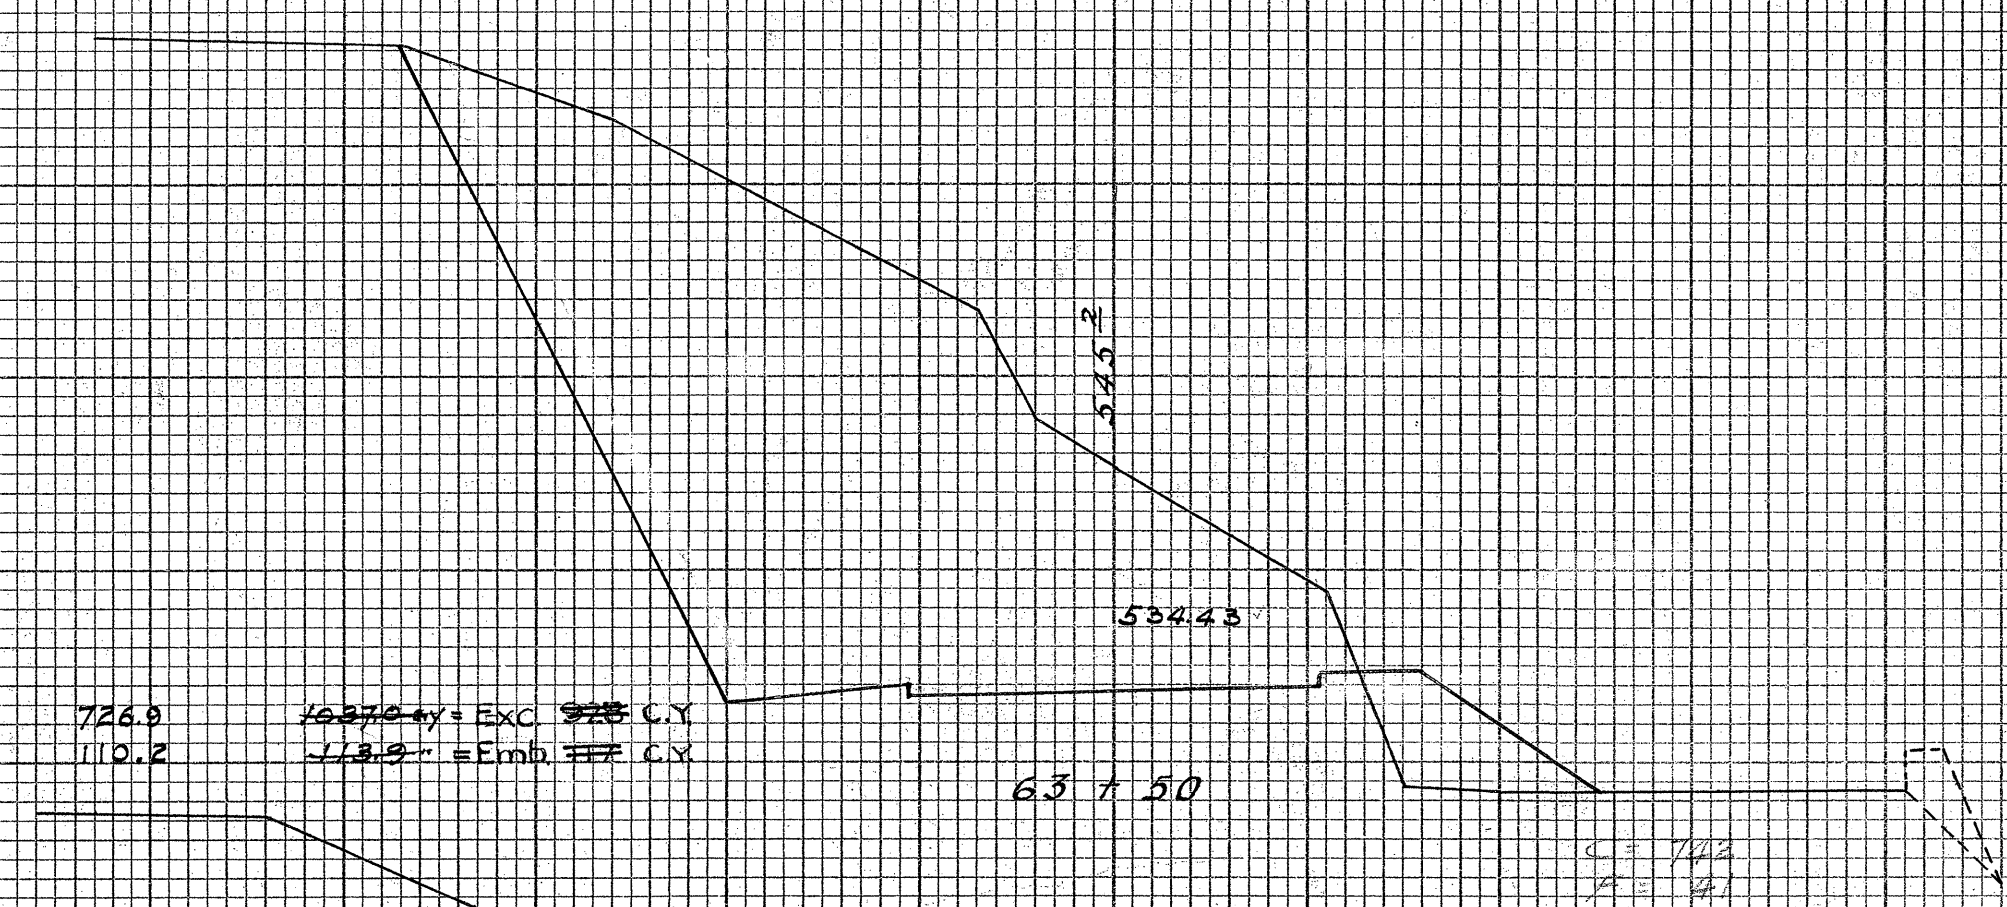

NOTE!
In All cross sections showing
two sections the dotted section
is the correct section. Where
two ground lines are shown the
dotted ground line is correct.

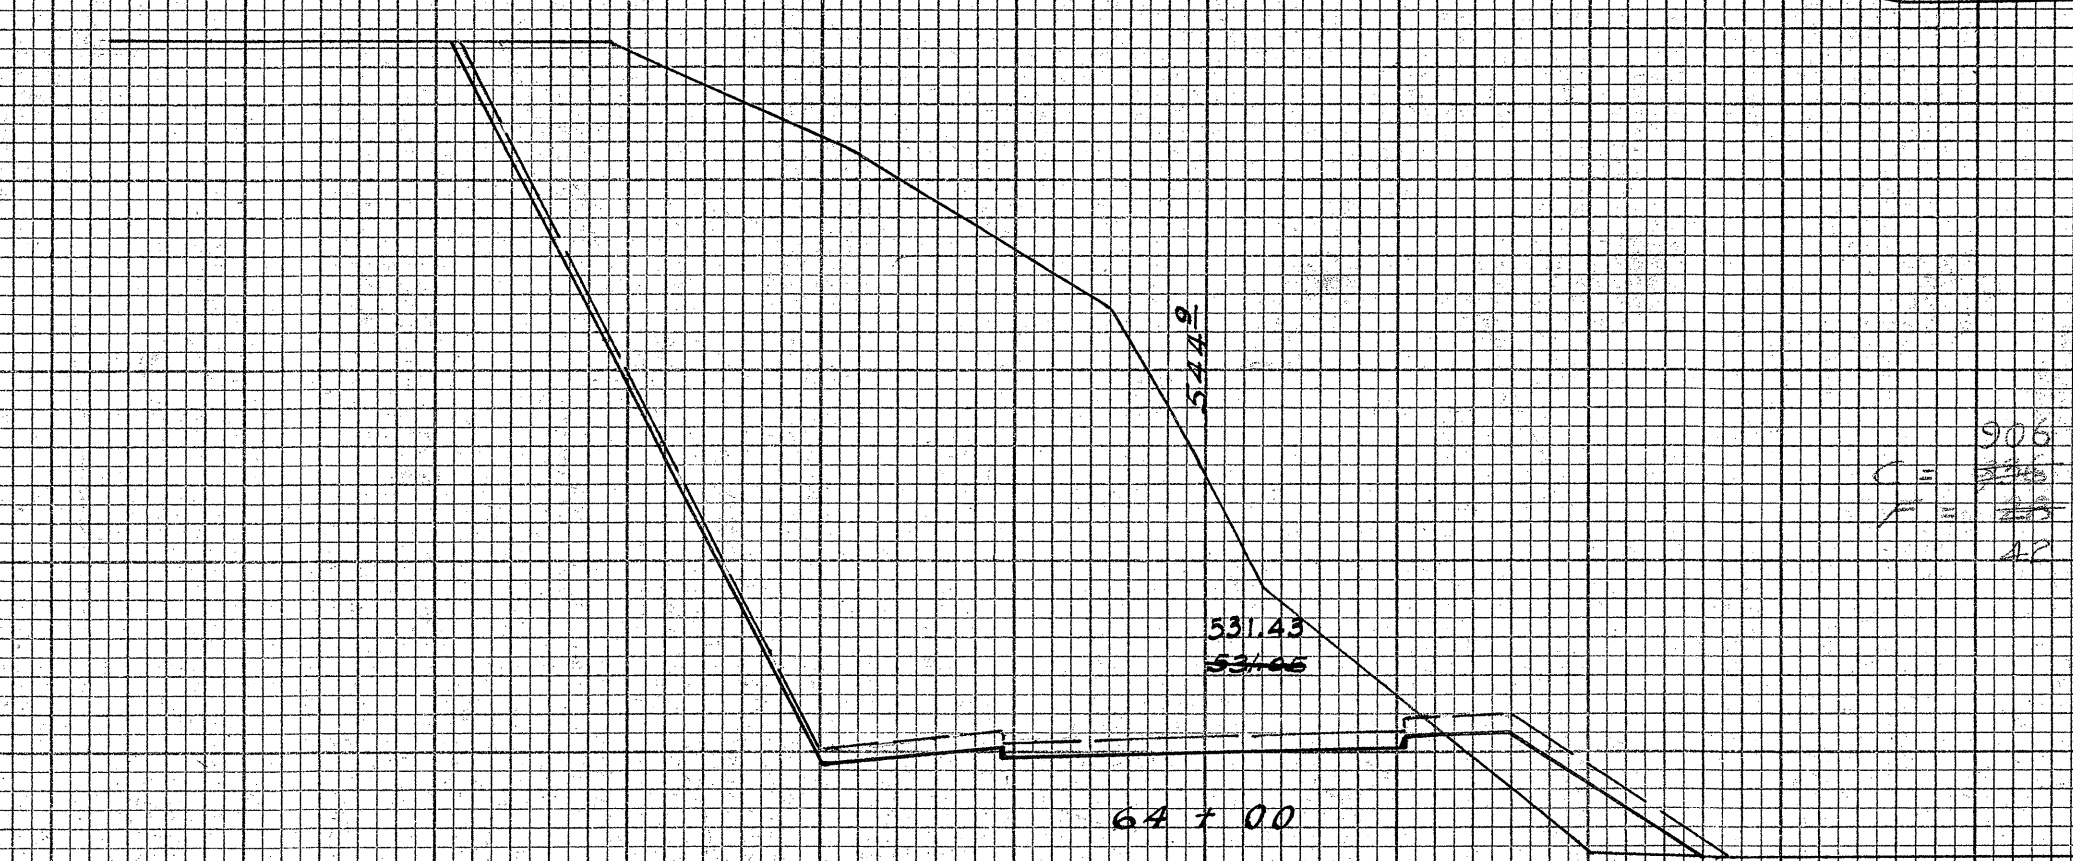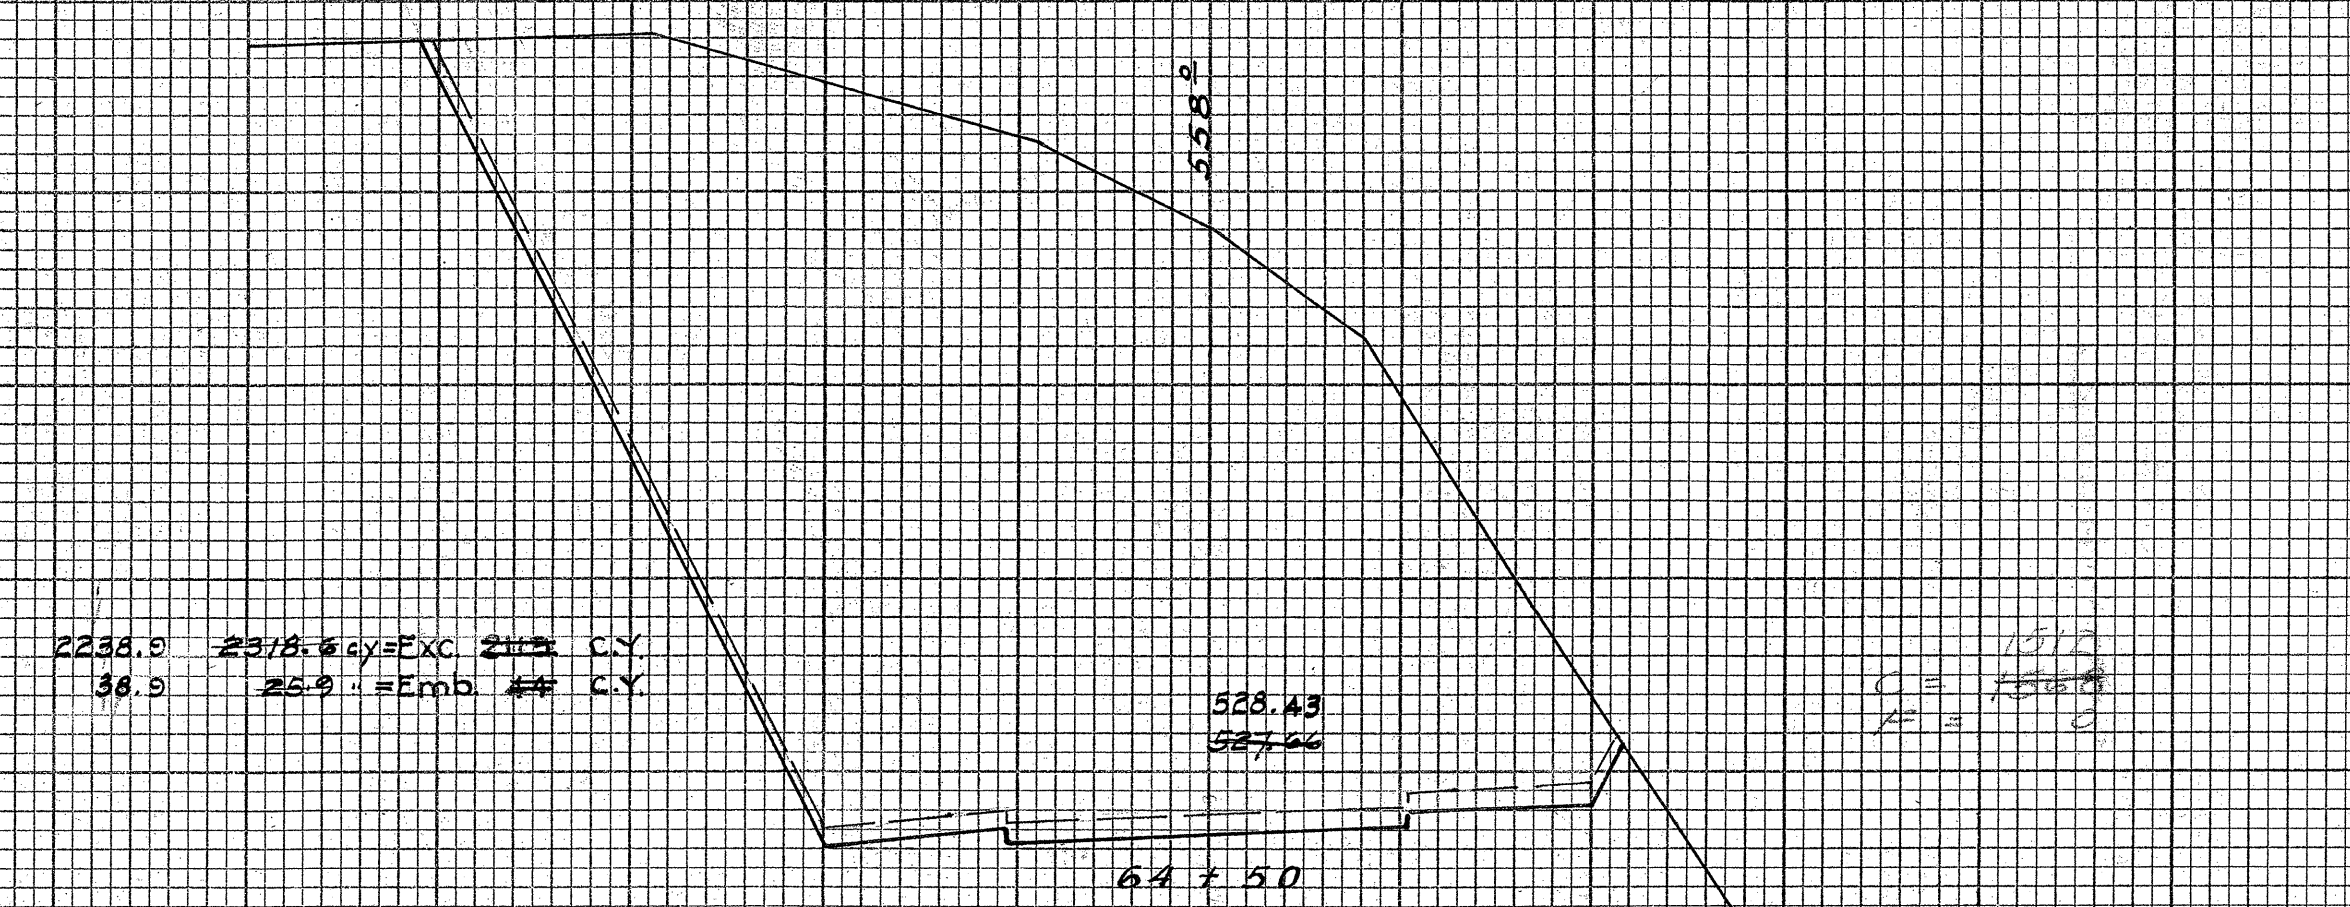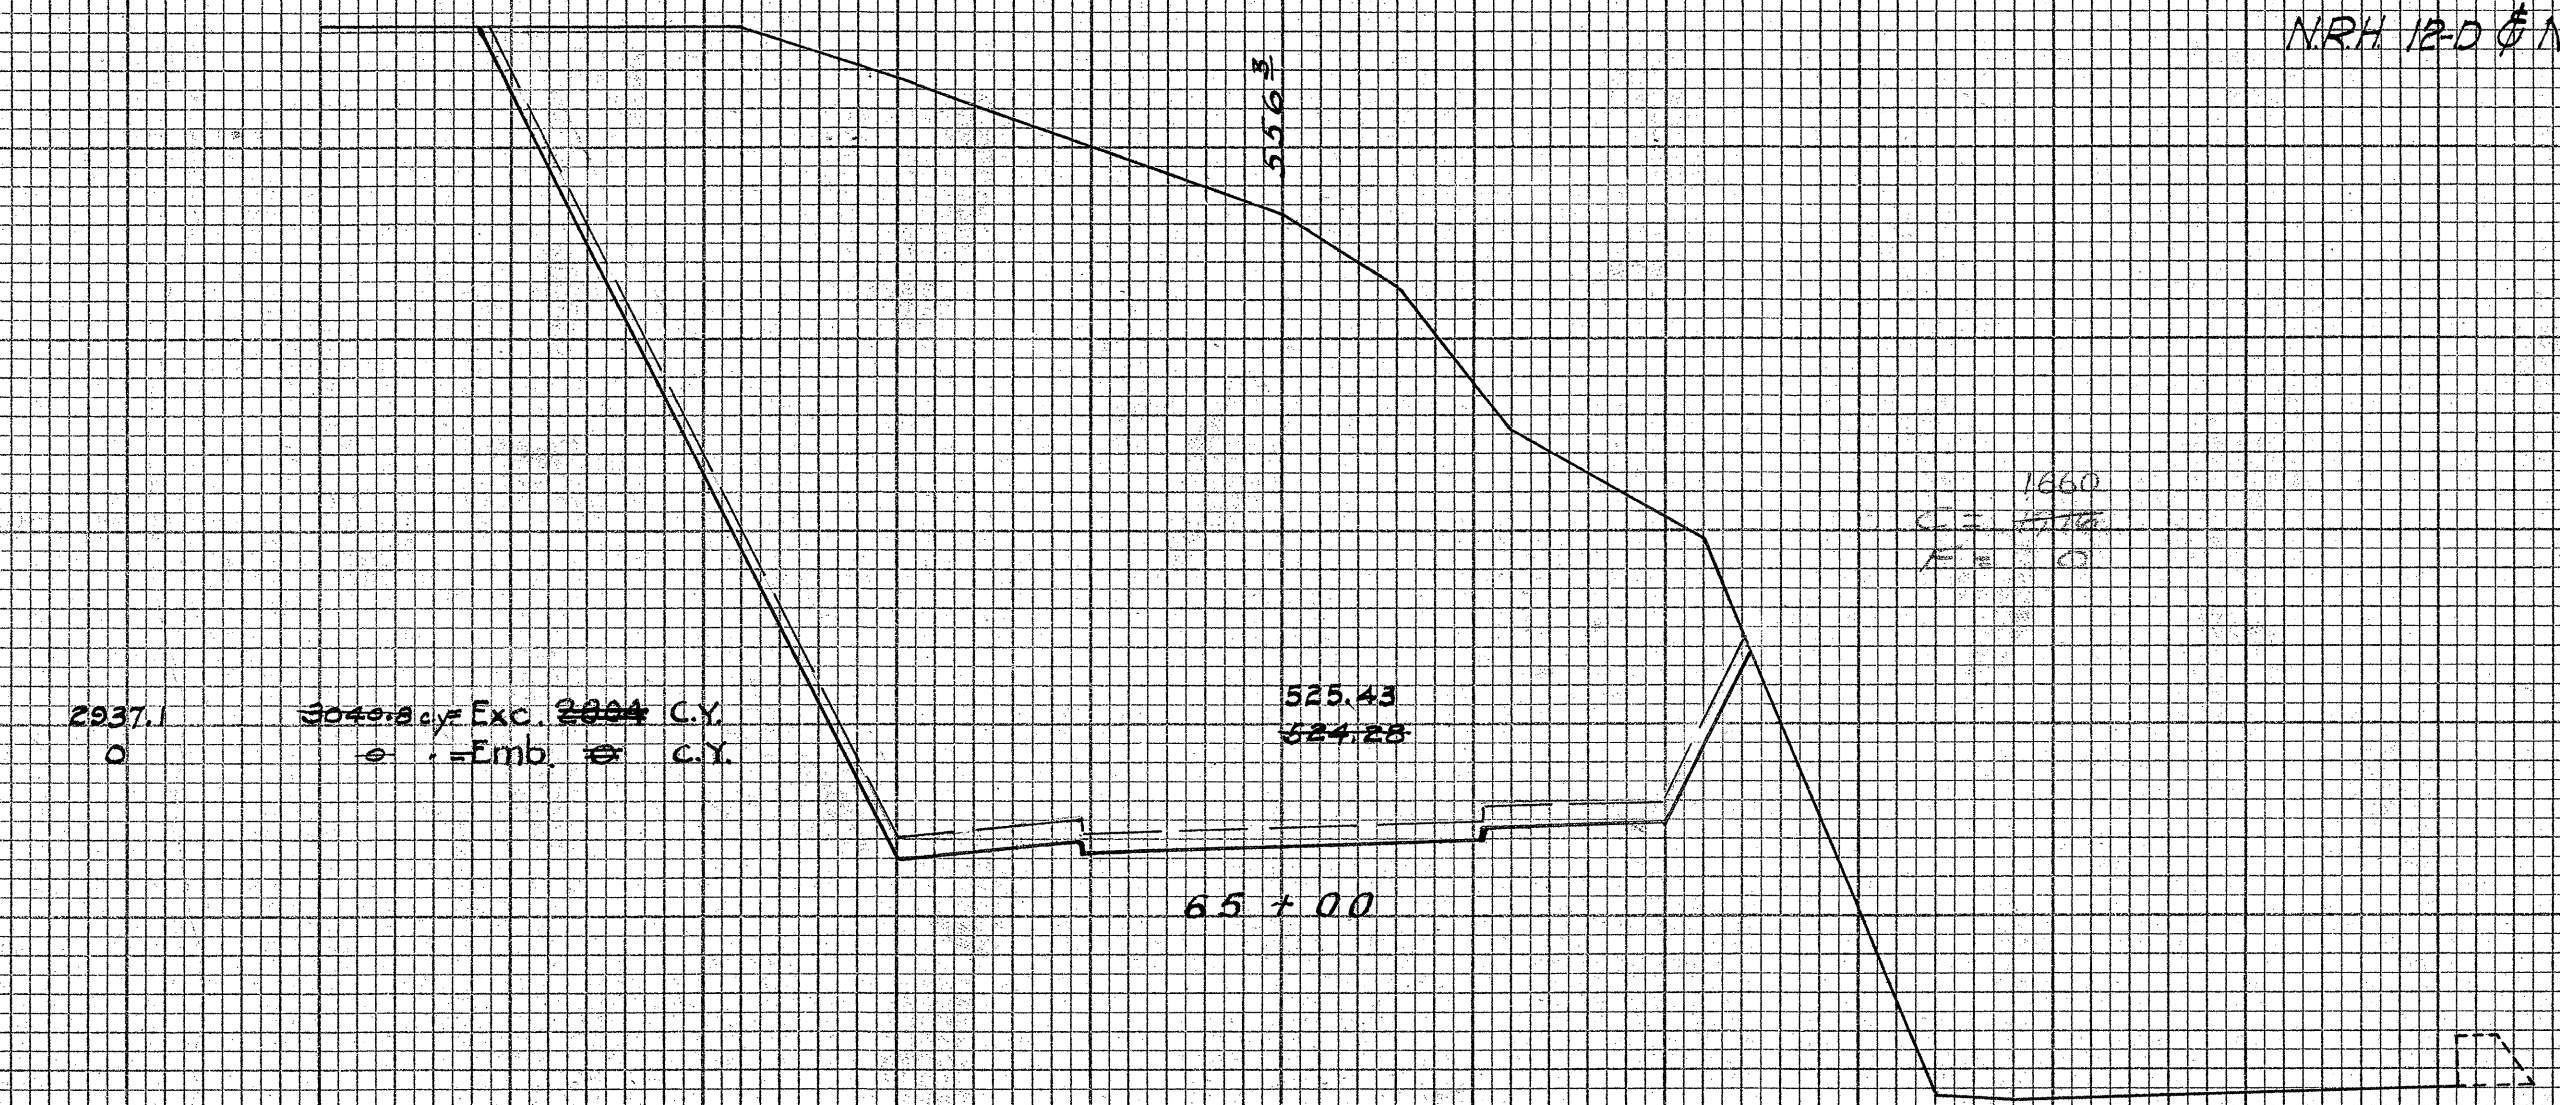

4333.26
4314.14