

FED. ROAD DIST. NO.	STATE	FED. AID PROJ. NO.	FISCAL YEAR	SHEET NO.	TOTAL SHEETS
HAWAII	HAW	NRH 12 C	1934	3	14



No. Plate for
F.A. Marker
N.R.H. 12-C

B.M. №1 ELEV. 700.046
U.S.G.S. Bronze Tablet set in
Concrete Sidewalk of Jardin's
Cash & Carry Store

$\Delta = 16^{\circ}26'$
 $D = 2^{\circ}17'$
 $R = 2500'$
 $T = 361.00'$
 $E = 23.92'$
 $L_c = 714.60'$
 $L = 717.04'$

B.M. No 2 ELEV. 643.49
R.R. Spike driven in Telephone Pole
about 2 feet above Ground
and 67 feet makai of Sta. 17+55

B.M. N23 ELEV. 666.40 DISY. NO. 37
 R.R. Spike driven in Telephone Pole HAWAII H
 about 2 feet above Ground and
116 feet makai of Sta. 26+86

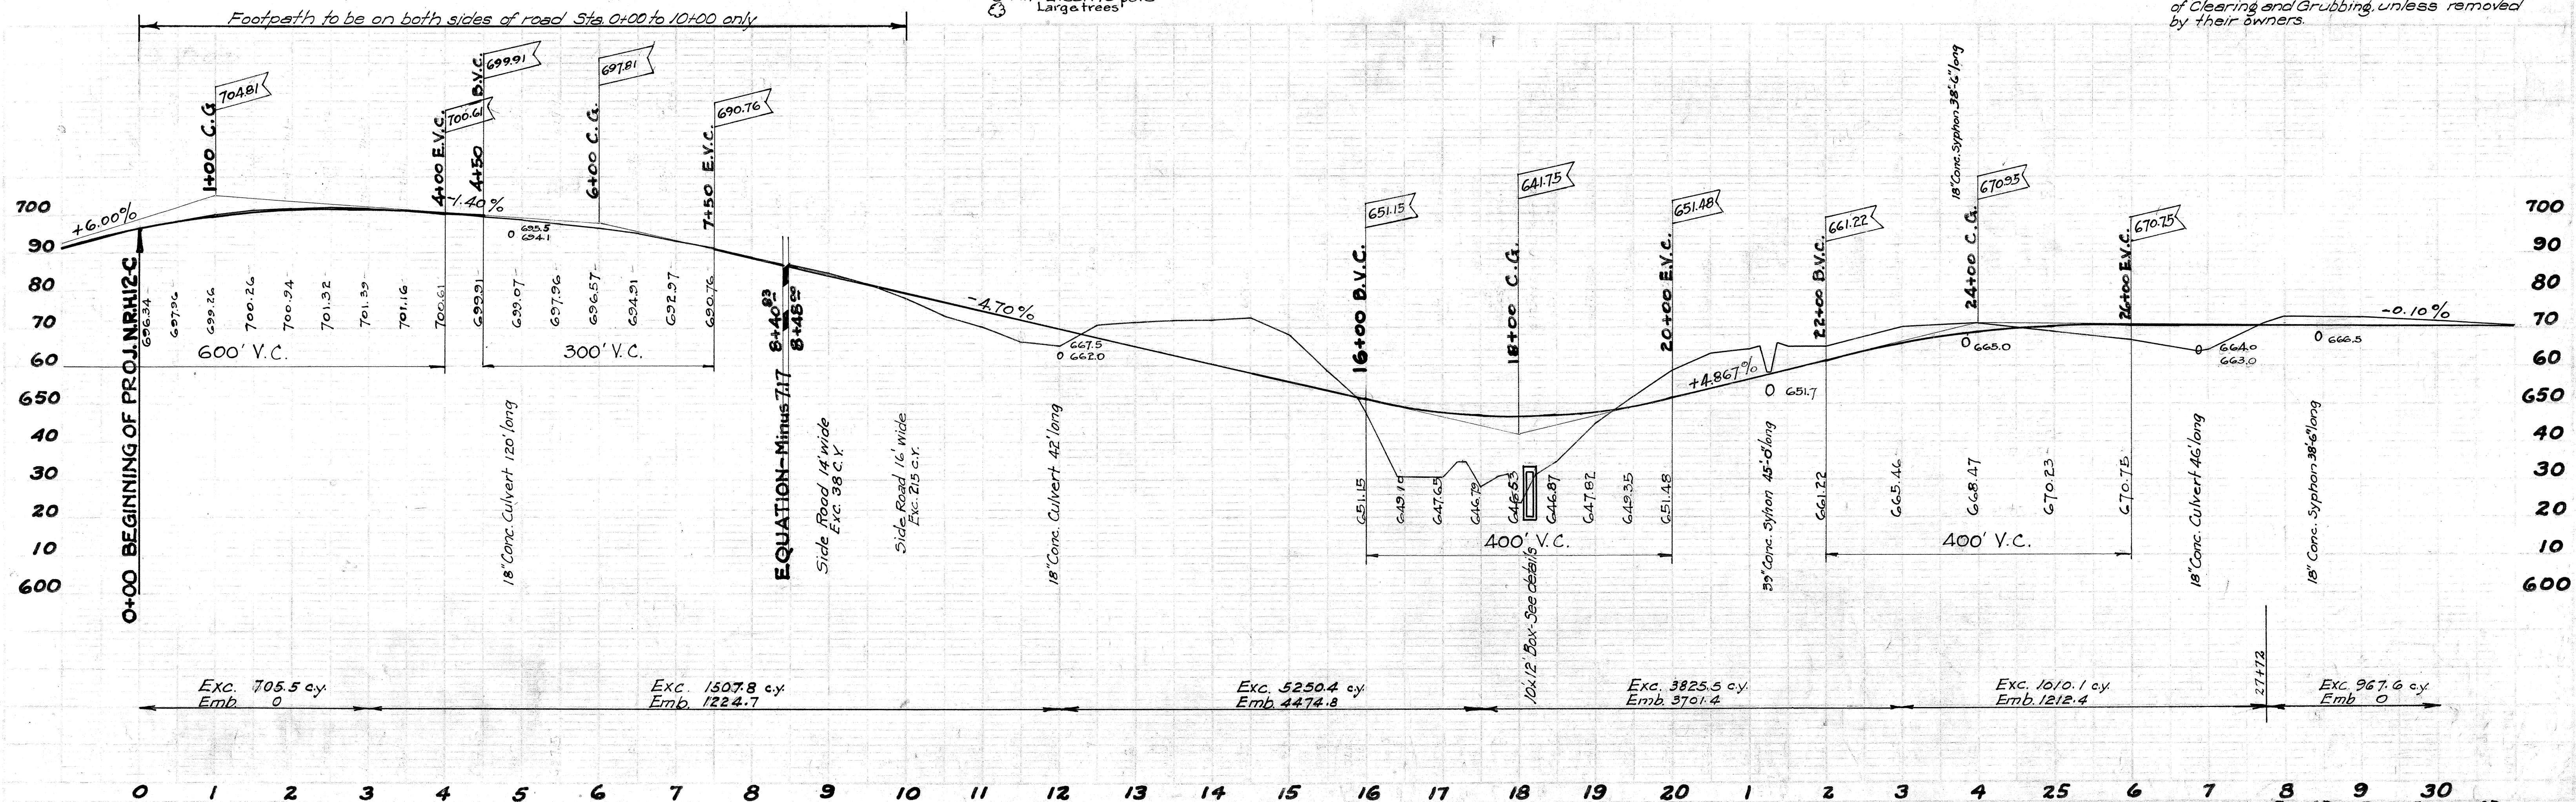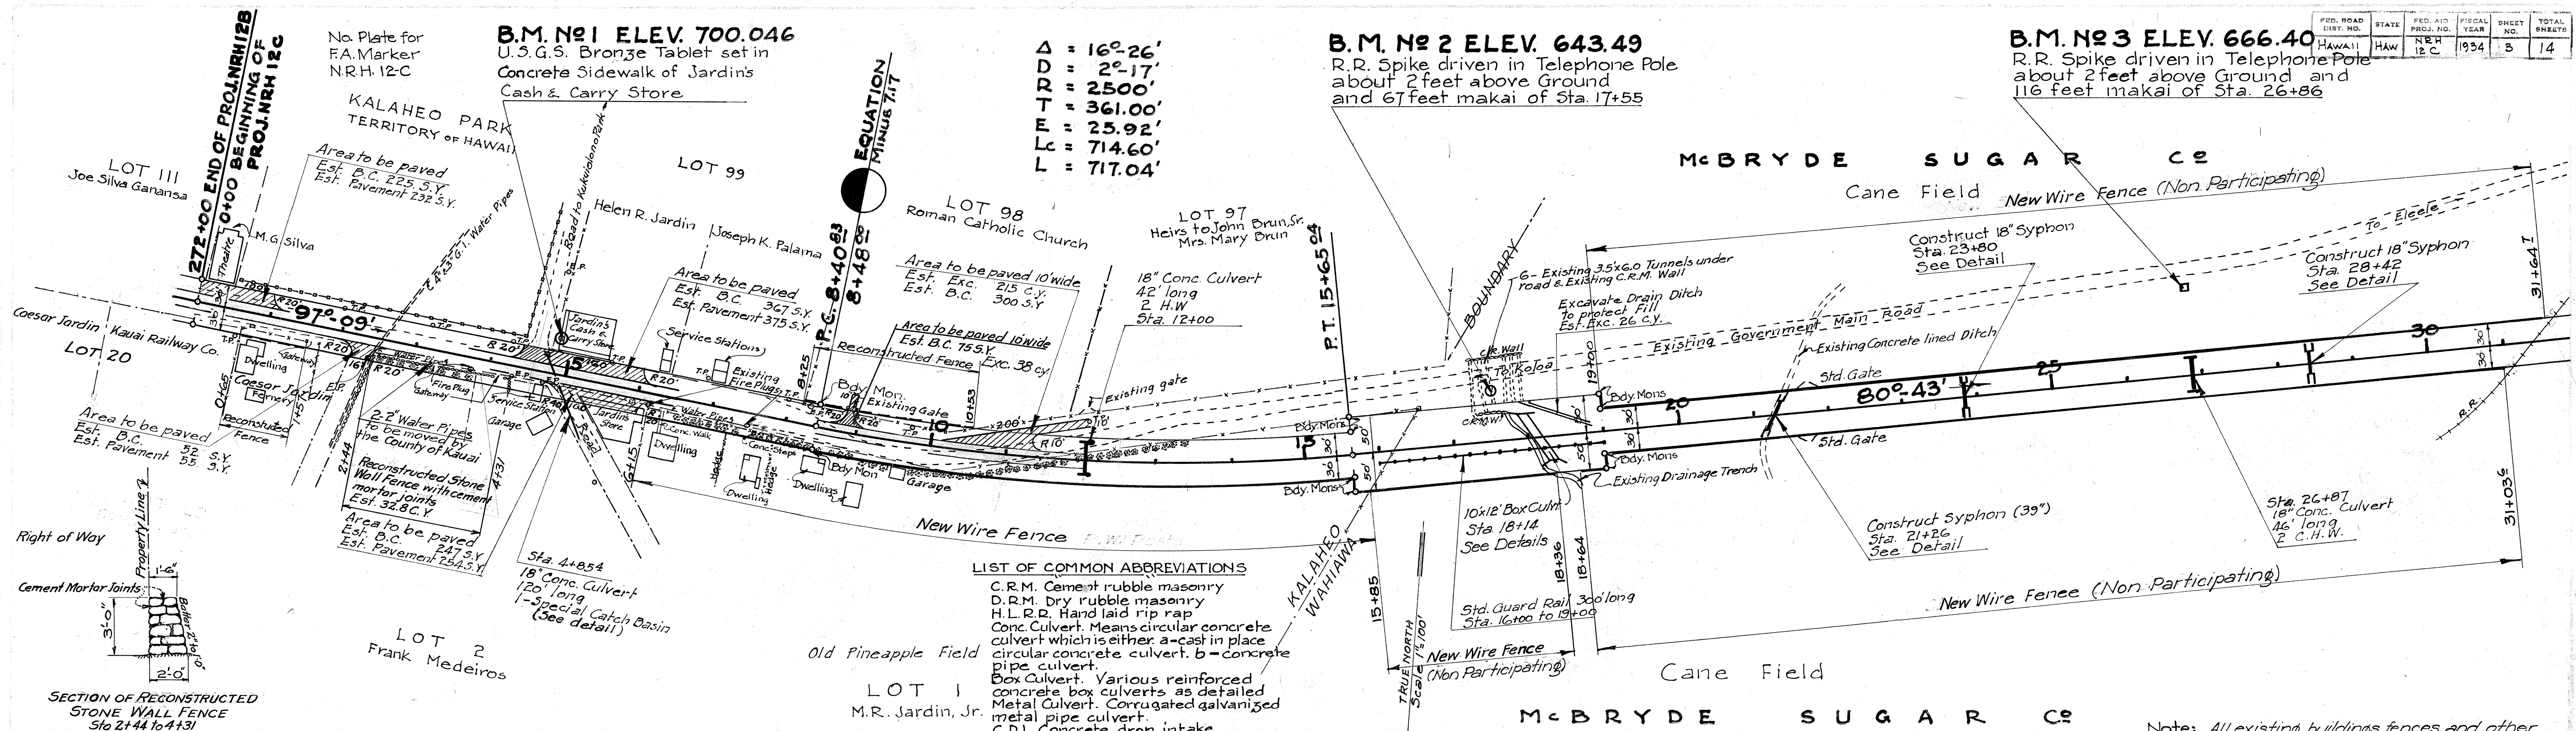

PROJ. NO.	STA.	PROJ. AC.	PLAN	SHEET	TOTAL SHEETS
HAWAII	HAW	NRH 12C	1934	5	14

$\Delta = 13^{\circ}35'$
 $D = 1^{\circ}33'$
 $R = 3500'$
 $T = 416.83'$
 $E = 24.73'$
 $L_c = 827.82'$
 $L = 829.76'$

Note: All items of work for this side road are non participating outside of highway Rt. of Way



Area to be paved
Est. B.C. 25 sy.

BRIDGE NO 6

B.M. NO 9 ELEV. 428.18
Cross on South End of the Mauka Coping of the Wahiawa Bridge.

$\Delta = 48^{\circ}49'$
 $D = 5^{\circ}44'$
 $R = 1000'$
 $T = 453.80'$
 $E = 96.15'$
 $L_c = 826.46'$
 $L = 852.01'$

GAY & ROBINSON

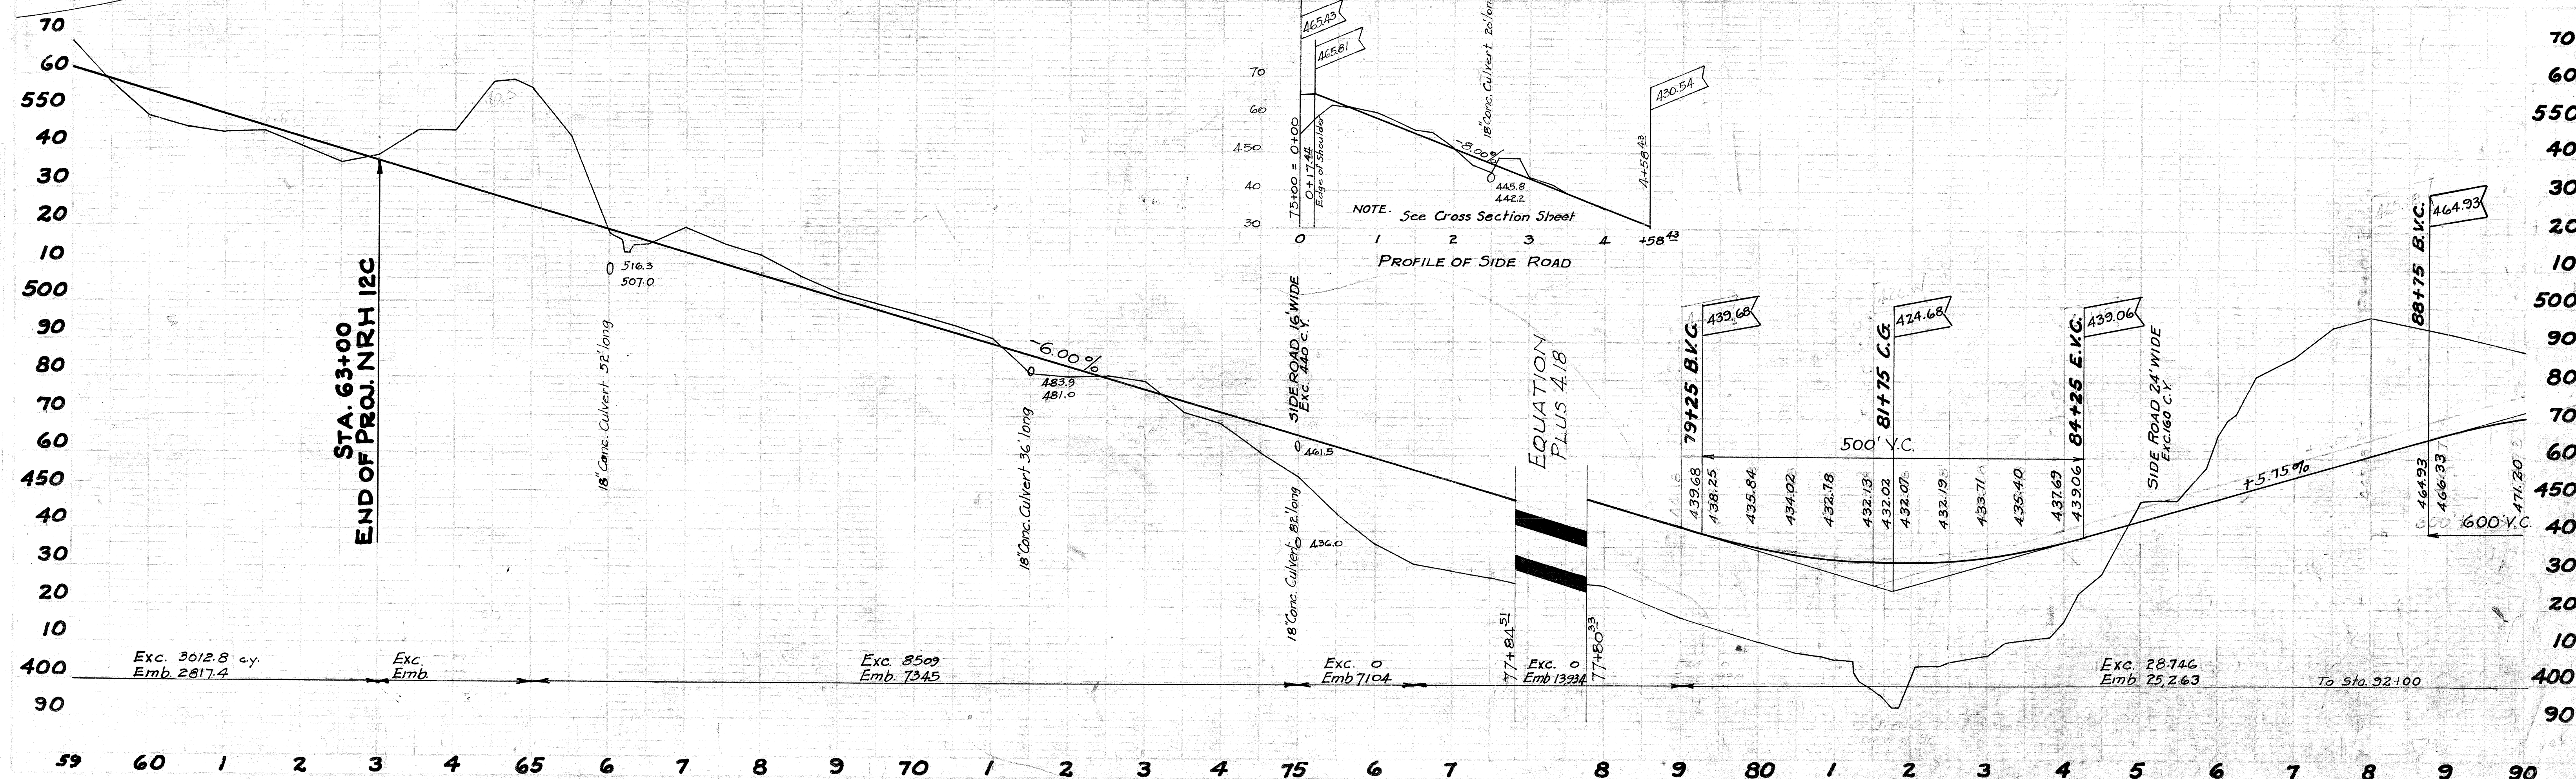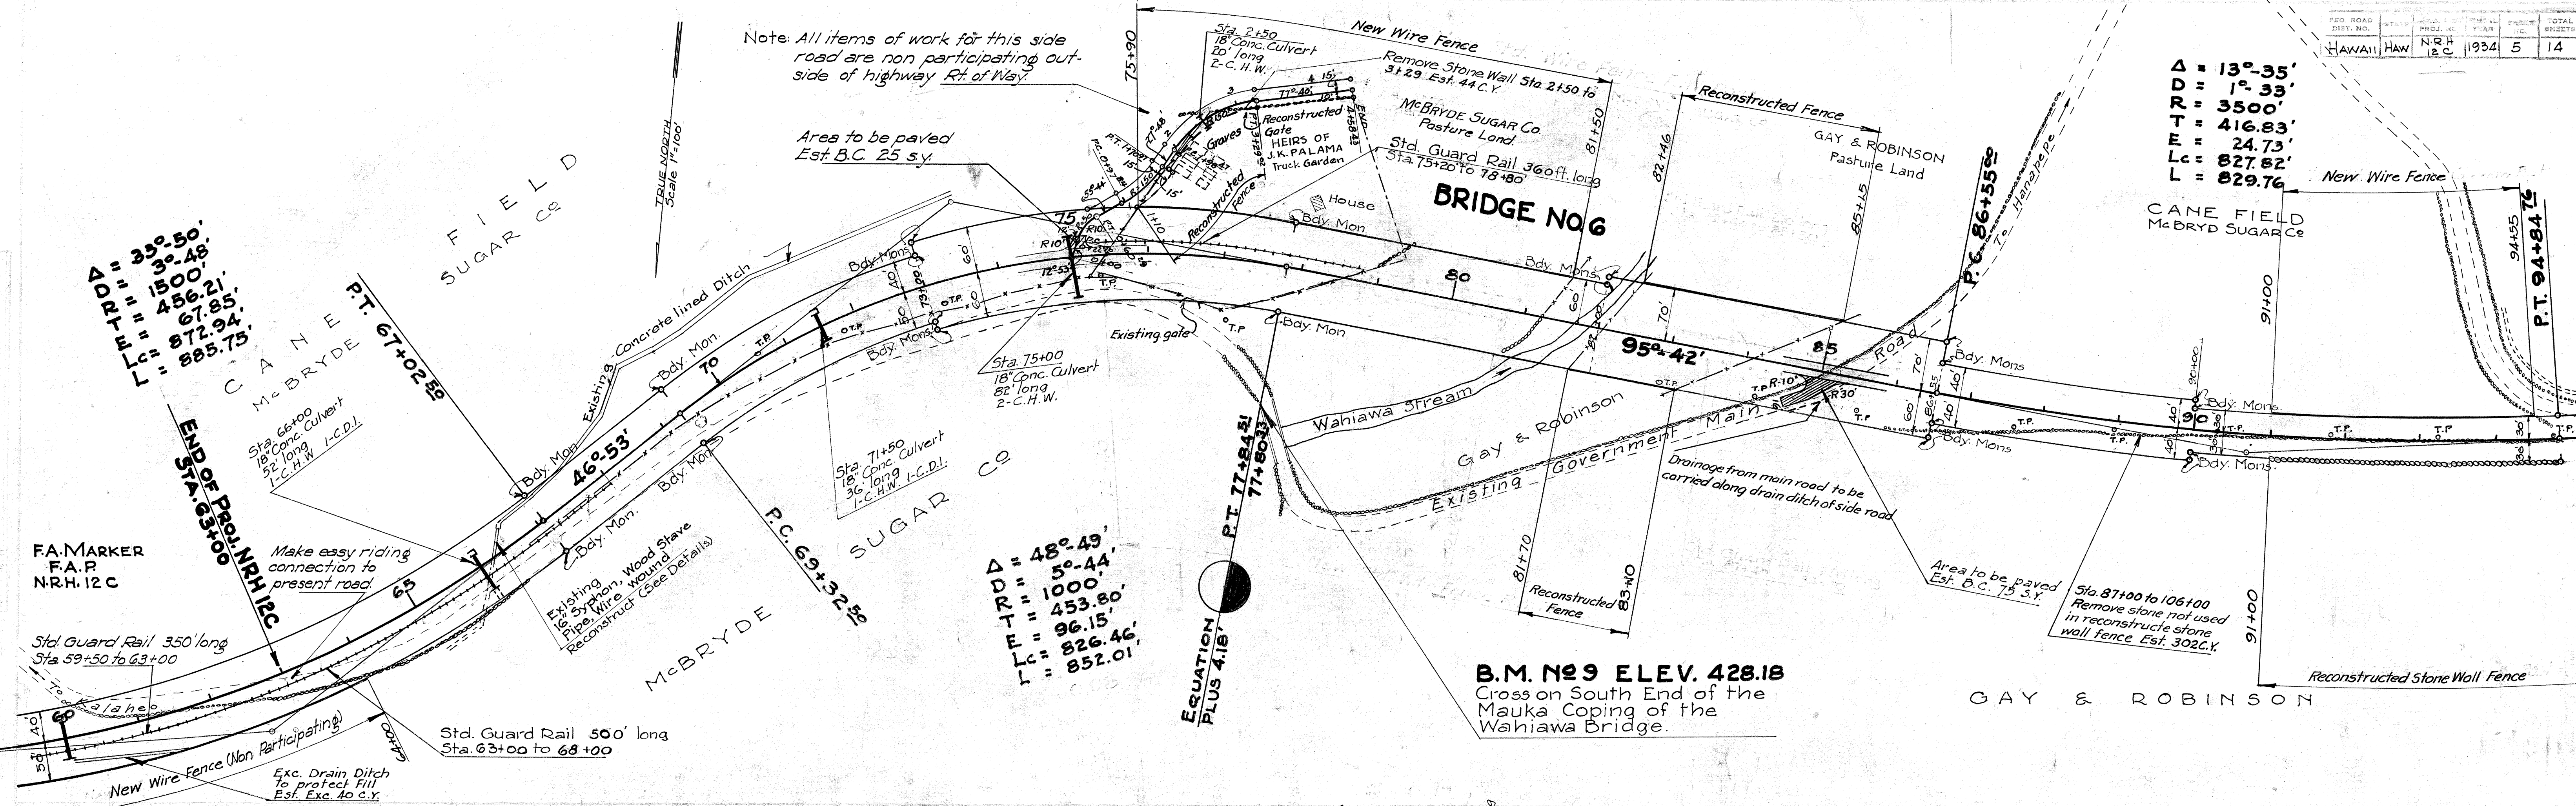

4314.5