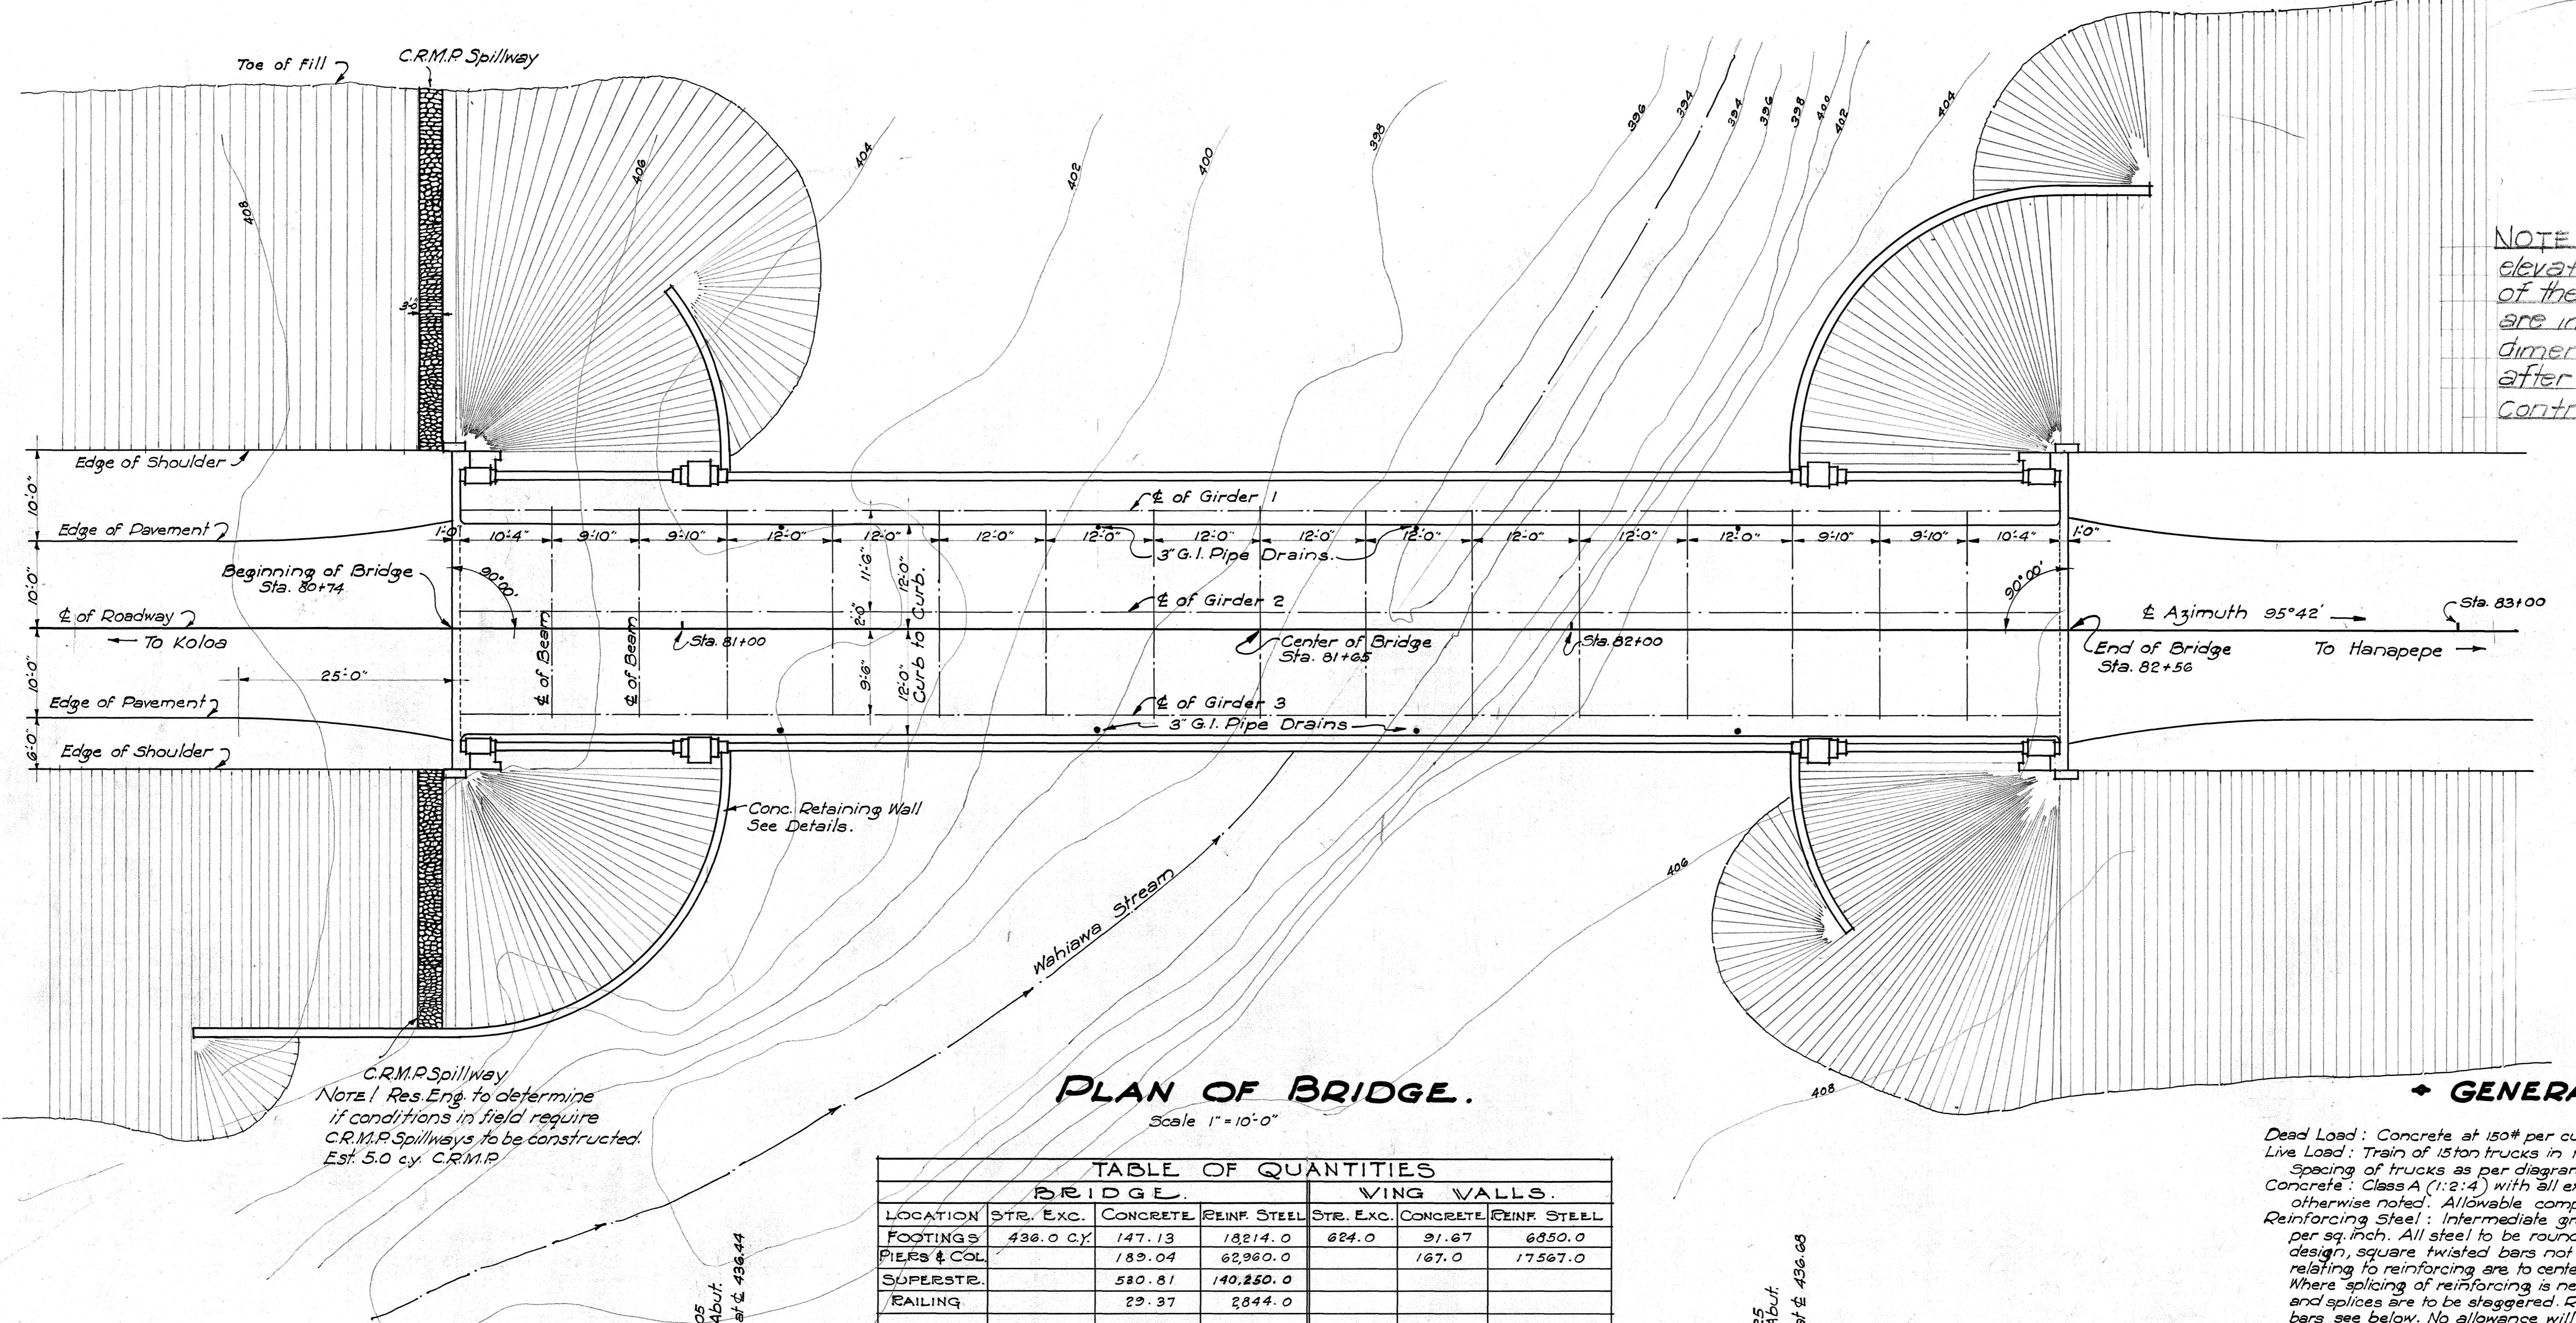


ED. ROAD DIST. NO.	STATE	FED. AID PROJ. NO.	FISCAL YEAR	SHEET NO.	TOTAL SHEETS
HAWAII	HAW.	N.R.H. 12-D/1935	1935	9	35

NOTE! Due to change in elevation of footings some of the vertical dimensions are incorrect. These dimensions will be changed after completion of the contract.



PLAN OF BRIDGE.

Scale 1" = 10'-0"

TABLE OF QUANTITIES


TABLE OF QUANTITIES							
BRIDGE.				WING WALLS.			
LOCATION	STR. EXC.	CONCRETE	REINF. STEEL	STR. EXC.	CONCRETE	REINF. STEEL	
FOOTINGS	436.0 C.Y.	147.13	18,214.0	624.0	91.67	6850.0	
PIERS & COL.		189.04	62,960.0		167.0	17567.0	
SUPERSTR.		530.81	140,250.0				
RAILING		29.37	2844.0				
TOTAL	436.0 C.Y.	896.35 C.Y.	224,268.0 #	624.0 C.Y.	258.67 C.Y.	24,417.0 #	

C.R.M.P. Spillway
Note! Res. Eng. to determine
if conditions in field require
C.R.M.P. Spillways to be constructed
Est. 5.0 c.v. C.R.M.P.

UPSTREAM ELEVATION

Scale 1" = 10'-0"

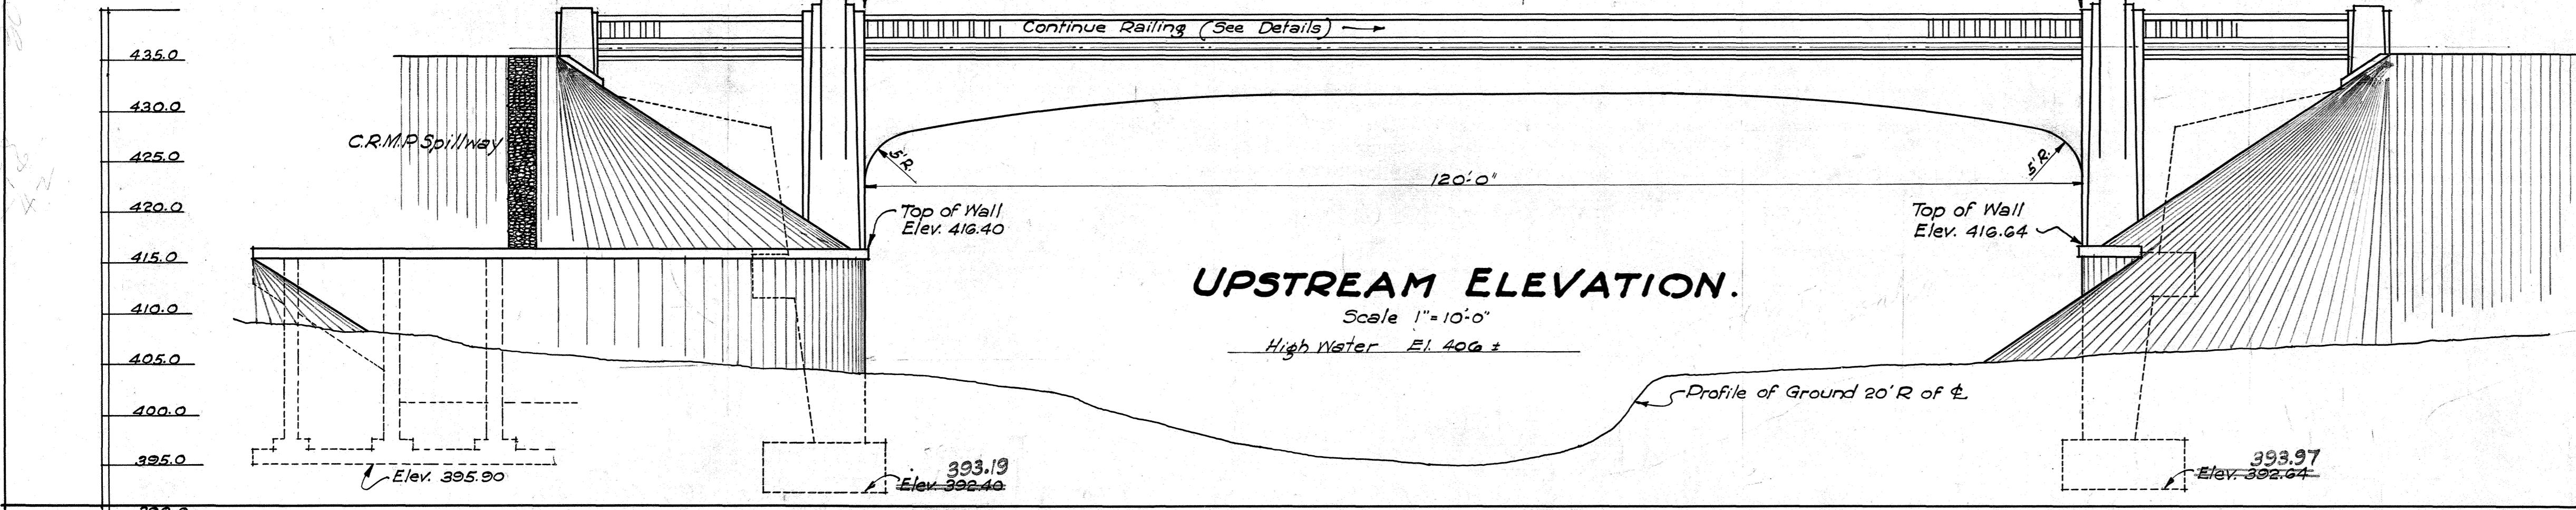High Water El. 406



Dead Load: Concrete at 150# per cu. ft.
Live Load: Train of 15ton trucks in two traffic lanes. Impact allowance $\frac{50}{(t+125)}$.
Spacing of trucks as per diagram.
Concrete: Class A (1:2:4) with all exposed edges chamfered $\frac{3}{4}$ " unless otherwise noted. Allowable compression 650#per sq. inch.
Reinforcing Steel: Intermediate grade, allowable tensile stress 18,000# per sq. inch. All steel to be round or square deformed bars of approved design, square twisted bars not to be considered deformed. All dimensions relating to reinforcing are to centers of bars unless otherwise noted. Where splicing of reinforcing is necessary, bars are to be lapped 40 diameters and splices are to be staggered. Regarding splicing of main longitudinal bars see below. No allowance will be made in the quantities for extra weight of steel required for splicing. Unless otherwise noted the minimum covering measured from the surface of concrete to the face of any steel shall be not less than $2\frac{1}{2}$ " in abutments and abutment footings; 2" in beams, girders and handrails and $1\frac{1}{4}$ " in slabs. Steel to be held rigidly & accurately in place before and during placing of concrete.

Splices: Splices are permitted in main bars exceeding trade lengths at points to be indicated by the Engineer, to be electrically arc welded, using wedge cutbacks and $\frac{1}{8}$ " collars. Splices to test at least full strength.

Brush Coat Waterproofing: Remove all projections, cement film, dirt, etc. and apply waterproofing as specified. Waterproofing is incidental to the concrete used and will not be paid for separately.

Construction Joints : All construction joints to have surface roughened and 1:2 cement grout applied immediately before second pour.

Bottom construction joints to be at top of footing, top construction joints at bottom of girder haunches, railing construction joint to be at top of curb.

Digitized by srujanika@gmail.com

TERRITORIAL HIGHWAY DEPARTMENT.
TERRITORY OF HAWAII

STATE OF HAWAII
WAHLIAWA BRIDGE




WAHIAWA BRIDGE
NO 6 STA 82+71 TO STA 83+56

SIA.80+14.10 SIA.82+56.
KAIUAI BELT ROAD NBU 122

KAUAI BELT ROAD N.R.A. 12-D.
DATE JUN 1935 SWEEET 12-17-2

DATE June 1935 SHEET 1 OF 17 SHEETS.

FED. ROAD DIST. NO.	STATE	FED. AID PROJ. NO.	FISCAL YEAR	SHEET NO.	TOTAL SHEETS
HAWAII	HAW	N.R.H.	1935	10	35

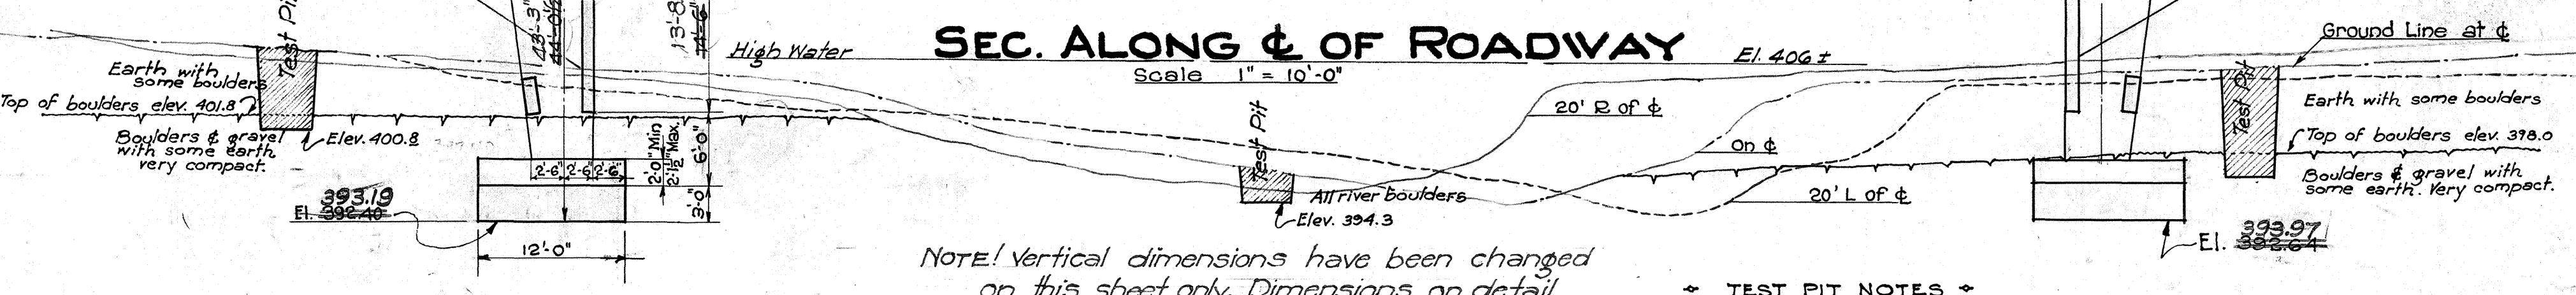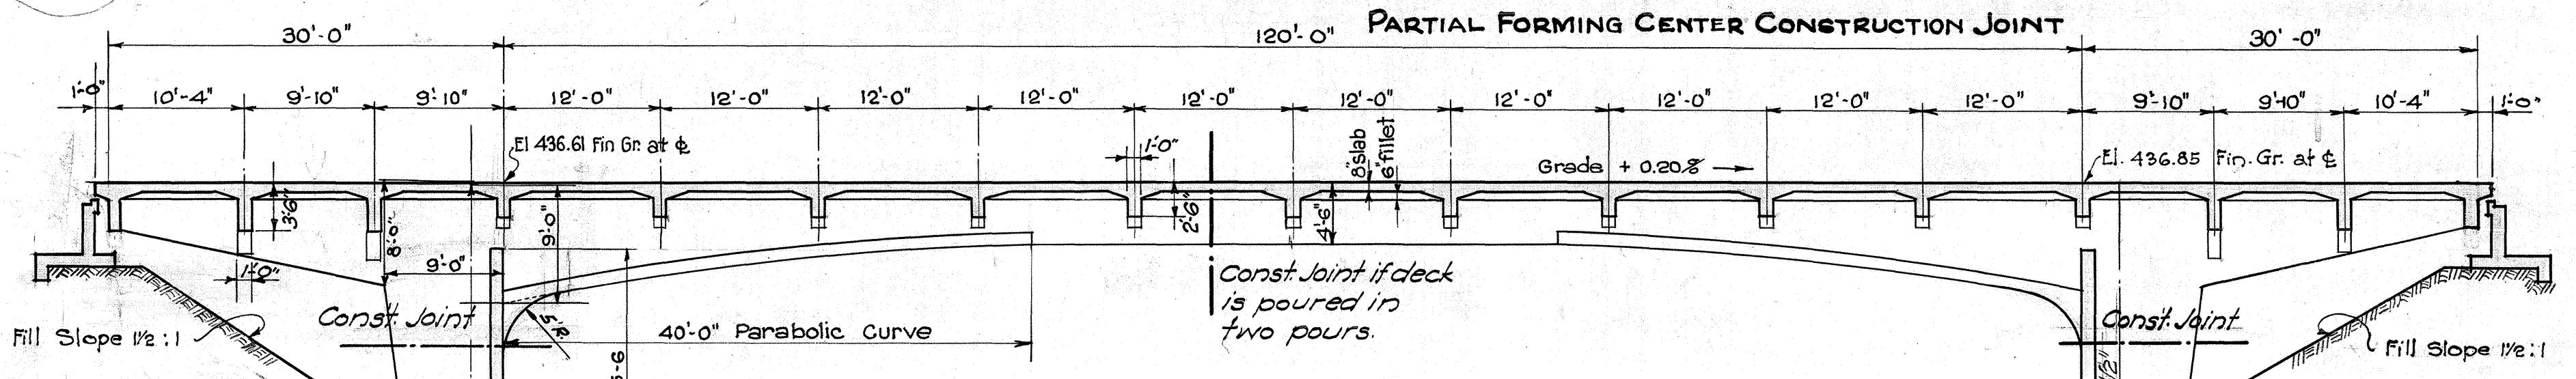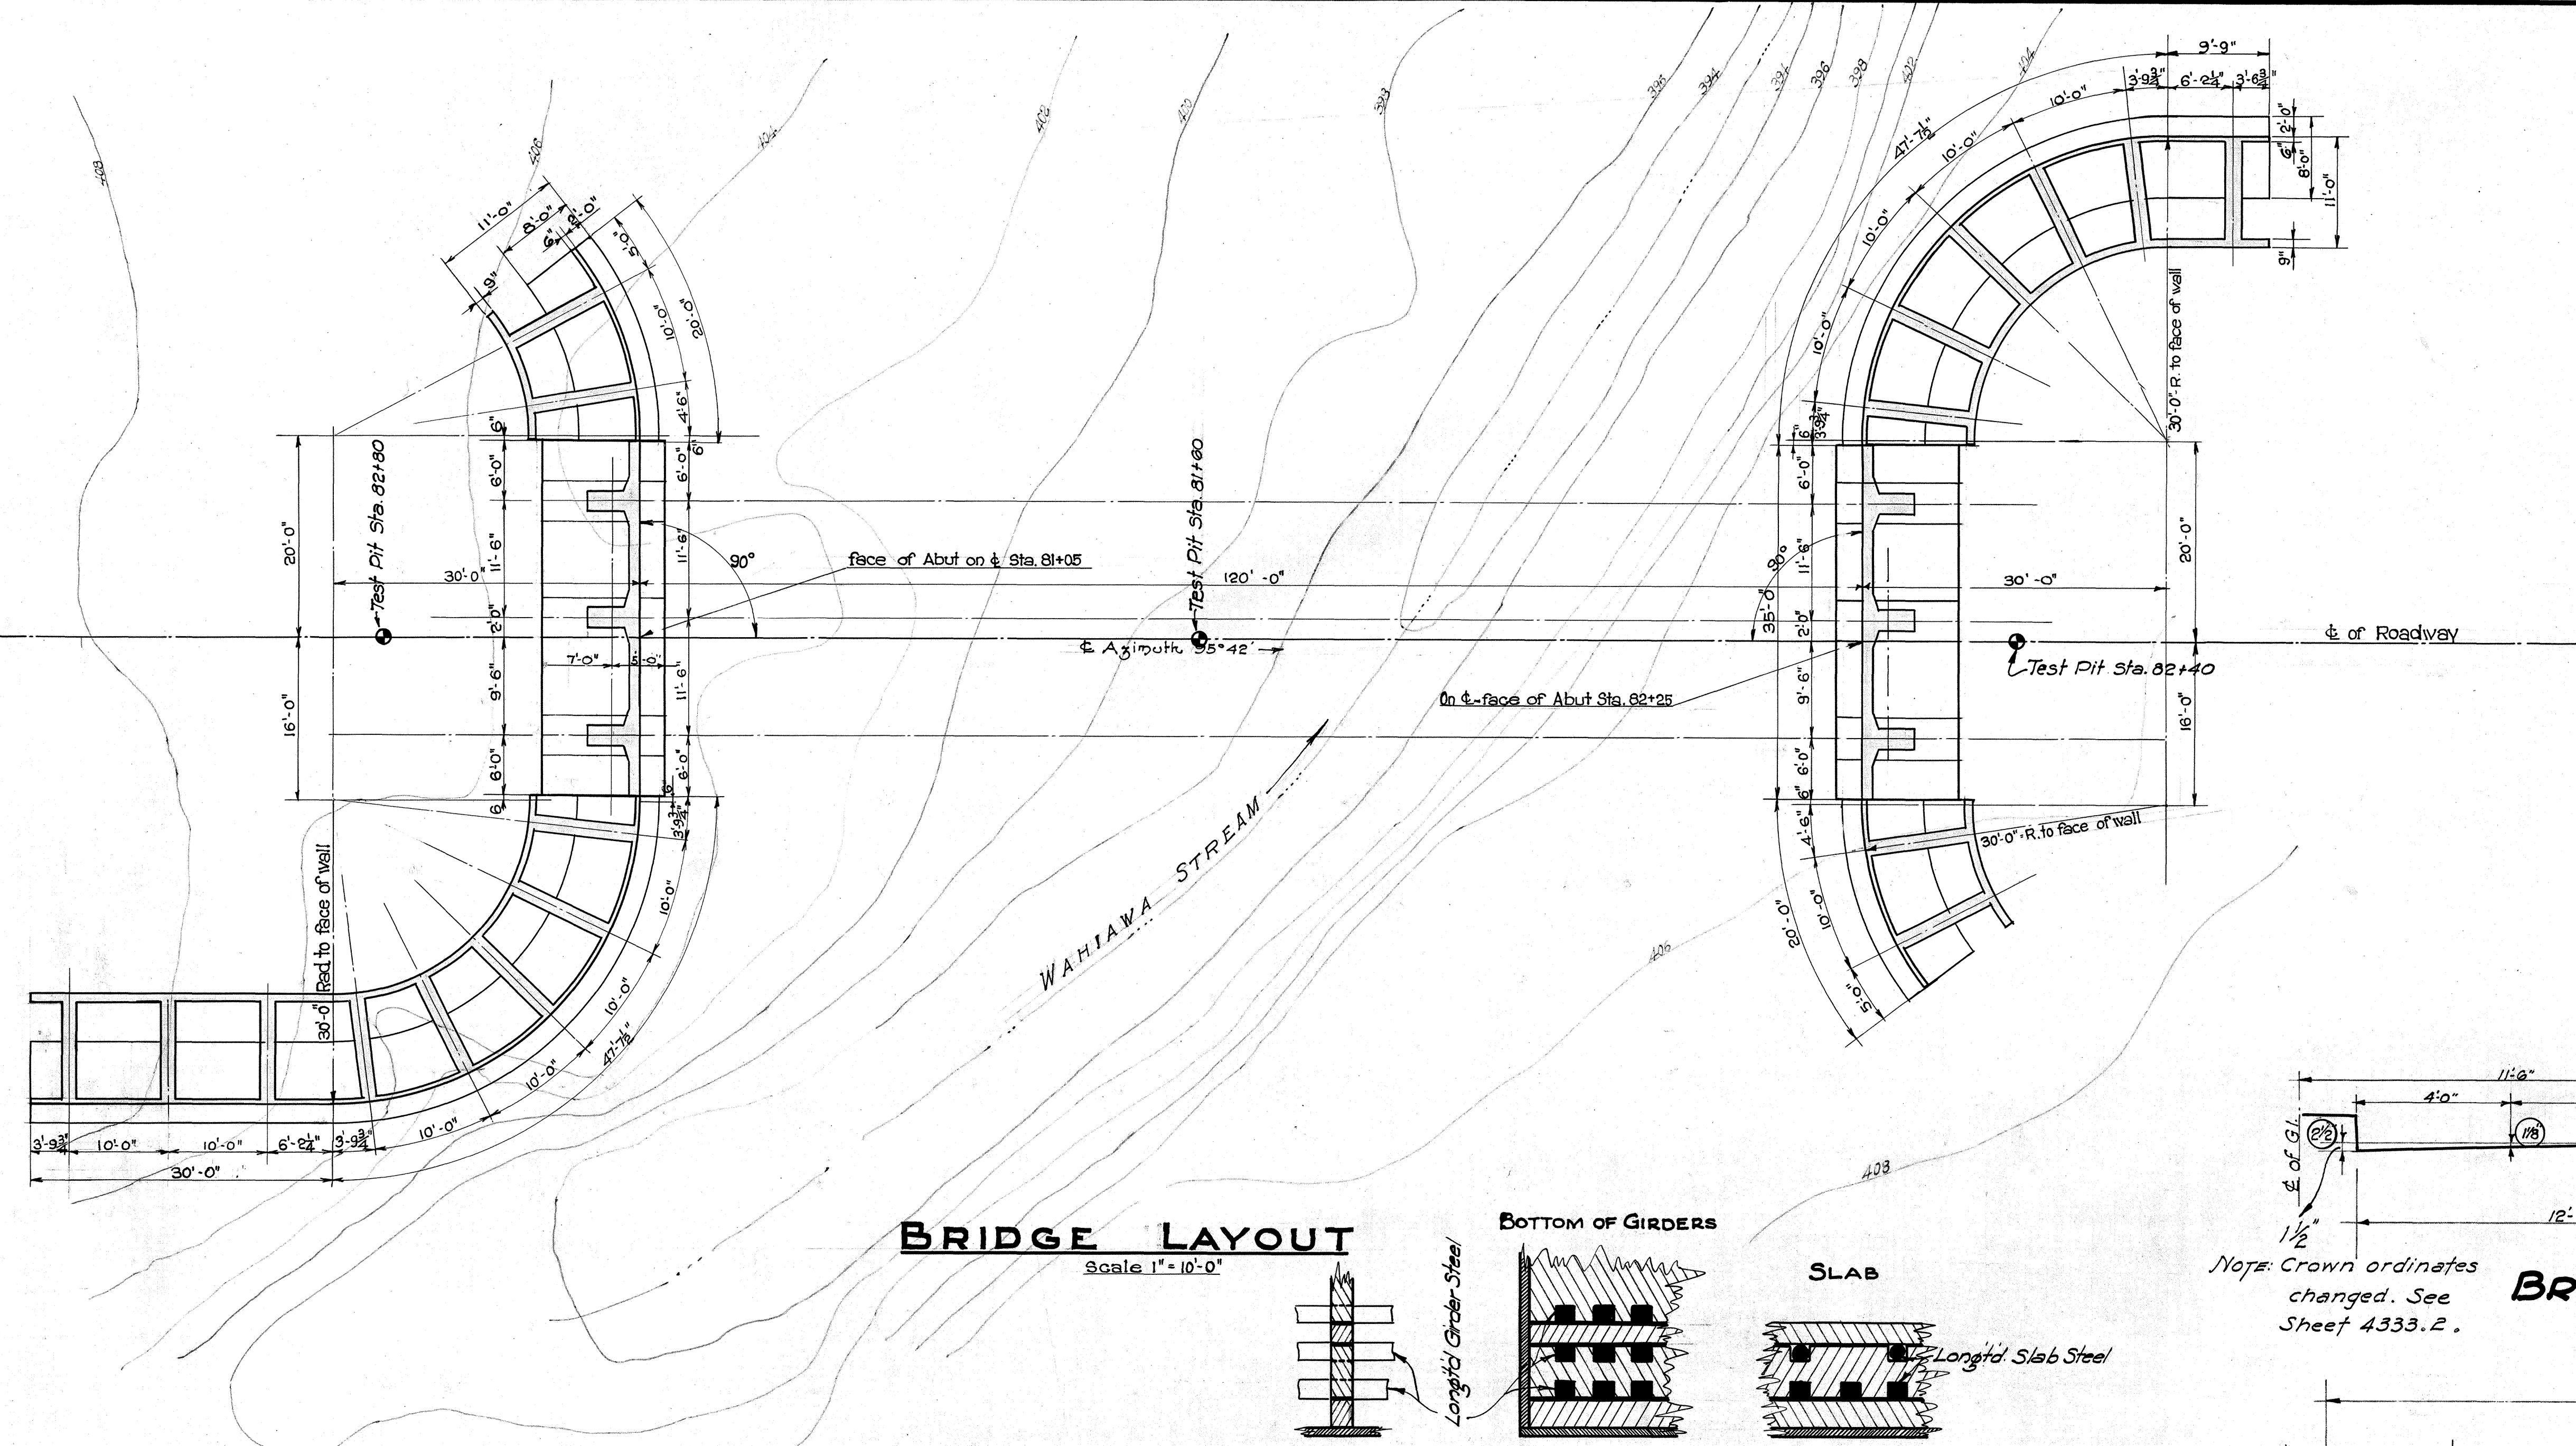

ORIGINAL SURVEY PLotted May 1935
PL. IN SURVEY BY C.E.V.
NOTES DRAWN BY C.E.V.
TRACED BY C.E.V.
QUOTED BY C.E.V.
CHECKED BY C.E.V.
RE-B
No. 393.19

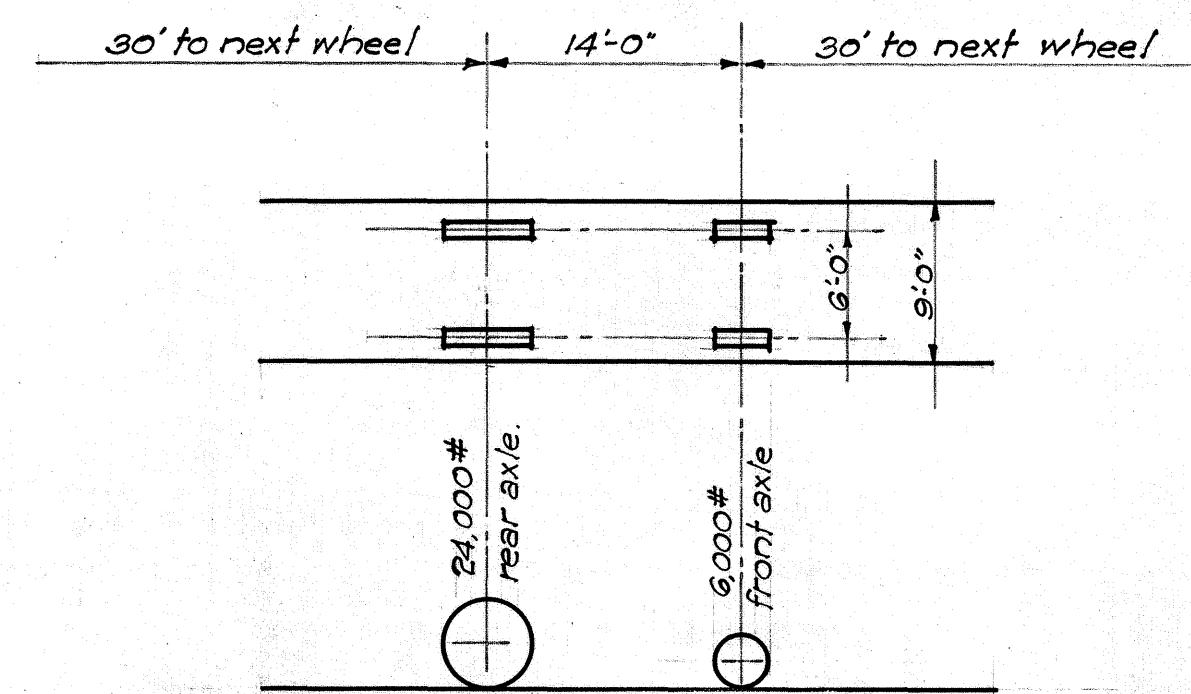


DIAGRAM OF TYPICAL 15 TON TRUCK.

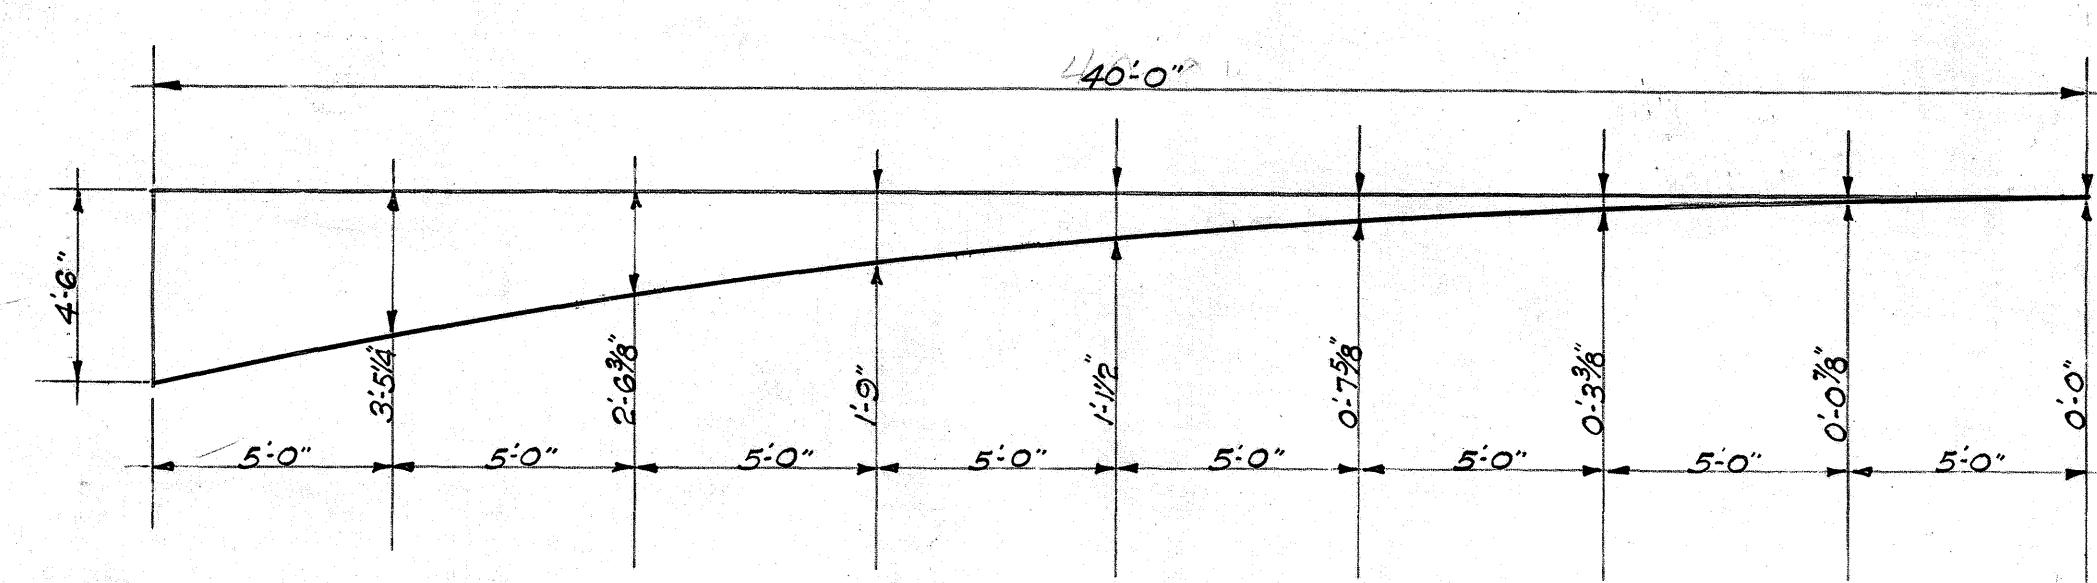
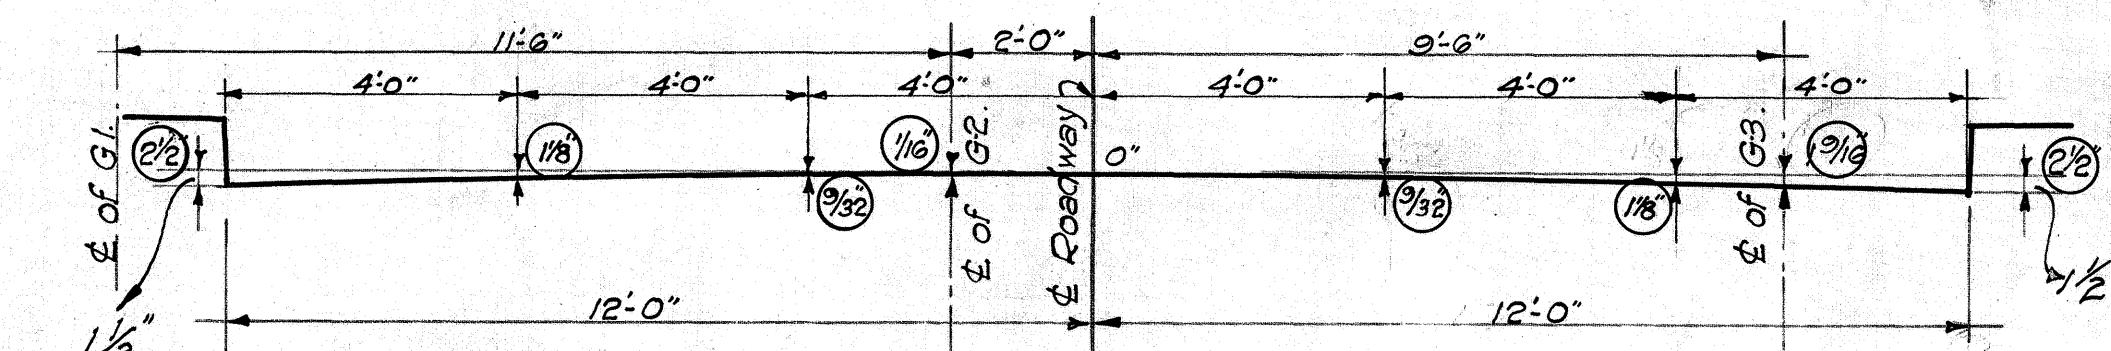
Depressed "V" letters $\frac{3}{8}$ deep
NAME
Use correct name of stream
DATE
Date of year built

LEFT HAND SIDE.

RIGHT HAND SIDE.

DETAIL OF LETTERS & FIGURES AT BOTH APPROACHES.

NOTE! Name of stream to be placed in left end post panels & date in right end post panels on entering bridge using standard block letters 3" in height.



TERRITORIAL HIGHWAY DEPARTMENT
TERITORY OF HAWAII

WAHIAWA BRIDGE








NO. 6 STA. 80+74 TO STA. 82+56.

KAUAI BELT ROAD N.R.H. 12-D.

DATE June 1935 SHEET 2 OF 17 SHEETS.






333.10

FED. ROAD DIST. NO.	STATE	FED. AID NO.	FISCAL YEAR	SHEET NO.	TOTAL SHEETS
HAWAII	HAW	K-17	12-0 (1935)	11	35

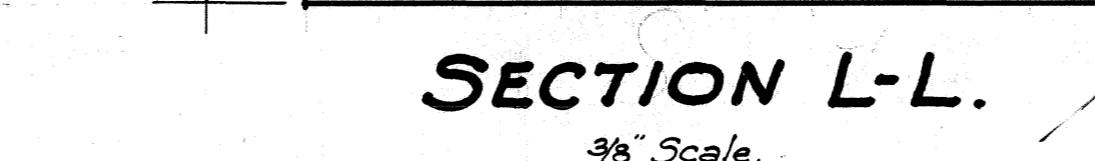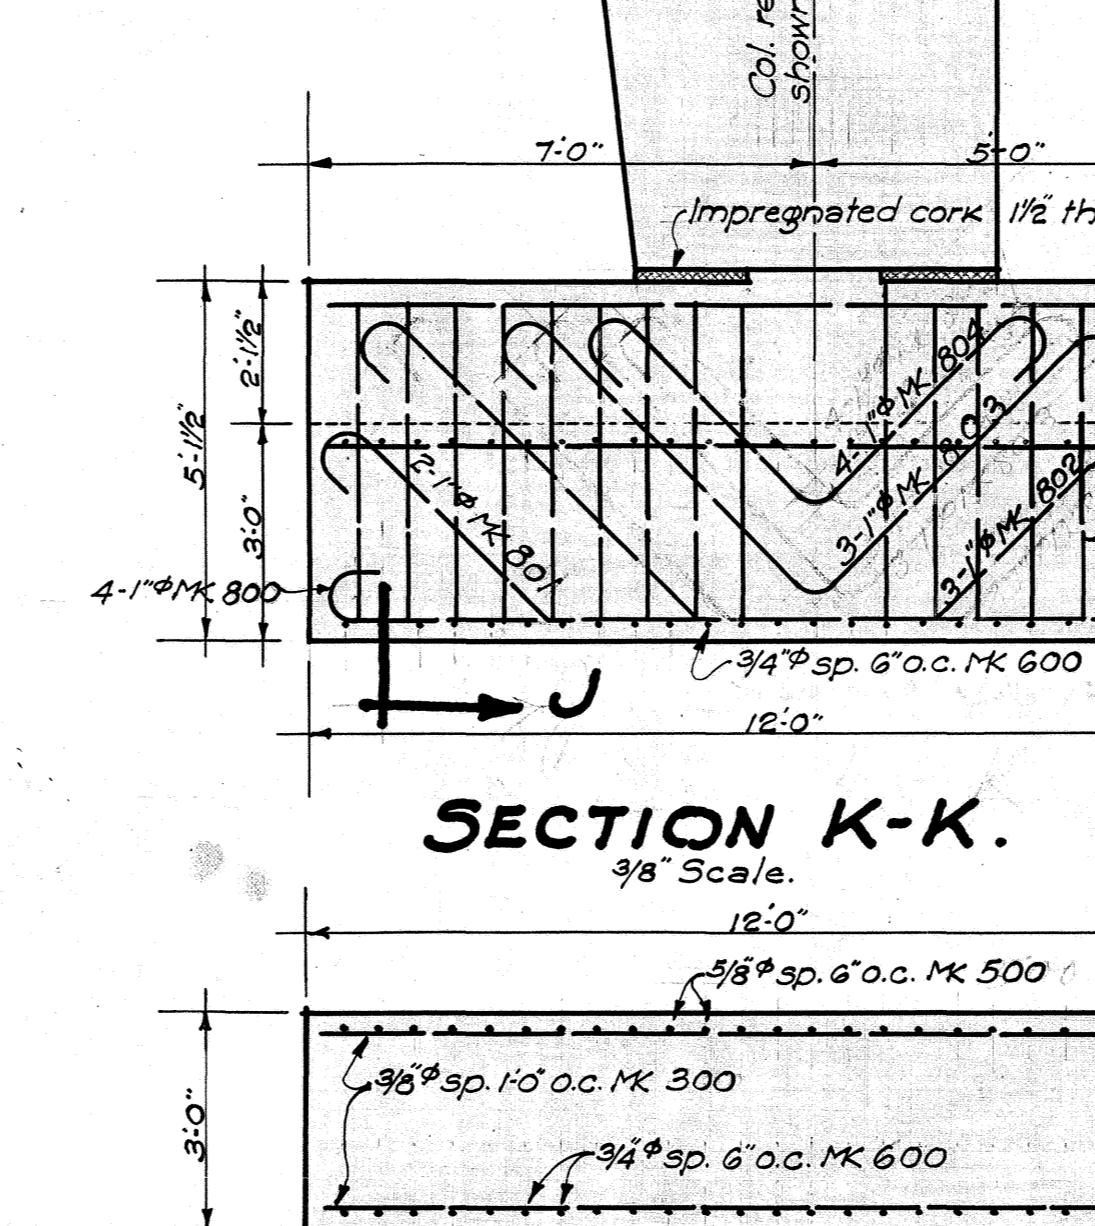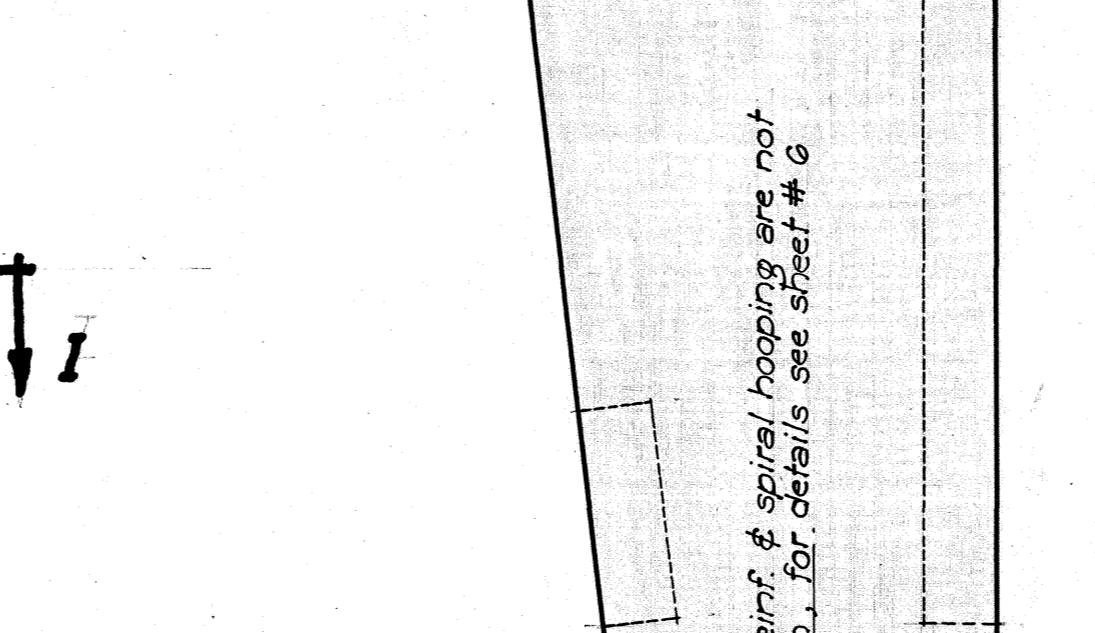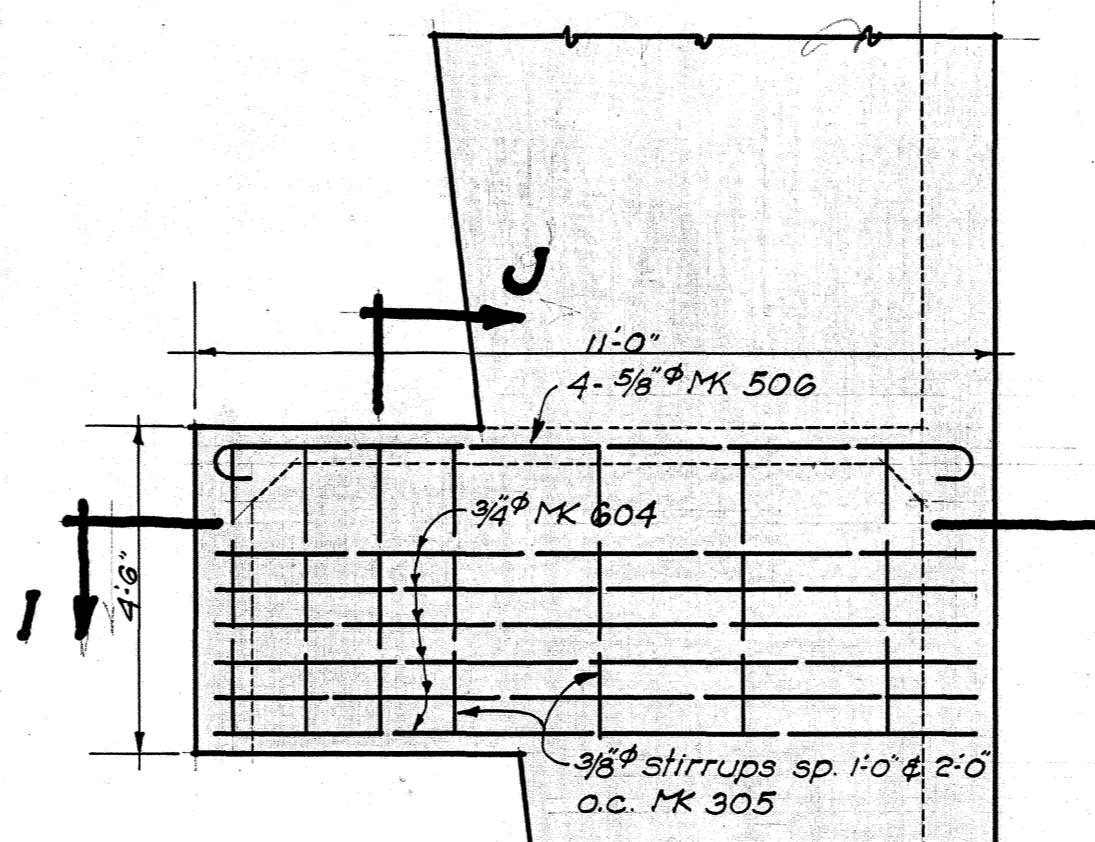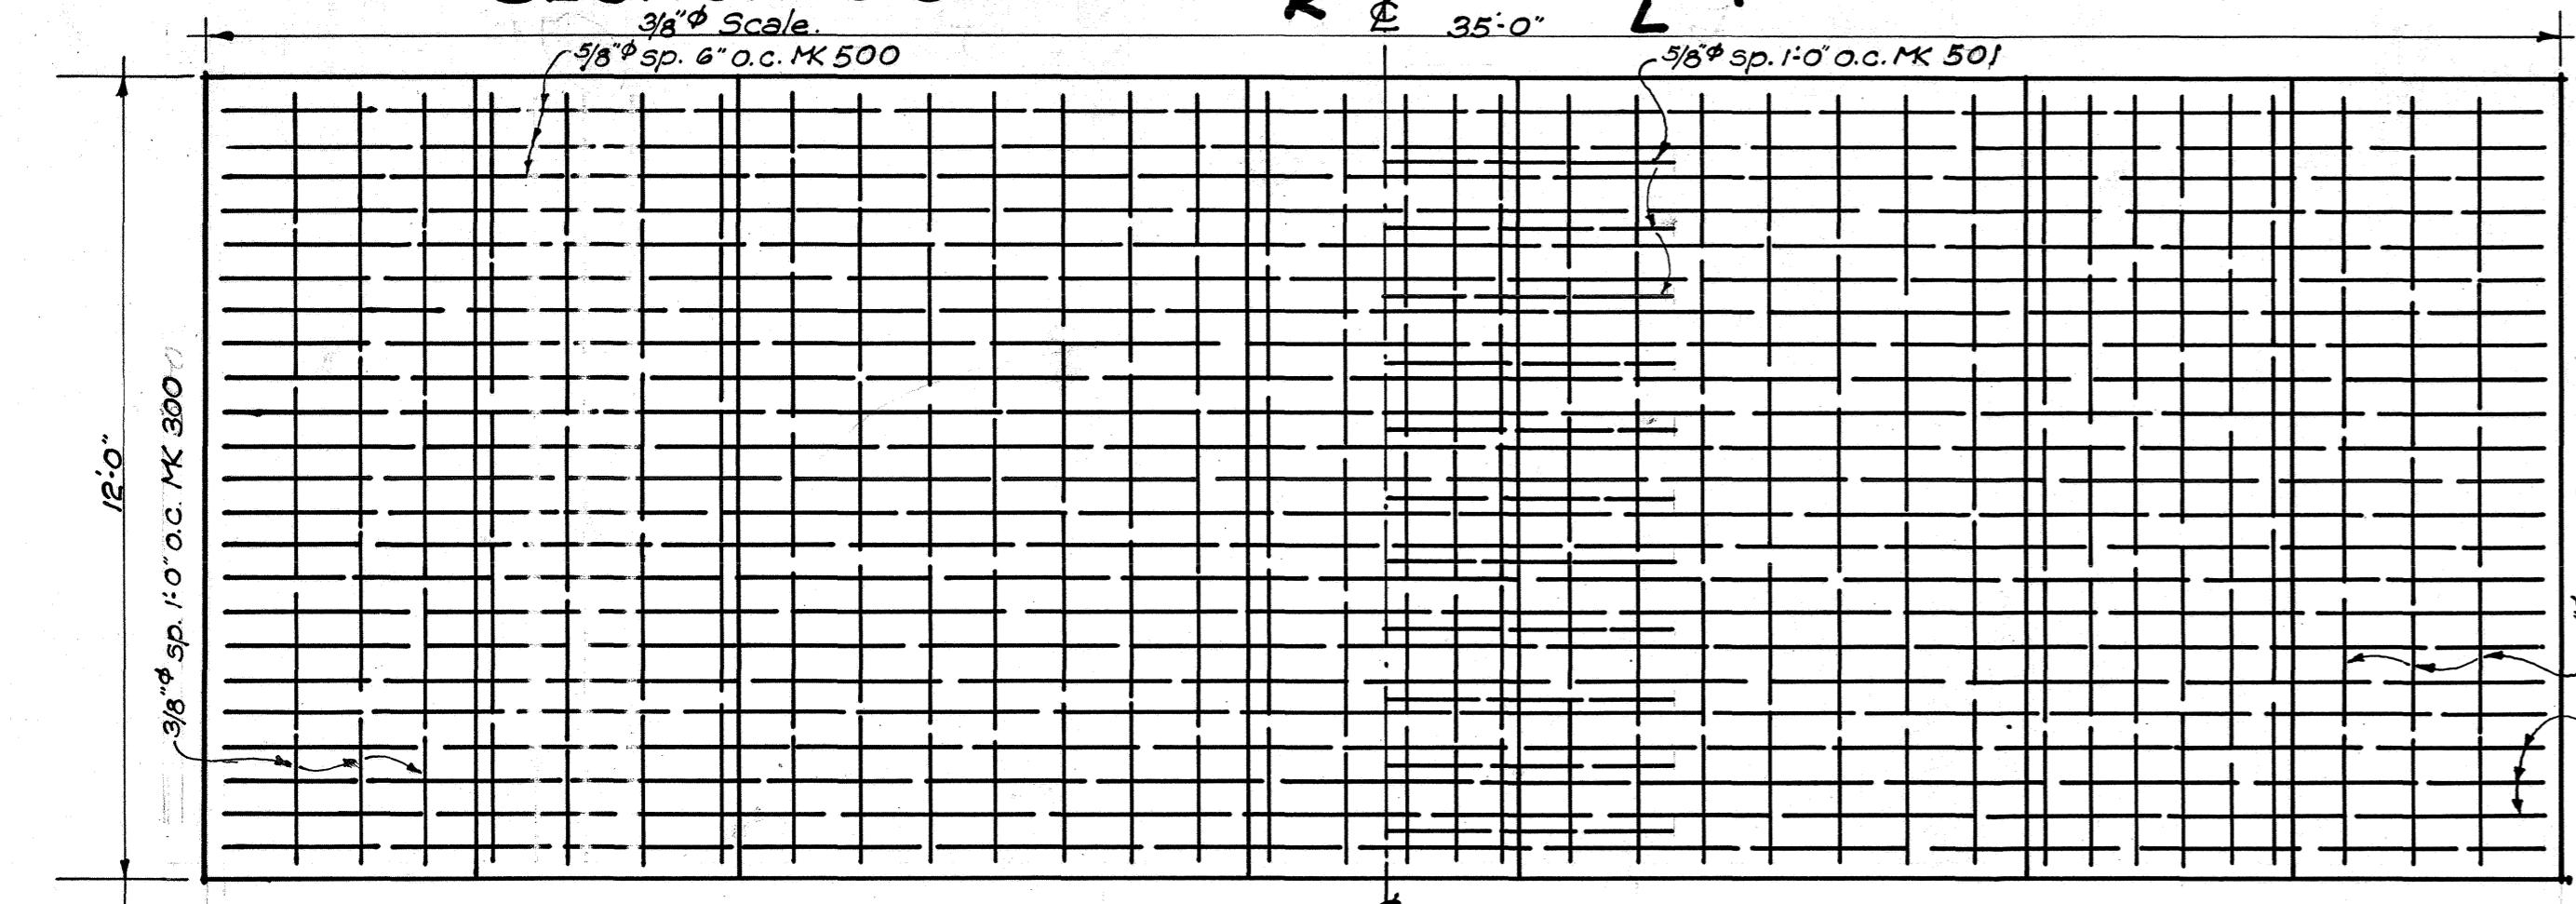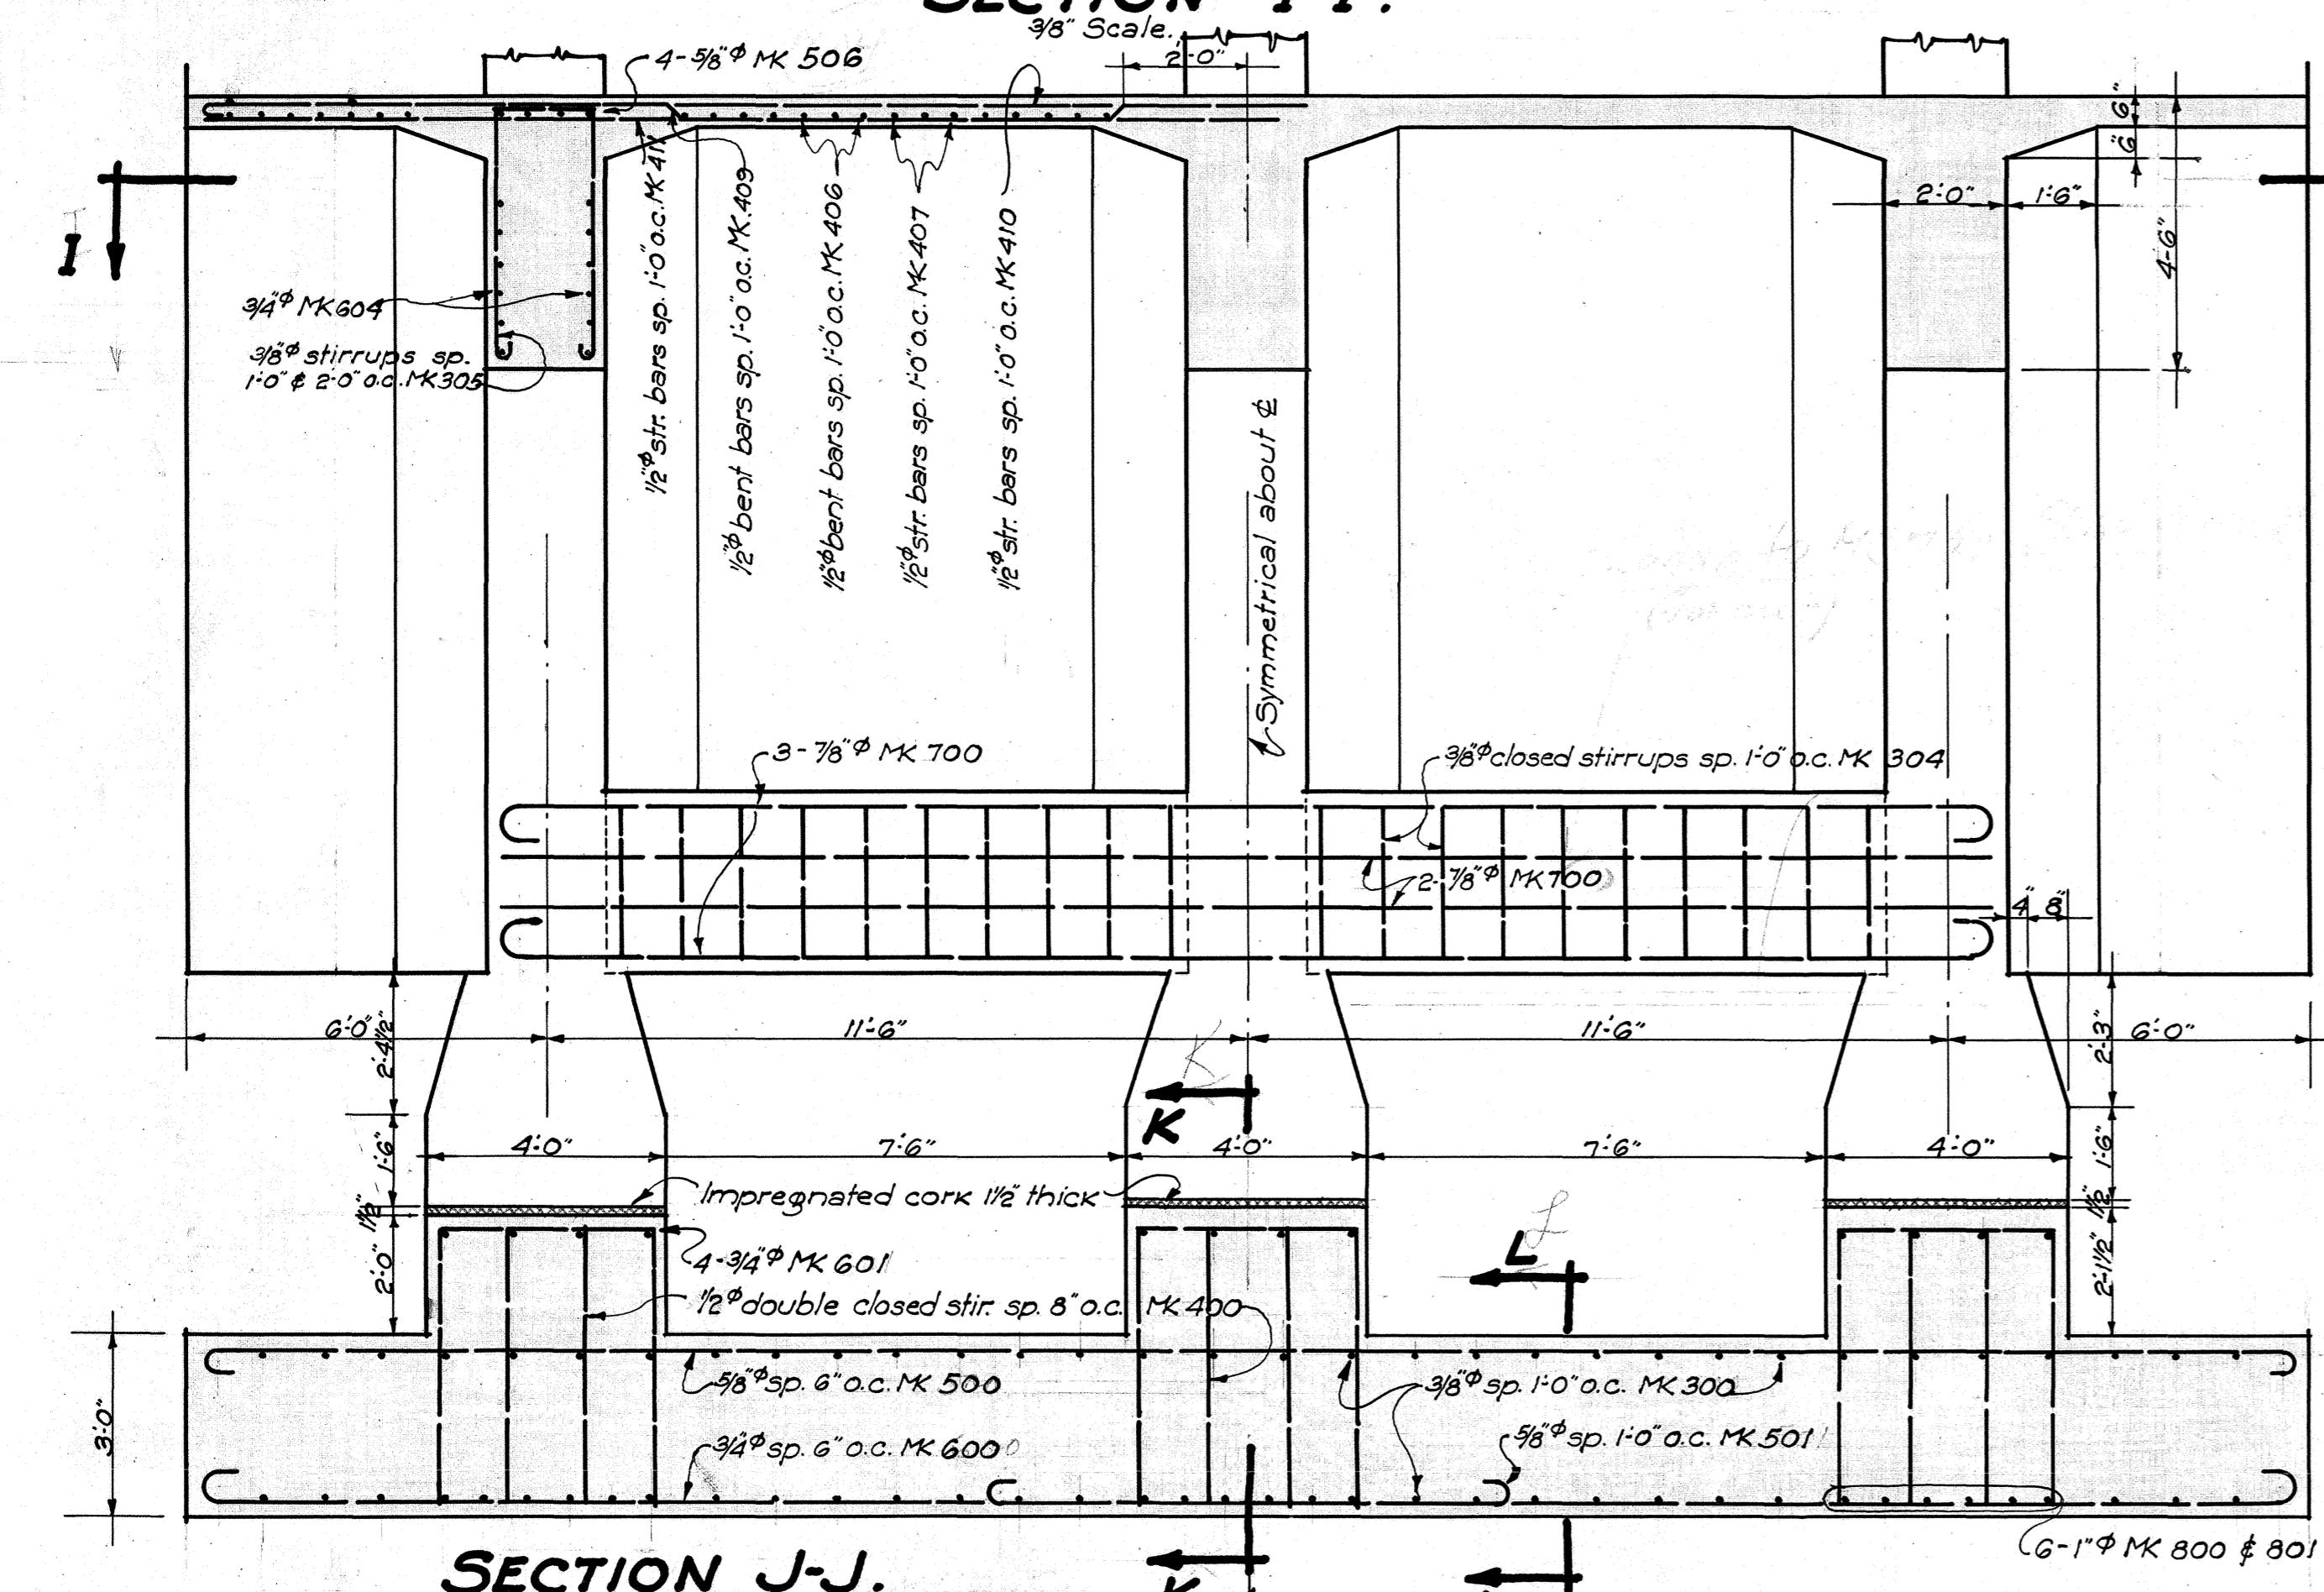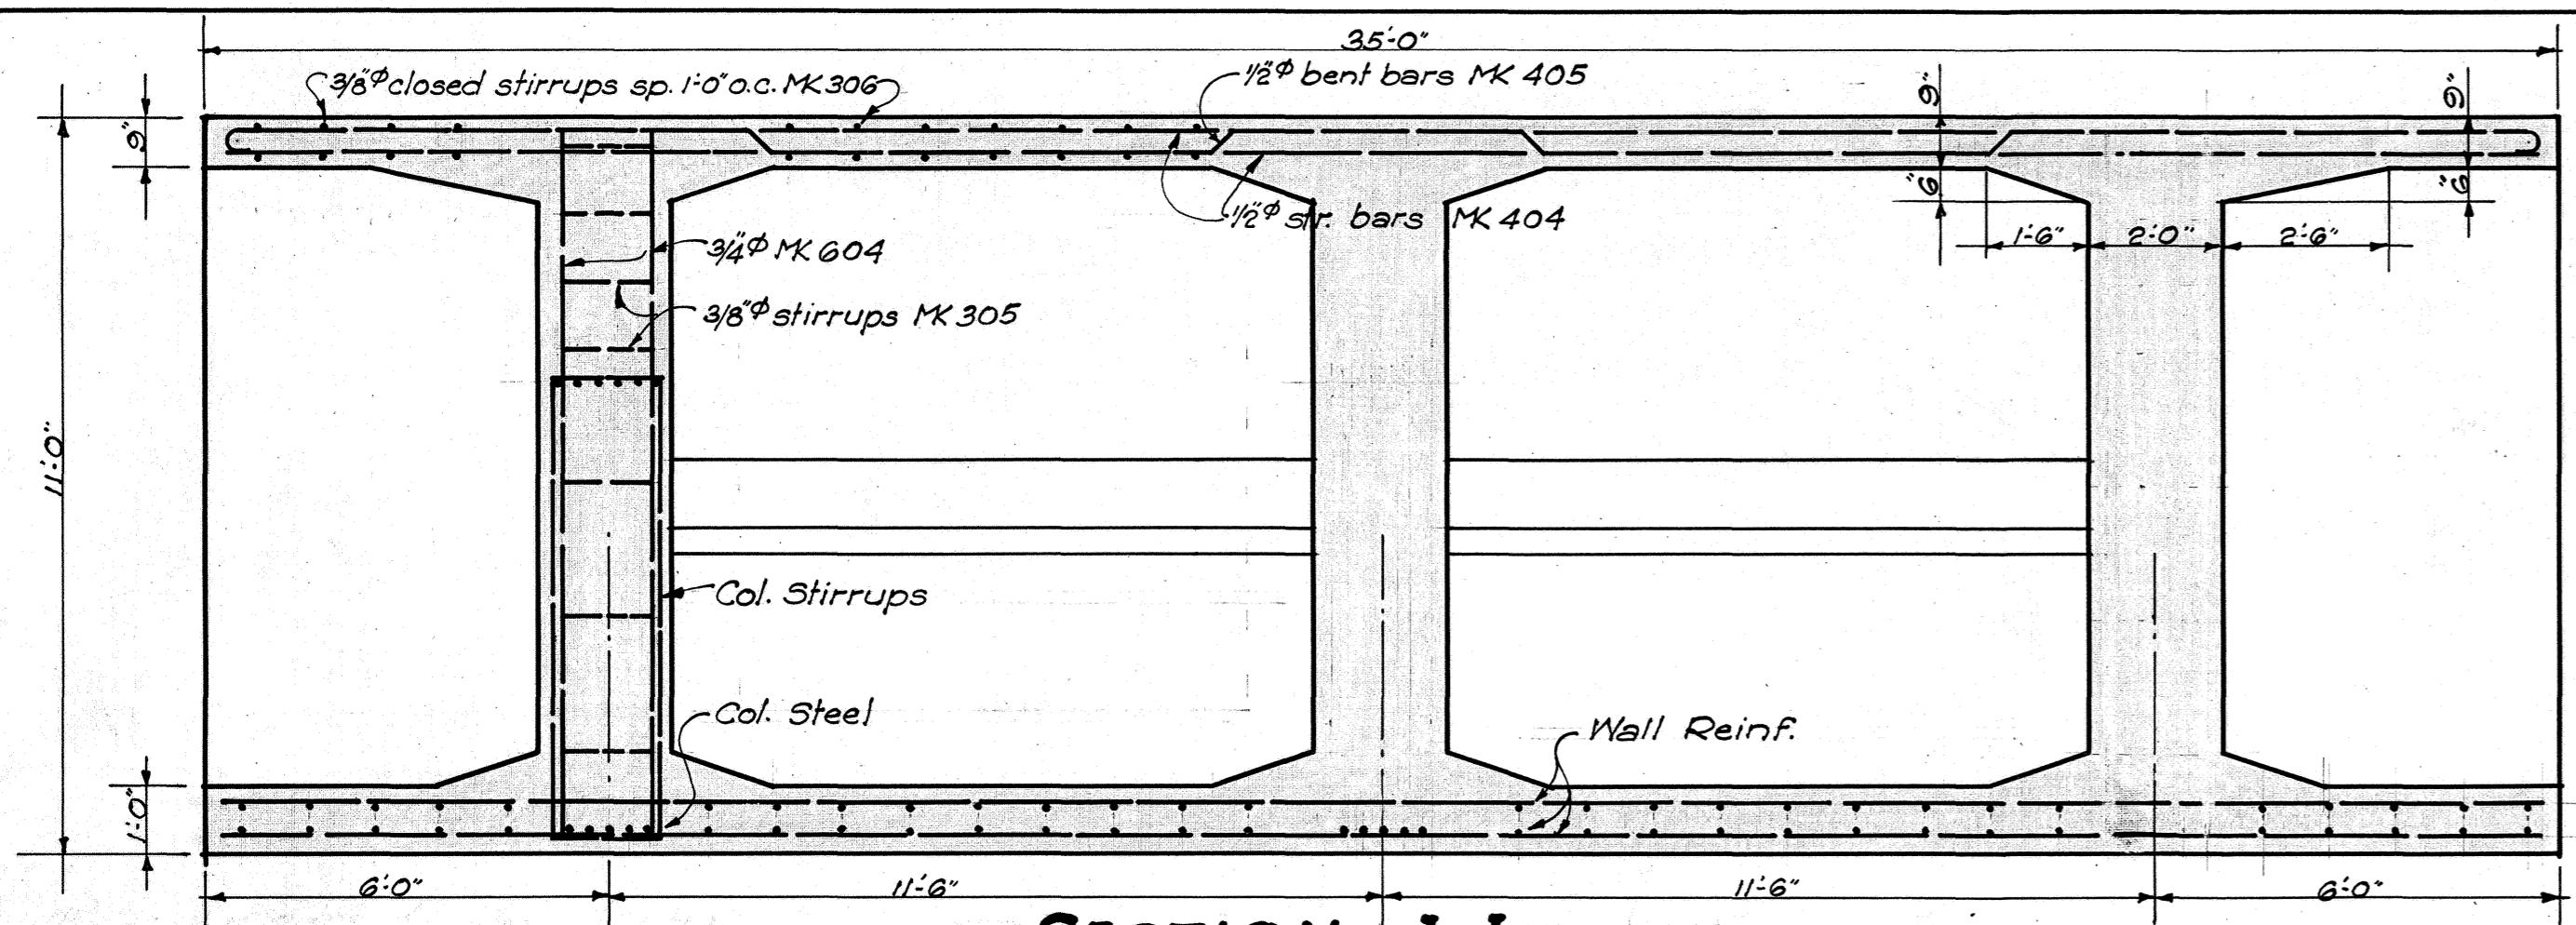

For reinf. of this wall
See Sheet # 5

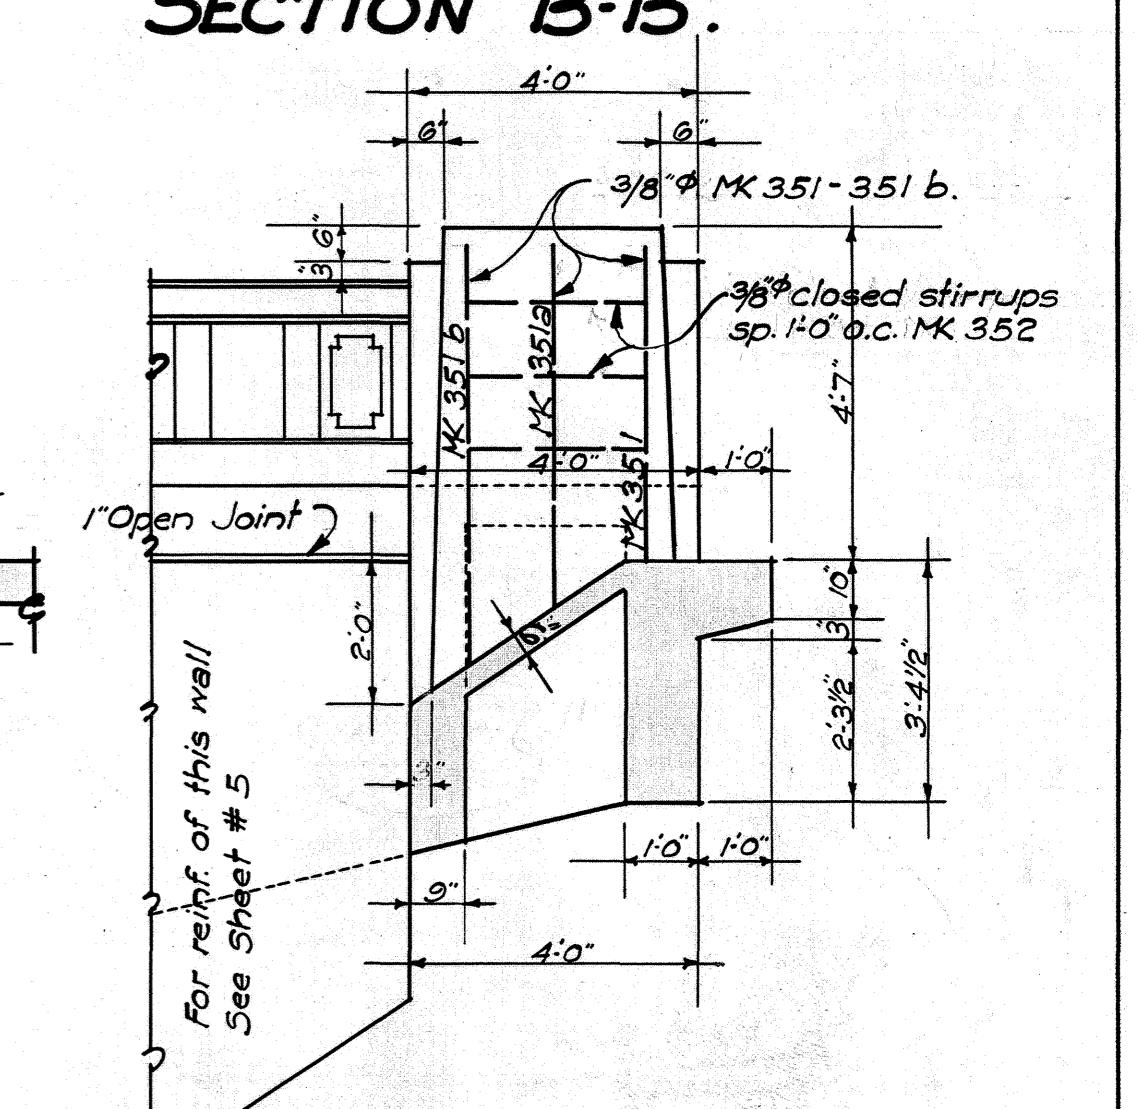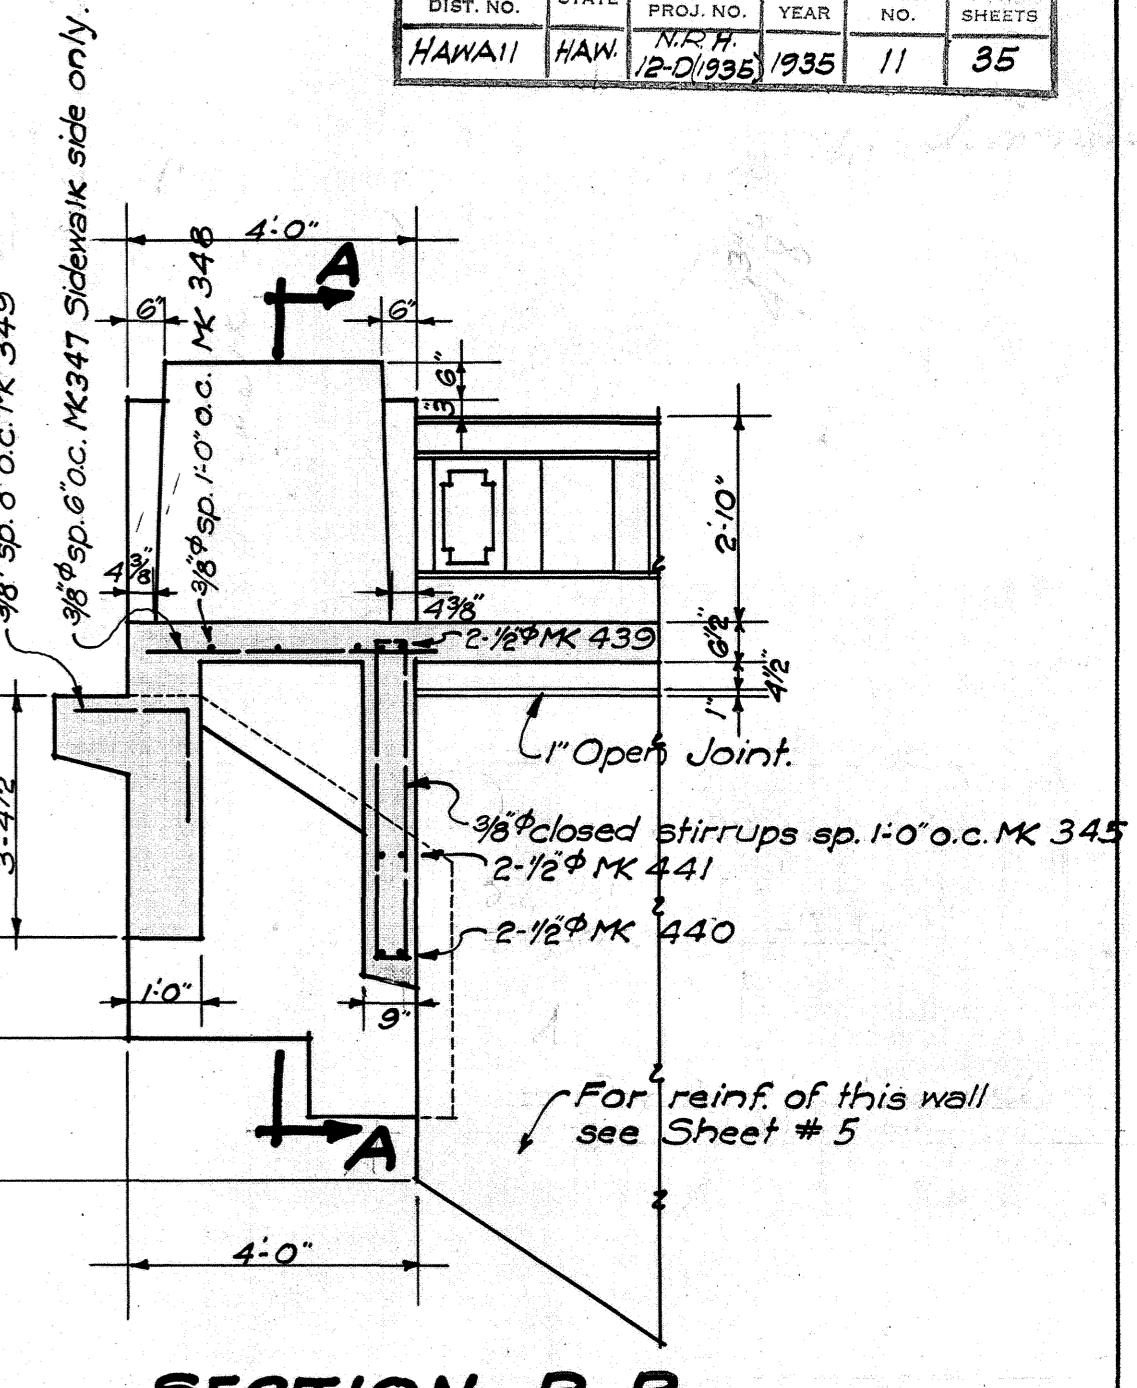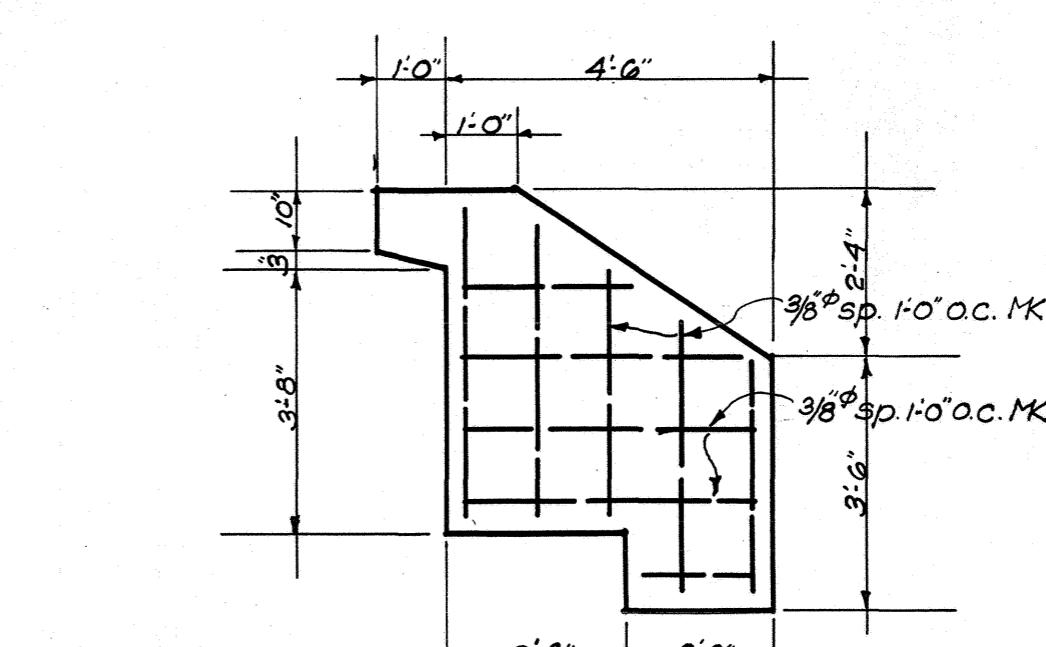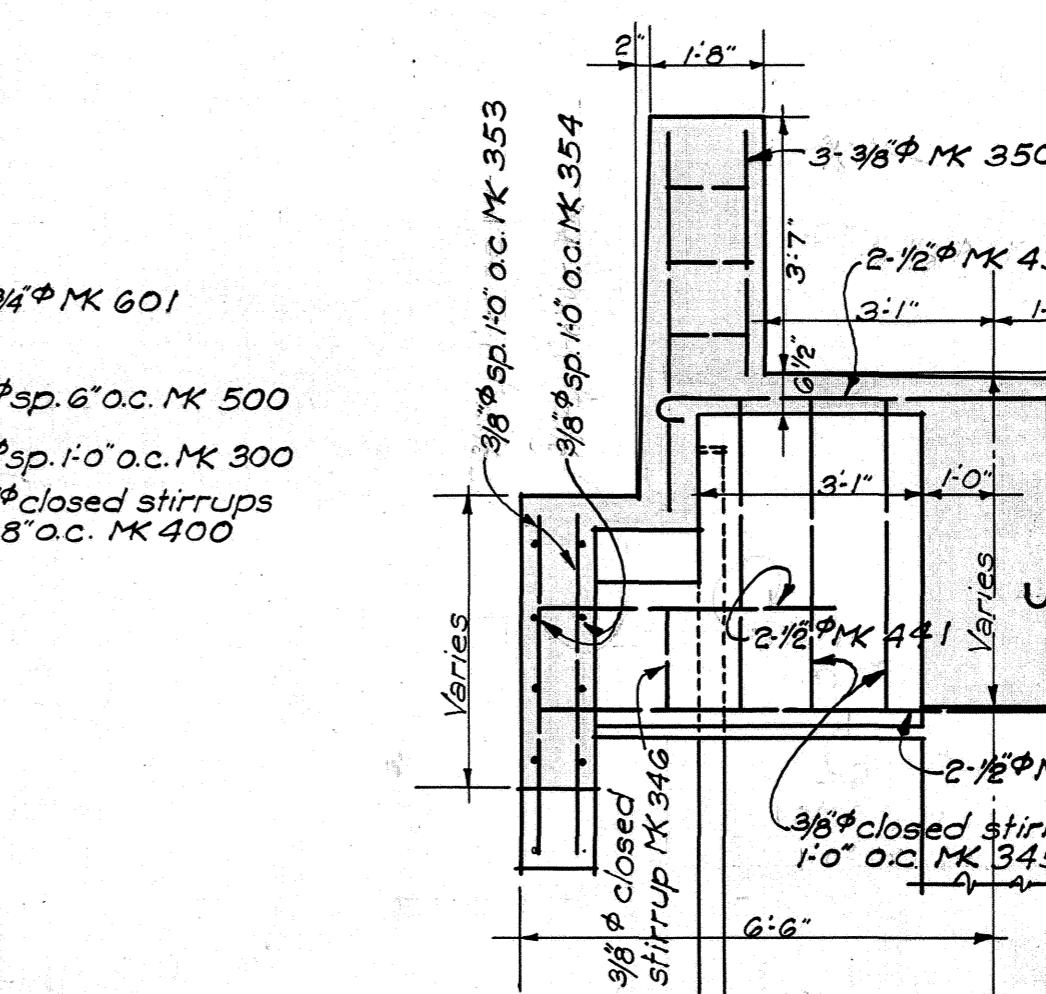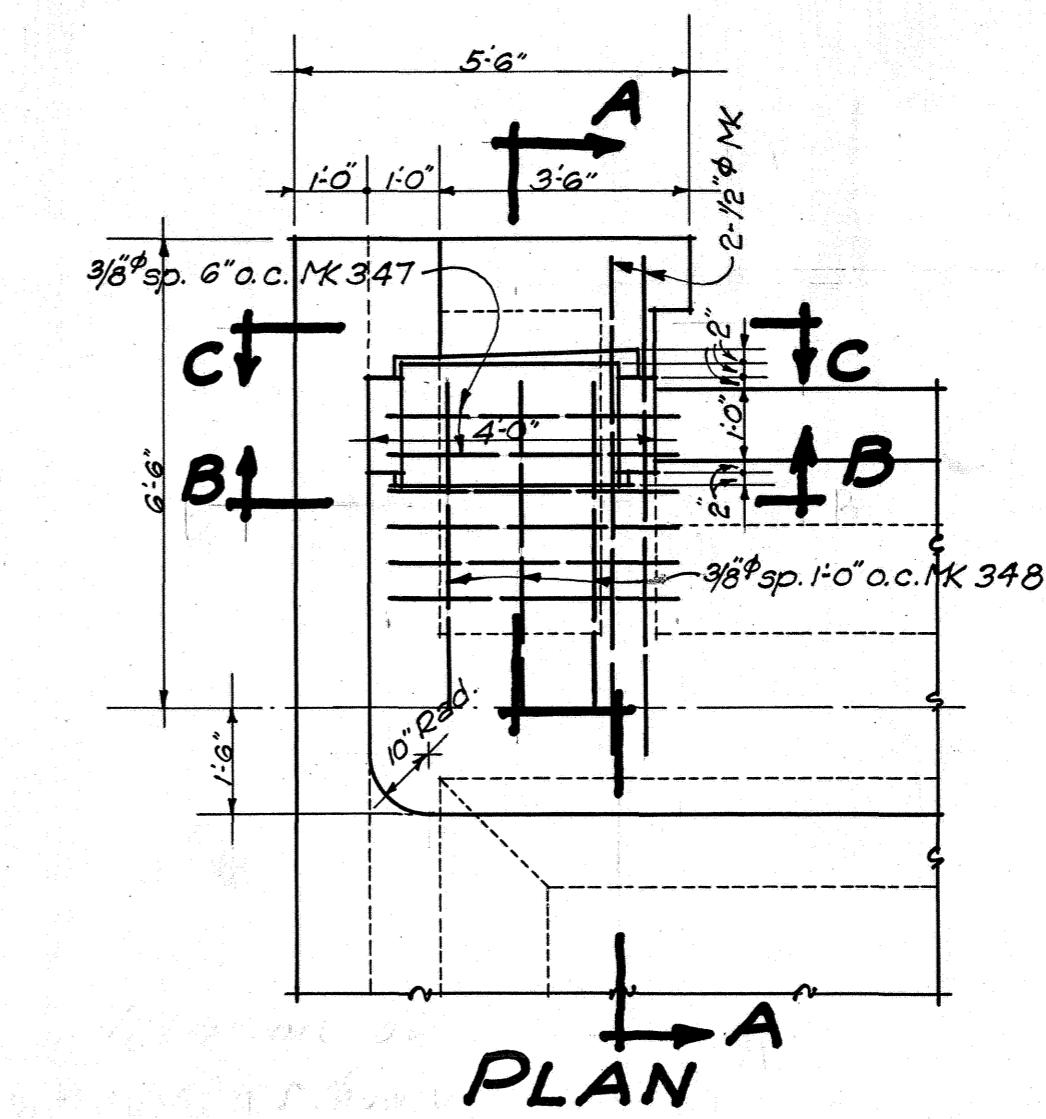
For reinf. of this wall
See Sheet # 5




TERRITORIAL HIGHWAY DEPARTMENT
TERRITORY OF HAWAII.

WAHIWA BRIDGE
NO. 6 STA. 80+74 TO STA. 82+56.
KAUAI BELT ROAD N.R.H. 12-D.
DATE June 1935 SHEET 3 OF 17 SHEETS.

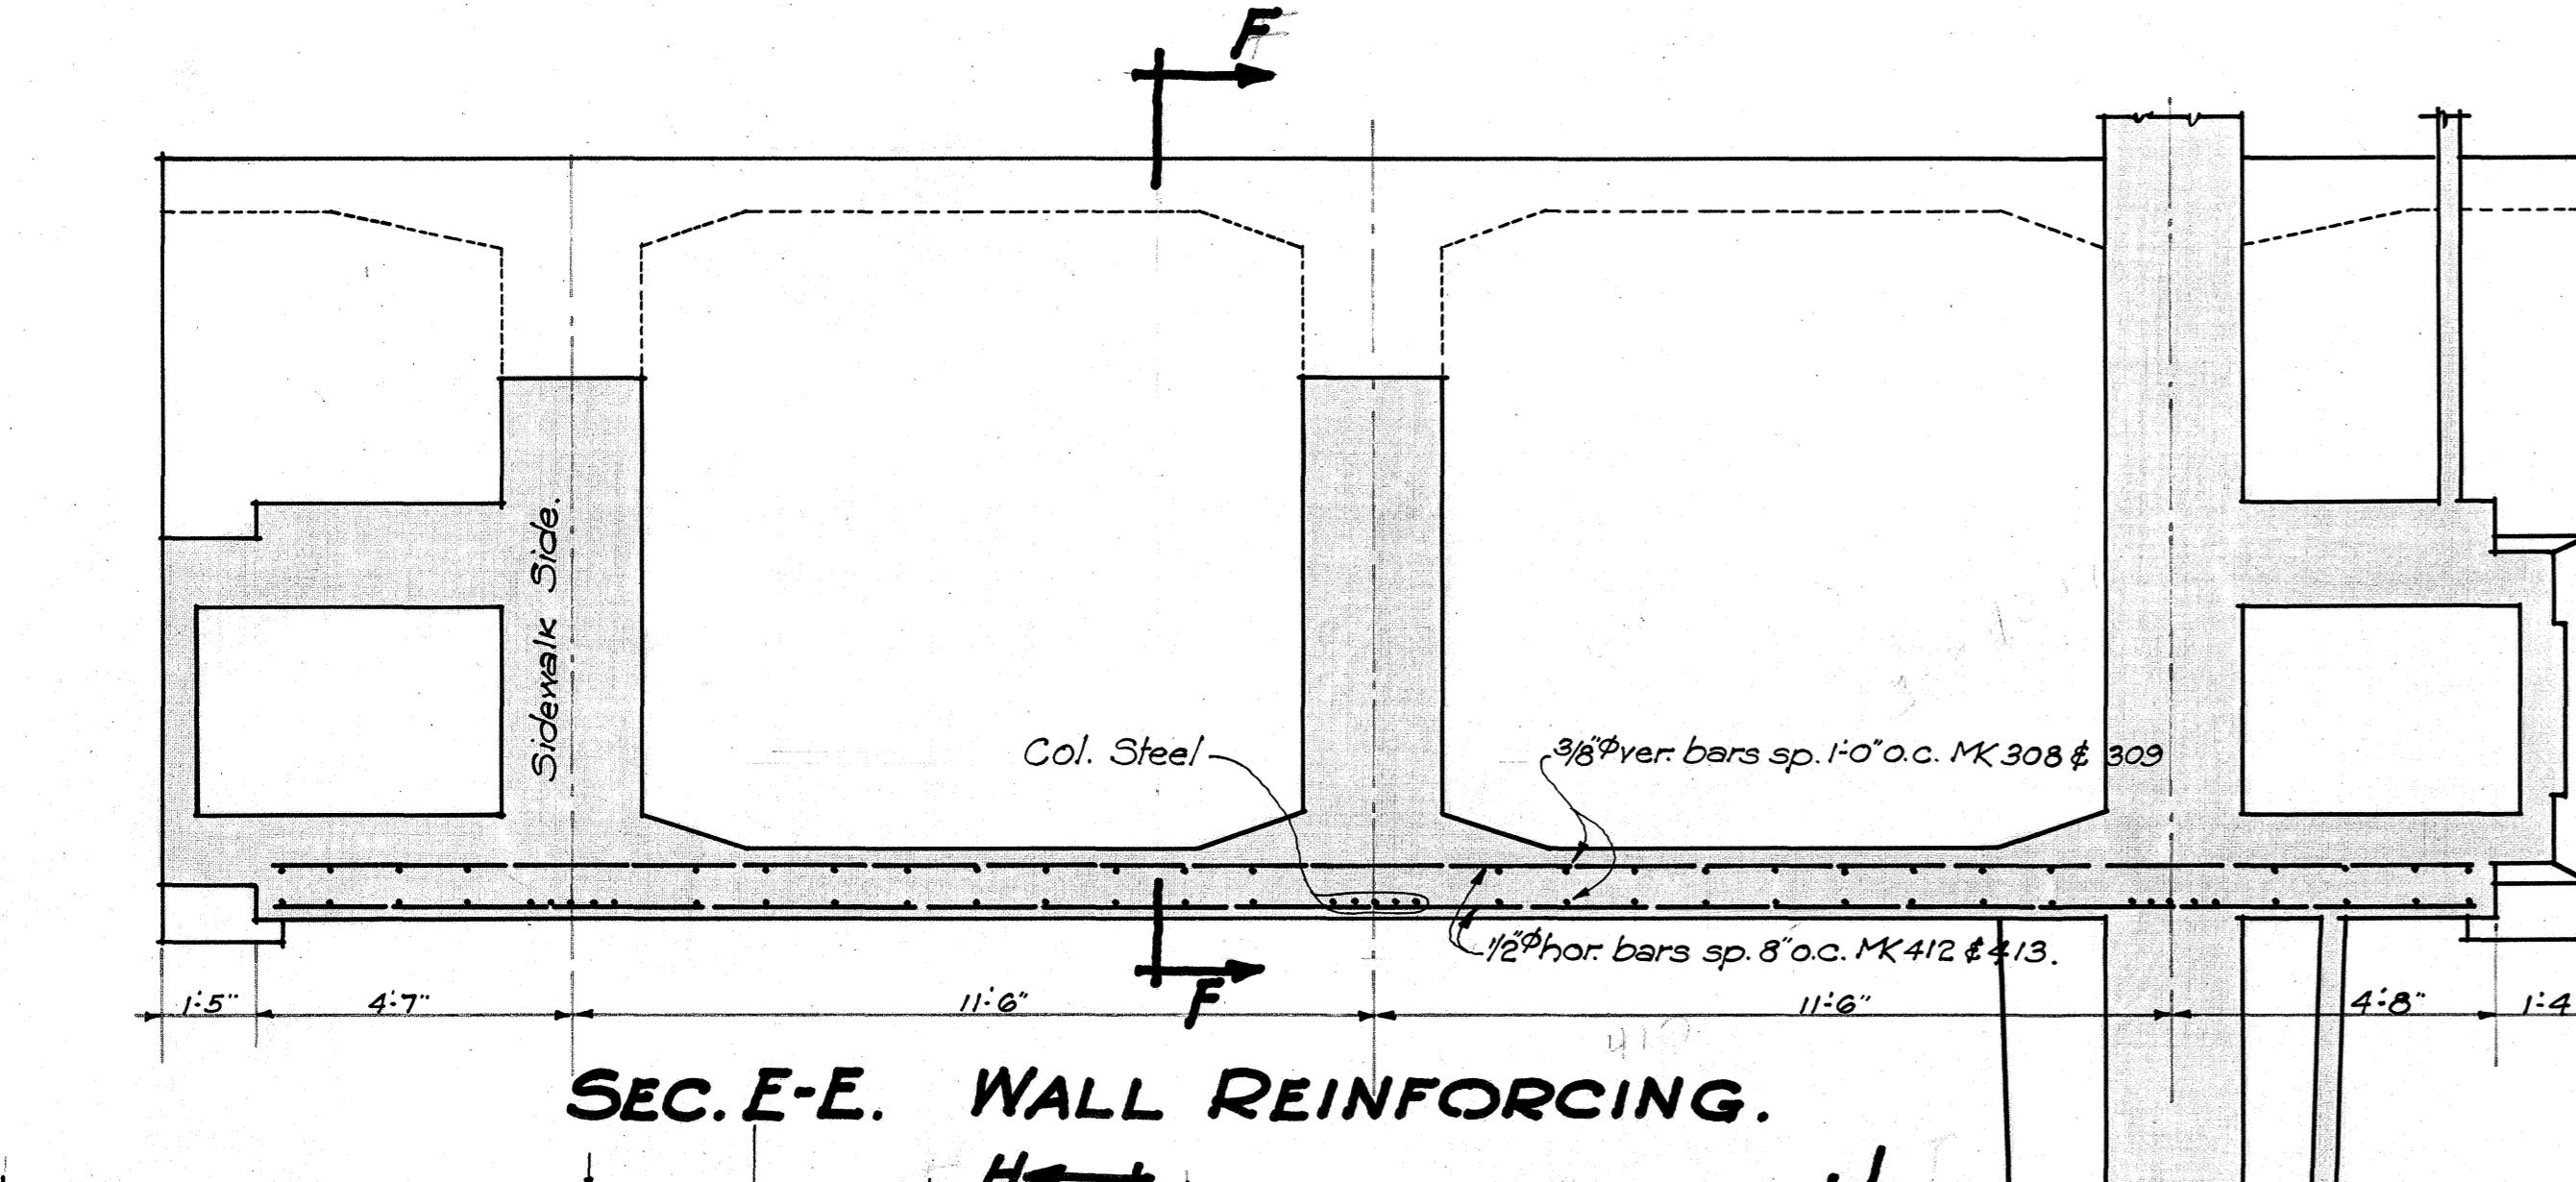
4333.11




SEC. E-E. WALL REINFORCING

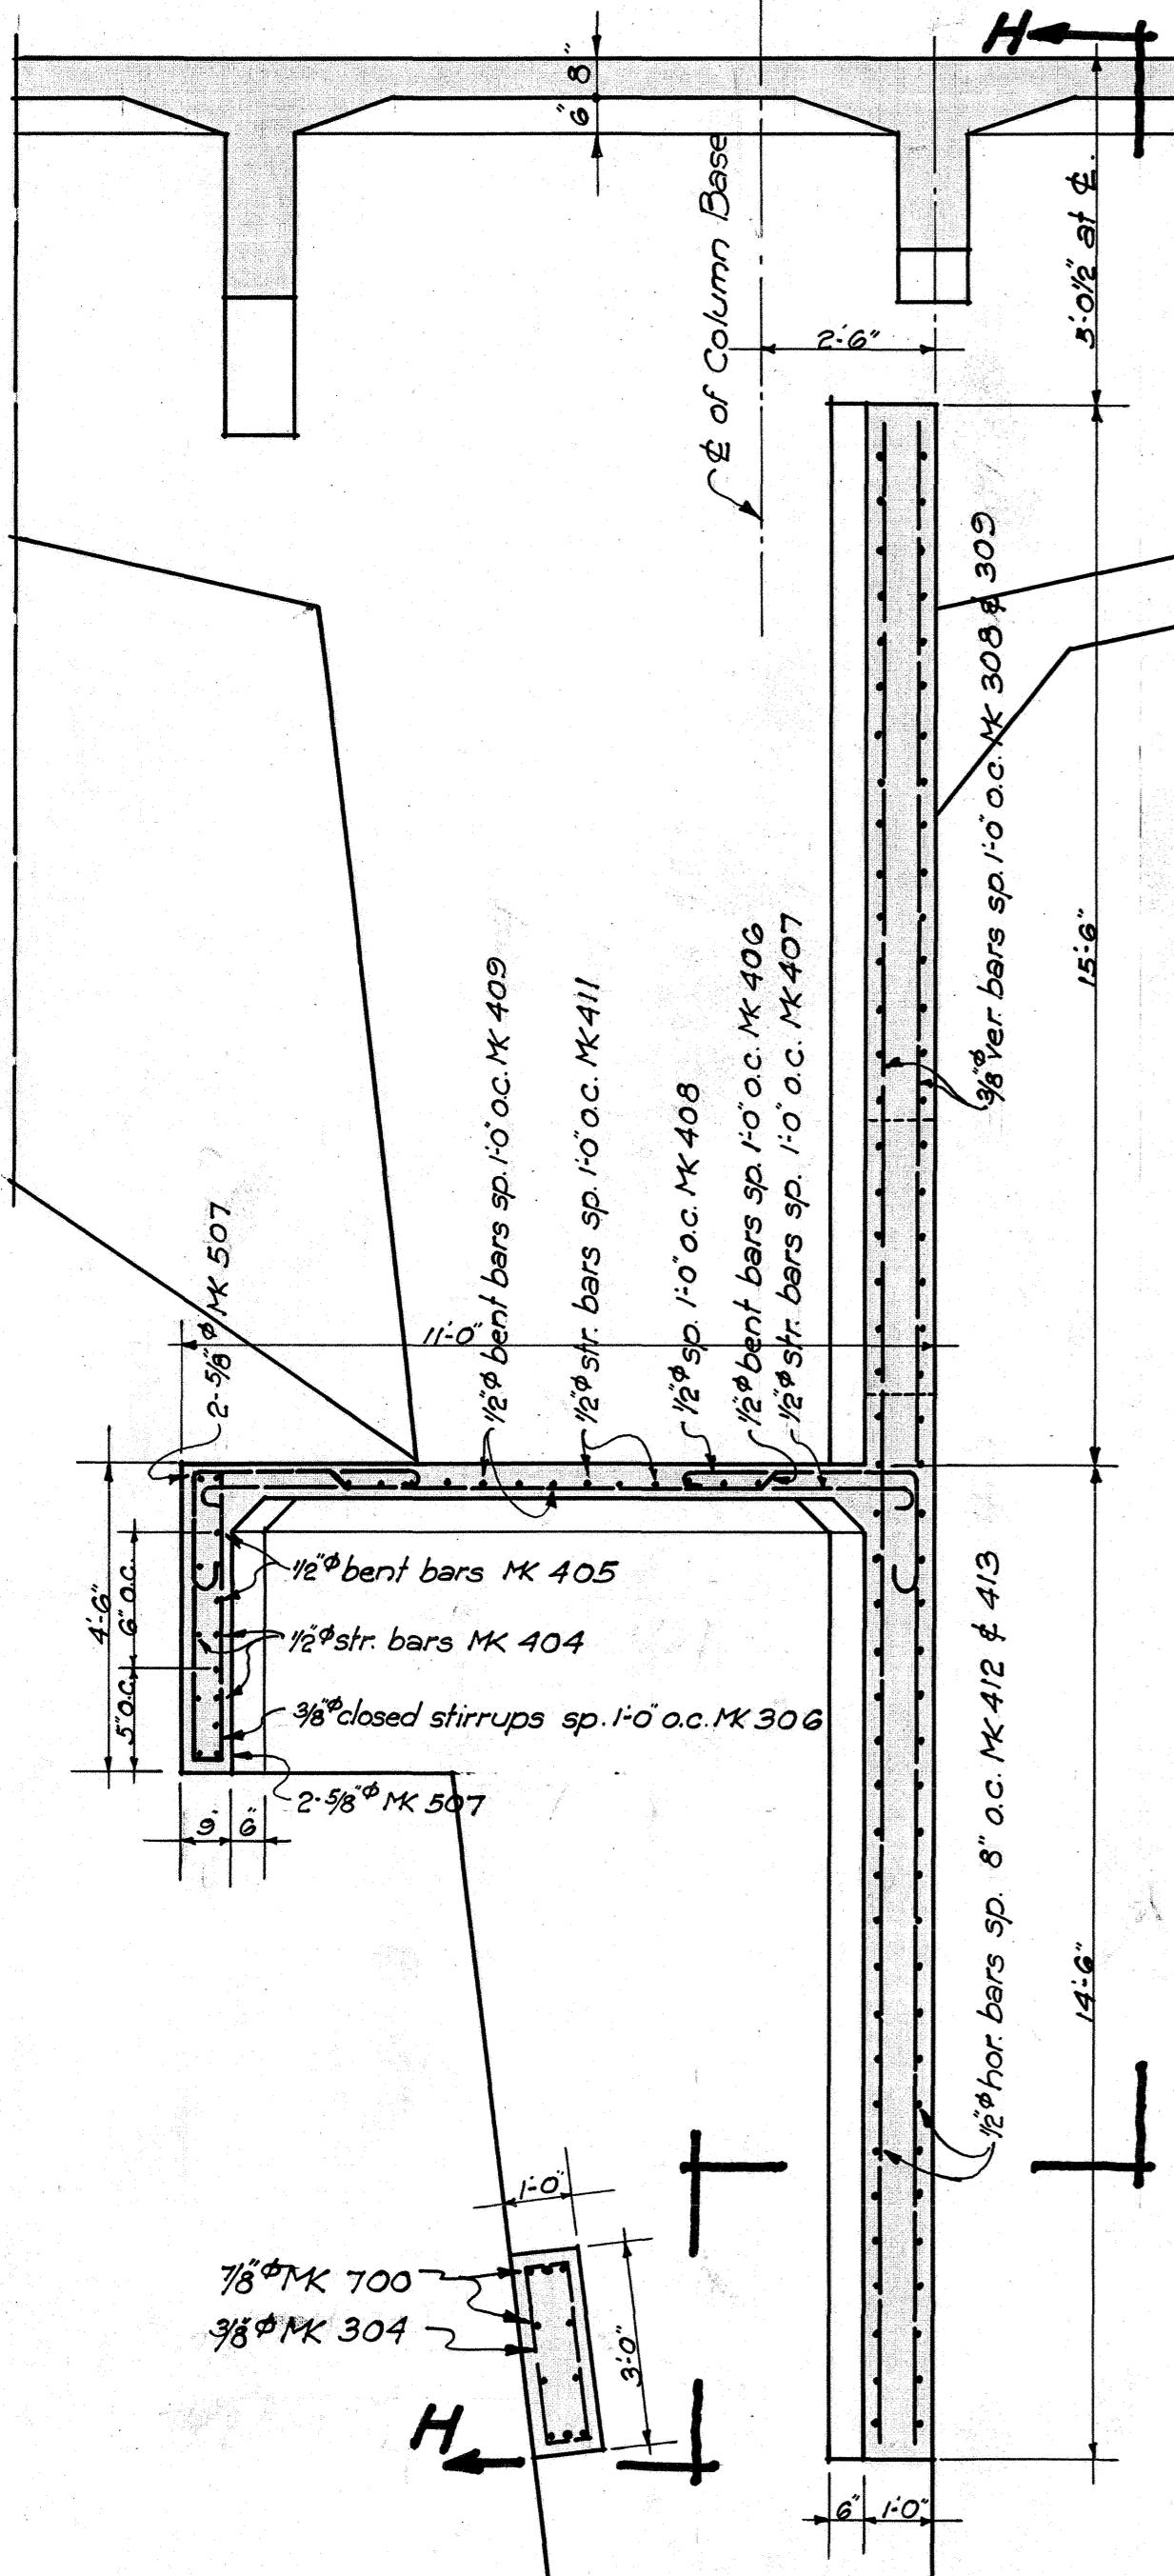

SEC. F-F.

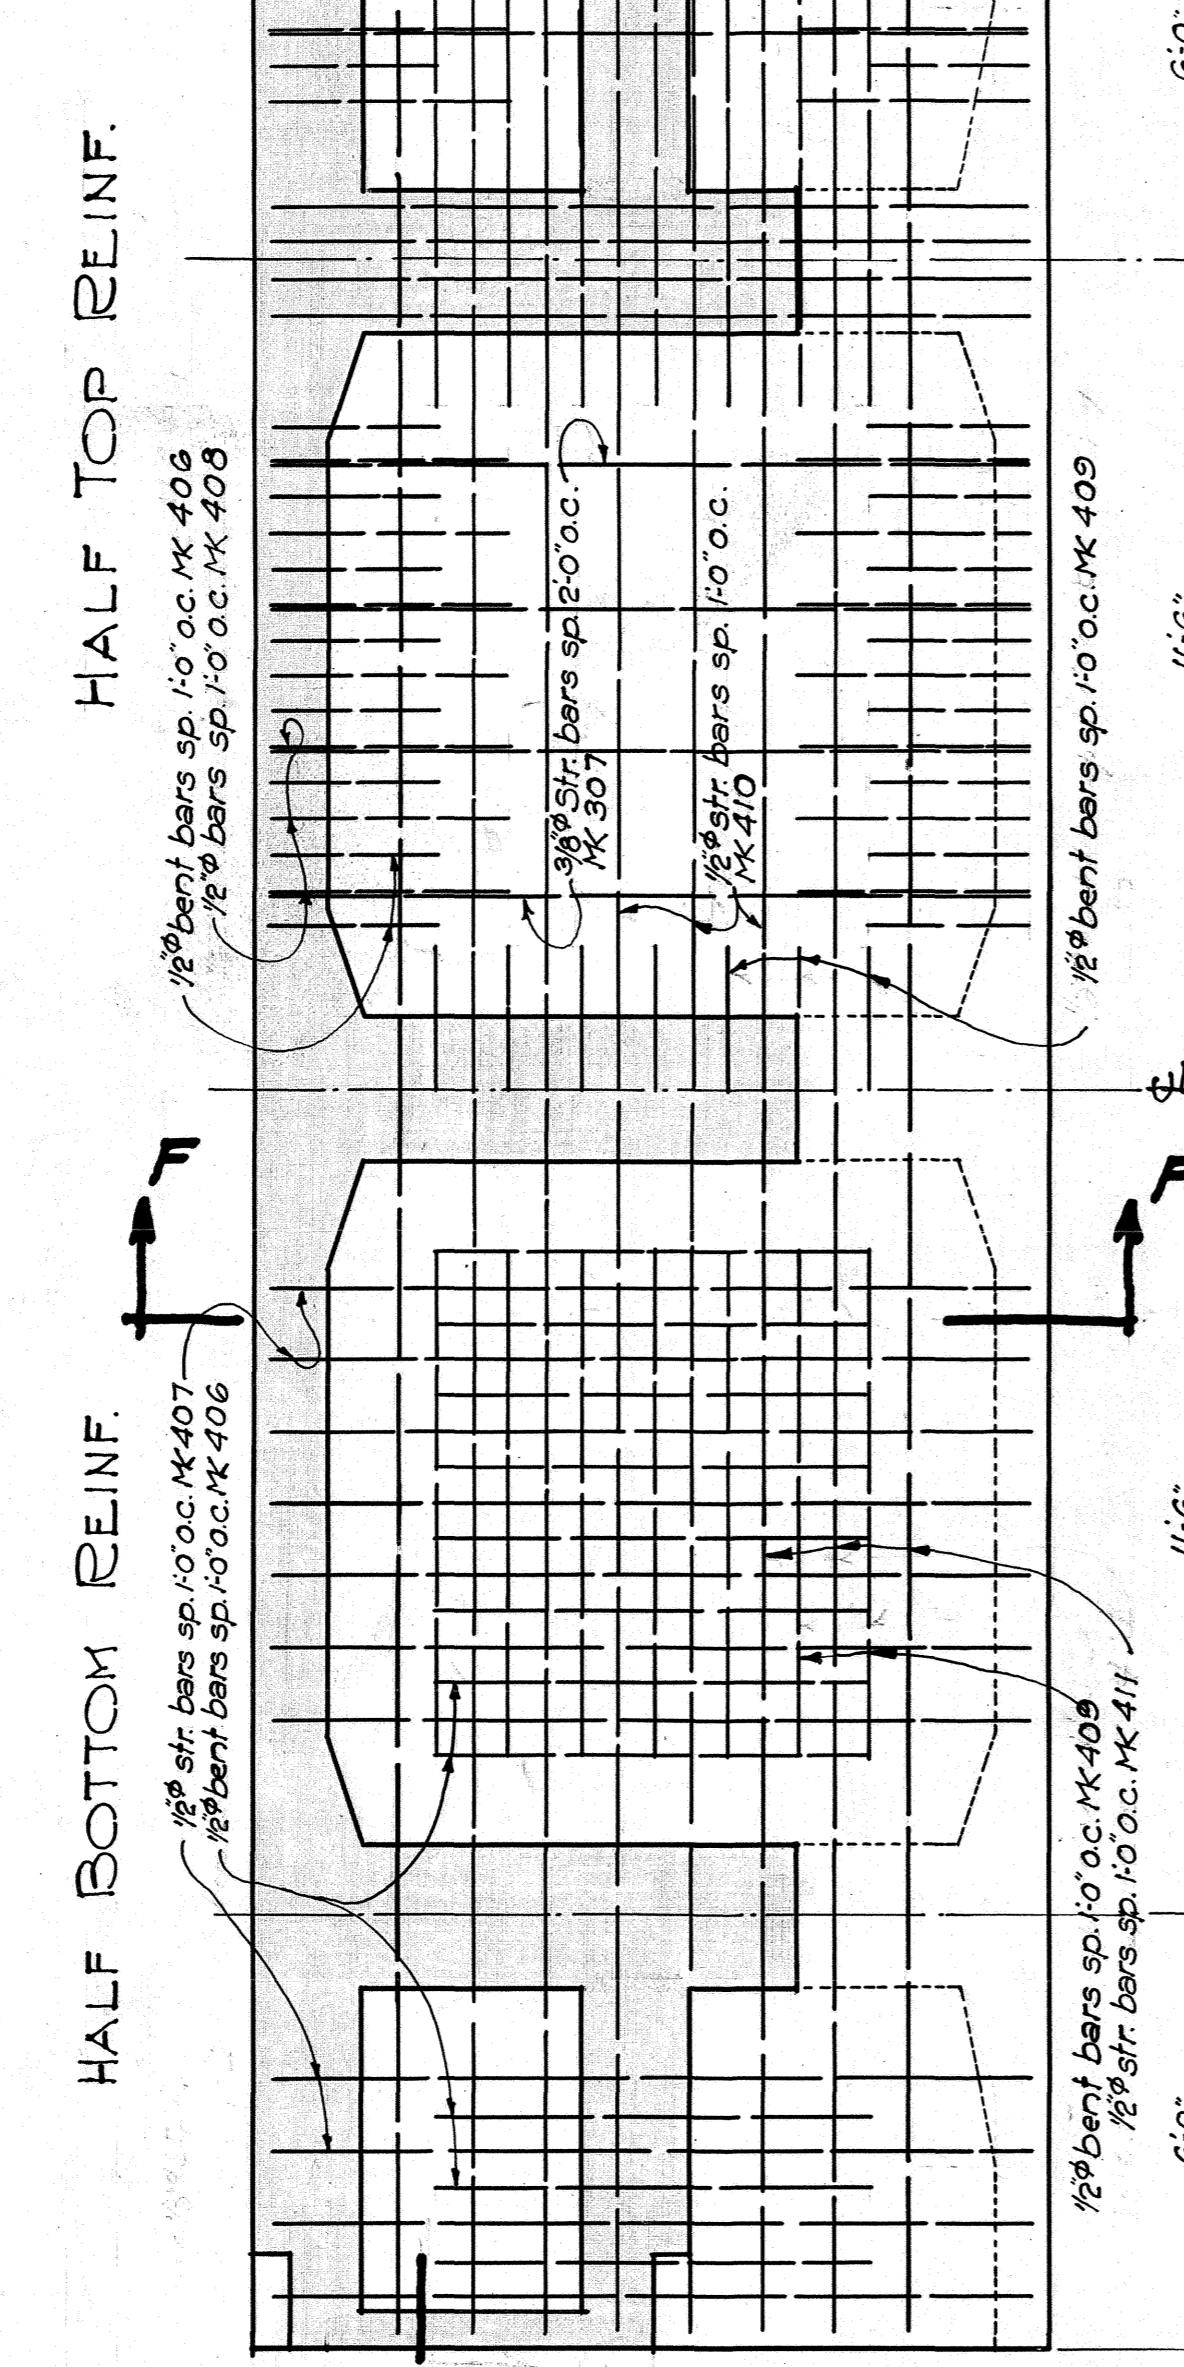

SEC. G-C

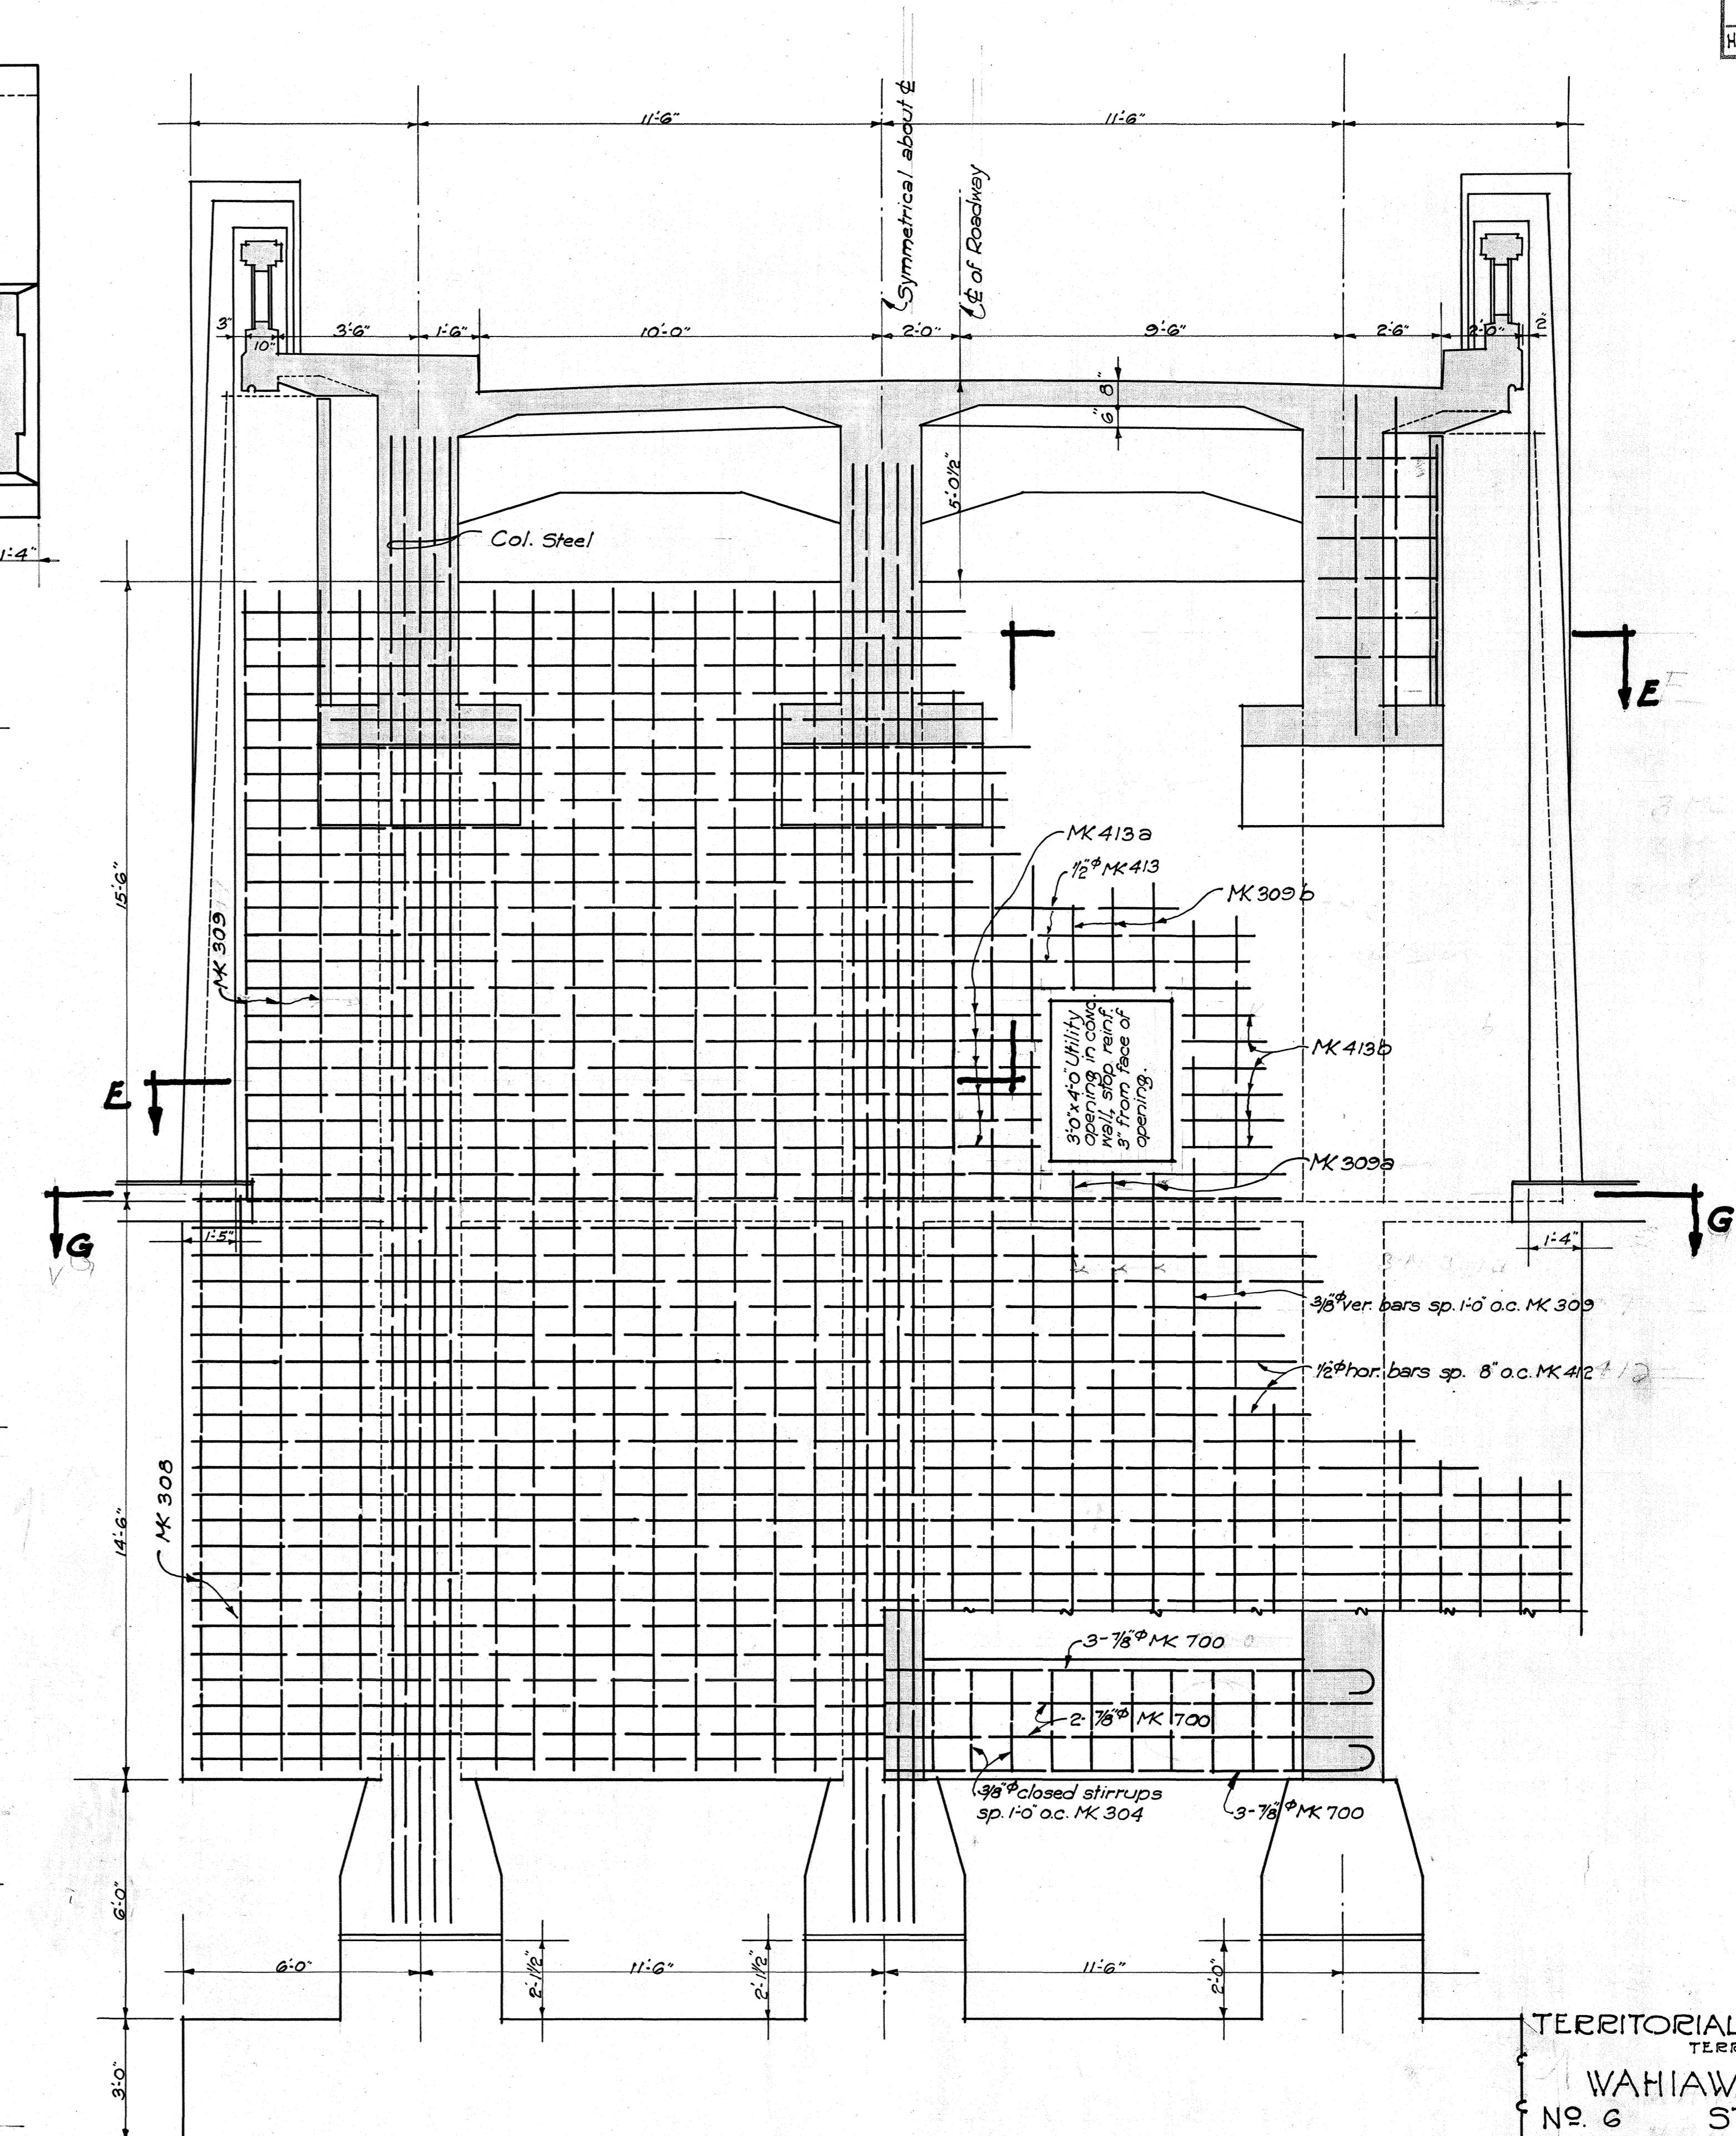


SEC. H-H. WALL REINFORCING.

TERRITORIAL HIGHWAY DEPARTMENT
TERRITORY OF HAWAII.
WAHIAWA BRIDGE.
NO. 6 STA. 80+74. TO STA. 82+56.
KAUAI BELT ROAD N.R.H. 12-D.
DATE June 1935 SHEET 14 OF 17 SHEETS.


19921

FED. ROAD DIST. NO.	STATE	FED. AID PROJ. NO.	FISCAL YEAR	SHEET NO.	TOTAL SHEETS
HAWAII	HAN	N.R.H. 12-D	1935	13	35

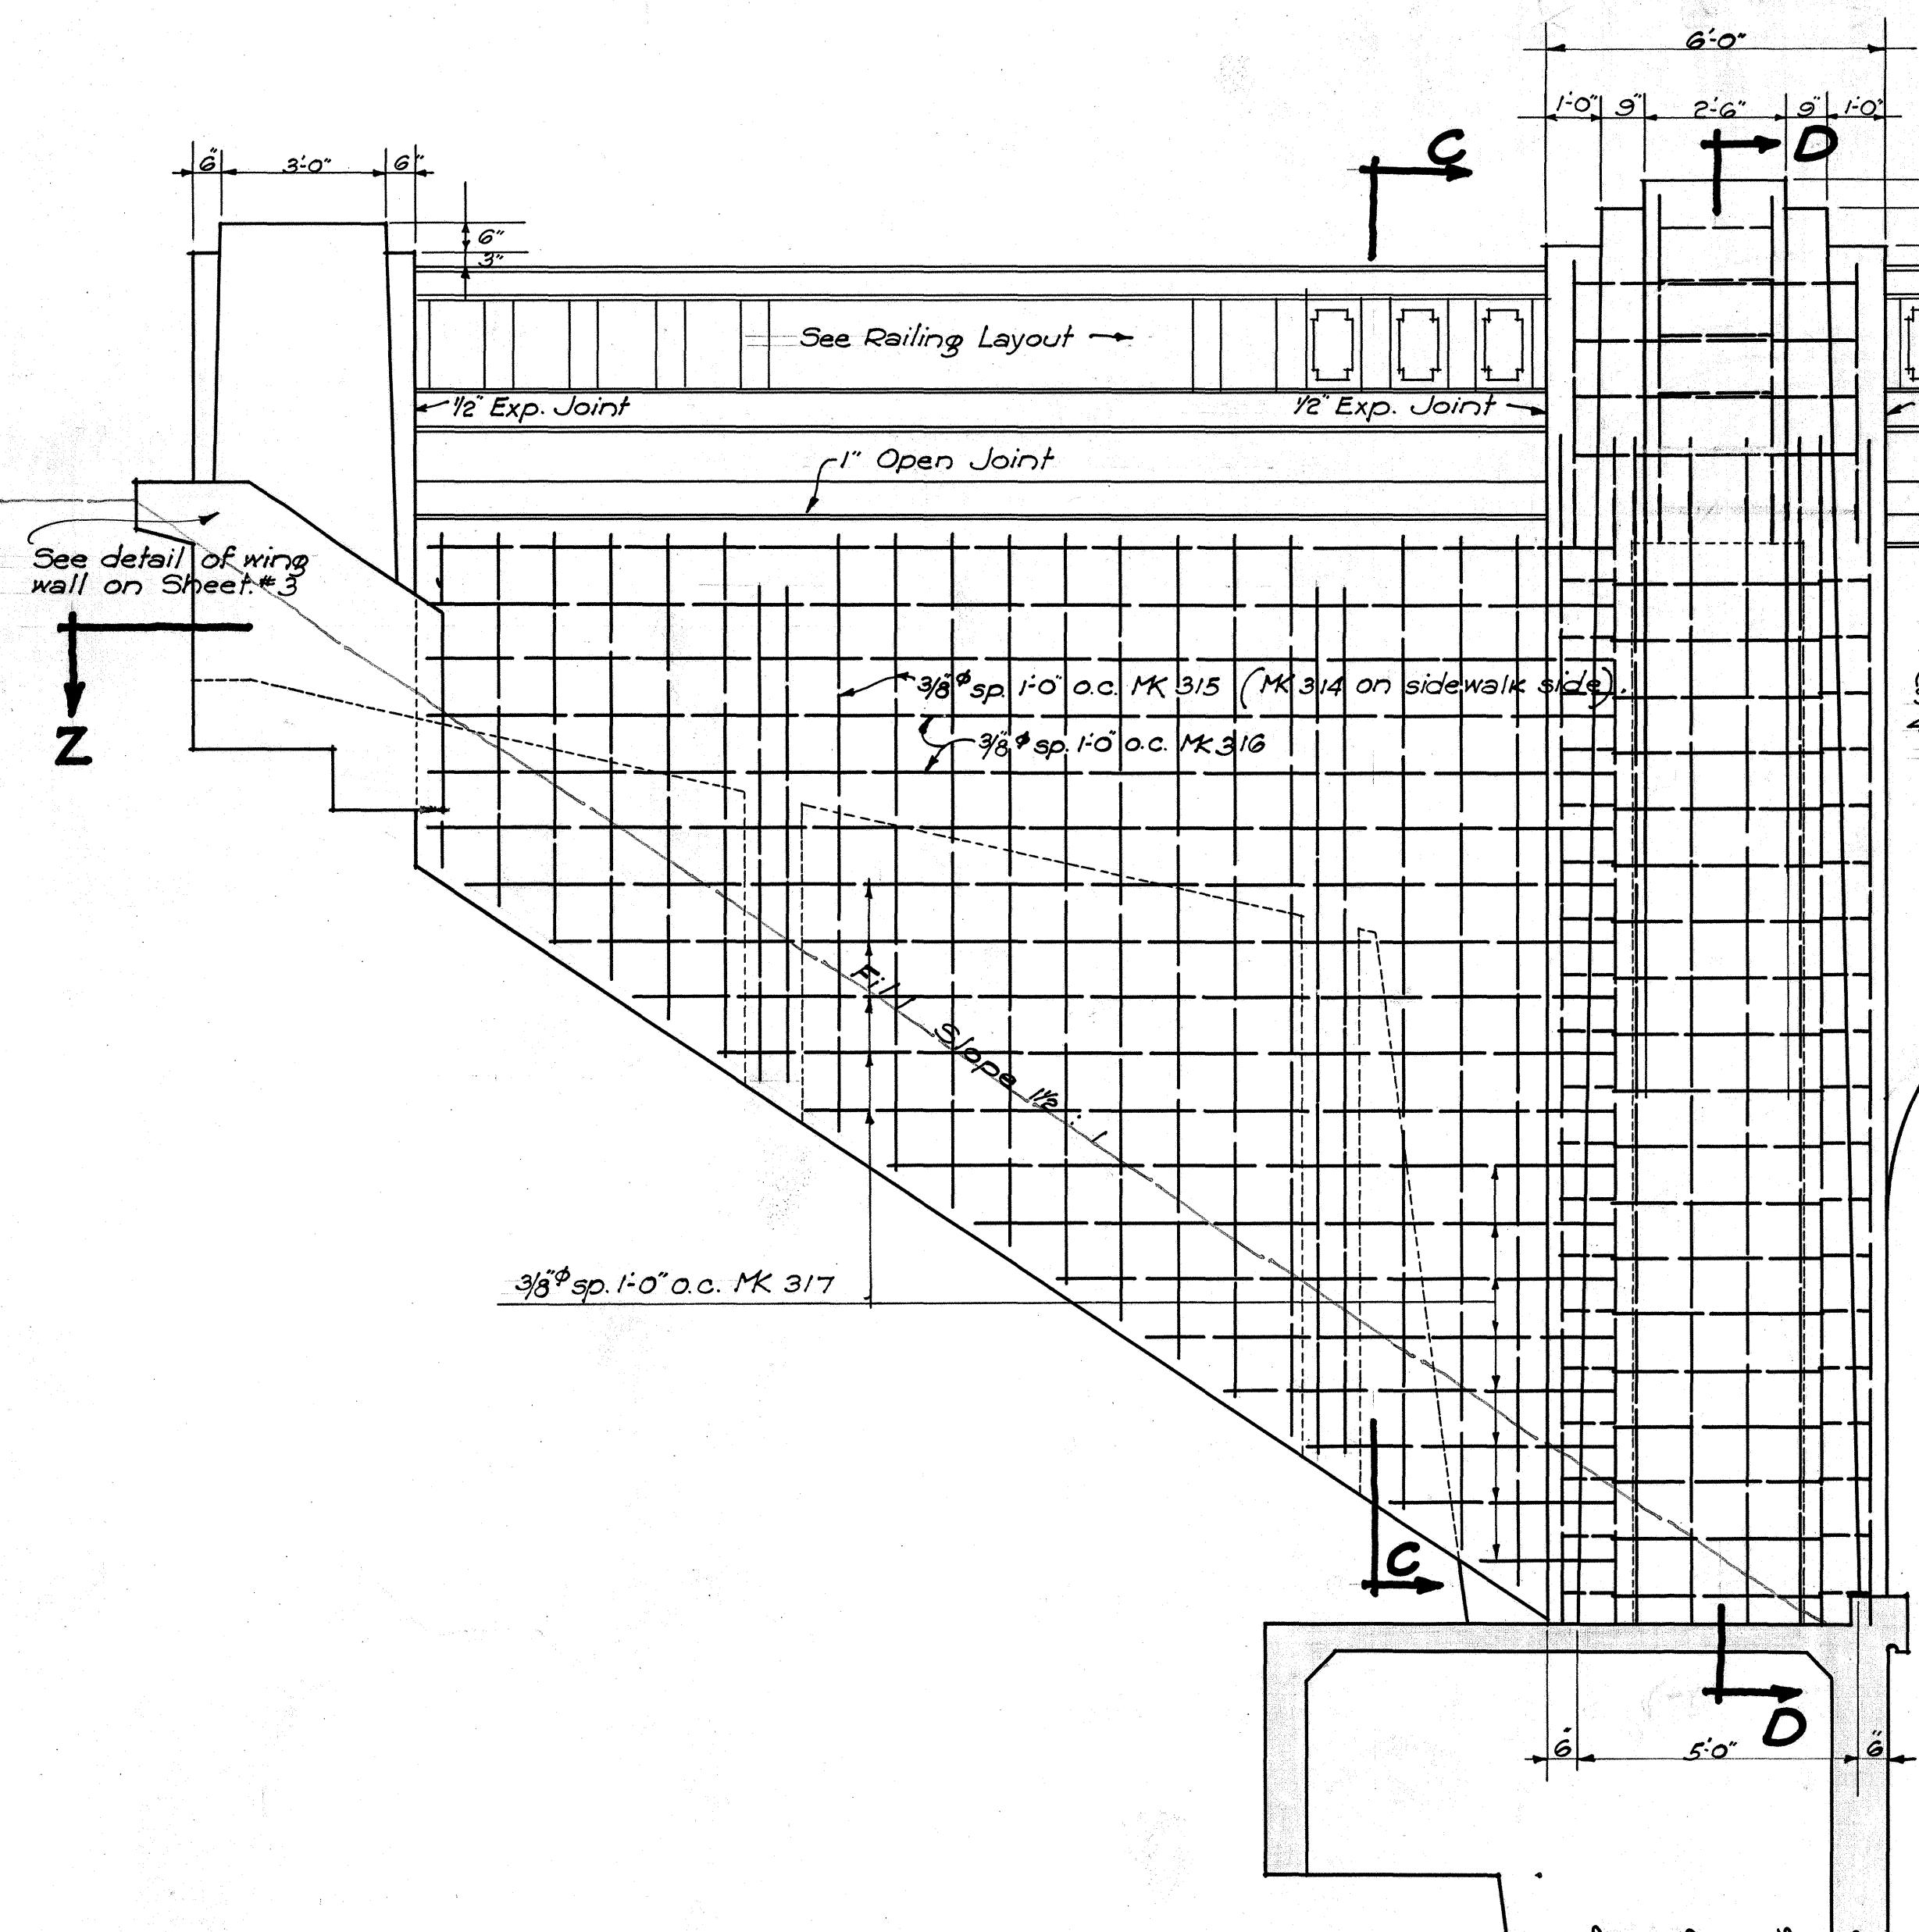

END CURTAIN WALL REINF.

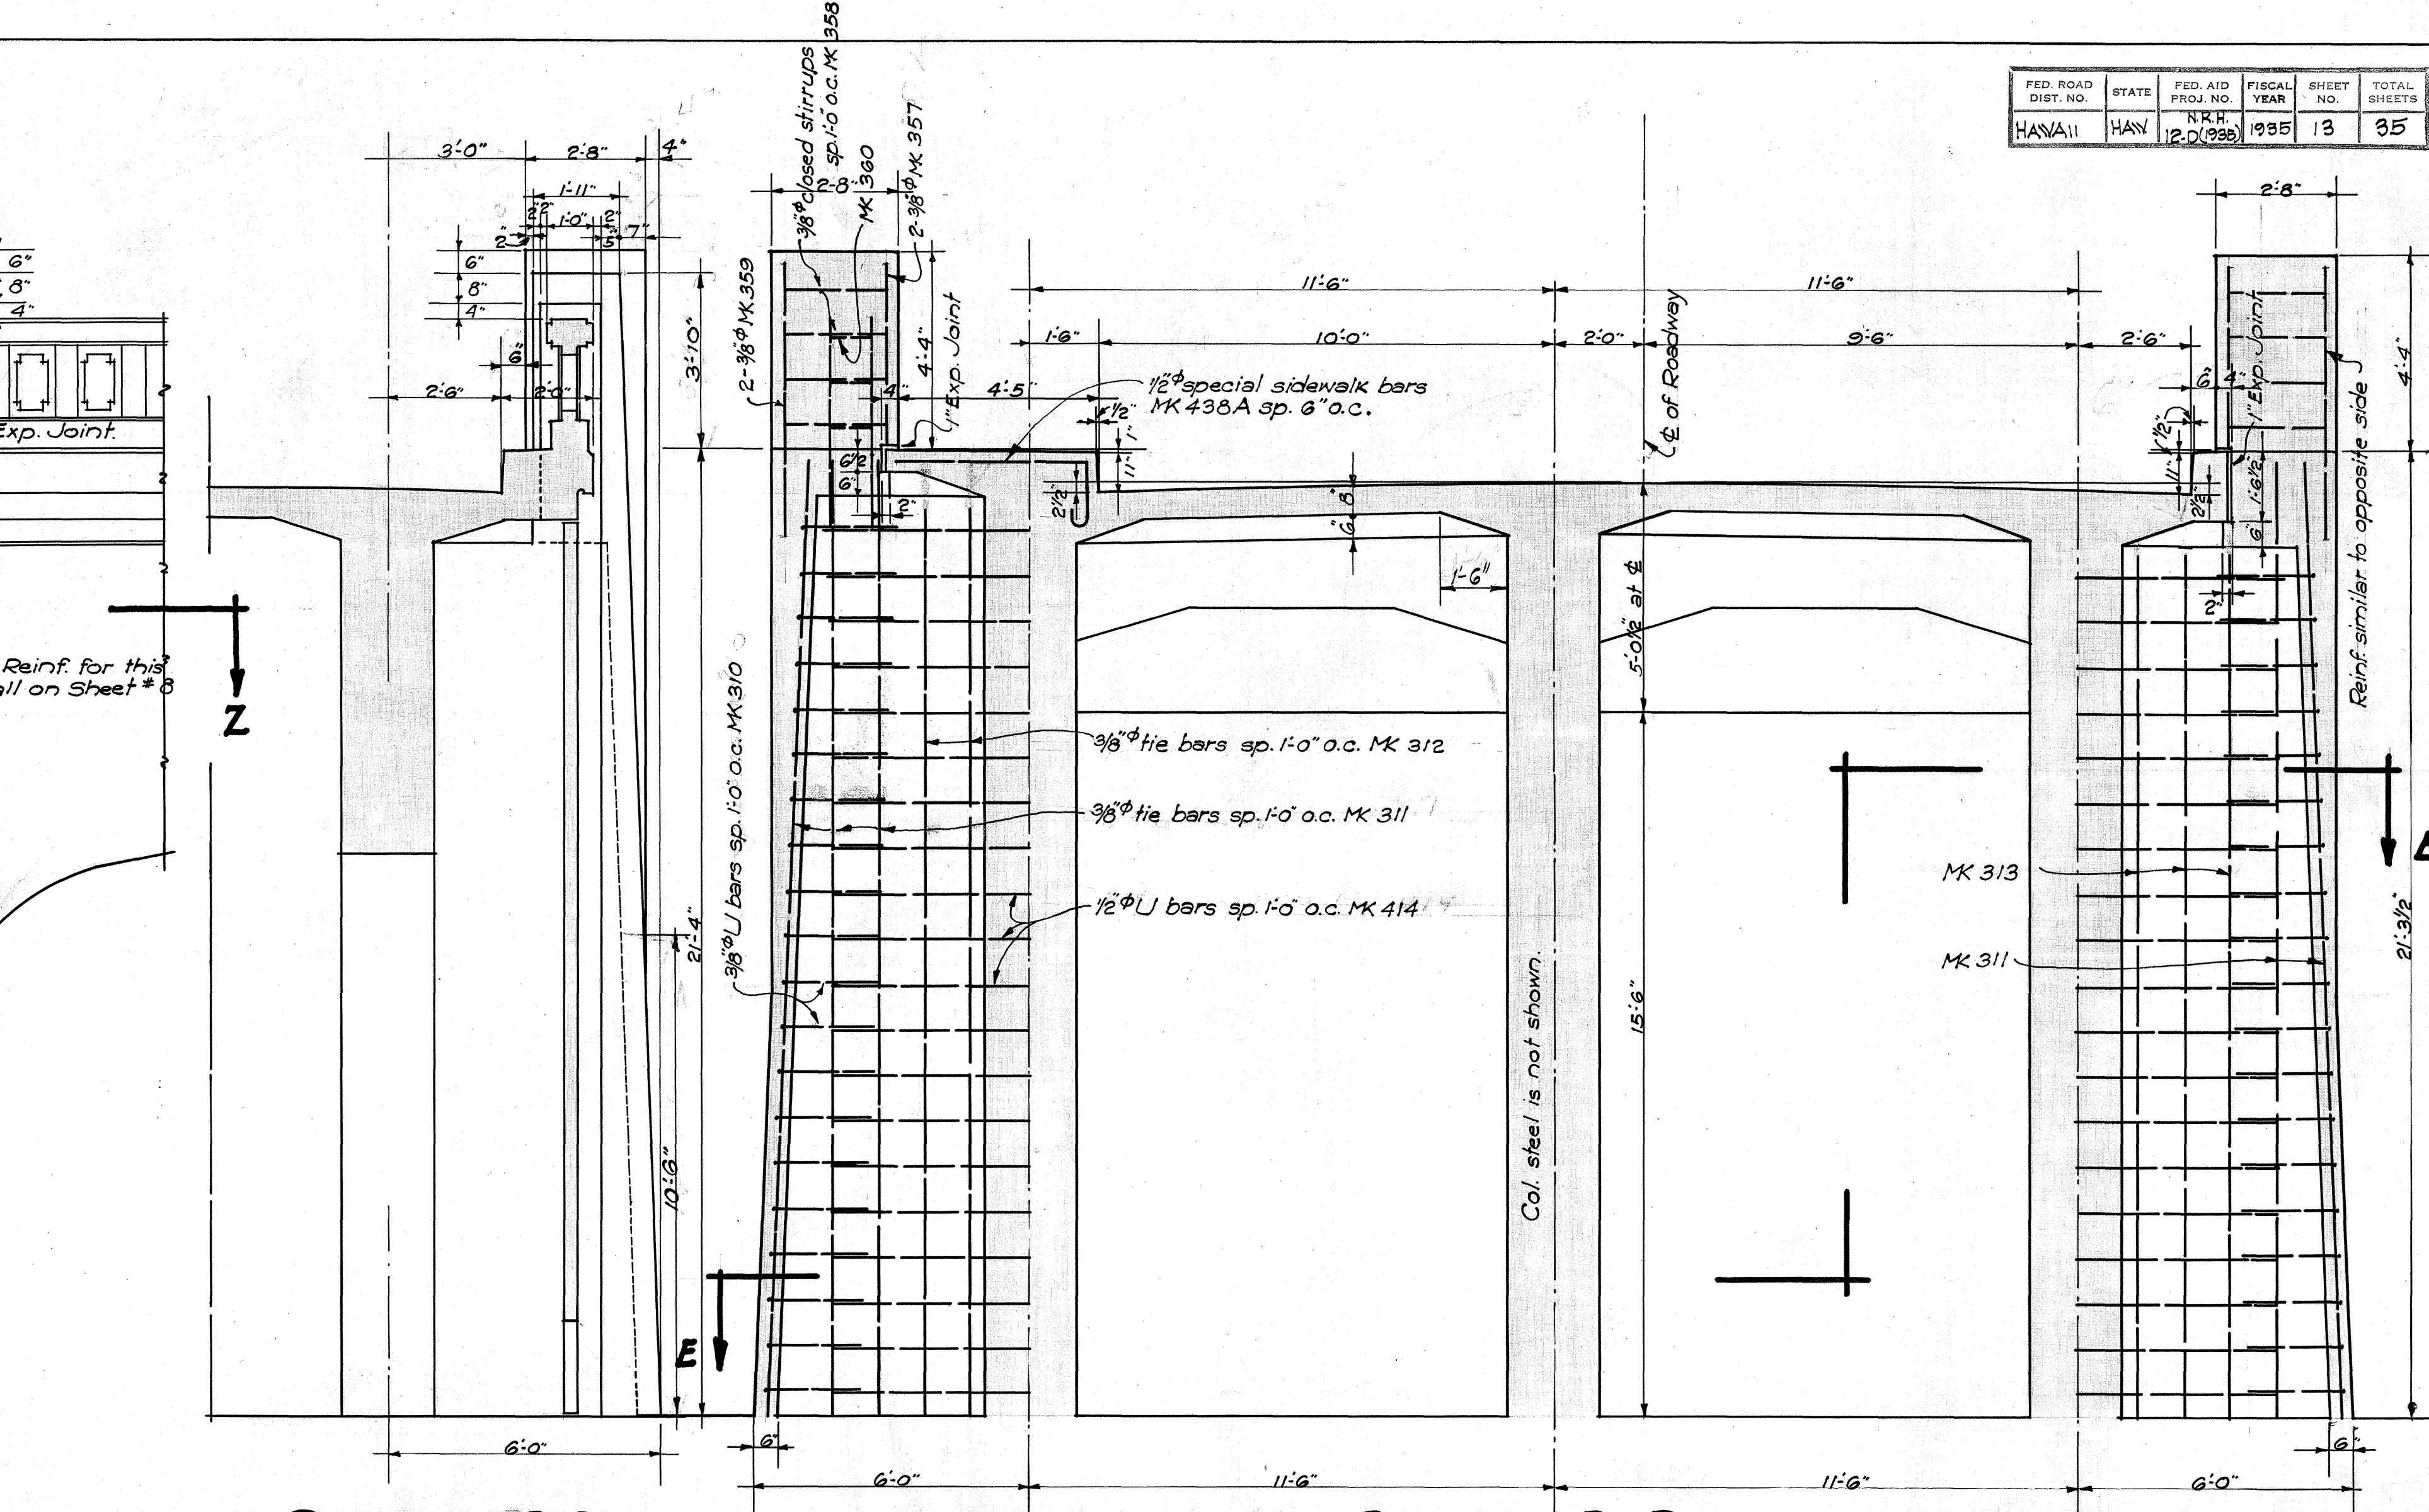
3/8" Scale.




SECTION C-C.

SECTION D-D.

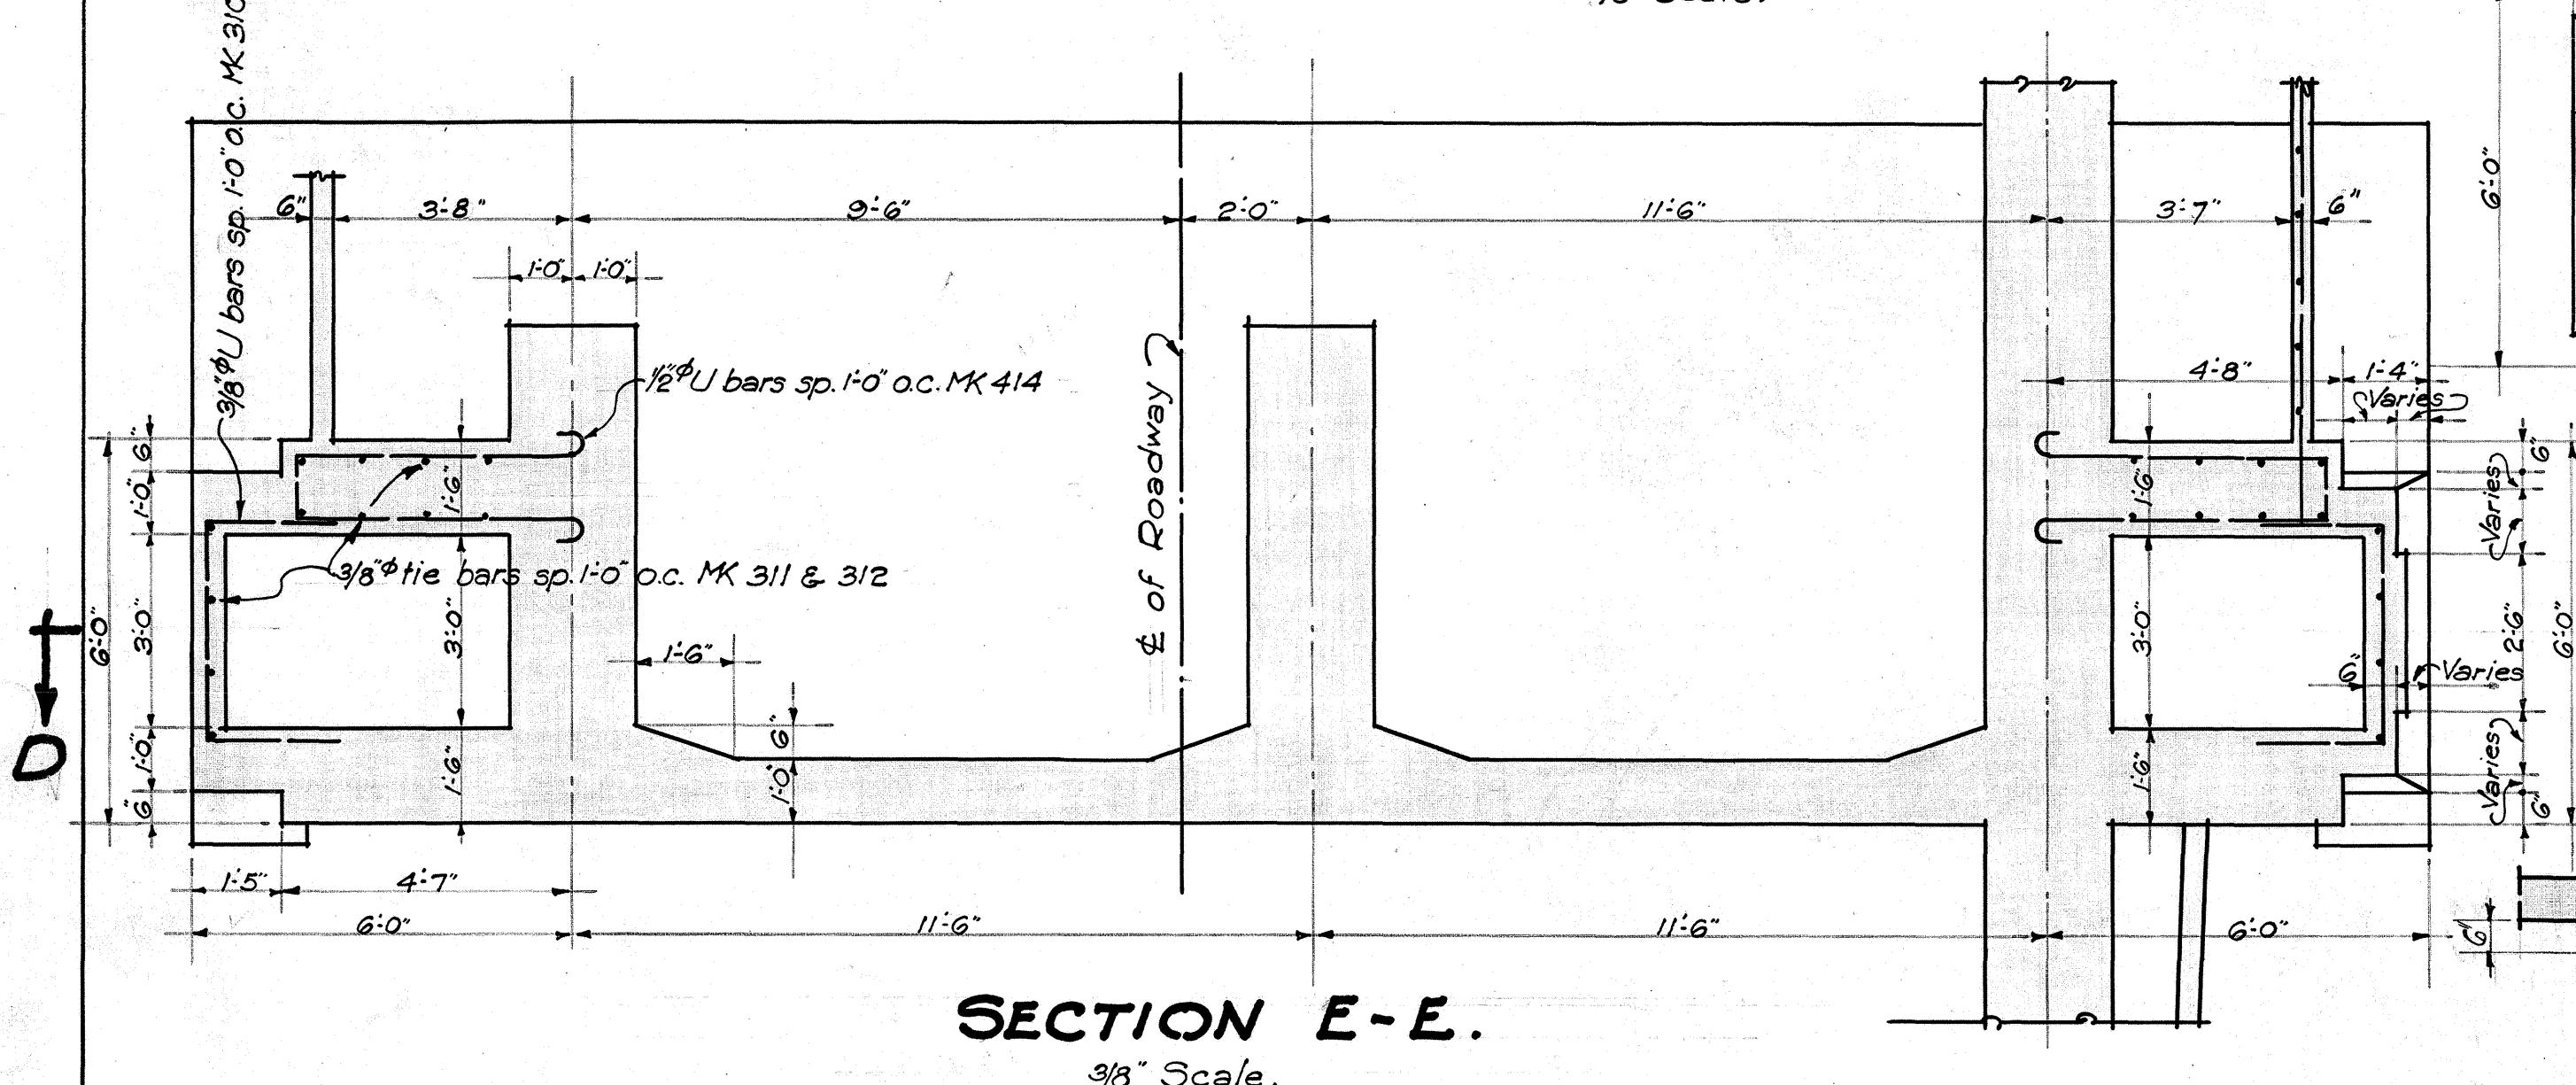
3/8" Scale.



DETAIL PLAN OF INTERMEDIATE PIER

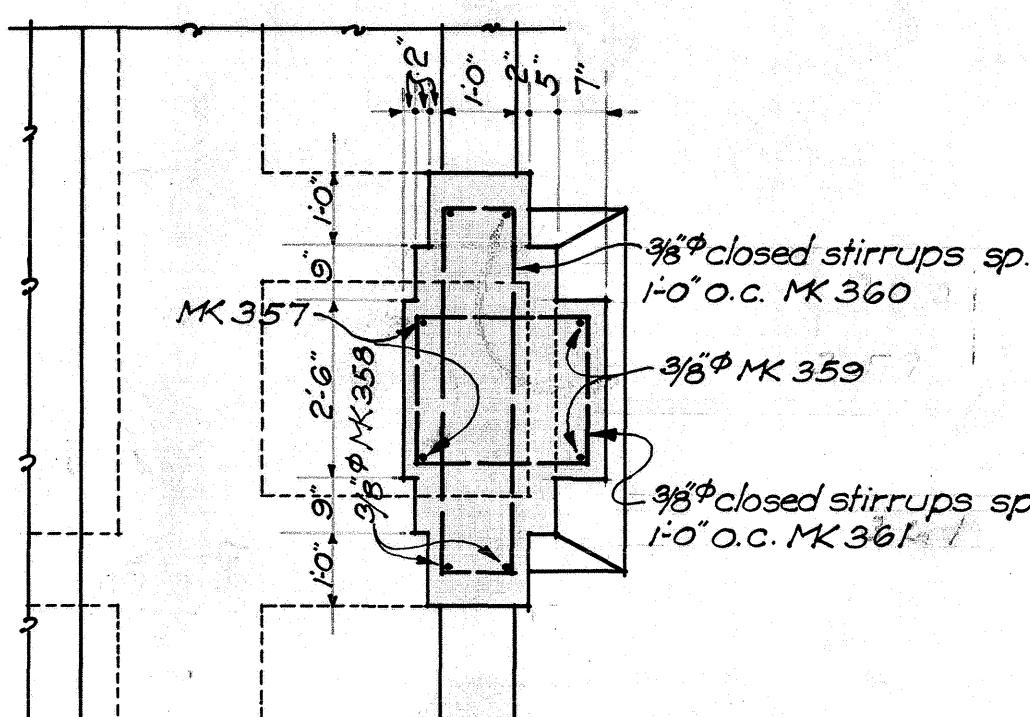


RAILING POST REINF.

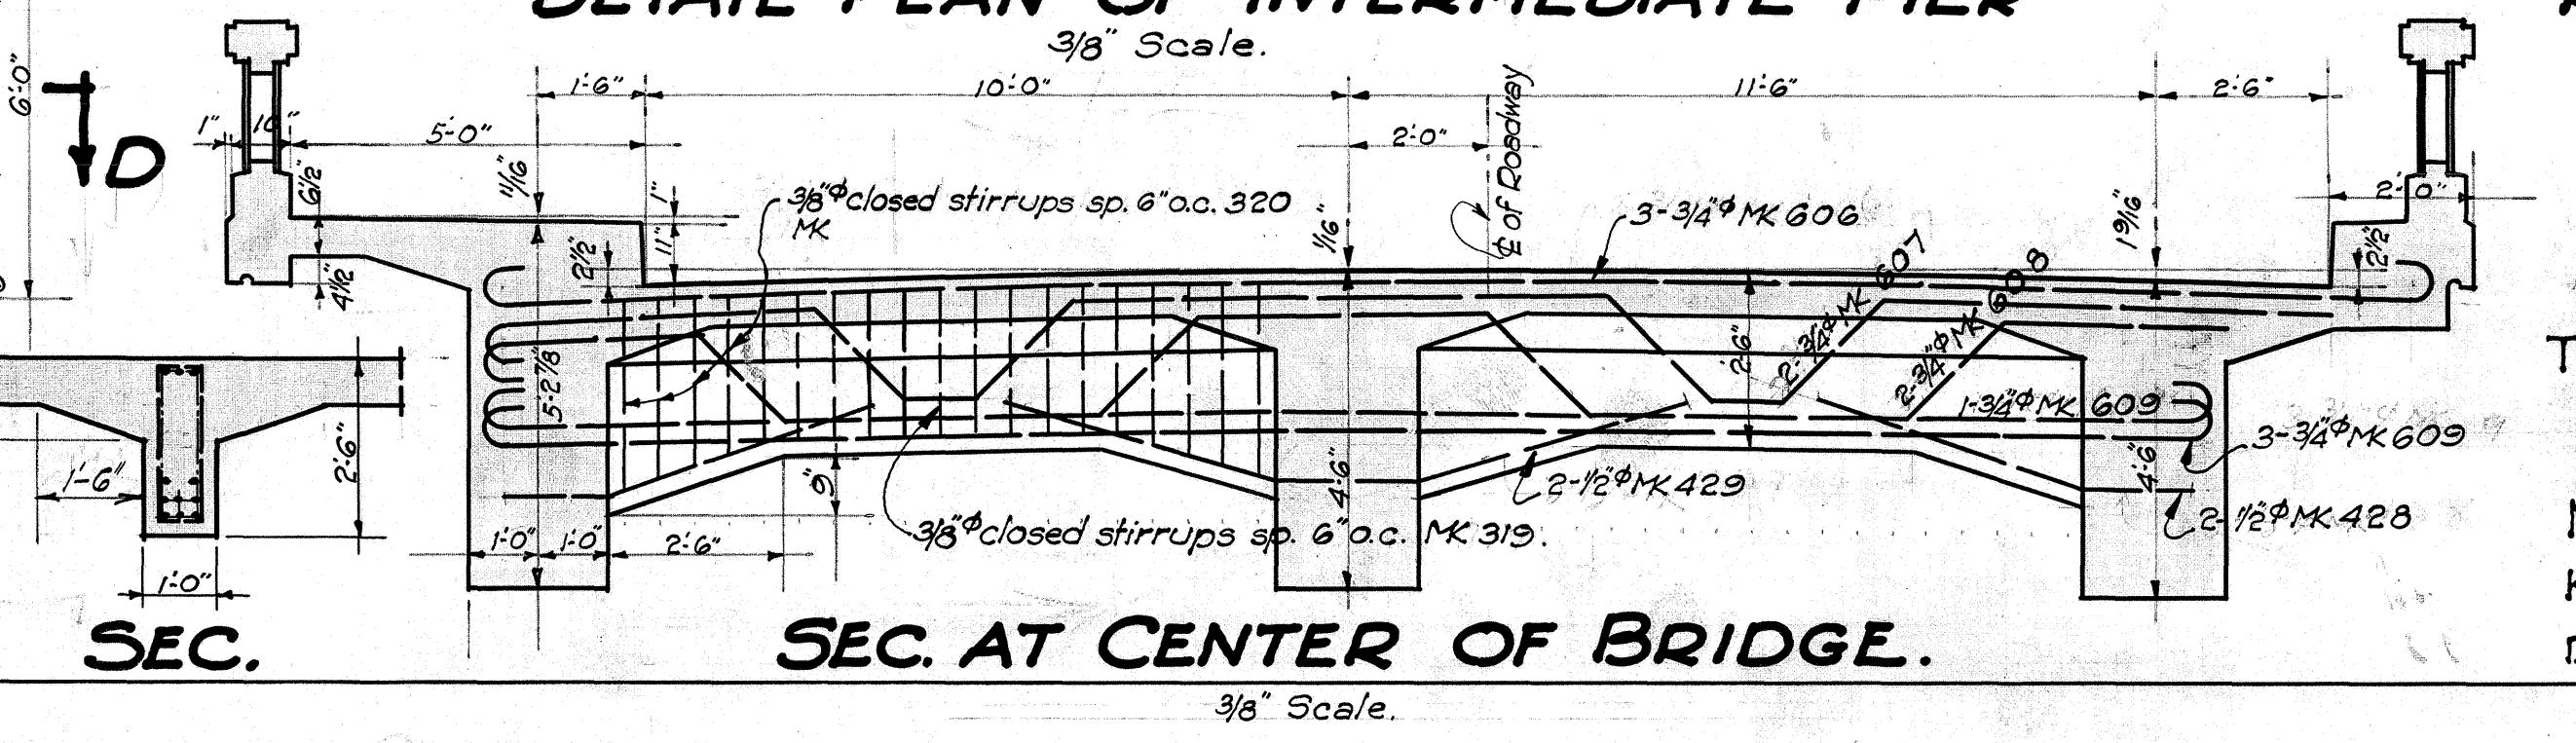


TERRITORIAL HIGHWAY DEPARTMENT
TERITORY OF HAWAII.
WAHIWAHA BRIDGE
NO. 6 STA. 80+74. TO STA. 82+56.
KAUAI BELT ROAD N.R.H. 12-D.
DATE June 1935 SHEET 5 OF 17 SHEETS.

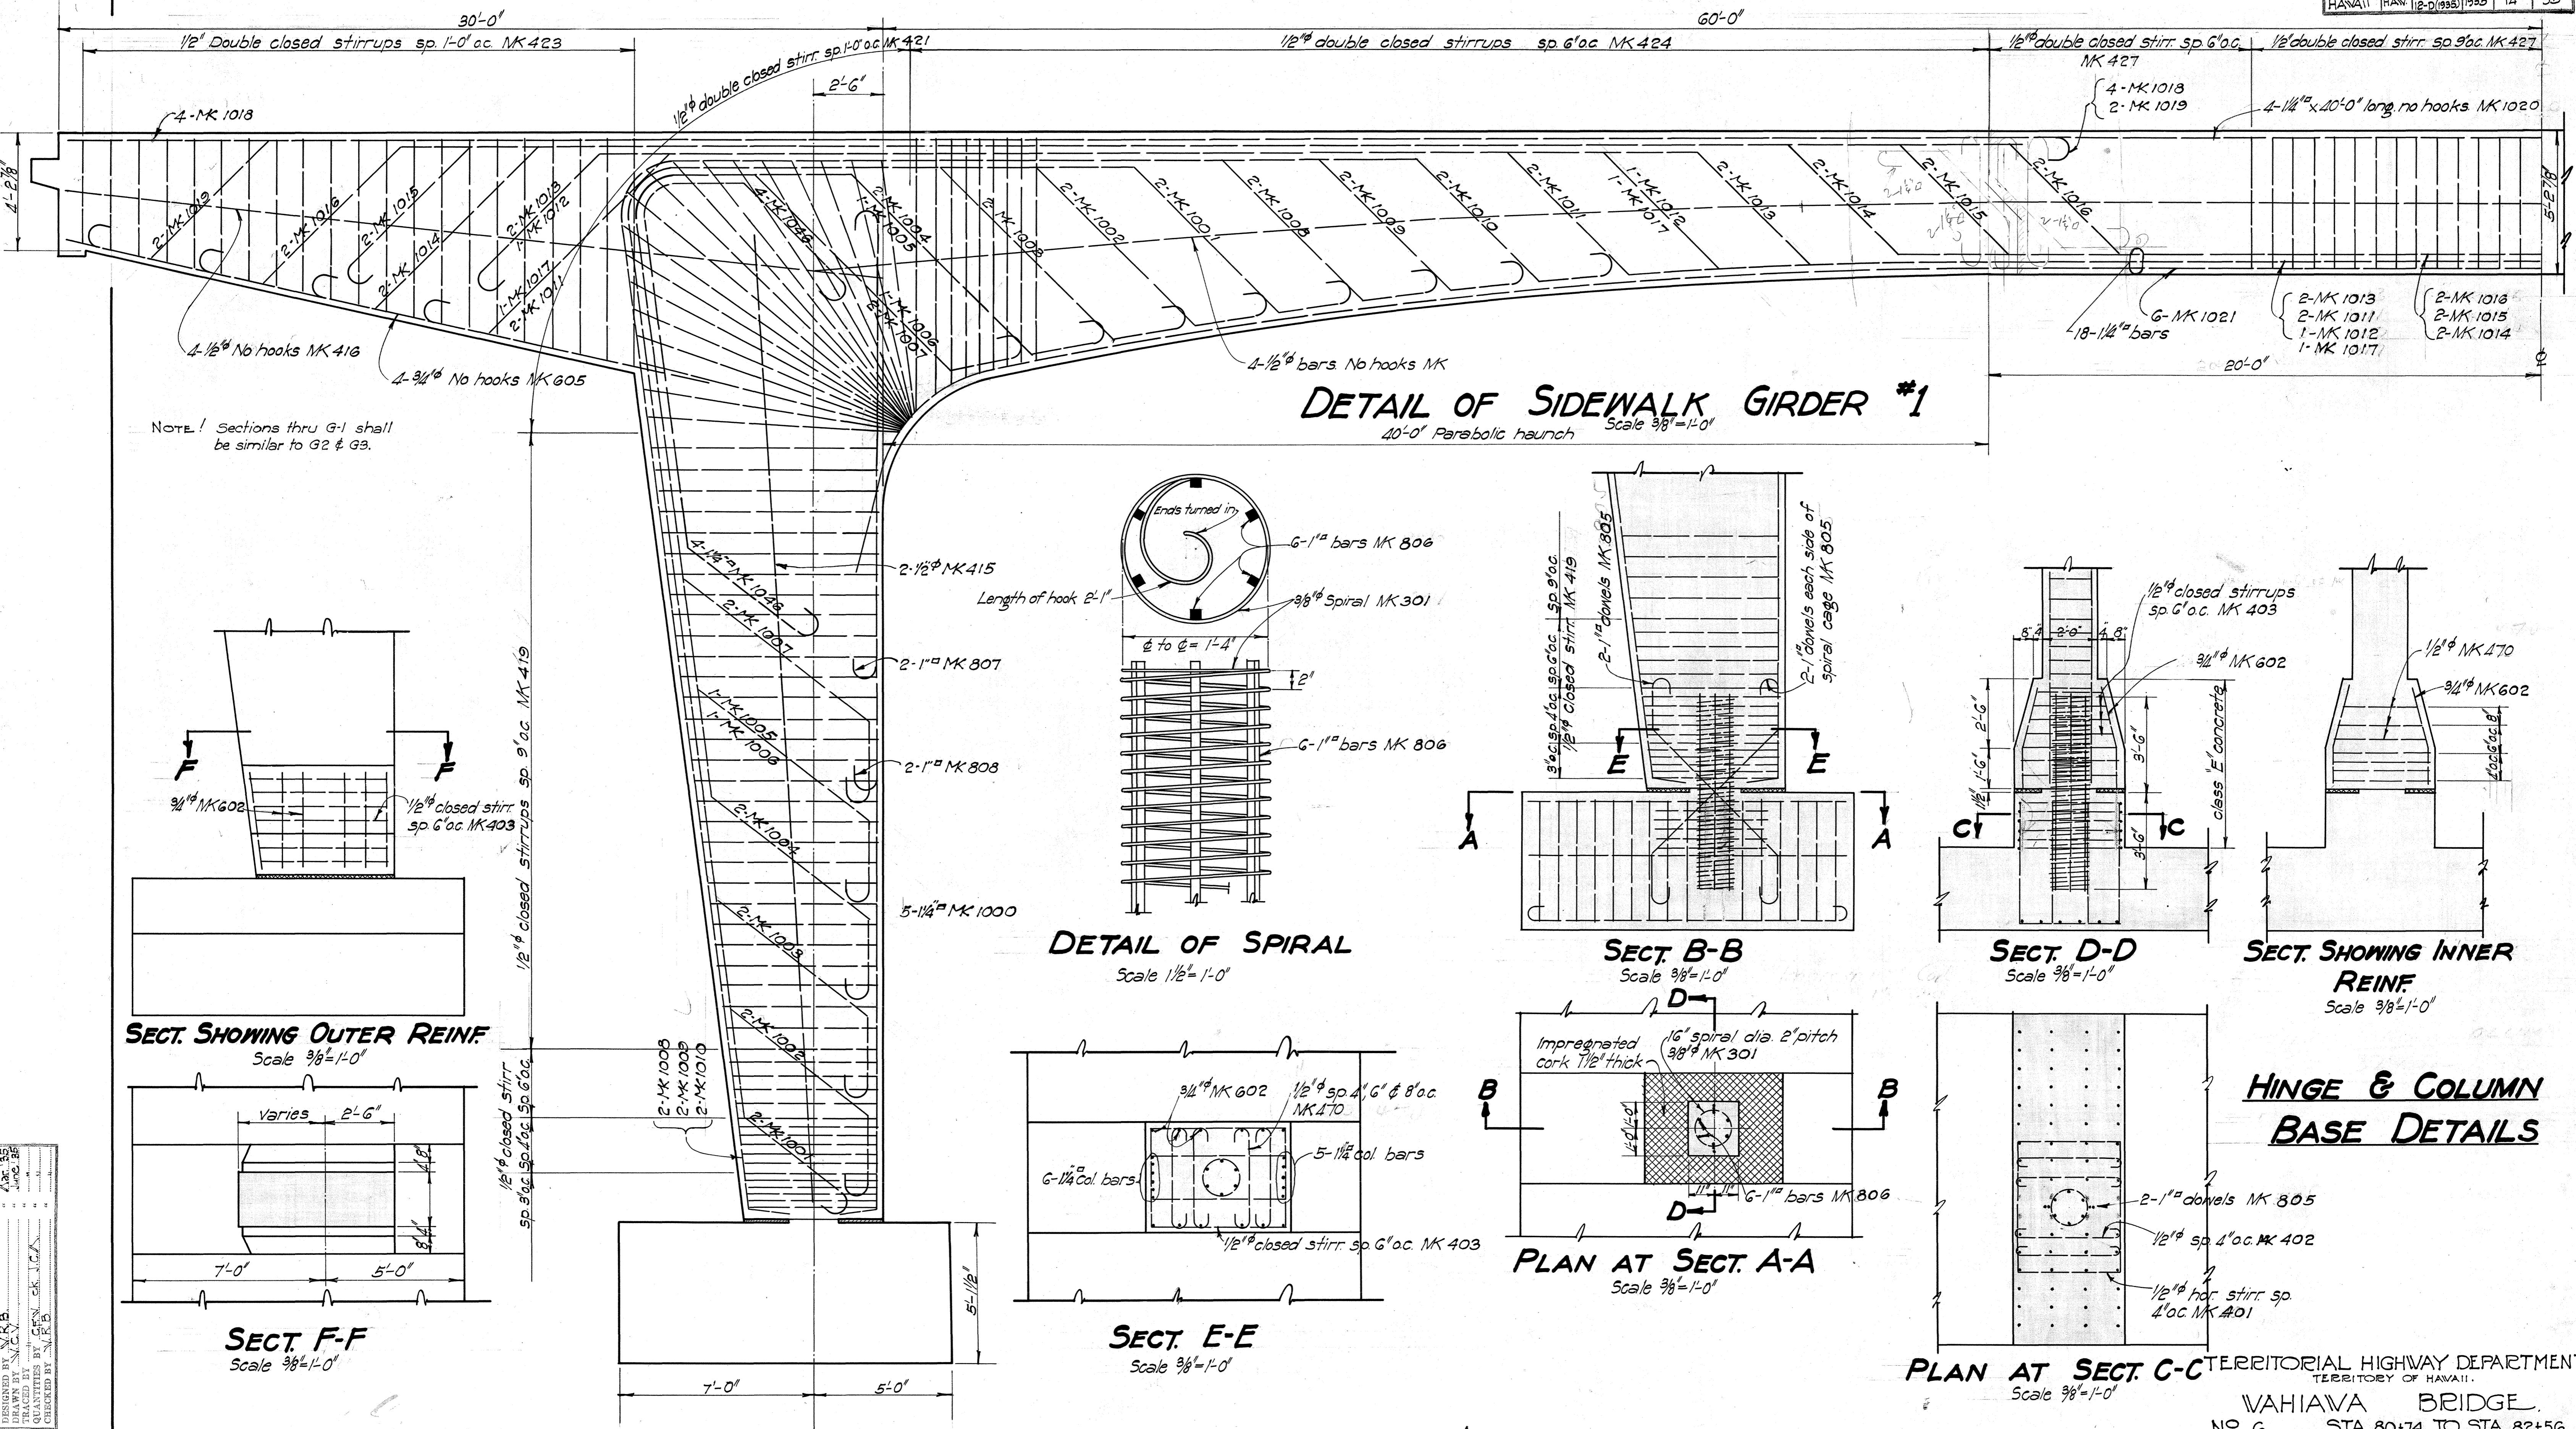
4333.13



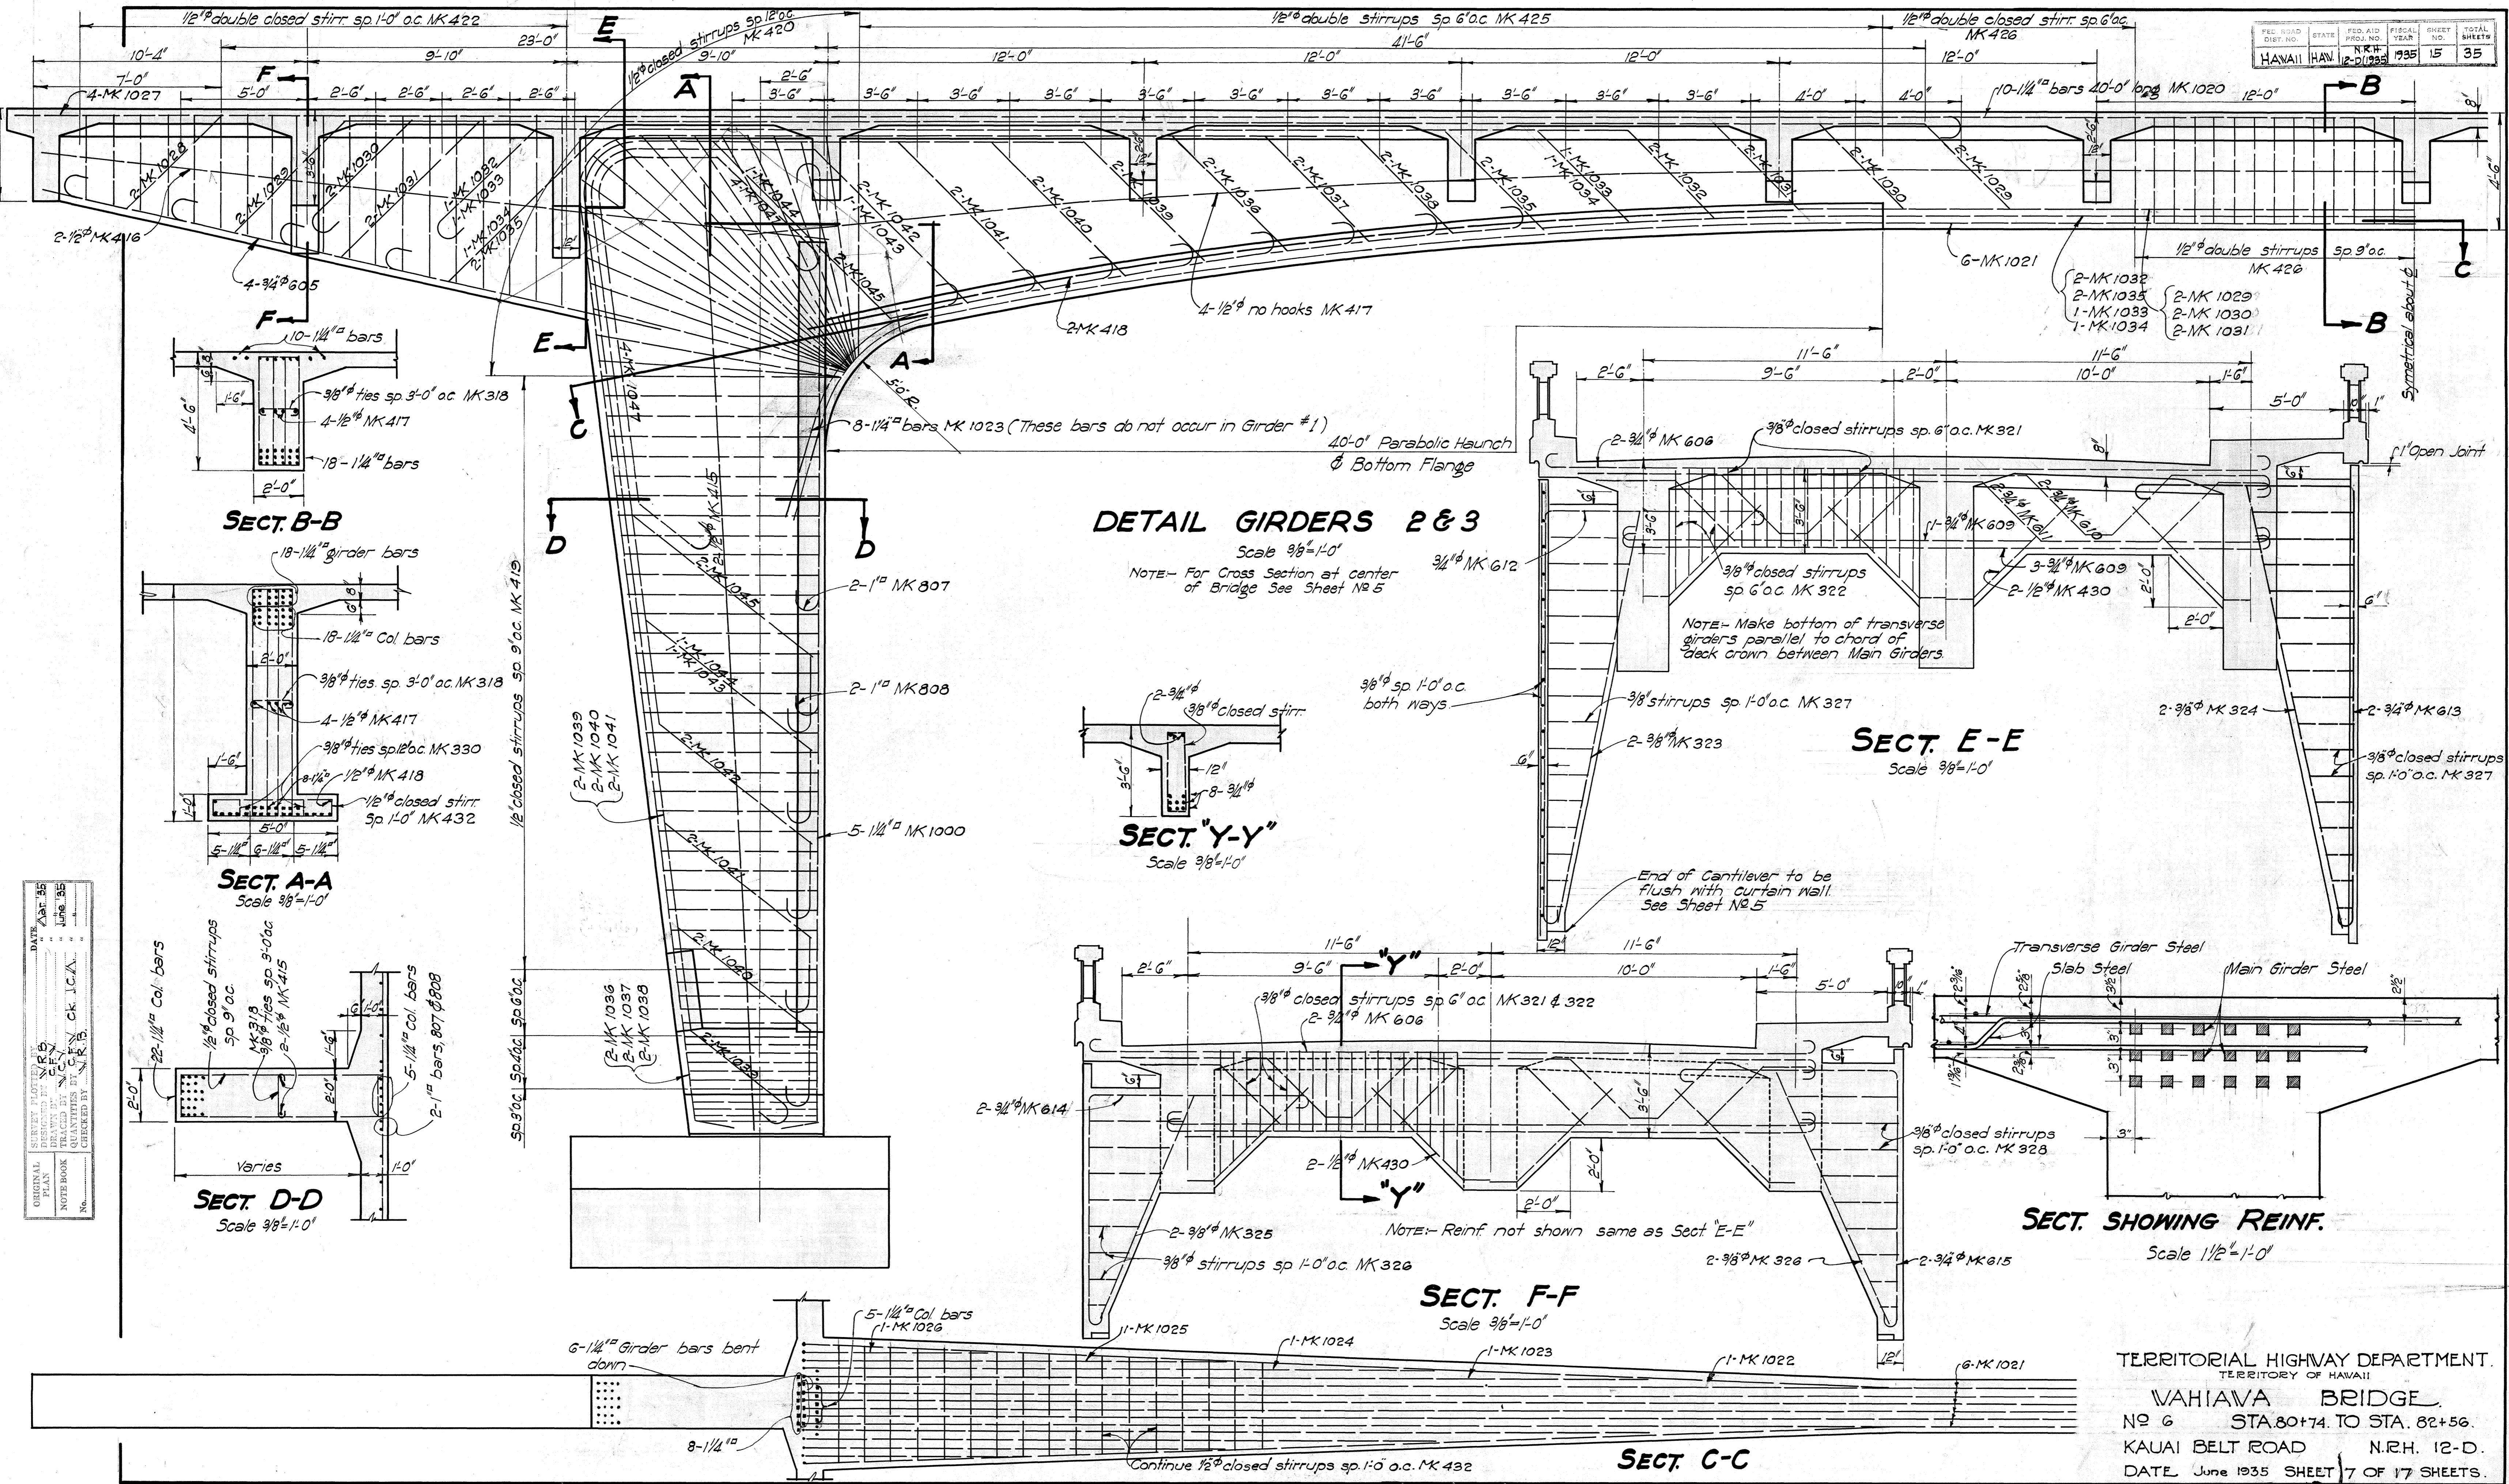FED. ROAD
DIST. NO. STATE
HAWAII HAWI 12-D
FED. AID PROJ. NO.
N.R.H. 1935 15 35



FED. ROAD DIST. NO.	STATE	FED. AID PROJ. NO.	FISCAL YEAR	SHEET NO.	TOTAL SHEETS
HAWAII	HAV	N.R.H. 12-D(935)	1935	16	35

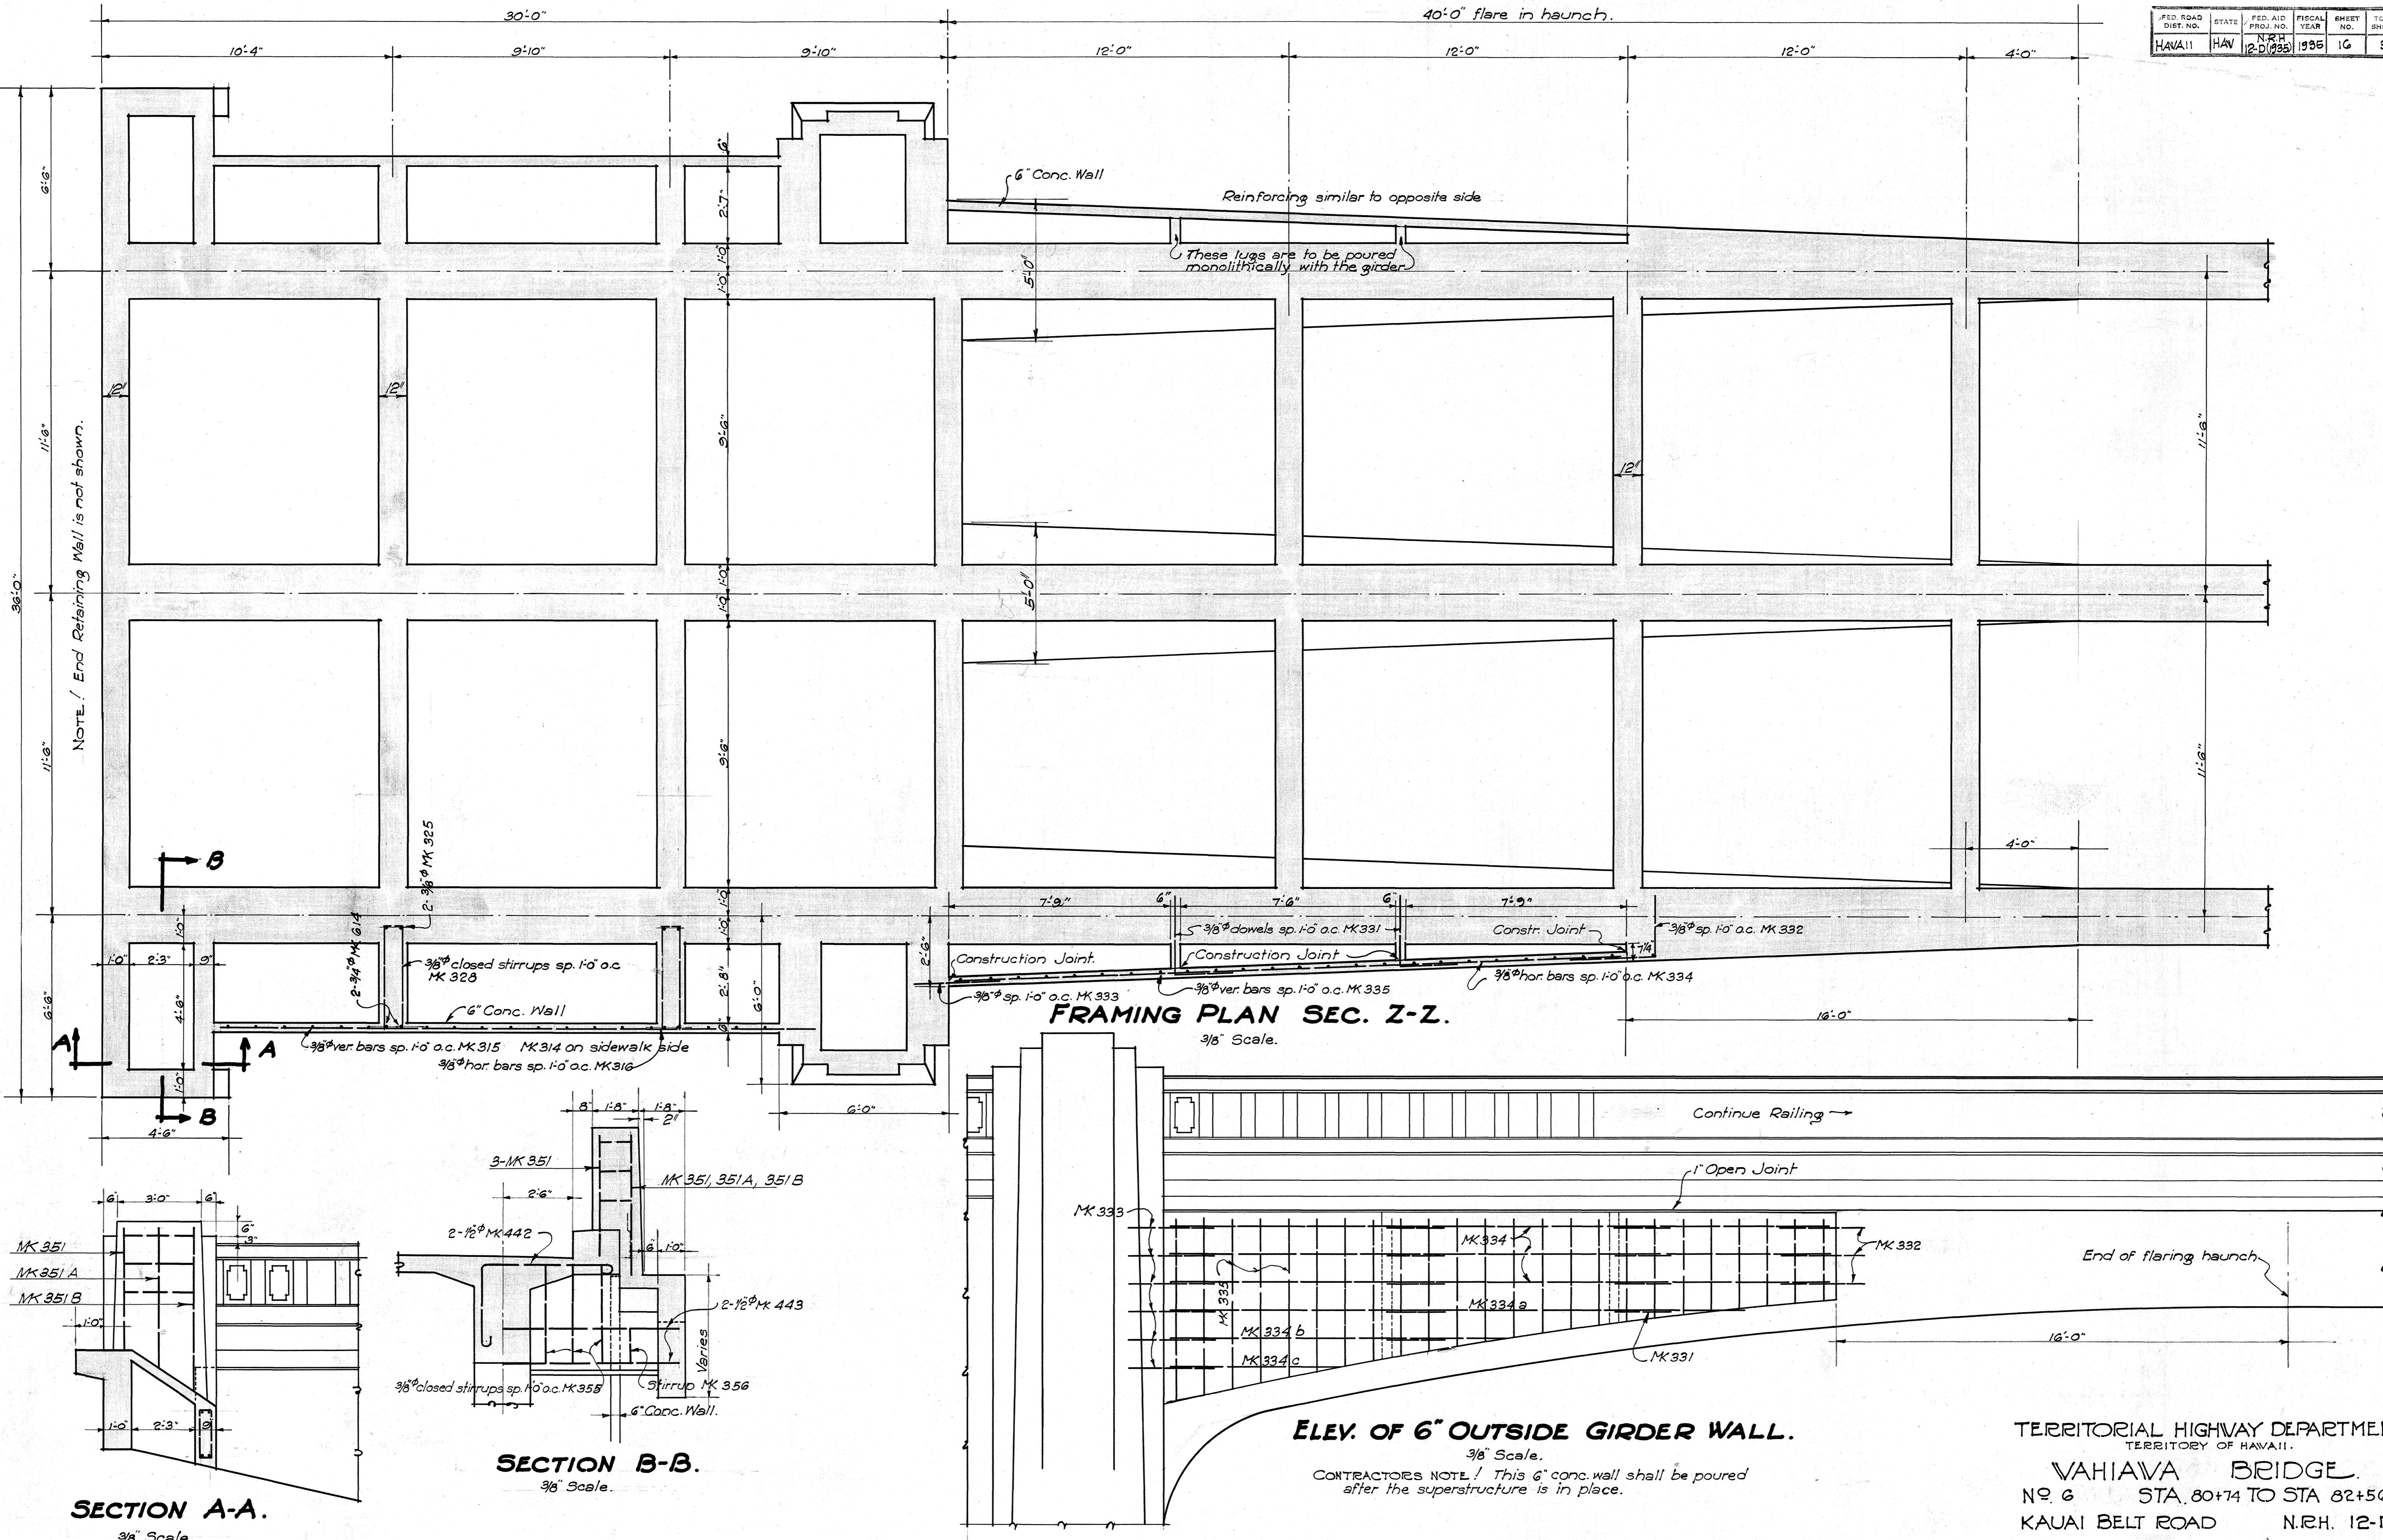

ORIGINAL PLAN	SURVEY PLOTTED BY W.R.B.	DATE Mar. 1935
NOTE BOOK	DESIGNED BY C.F.W.	APR. "
No.	DRAWN BY C.F.W.	"
	QUANTITIES BY C.F.W. C.R.C.A.	"
	CHECKED BY W.R.B.	May " June "

TERRITORIAL HIGHWAY DEPARTMENT
TERRITORY OF HAWAII.

VAHIAWA BRIDGE.
NO. 6 STA. 80+74 TO STA 82+56
KAUAI BELT ROAD N.R.H. 12-D.
DATE June 1935 SHEET 8 OF 17 SHEETS.

SECTION A-A.

3/8" Scale.

SECTION B-B


3/8" Scale

ELEV. OF 6" OUTSIDE GIRDER WALL.

3/8" Scale.
CONTRACTORS NOTE! This 6" conc. wall shall be poured
after the superstructure is in place.


413833.16

FED. ROAD DIST. NO.	STATE	FED. AID PROJ. NO.	FISCAL YEAR	SHEET NO.	TOTAL SHEETS
HAWAII	HAW	N.R.H.	1935	17	35

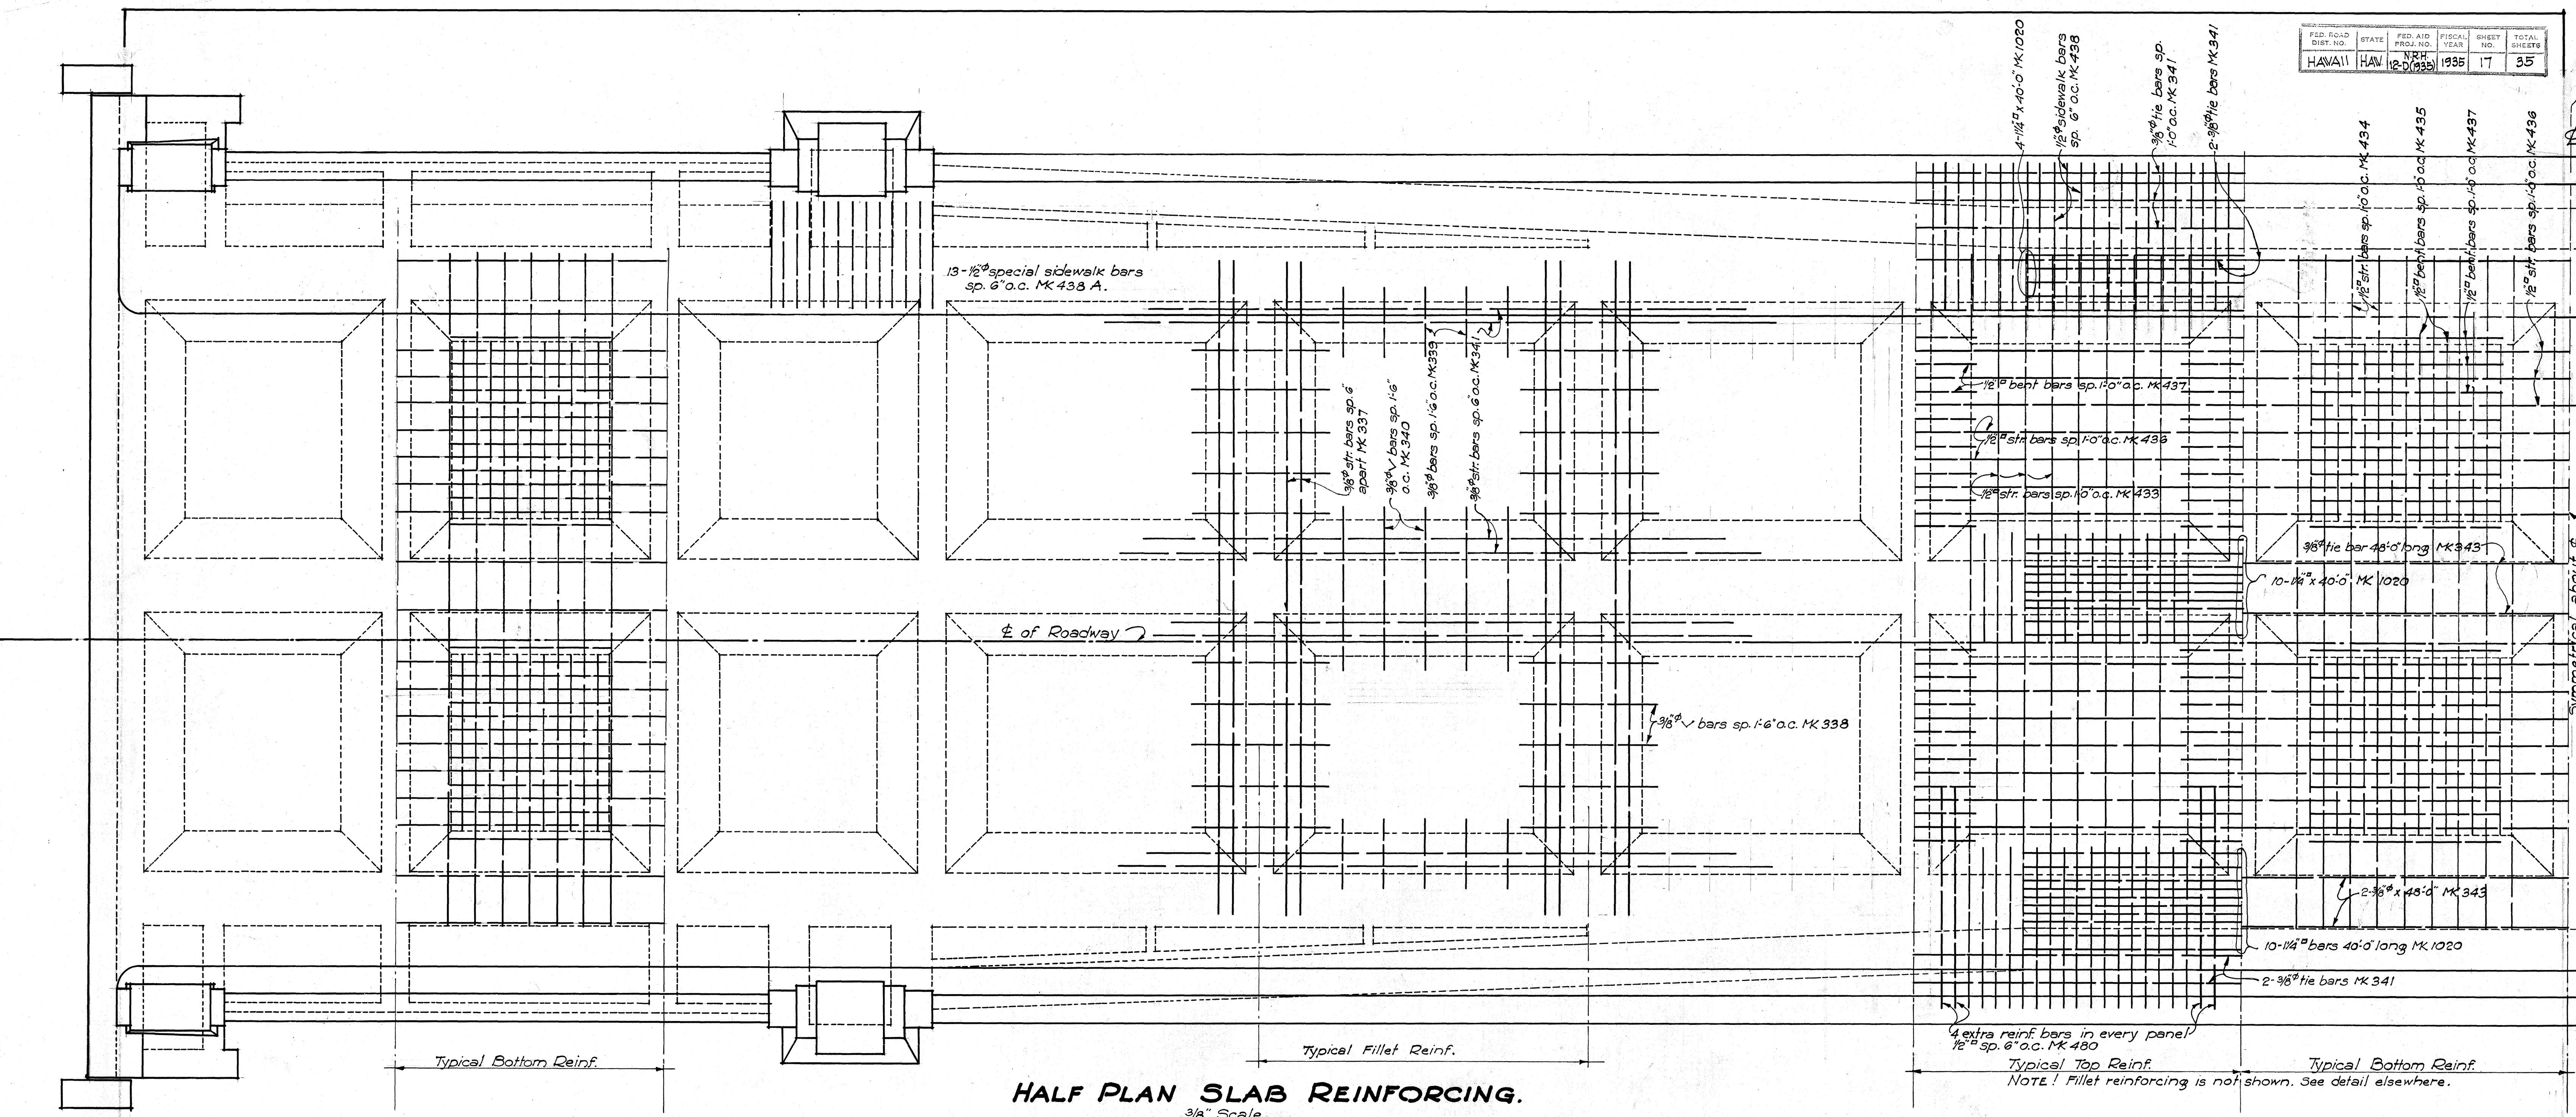


HALF PLAN SLAB REINFORCING.

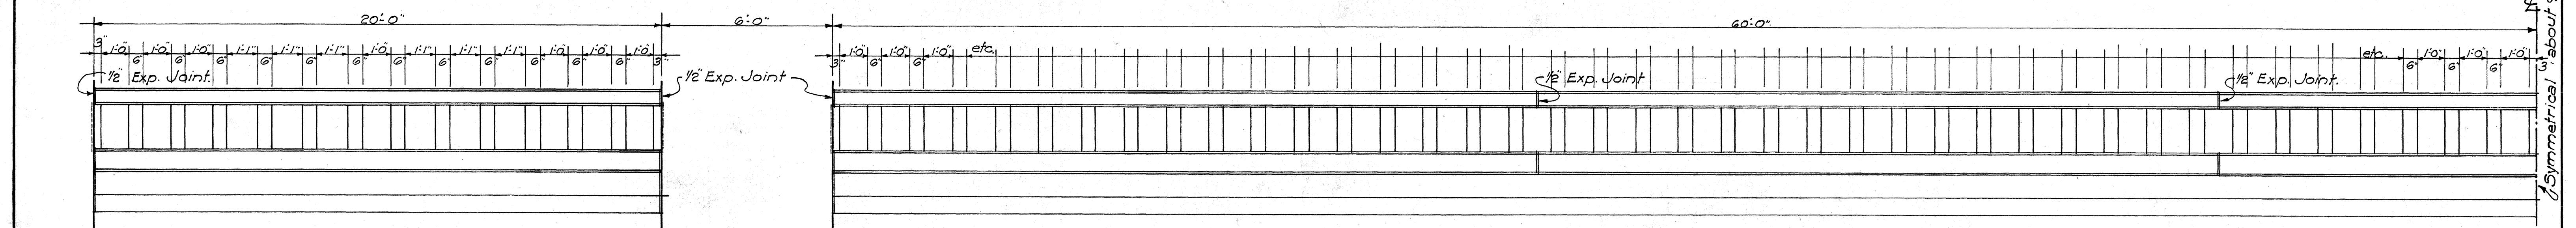3/8" Scale.



HALF ELEV. RAILING LAYOUT.

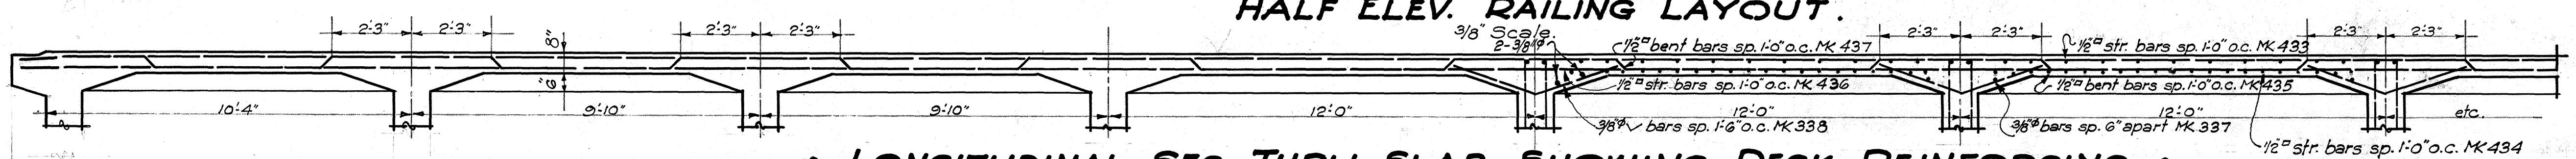3/8" Scale.



3/8" Scale.

TERRITORIAL HIGHWAY DEPARTMENT
TERRITORY OF HAWAII.

VAHIAVA BRIDGE.


No. 6 STA. 80+74 TO STA. 82+56

KAUAI BELT ROAD N.R.H. 12-D.

DATE June 1935 SHEET 9 OF 17 SHEETS.

4 3 3 3 . 1 5

ORIGINAL PLAN	SURVEY PLOTTED BY DESIGNED BY DRAWN BY TRACED BY	DATE <u>May 35</u>
NOTE BOOK	QUANTITIES BY CHECKED BY	DATE <u>June 1</u>
No.		

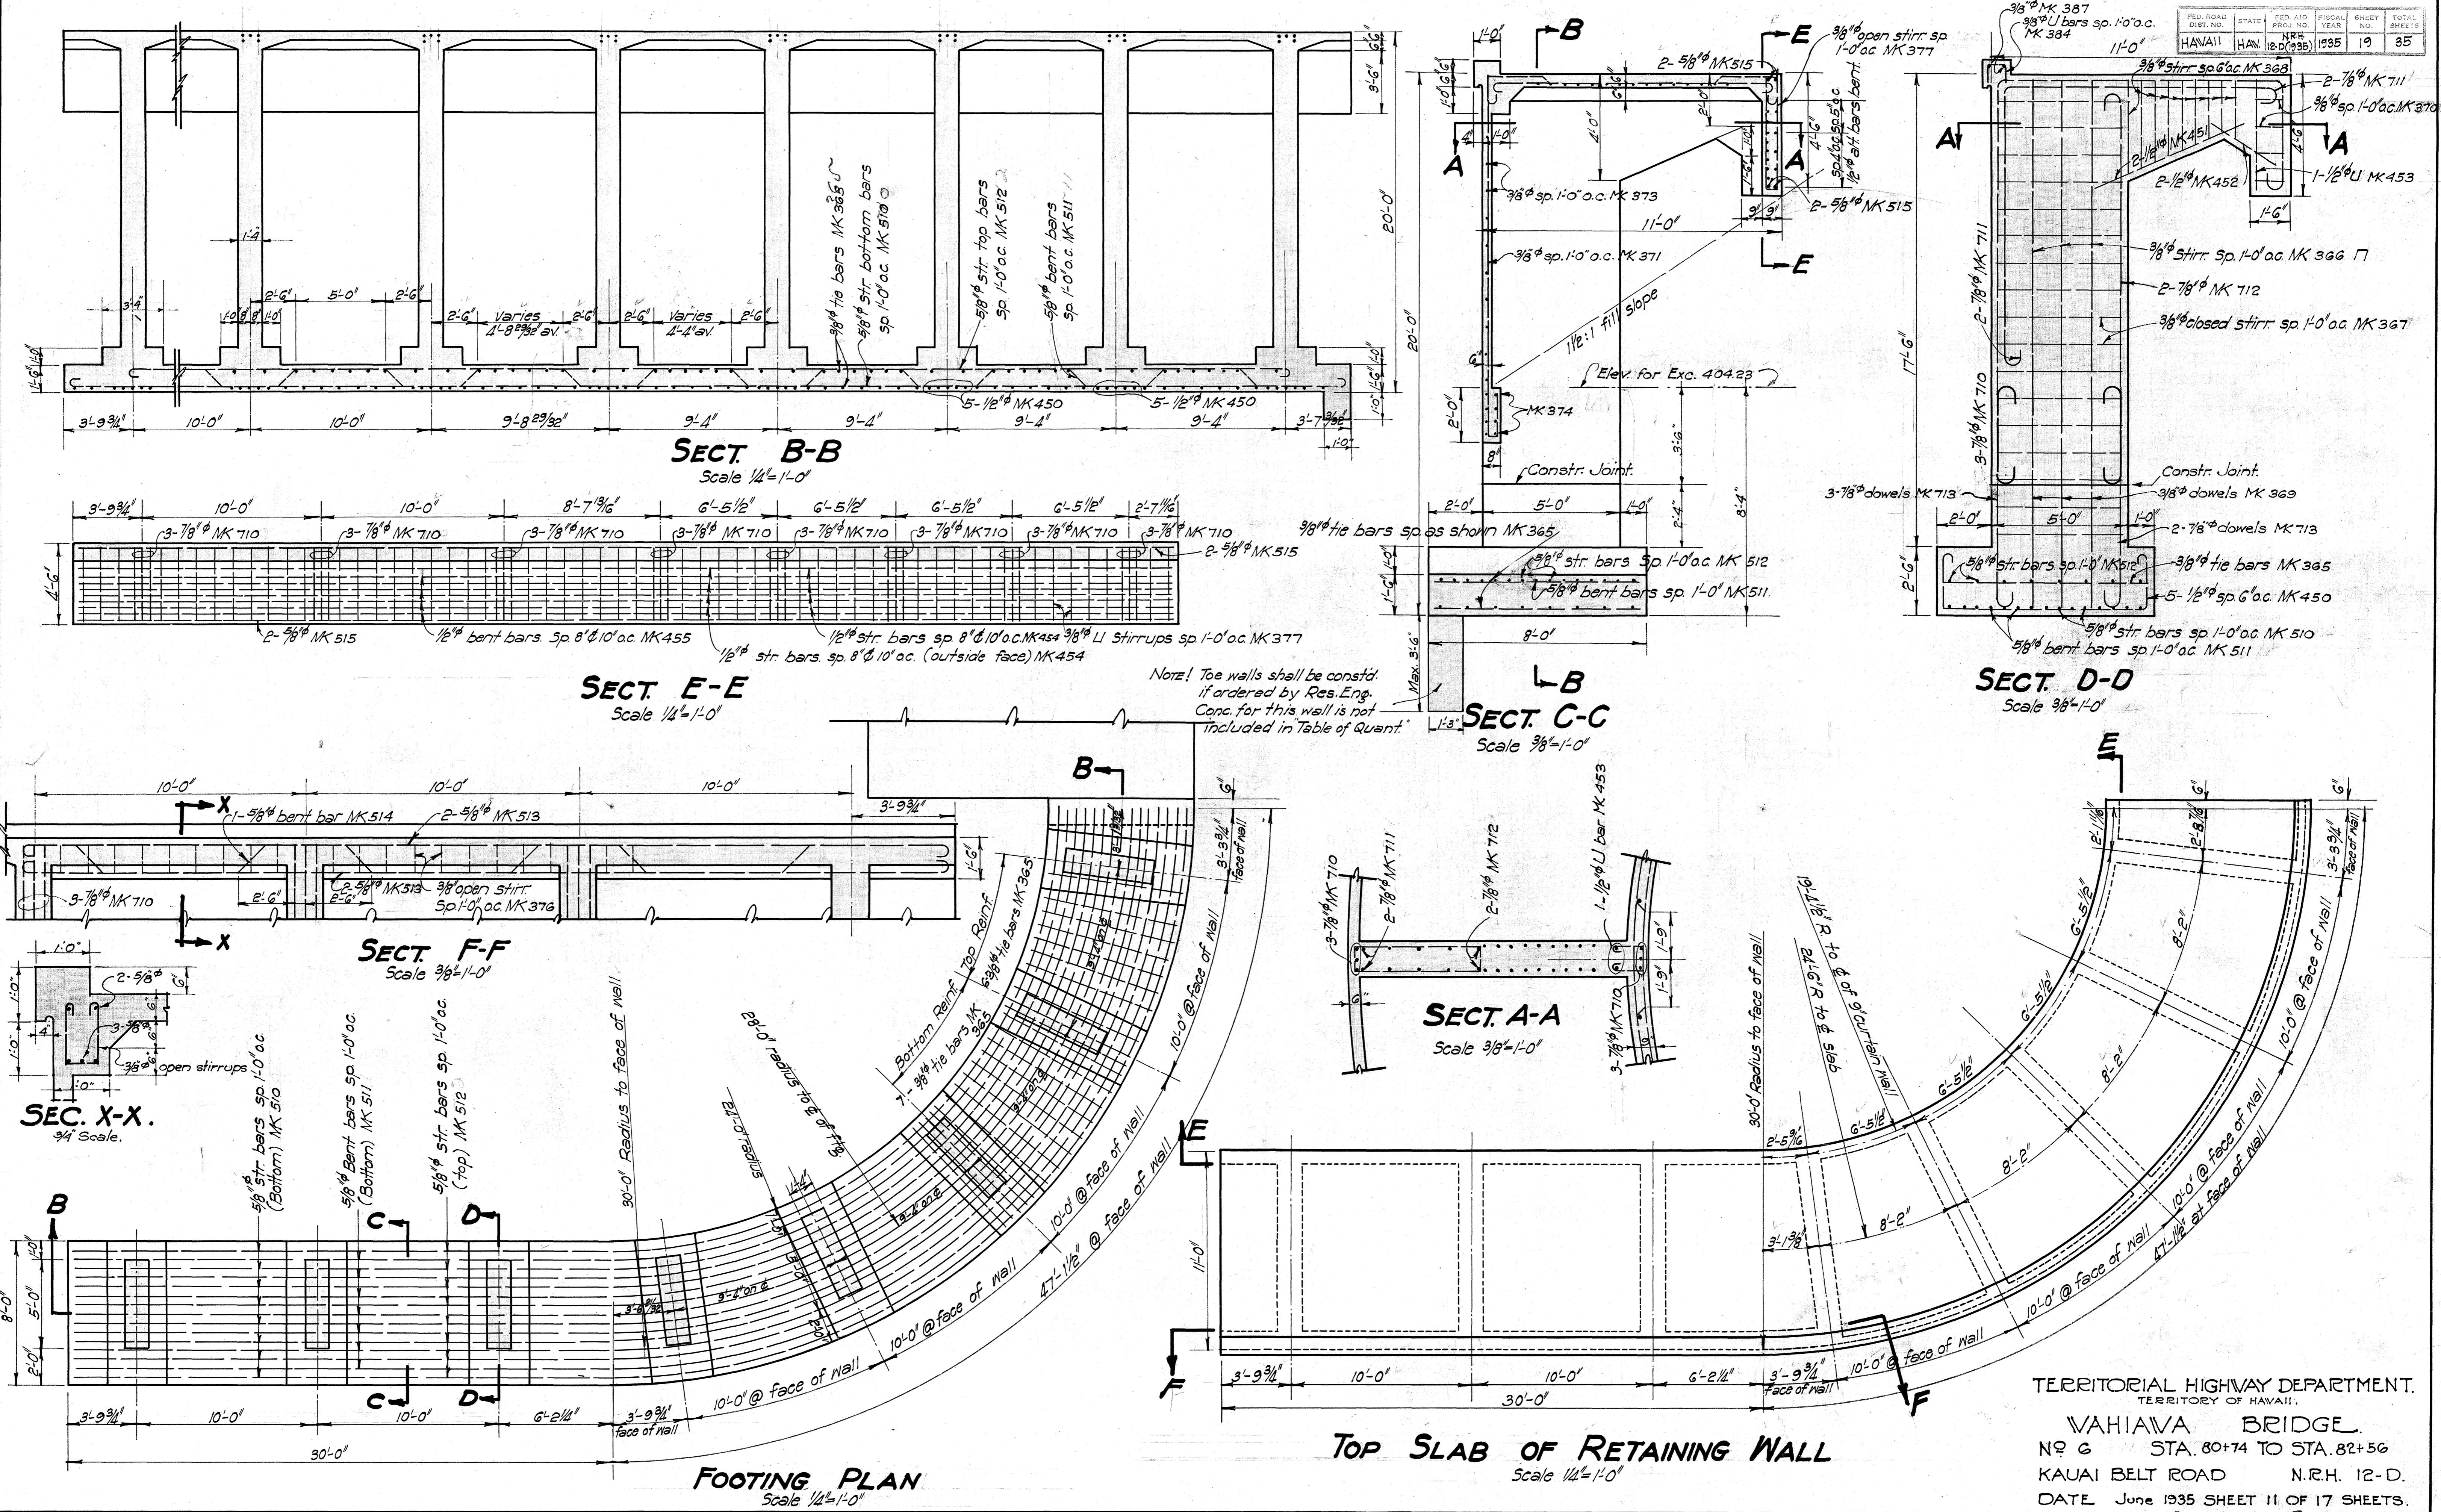


WAHIAWA BRIDGE.
NO. 6 STA. 80+74 TO STA. 82+56
KAUAI BELT ROAD N.R.H. 12-D.
DATE June 1935 SHEET 11 OF 17 SHEETS.

1288 19

1222316

Fig. 1. A photograph of the same field as in Figure 1, but taken at a later date. The vegetation has been cleared and the ground is bare.

O. ROAD ST. NO.	STATE	FED. AID PROJ. NO.	FISCAL YEAR	SHEET NO.	TOTAL SHEETS
WAII	HAW.	N.R.A. 12-01935	1935	20	35

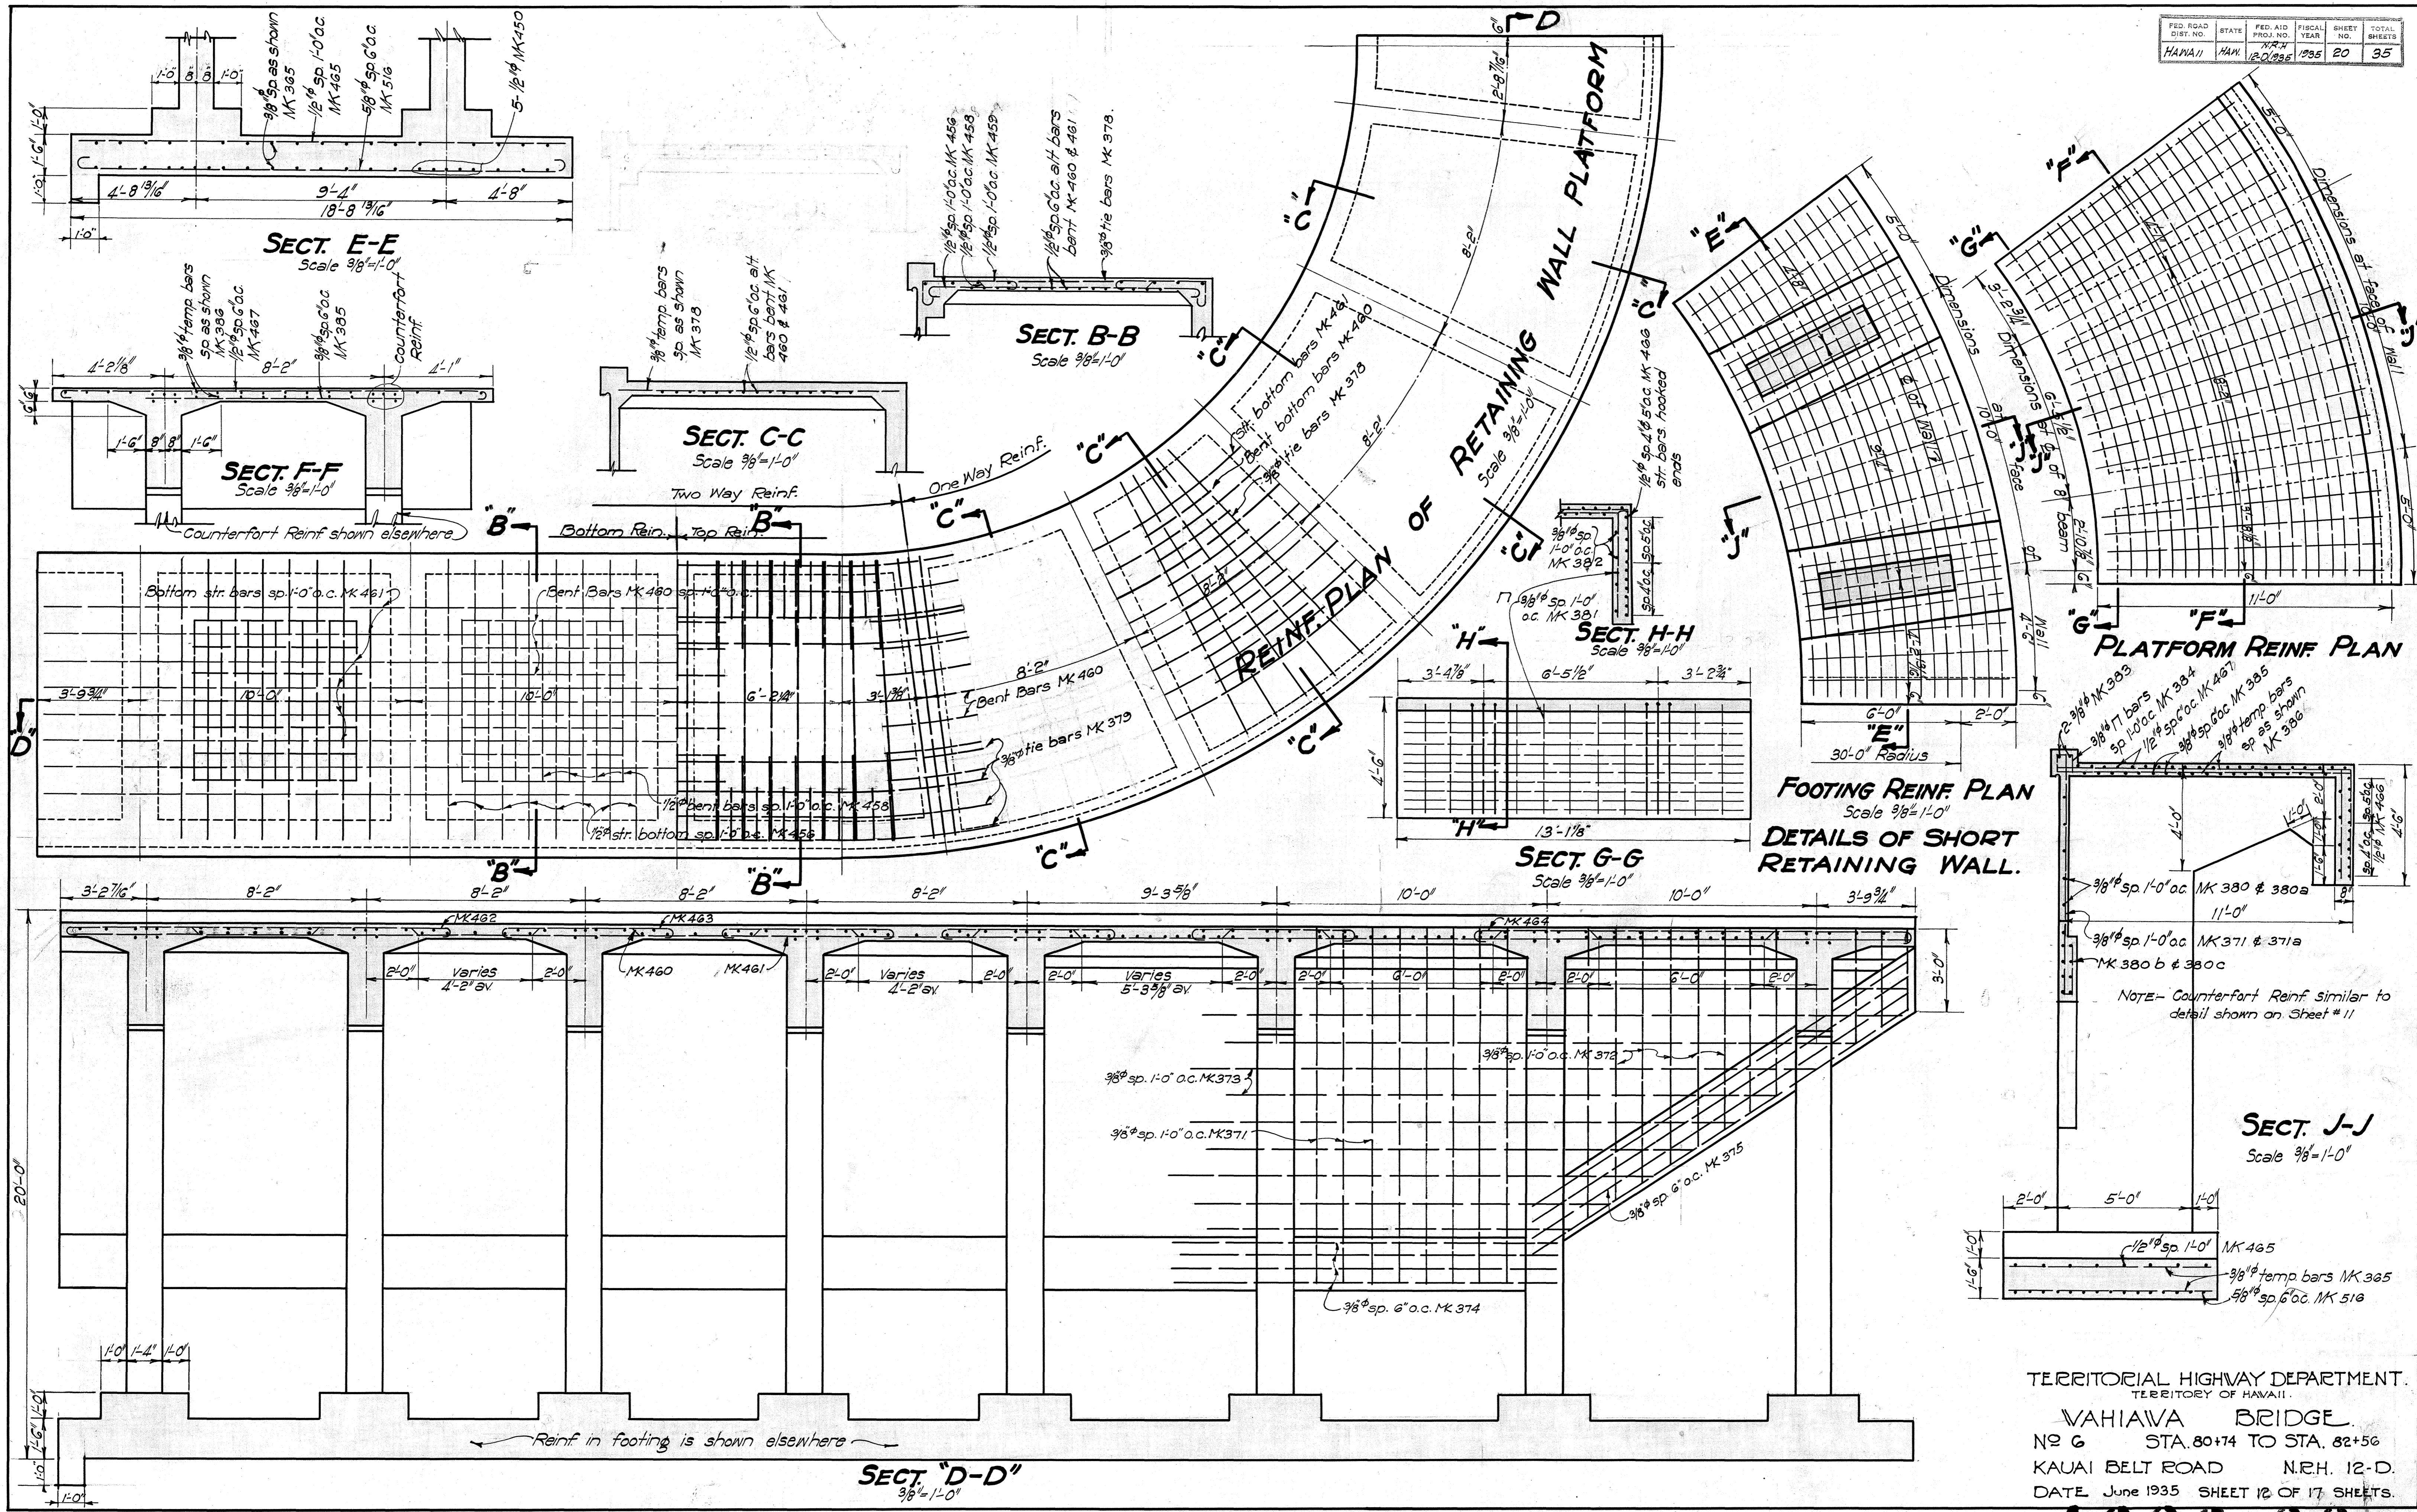

TERRITORIAL HIGHWAY DEPARTMENT.
TERRITORY OF HAWAII.

VAHIAWA BRIDGE.

Nº 6 STA. 80+74 TO STA. 82+56

KAUAI BELT ROAD N.R.H. 12-D.

DATE June 1935 SHEET 12 OF 17 SHEETS.

1 2 3 4 5 6 7 8 9 10

STEEL SCHEDULE

FED. ROAD DIST. NO.	STATE NO.	FED. AID PRO. NO.	FISCAL YEAR	SHEET NO.	TOTAL SHEETS
HAWAII	HAWAII	175	1935	22	35

MK	DESCRIPTION	LOCATION	SIZE	LENGTH	NO. OF BARS IN EA. UNIT	NO. OF UNITS	TOTAL NO. OF BARS	TOTAL LENGTH	WT. PER FOOT	TOTAL WEIGHT
600		Pier footing	3/8"	36'-2"	23	2	46	1663.82	1.02	2529.0
500		" "	5/8"	35'-11"	23	2	46	1652.32	1.06	1751.0
300		" "	3/8"	11'-6"	20	20	404	1196.00	0.38	454.0
501		" "	5/8"	10'-0"	11	2	22	220.00	1.06	233.0
601		" "	3/4"	11'-6"	12	2	24	276.00	1.02	420.0
800		" "	1/2"	13'-8"	4	6	24	328.08	2.70	886.0
801		" "	1/2"	14'-4"	2	6	12	171.96	"	464.0
802		" "	1/2"	14'-10"	3	6	18	266.94	"	721.0
803		" "	1/2"	13'-1"	3	6	18	235.14	"	636.0
804		" "	1/2"	9'-10"	4	6	24	235.92	"	637.0
400		" "	1/2"	14'-9"	30	6	180	265.500	0.68	1805.0
805		Gables(s)	1"	12'-4"	4	6	24	295.92	3.44	1018.0
806		" (Spiral)	1"	7'-3"	6	6	36	261.00	"	898.0
301	Length of hook 2'-1"	Fig Col bars	3/8"	180'-3"	1	6	6	1081.50	0.38	411.0
401		" "	1/2"	17'-6"	6	6	36	630.00	0.68	428.0
402		" "	1/2"	4'-8"	24	6	144	672.48	"	457.0
602		" "	3/8"	3'-6"	12	6	72	252.00	1.02	383.0
403		" "	1/2"	Variety 12'-3" AV	7	6	42	682.50	0.68	464.0
470		" "	1/2"	Variety 4'-10"	7	6	42	202.86	"	138.0
502		End Ret. Wall	5/8"	7'-8"	38	2	76	582.92	1.06	618.0
503		" "	5/8"	7'-2"	38	2	76	544.92	"	578.0
504		" "	5/8"	5'-6"	38	2	76	418.00	"	443.0
505		" "	5/8"	7'-4"	76	2	152	1114.16	"	1181.0
302		" "	3/8"	37'-9"	19	2	38	1434.50	0.38	545.0
303		" "	3/8"	4'-0"	38	2	76	304.00	"	116.0
700		Col tie beam	7/8"	26'-5"	10	2	20	528.00	2.07	1093.0
304		" "	3/8"	7'-0"	20	2	40	280.00	0.38	106.0
506		Col lug on Pier Platform	5/8"	11'-11"	4	6	24	286.08	1.06	303.0
604		" "	3/4"	10'-6"	12	6	72	756.00	1.52	1149.0
305		" "	3/8"	10'-5"	7	6	42	437.64	0.38	166.0
404		Curtain Wall for Pier Platform	1/2"	34'-6"	6	2	12	414.00	0.68	282.0
405		" "	3/8"	36'-0"	4	2	8	288.00	"	196.0
306		" "	3/8"	9'-6"	22	2	44	418.00	0.38	159.0
507		" "	3/8"	34'-6"	4	2	8	276.00	1.06	293.0
406		Slab for Pier Platform	1/2"	15'-0"	22	2	44	660.00	0.68	449.0
407		" "	1/2"	11'-5"	22	2	44	502.48	"	342.0
408		" "	1/2"	6'-0"	44	2	88	528.00	"	359.0
307		" "	3/8"	10'-6"	12	2	24	252.00	0.38	96.0

MK	DESCRIPTION	LOCATION	SIZE	LENGTH	NO. OF BARS IN EA. UNIT	NO. OF UNITS	TOTAL NO. OF BARS	TOTAL LENGTH	WT. PER FOOT	TOTAL WEIGHT
409		Slab for Pier Platform	1/2"	35'-9"	7	2	14	500.50	0.68	340.0
410		" "	1/2"	35'-6"	6	2	12	426.00	"	290.0
411		" "	1/2"	34'-6"	6	2	12	414.00	"	282.0
308		Vert bars	3/8"	14'-3"	8	2	16	228.00	0.38	87.0
309		" "	3/8"	29'-6"	52	2	104	306.800	"	1166.0
412		Hor bars	1/2"	34'-6"	44	2	88	303.600	0.68	2064.0
413		" "	1/2"	31'-9"	44	2	88	279.400	"	1900.0
310		Railing Pier Post	3/8"	7'-6"	39	2	78	585.00	0.38	222.0
414		" "	1/2"	11'-0"	39	2	78	858.00	0.68	583.0
311		Sidewalk Normal	3/8"	21'-0"	14	2	28	588.00	0.38	223.0
312		" "	20'-0"	4	2	8	160.00	"	61.0	
313		Normal	1/2"	19'-0"	6	2	12	228.00	"	87.0
314		Varieties	1/2"-10" AV	"	18	2	36	461.88	"	176.0
315		" "	1/2"-3" AV	"	18	2	36	441.00	"	168.0
316		" "	21'-0"	6	4	24	504.00	"	192.0	
317		" "	11'-9"	13	4	52	611.00	"	232.0	
1000		Col Bars G-1,G-2,G-3	1/2"	39'-0"	5	6	30	1170.00	5.37	6283.0
807		" "	1/2"	19'-0"	2	6	12	228.00	3.44	784.0
808		" "	20'-2"	"	2	6	12	276.00	"	949.0
415		" "	36'-0"	2	6	12	432.00	0.68	294.0	
1001		" G-1 "	1/2"	69'-10"	2	2	4	279.32	5.37	1500.0
1002		" G-1 "	1/2"	67'-4"	2	2	4	269.32	"	1446.0
1003		" G-1 "	1/2"	61'-2"	2	2	4	244.68	"	1314.0
1004		" G-1 "	1/2"	54'-6"	2	2	4	218.00	"	1171.0
1005		" G-1 "	1/2"	51'-1"	1	2	2	102.16	"	549.0
1006		" G-1 "	1/2"	48'-5"	1	2	2	96.84	"	520.0
1007		" G-1 "	1/2"	45'-1"	2	2	4	180.32	"	968.0
1008		" G-1 "	1/2"	71'-9"	2	2	4	287.00	"	1541.0
1009		" G-1 "	1/2"	74'-9"	2	2	4	299.00	"	1606.0
1010</										

STEEL SCHEDULE






















FED. ROAD Bldg. No.	STATE N.R.H. 120-1935	FED. AID Proj. No.	FISCAL YEAR 1935	SHEET NO.	SHETS
HAWAII	HAW.			23	35
















MK	DESCRIPTION	LOCATION	SIZE	LENGTH	Bars in each unit	No. of bars	Total No. of bars	Total Length	Weight per foot	Total Weight	
1041		Col. Bars G2 & G3	1/4"	60'2"	2	4	8	481.36	5.37	2585	
1042		"	"	53'5"	2	4	8	427.36	"	2295	
1043		"	"	50'-0"	1	4	4	200.0	"	1074	
1044		"	"	47'5"	1	4	4	189.68	"	1019	
1045		"	"	44'2"	2	4	8	353.36	"	1898	
419		Col. Stirrups G1-G2 & G3	1/2"	Varies Av. 18'-0"	46	6	276	4968.0	0.68	3378	
420		Knee Stirr. G2 & G3.	"	Varies Av. 23'-0"	36	4	144	3432.0	"	2334	
421		"	"	Varies Av. 24'-11"	36	2	72	1794.0	"	1220	
422		Cantilever Stirr G2 & G3	"	Varies Av. 13'-9"	42	4	168	2310.0	"	1571	
423		"	"	Varies Av. 15'-0"	42	2	84	1260.0	"	857	
432		Flaring Haunch Stirr " G1-G2 & G3.	"	Varies Av. 8'-3"	82	3	246	2029.50	"	1380	
424		Haunch Stirr G1	"	Varies Av. 16'-11"	308	1	308	5210.33	"	3543	
425		"	"	G2 & G3	312	2	624	9620.0	"	6542	
426		Normal Stirr. G2 & G3	"	11'-0"	134	2	268	2948.0	"	2005	
427		"	"	G1.	12'-6"	134	1	134	1675.0	"	1139
330		Flaring Haunch Stirr Ties G1-G2 & G3	3/8"	2'-4"	82	3	246	573.18	0.38	218	
606		Normal Tie Beam.	3/4"	29'-4"	3	9	27	791.91	1.52	1204	
607		"	"	29'-3"	2	11	22	643.50	"	978	
608		"	"	28'-6"	2	11	22	627.0	"	953	
609		"	"	26'-2"	4	11	44	1151.48	"	1750	
319		"	"	3/8"	6'-0"	18	11	198	1188.0	0.38	451
320		"	"	Varies Av. 16'-10"	20	11	220	1502.60	"	571	
428		"	"	1/2"	5'-6"	4	11	44	242.0	0.68	165
429		"	"	10'-0"	2	11	22	220.0	"	150	
606a		Pier Tie Beam	3/4"	27'-6"	3	2	6	165.0	1.52	251	
606		Cant. Tie Beam.	"	29'-4"	2	4	8	234.64	"	357	
609		"	"	26'-2"	4	4	16	418.72	"	636	


MK	DESCRIPTION	LOCATION	SIZE	LENGTH	Bars in each unit	No. of bars	Total No. of bars	Total Length	Weight per foot	Total Weight	
610		Cant. Tie Beam	3/4"	30'-11"	2	4	8	247.36	"	376	
611		"	"	30'-2"	2	4	8	241.36	"	367	
430		"	"	12'-0"	8	4	32	192.0	0.68	131	
321		"	"	3'-14"	22	4	88	704.0	0.38	268	
322		"	"	Varies Av. 10'-0"	16	4	64	640.0	"	243	
612		Brackets	3/4"	25'-6"	2	1	2	51.0	1.52	78	
613		Normal Sidewalk	"	"	2	1	2	53.0	"	81	
614		Normal Sidewalk	"	"	2	1	2	37.34	"	57	
615		"	"	19'-8"	2	1	2	39.34	"	60	
323		Normal	3/8"	16'-0"	2	1	2	32.0	0.38	12	
324		Sidewalk	"	"	2	1	2	34.0	"	13	
325		Normal	"	"	2	1	2	18.0	"	7	
326		Sidewalk	"	"	2	1	2	20.0	"	8	
327		Sidewalk Normal	5/8"	6'-0"	15	1	15	90.0	"	34	
328		"	"	6'-0"	8	1	8	48.0	"	18	
616		End Tie Beam	3/4"	37'-2"	3	2	6	223.02	1.52	339	
617		"	"	34'-5"	2	2	4	137.68	"	209	
618		"	"	29'-5"	2	2	4	117.68	"	179	
609		See Sketch	"	"	26'-2"	4	2	8	209.36	"	318
431		"	"	7'-0"	4	2	8	56.0	0.68	38	
619		"	"	3'-0"	2	2	4	41.0	1.52	62	
329		"	"	2'-11"	58	2	116	899.0	0.38	342	
331		False Girder Wall	"	"	4'-6"	9	4	36	162.0	"	62
332		"	"	2'-0"	3	4	12	60.0	"	23	
333		"	"	3'-0"	6	4	24	72.0	"	27	
334		"	"	23'-6"	3						

STEEL SCHEDULE

FED. ROAD DIST. NO.	STATE PROJ. NO.	FED. AID N.R.R. (12-01-1935)	FISCAL YEAR 1935	HEET NO.	TOTAL SHEETS
HAWAII	HAW	12-01-1935	1935	24	35

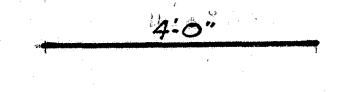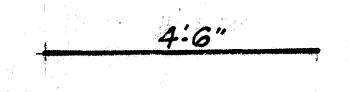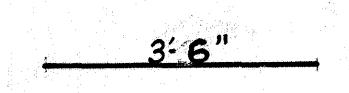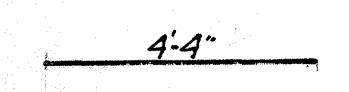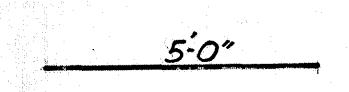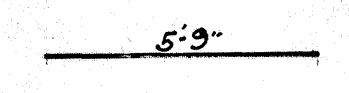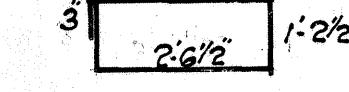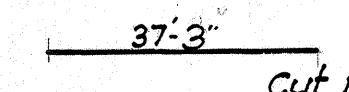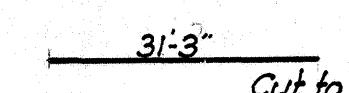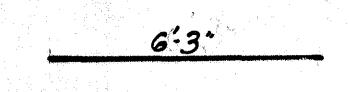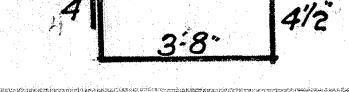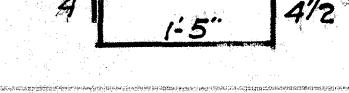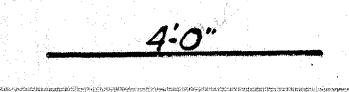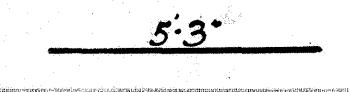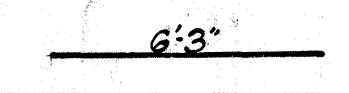
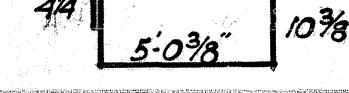
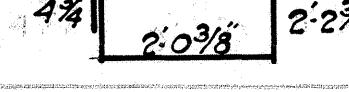
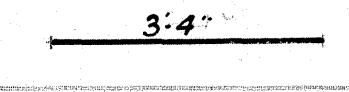
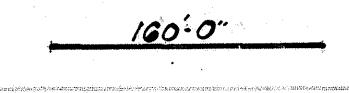
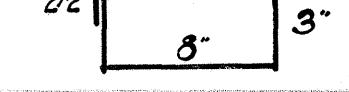
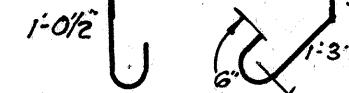
MK	DESCRIPTION	LOCATION	SIZE	LENGTH	Bars in each unit	No. of units	Total No. of bars	Total Length	Weight per foot.	Total Weight	
347		Superstr. End Post Slab & Wall	3/8"	4'-0"	6	2	12	48.0	0.38	18	
348		"	"	4'-6"	3	2	6	27.0	"	10	
349		End Tie Beam.	"	3'-0"	12	2	24	72.0	"	27	
350		End Post	"	3'-6"	3	2	6	21.0	"	8	
351		"	"	4'-4"	3	2	6	43.33	"	16	
351a		"	"	5'-0"	1	4	4	20.0	"	8	
351b		"	"	5'-9"	1	4	4	23.0	"	9	
352		"	"	8'-0"	3	4	12	96.0	"	36	
353		Curtain Wall	"	37'-3"	1	4	4	149.0	"	57	
354		"	"	31'-3"	1	4	4	125.0	"	48	
442		End Post Wall	1/2"	8'-7"	2	2	4	34.32	0.68	23	
443		"	"	6'-3"	4	2	8	50.0	"	34	
355		"	"	38"	3	2	6	52.50	0.38	20	
356		"	"	4'-3"	1	2	2	8.50	"	3	
357		Center Pier Post Reinf.	"	4'-0"	2	4	8	32.0	"	12	
358		"	"	5'-3"	4	4	16	84.0	"	32	
359		"	"	6'-3"	2	4	8	50.0	"	19	
360		"	"	12'-6"	4	4	16	200.0	"	76	
361		"	"	9'-3"	4	4	16	148.0	"	56	
444		Railing	1/2"	3'-4"	2	2	8	436	1451.88	0.68	987
362		"	"	98"	160'-0"	16	1	16	2560.0	0.38	973
200		"	"	14"	2'-3"	2	4	426	958.50	0.17	163
201		"	"	6"	1'-6"	2	4	426	639.0	"	109
363		"	"	38"	5'-0"	161	2	322	1610.0	0.38	612
1046		Col. Bars G-1.	1/4"	35'-0"	4	2	8	280.0	5.37	1504	
1047		G2 & G3	"	34'-11"	4	4	16	558.72	"	3000	

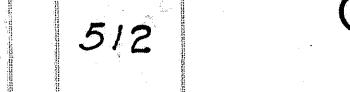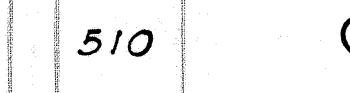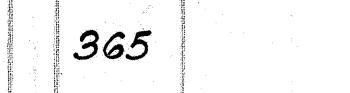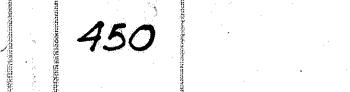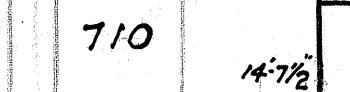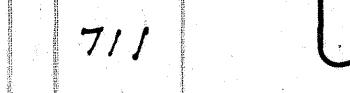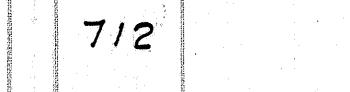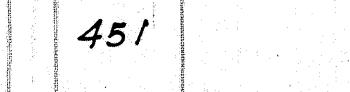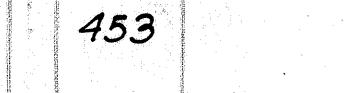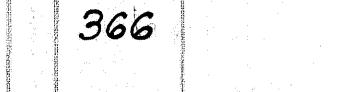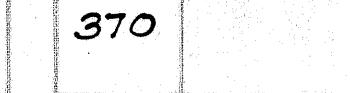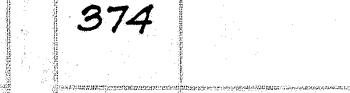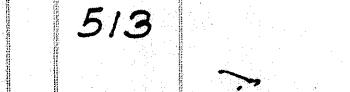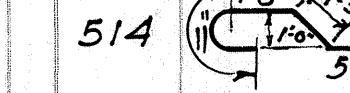
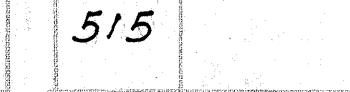
MK	DESCRIPTION	LOCATION	SIZE	LENGTH	Bars in each unit	No. of units	Total No. of bars	Total Length	Weight per foot.	Total Weight	
512		R.W. Wall Beg. of Br. Footing	3/8"	Varies Av. 69'-0"	8	1	8	552.0	1.06	585	
510		"	"	Varies Av. 11'-2"	7	1	7	568.17	"	602	
365		"	"	Varies Av. 75'-4"	8	1	8	602.67	"	639	
450		"	"	1/2"	12'-6"	5	8	40	500.0	0.68	340
710		W.W. Col.	"	10'-6"	3	8	24	746.0	2.07	1544	
711		"	"	22'-3"	2	8	16	356.0	"	737	
712		"	"	16'-4"	2	8	16	261.33	"	541	
451		"	"	1/2"	6'-0"	2	8	16	96.0	0.68	65
452		"	"	"	3'-0"	2	8	16	48.0	"	33
453		"	"	10'-8"	"	1	8	8	71.33	"	49
366		"	"	10'-11"	"	3	8	24	738.0	0.38	280
367		"	"	11'-9"	17	8	136	1598.0	"	607	
368		"	"	Varies Av. 8'-0"	9	8	72	576.0	"	219	
369		"	"	6'-0"	"	6	8	48	288.0	"	109
713		"	"	10'-0"	5	8	40	4000	2.07	828	
370		"	"	3'-9"	4	8	32	120.0	0.38	46	
371		Front Wall	"	15'-3"	3	6	48	777.75	"	296	
372		"	"	Varies Av. 7'-0"	11	1	11	99.0	"	38	
373		"	"	Varies Av. 70'-0"	10	1	10	705.0	"	268	
374		"	"	64'-0"	8	1	8	512.0	"	195	
375		"	"	16'-9"	8	1	8	134.0	"	51	
513		"	"	33'-6"	4	1	4	141.33	1.06	150	
514		"	"	37'-10"	11	1	1	37.83	"	40	
376		"	"	3'-3"	30	1	30	97.50	0.38	37	
515		"	"	60'-6"	4	1	4	242.0	1.06	257	
454		"	"	1/2"	61'-4"	4	2	8	490.67	0.68	334

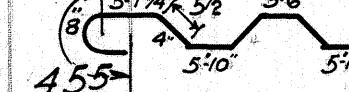
MK	DESCRIPTION	LOCATION	SIZE	LENGTH	Bars in each unit	No. of units	Total No. of bars	Total Length	Weight per foot.	Total Weight
455		Rear Curtain Wall 1/2	"	63'-2"	5	1	5	315.83	0.68	215
377		"	"	4'-6"	50	1	50	425.0	0.38	162
456		"	"	11'-0"	29	1	29	319.0	0.68	217
458		"	"	13'-6"	20	1	20			


STEEL SCHEDULE

ROAD ST. NO.	STATE	FED. AID PROJ. NO.	FISCAL YEAR	SHEET NO.	TOTAL SHEETS
HAWAII	HAW	N.R.H. 12-D (1935)	1935	25	35

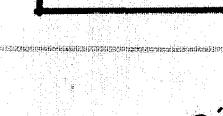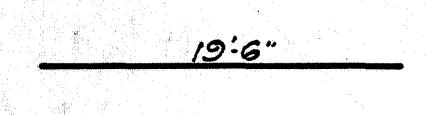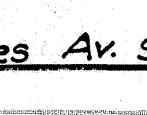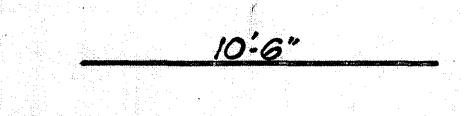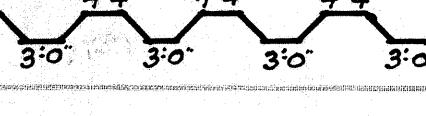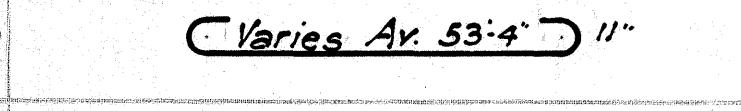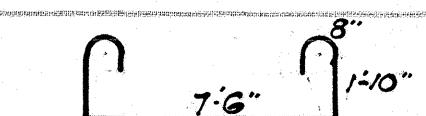MK	DESCRIPTION	LOCATION	SIZE	LENGTH	Bars in each unit	No. of units	Total No. of bars	Total Length	Weight per foot	Total Weight
366	See Sketch	Small W.W. Col.	$\frac{3}{8}^{\prime\prime}\phi$	30'-9"	3	4	12	369.0	0.38	141
367	"	"	"	11'-9"	17	4	68	799.0	"	300
368	"	"	"	8'-0"	9	4	36	288.0	"	100
369	"	"	"	6'-0"	6	4	24	144.0	"	50
713	"	"	$\frac{7}{8}^{\prime\prime}\phi$	10'-0"	5	4	20	200.0	2.07	414
370	"	"	$\frac{3}{8}^{\prime\prime}\phi$	3'-9"	4	4	16	60.0	0.38	22
371	"	Front Wall Reinf	"	15'-3"	4	2	8	122.0	"	44
380	<u>19'-6"</u>	"	"	19'-6"	2	2	4	78.0	"	28
381		Rear Curtain Wall.	"	8'-6"	9	2	18	153.0	"	55
382	<u>12'-6"</u>	"	"	12'-6"	4	2	8	100.0	"	36
466		"	$\frac{1}{2}^{\prime\prime}\phi$	13'-7"	11	2	22	298.76	0.68	200
383	<u>19'-6"</u>	"	$\frac{3}{8}^{\prime\prime}\phi$	19'-6"	2	2	4	78.0	0.38	30
384		"	"	1'-9"	20	2	40	70.0	"	26
385	<u>Varies Av. 9'-6"</u>	"	"	Varies Av. 9'-6"	19	2	38	361.0	"	130
467	<u>Varies Av. 15'-7"</u> 6" 	"	$\frac{1}{2}^{\prime\prime}\phi$	Varies Av. 16'-7"	21	2	42	696.36	0.68	470
386	<u>10'-6"</u>	"	$\frac{3}{8}^{\prime\prime}\phi$	10'-6"	24	2	48	504.0	0.38	190
517	<u>Varies Av. 47'-2"</u> 	W.W. at L End of Br. Footing	$\frac{5}{8}^{\prime\prime}\phi$	Varies Av. 49'-0"	8	1	8	392.0	1.06	41
518		"	"	Varies Av. 59'-3"	7	1	7	414.75	"	44
519		"	"	Varies Av. 55'-2"	8	1	8	441.36	"	46
365	<u>7'-6"</u>	"	$\frac{3}{8}^{\prime\prime}\phi$	7'-6"	2	2	4	592.50	0.38	220
450		"	$\frac{1}{2}^{\prime\prime}\phi$	12'-6"	5	6	30	375.0	0.68	250
710	See Sketch	"	$\frac{7}{8}^{\prime\prime}\phi$	31'-1"	3	6	18	559.44	2.07	115
711	"	"	"	22'-3"	2	6	12	267.0	"	55
712	"	"	"	16'-4"	2	6	12	195.96	"	40
451	"	"	$\frac{1}{2}^{\prime\prime}\phi$	6'-0"	2	6	12	72.0	0.68	5
452	"	"	"	3'-0"	2	6	12	36.0	"	2
453	"	"	"	8'-15"	1	6	6	53.52	"	3

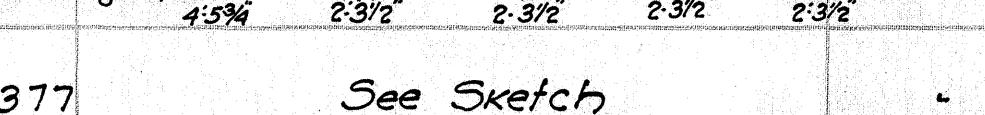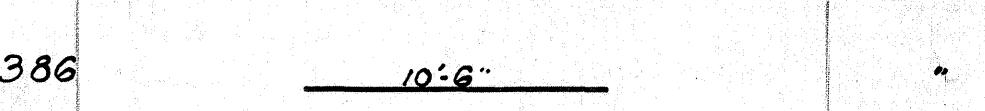
MK	DESCRIPTION	LOCATION	SIZE	LENGTH	Bars in each unit	No of units	Total No of bars	Total Length	Weight per foot	Total Weight
366	See Sketch	N.W. at L End of Br. Col.	3/8"	30'-9"	3	6	18	553.50	0.38	210
367	"	"	"	11'-9"	17	6	102	1198.50	"	455
368	"	"	"	8'-0"	9	6	54	432.0	"	164
369	"	"	"	6'-0"	6	6	36	216.0	"	82
713	"	"	7/8"	10'-0"	5	6	30	300.0	2.07	621
370	"	"	3/8"	3'-9"	4	6	24	90.0	0.38	34
371	"	Front Wall Reinf.	"	15'-3"	35	1	35	533.75	"	203
373a	<u>57'-0"</u>	"	"	57'-0"	2	1	2	114.0	"	43
374a	<u>44'-6"</u>	"	"	44'-6"	8	1	8	356.0	"	135
515a	<u>40'-2"</u>	Rear Curtain Wall	5/8"	40'-2"	4	1	4	160.68	1.06	170
454a	<u>39'-10" 8"</u>	"	1/2"	41'-2"	8	1	8	329.36	0.68	224
455a		"	"	42'-6"	5	1	5	212.50	"	145
377	See Sketch	"	3/8"	8'-6"	34	1	34	289.0	0.38	110
461a	<u>Varies Av. 48'-3"</u>	"	1/2"	Varies Av. 48'-3"	8	1	8	386.0	0.68	262
460a		"	"	Varies Av. 49'-11"	7	1	7	349.44	"	238
386	<u>10'-6"</u>	"	3/8"	10'-6"	50	1	50	525.0	0.38	200
372	<u>Varies Av. 7'-0" 3"</u> <u>1'-9"</u>	Front Wall	"	Varies Av. 9'-0"	11	1	11	99.0	"	38
373b	<u>Varies Av. 55'-6"</u>	"	"	Varies Av. 55'-6"	10	1	10	555.0	"	211
387a	<u>57'-0"</u>	WW.Coping	"	57'-0"	2	1	2	114.0	"	43
384	See Sketch	"	"	1'-9"	58	1	58	101.5	"	39
371a	<u>Av 7'-3"</u> <u>3"</u> <u>1'-9"</u>	Front Wall Small WW.	"	Varies Av 9'-3"	12	2	24	222.0	"	84
380a	<u>Varies Av. 13'-0"</u>	"	"	Varies Av. 13'-0"	9	2	18	234.0	"	89
380b	<u>5'-0"</u>	" Beam Small WW.	"	5'-0"	8	2	16	80.0	"	30
380c	<u>18'-0"</u>	"	"	18'-0"	8	2	16	288.0	"	199
384	<u>7"</u> <u>7"</u>	Small WW. WW.Coping R@ beg. of Br.	"	1'-9"	78	1	78	136.0	"	52
387	<u>77'-0"</u>	"	"	77'-0"	2	1	2	154.0	"	59
438A	<u>4'-2"</u> <u>J-4"</u>	SUPERSTR. Special side- " "	1/2"	6'-2"	13	2	26	160.42	0.68	109

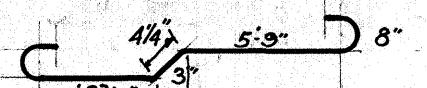MK	DESCRIPTION	LOCATION	SIZE	LENGTH	Bars in each unit	No. of units	Total No. of bars	Total Length	Weight per foot	Total Weight.
480	 Br. Slab		1/2"	8'-9"	4	16	64	560.0	0.86	482

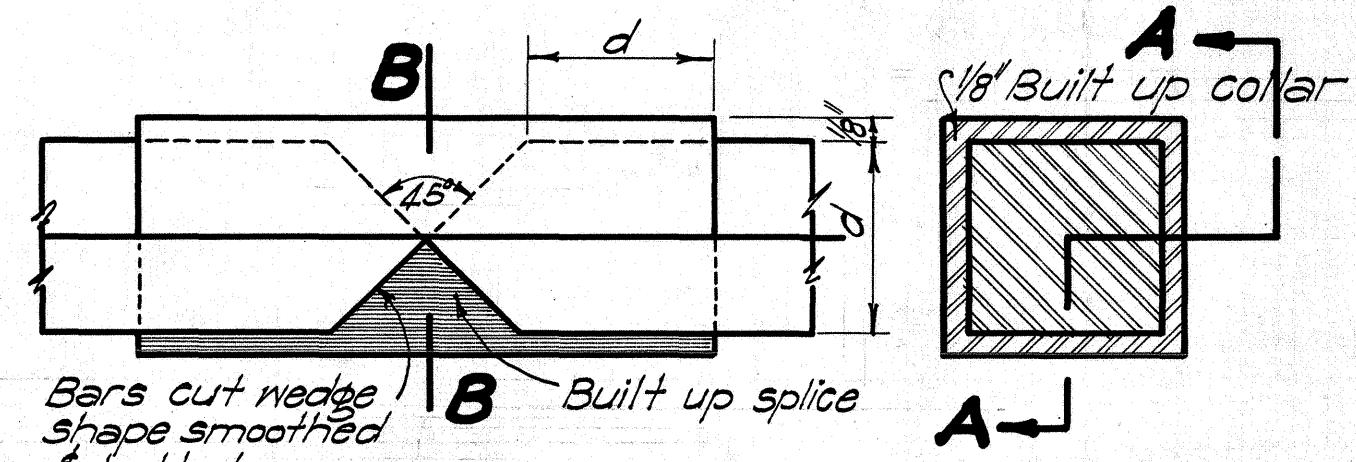

SECT. A-A SECT. B-B

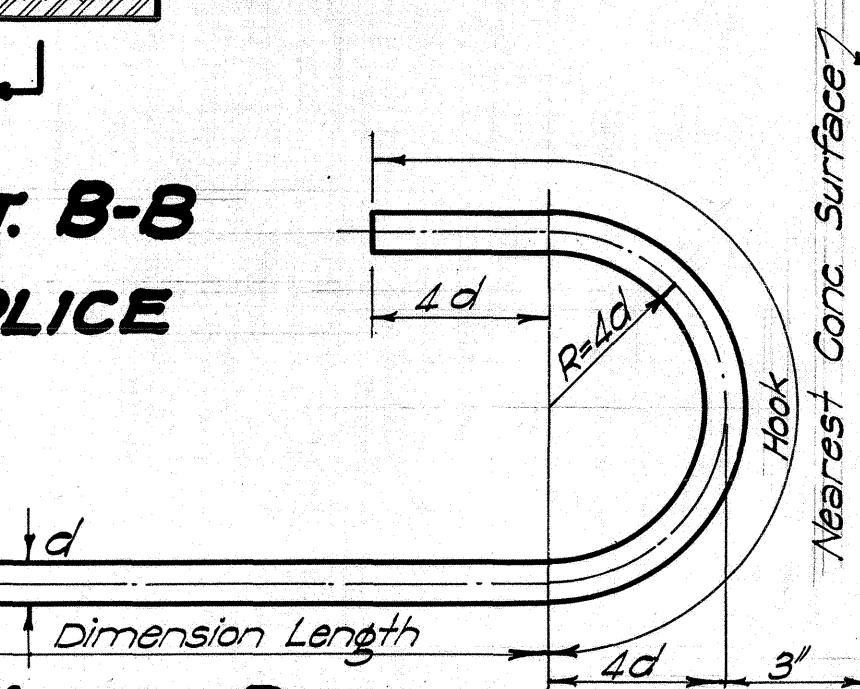DETAIL OF REIN. BAR SPLICE



HOOK DETAIL

TERRITORIAL HIGHWAY DEPARTMENT.
TERRITORY OF HAWAII.

WAHIAWA BRIDGE.

40 6 STA. 80+74 TO STA. 82+56.
NORTH ROAD NEW YORK

KAUAI BELT ROAD N.R.H. 12-B.
DATE June 1935 SHEET 17 OF 17 SHEETS

DATE June 1993 SHEET 1 / OF 1 / SHEETS.

4 3333.25

Digitized by srujanika@gmail.com

43333.25