



F. S. C. B.  
J. M. B.

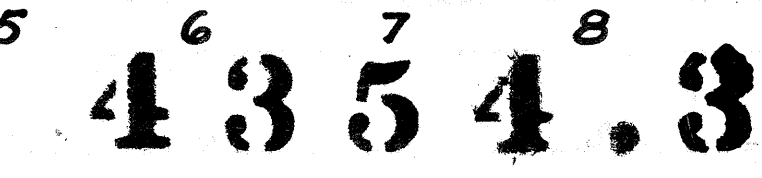

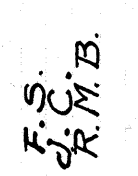

Note! Center-Line Boundary Monuments at each P.C. and RT.

# GROVE FARM

# C<sup>o</sup>, LTD.

REVISED DATA  
 $\Delta = 35^\circ - 05'$   
 $R = 2000'$   
 $T = 632.20'$   
 $L = 1224.64'$

Side Roads  
 B.C. = 135 sq. yds. Exc. = 20 cy.  
 No. 2 Rock 16.9 Tons  
 No. 3 Rock 2.07 "  
 No. 5 Rock 0.93 "  
 Bit. Binder 1.7 "

STA. 231 + 50  
 24-inch Circ. Conc. Culvert  
 64 ft. Long. 2-C.H.W.

STA. 234 + 85 8' x 8'-2 1/2"  
 Conc. Double Box Culvert or  
 12'-0" Masonry Arch Culvert See details

STA. 214 + 90  
 Ind. Track Crossing  
 75 ft. Long.

B.M. No 14. Elev. 468.14  
 Cross on conc. base of conc. fence  
 right Sta. 213 + 40. and right of  
 present road.

B.M. No 15 Elev. 430.99  
 Spike driven in telephone post  
 right Sta. 231 + 25. and left of  
 present road.

STA. 239 + 50  
 24-inch Circ. Conc. Culvert  
 64 ft. Long. 2-C.H.W.

Side Road 16-Ft. wide  
 Uncl. Exc. 500 c.y.  
 Base Course 160 sq. yds.  
 No. 2 Rock 17 c.y.  
 No. 3 Rock 3 c.y.  
 No. 5 Rock 1 c.y.  
 Bit. Binder 1 ton.

Sta. 239 + 80  
 Ind. Track Crossing  
 30 Ft. Long.

Note! Revisions to above curve.  
 Res. Engr. is to modify grades  
 accordingly and calculate cor-  
 rected quantities.

Note:-  
 Contractor shall construct as an  
 incidental necessary road along  
 new right of way for this purpose

Note:-  
 Contractor shall use excess  
 exc. on F.A. Proj. No. 126 to  
 construct roadway prism  
 from Sta. 231 + 00 to 234 + 50  
 or as much further as avail-  
 able material permits. Open-  
 ings in emb. to be left for  
 structures.

