


| INDEX TO DRAWINGS |                                         |
|-------------------|-----------------------------------------|
| Sheet No.         | Description                             |
| 1                 | Title Sheet                             |
| 2                 | Typical Road Sections                   |
| 3-6               | Plan and Profile                        |
| 7-8 9             | Standard Details Nos 1, 2 & 3           |
| 11-10             | Culvert Details - There is No Sheet #10 |
| 12                | Bridge No 7 G.                          |
| 13-24             | Cross Sections                          |
| 12-25             |                                         |
|                   |                                         |
|                   |                                         |

TERRITORY OF HAWAII  
TERRITORIAL HIGHWAY DEPARTMENT  
HONOLULU, T. H.

PLANS OF  
**KAUAI BELT ROAD**  
U.S. WORKS PROGRAM HIGHWAY PROJECT NO. VPH 12-H  
HAWAII PROJECT NO.12-H  
DISTRICTS OF KOLOA AND LIHUE  
KAUAI, T.H.


| CONVENTIONAL SIGNS         |               |
|----------------------------|---------------|
| Edge of existing Road      | -----         |
| Existing Fence             | - x - x - x - |
| Boundary Line (not fenced) | -----         |
| Existing Stone Wall        | =====         |
| Railroad                   | +++++         |
| Center Line                | =====         |
| Future Pavement            | =====         |
| Cement Rubble Masonry Wall | =====         |
| Bridges                    | =====         |

| SCALES         |      |                   |
|----------------|------|-------------------|
| PLANS          |      | 1 INCH = 100 FEET |
| PROFILE        | HOR. | 1 INCH = 100 FEET |
|                | VERT | 1 INCH = 20 FEET  |
| CROSS SECTIONS |      | 1 INCH = 10 FEET  |

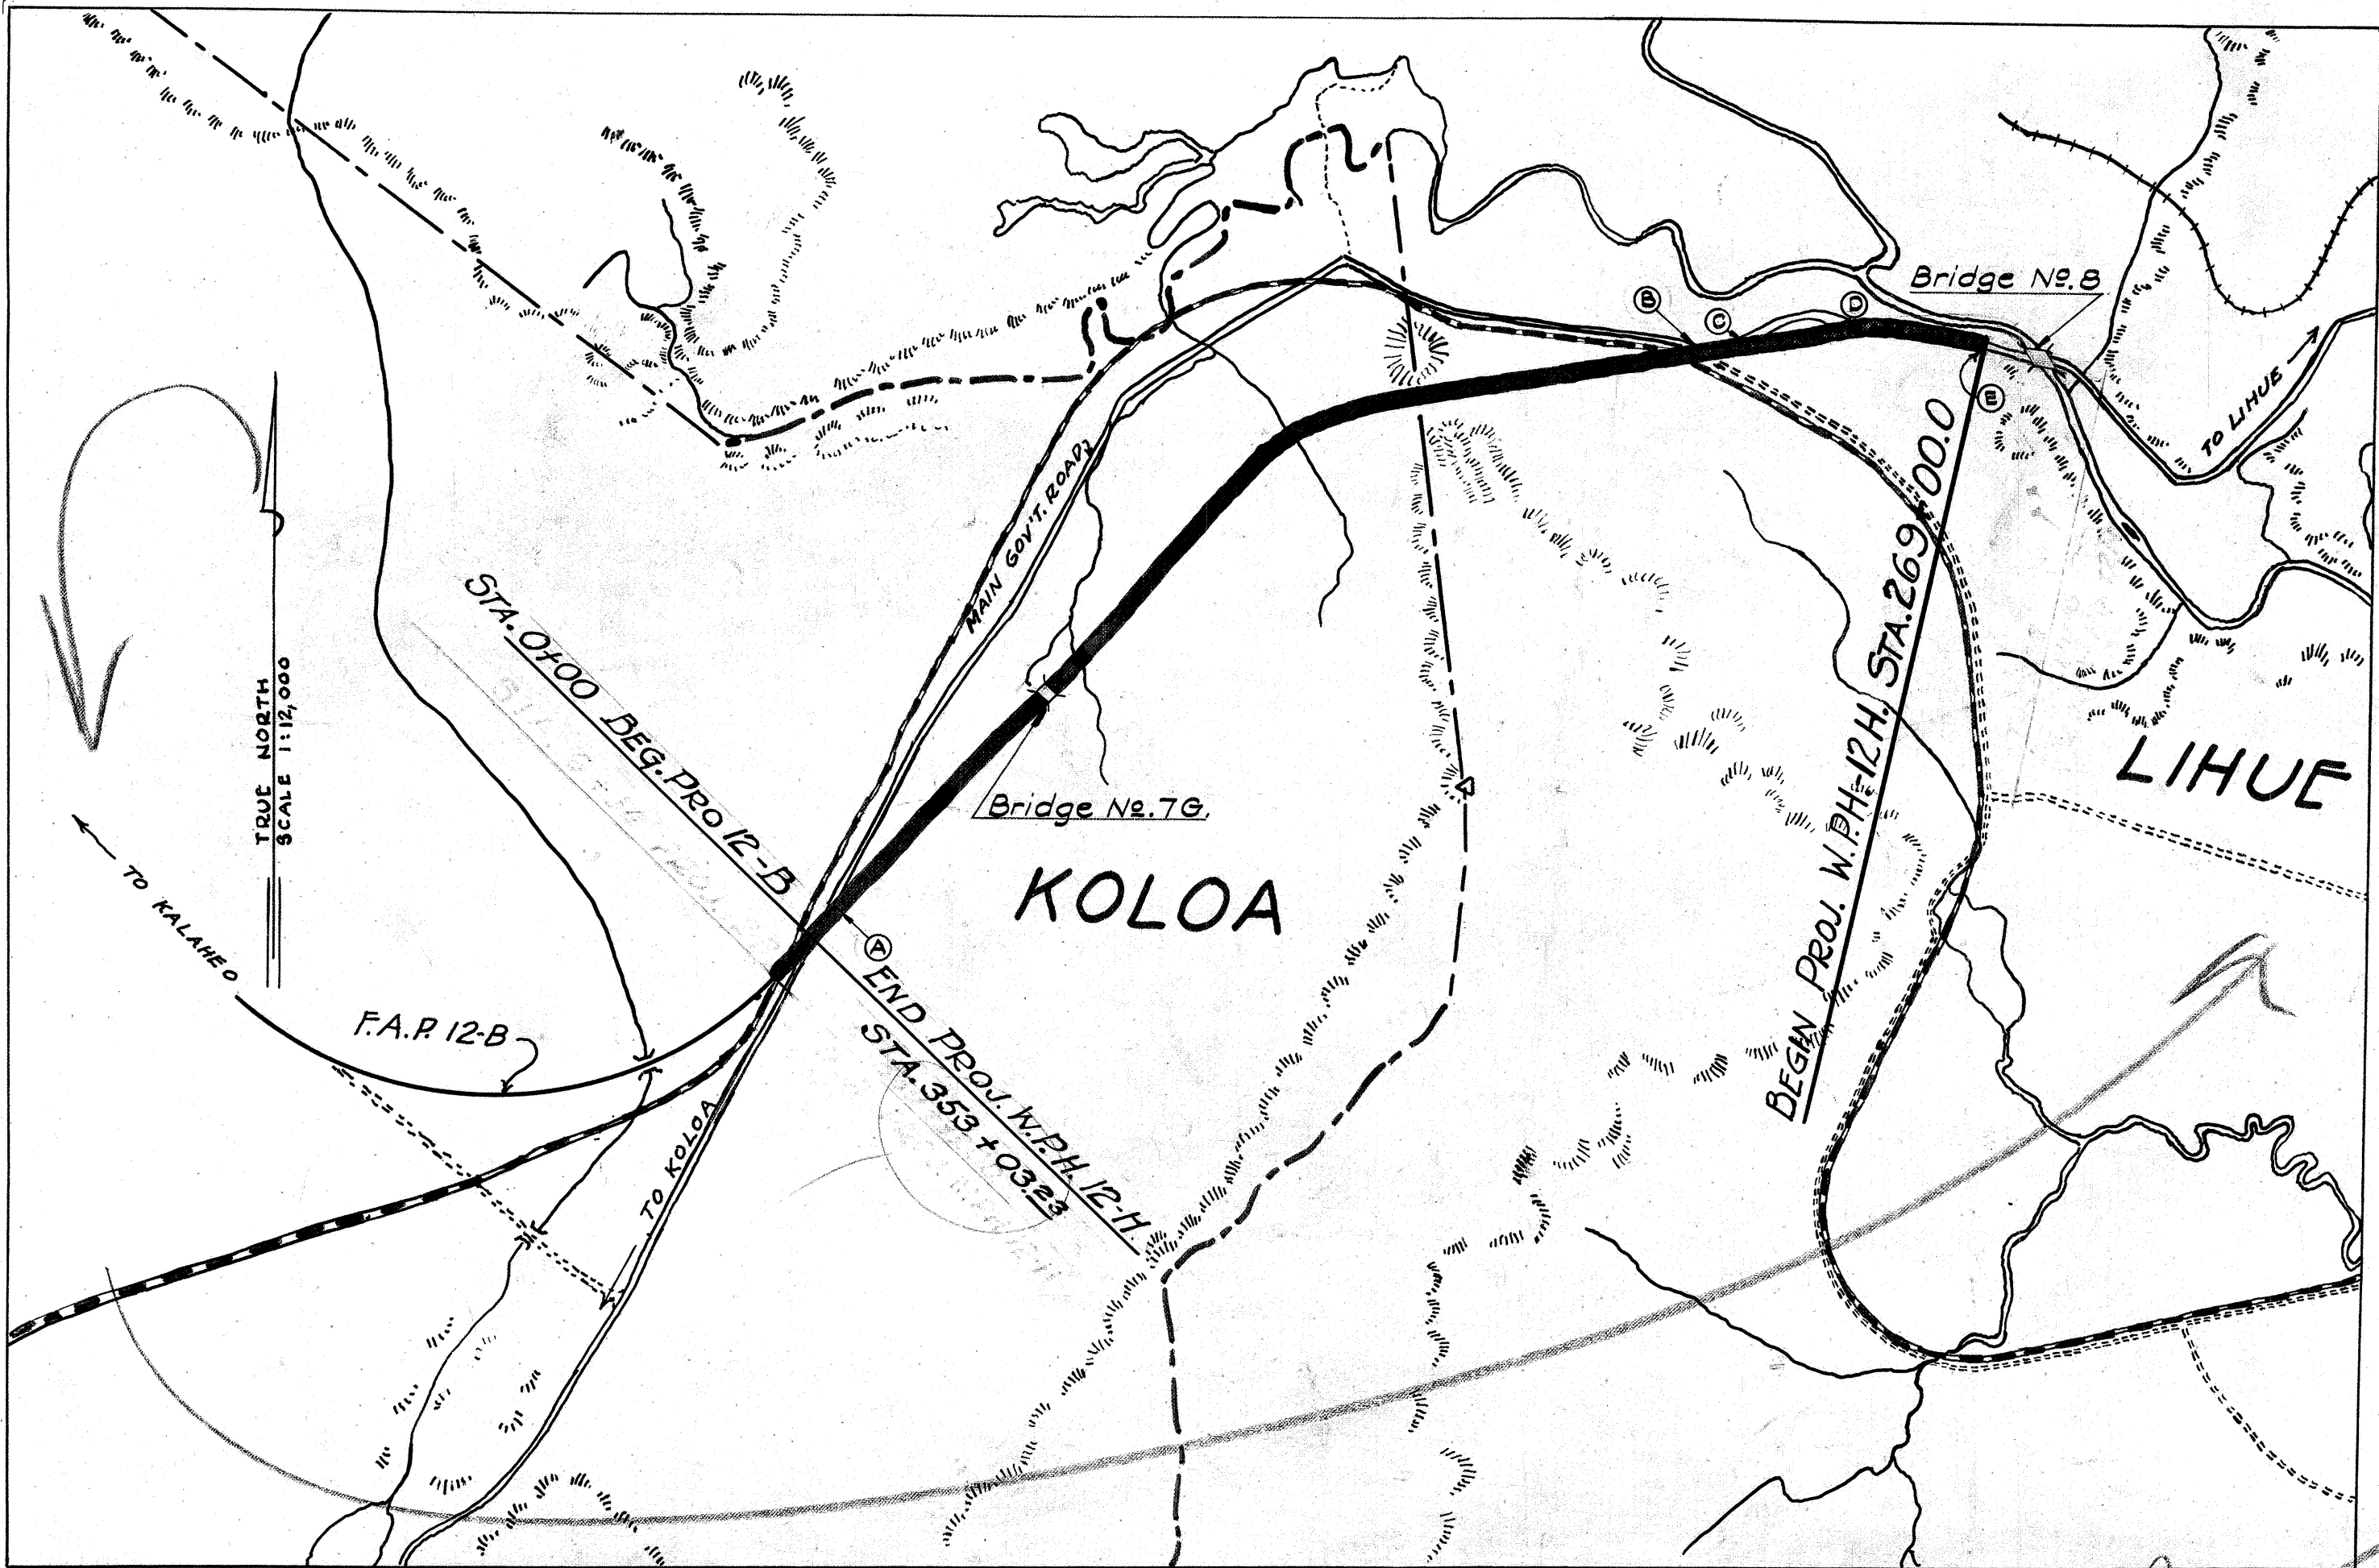

LAYOUT OF PROJECT

|                            |             |
|----------------------------|-------------|
| Gross Length of Project    | 1.592 Miles |
| Bridges (over 20 ft. Span) | 0.007 "     |
| Net Length Roadway         | 1.585 "     |

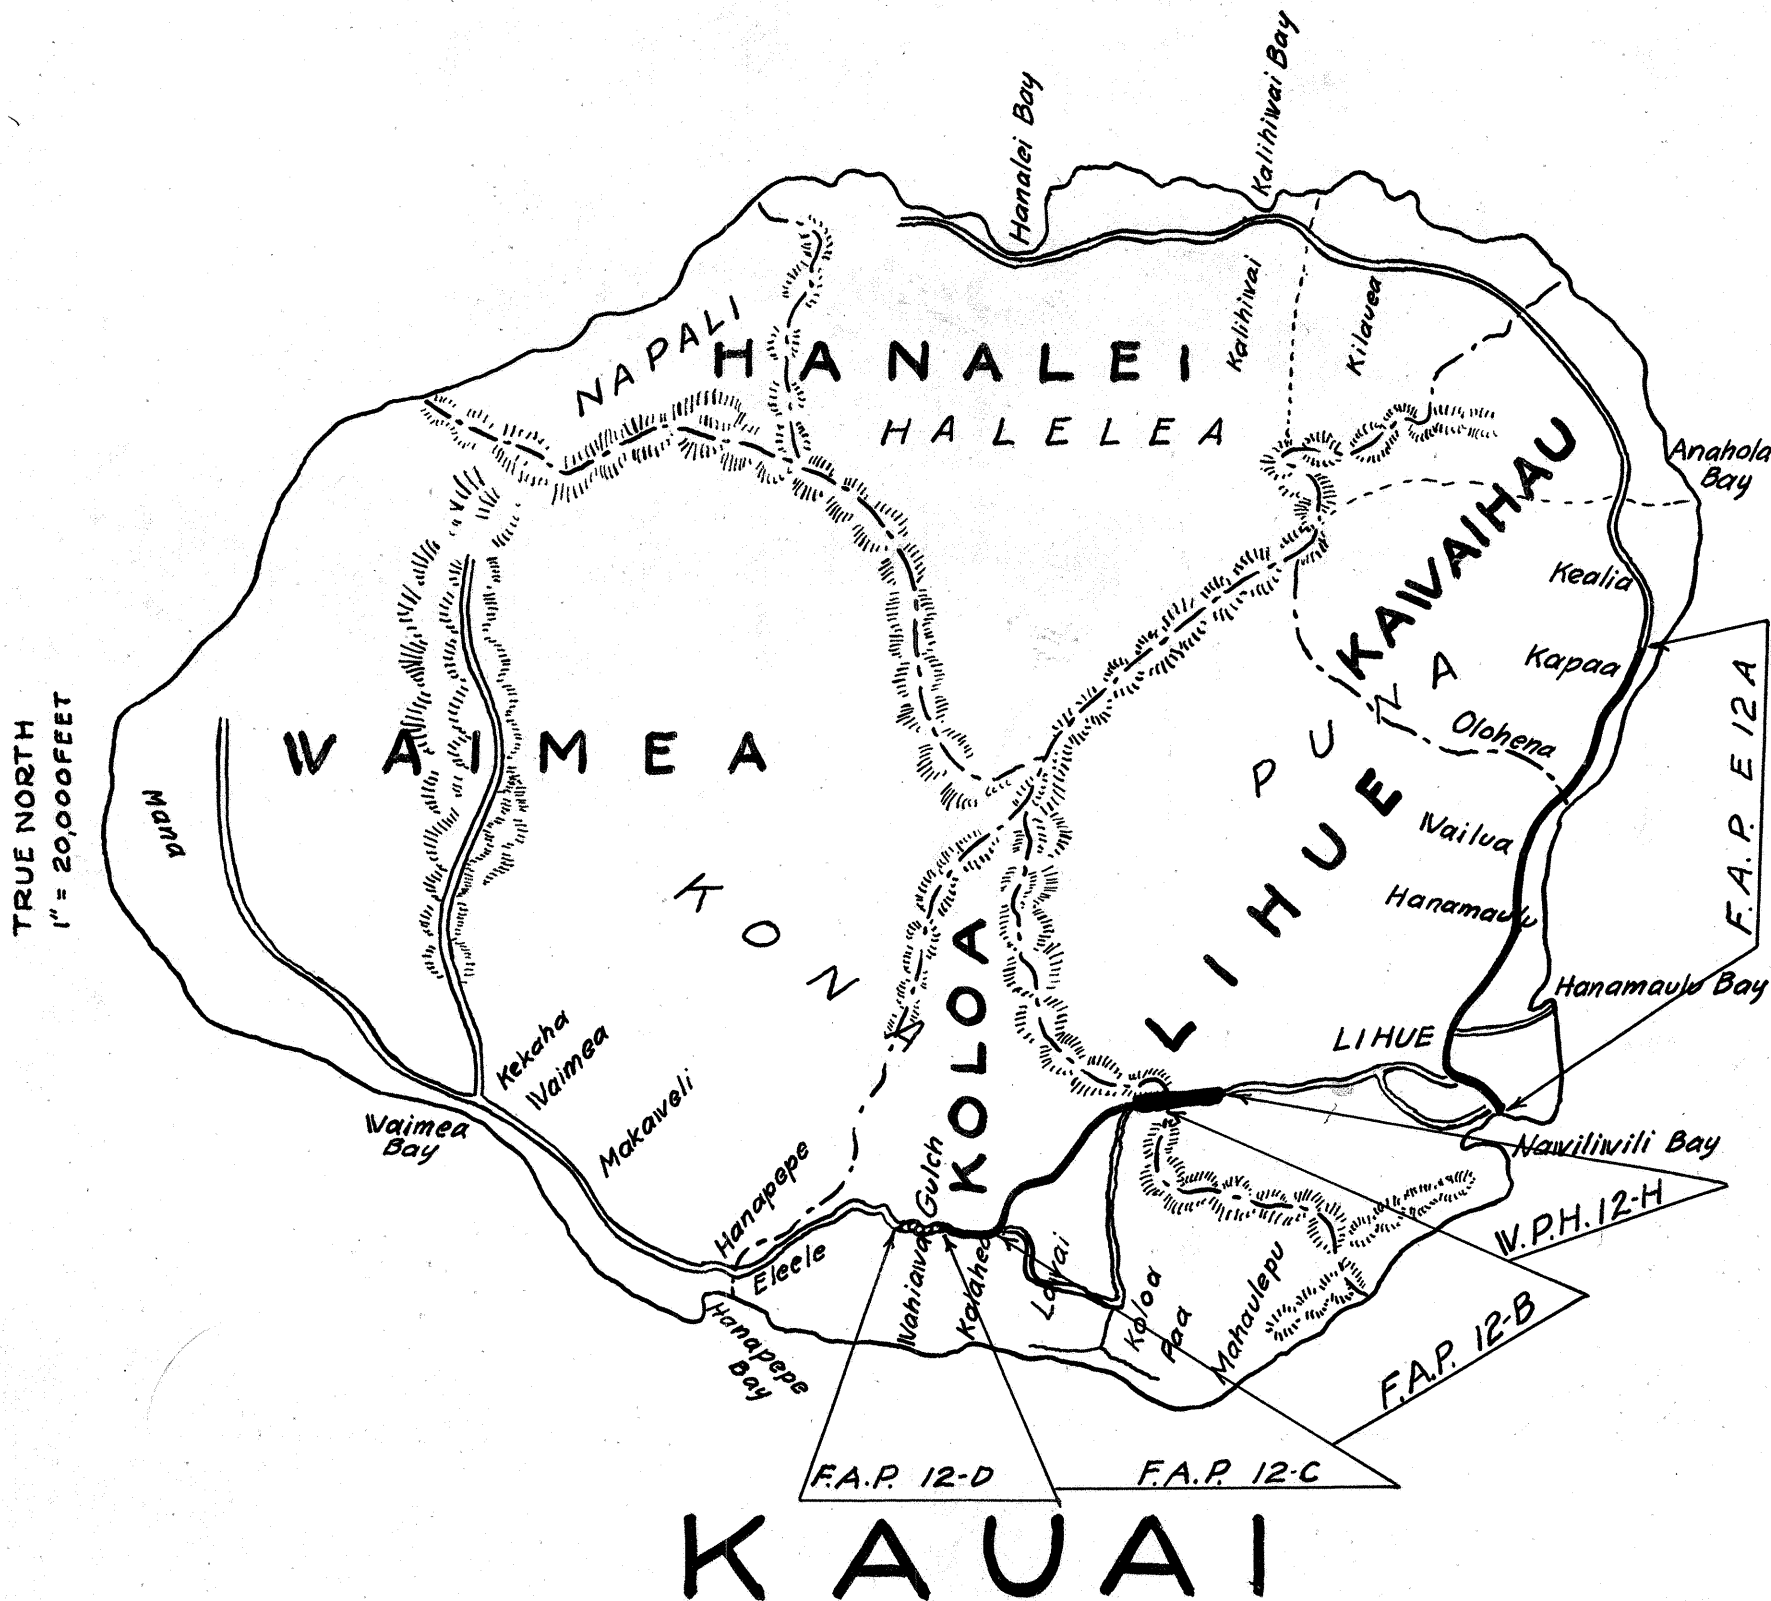

RECOMMENDED FOR APPROVAL  
\_\_\_\_\_  
PRINCIPAL HIGHWAY ENGINEER  
Bureau of Public Roads

RECOMMENDED FOR APPROVAL  
\_\_\_\_\_  
CHIEF ENGINEER Bureau of Public Roads

APPROVED  
*Louis B. Cain* 11/30/54  
TERRITORIAL HIGHWAY ENGINEER

APPROVED  
\_\_\_\_\_  
DIRECTOR Bureau of Public Roads