


Revised By: J.C.M. & F.C. Feb 1936.
as per R.M.B.'s letter of Jan. 18, 1936.
Rev. by J.C.M. Mar. 1936 (Br. length changed)

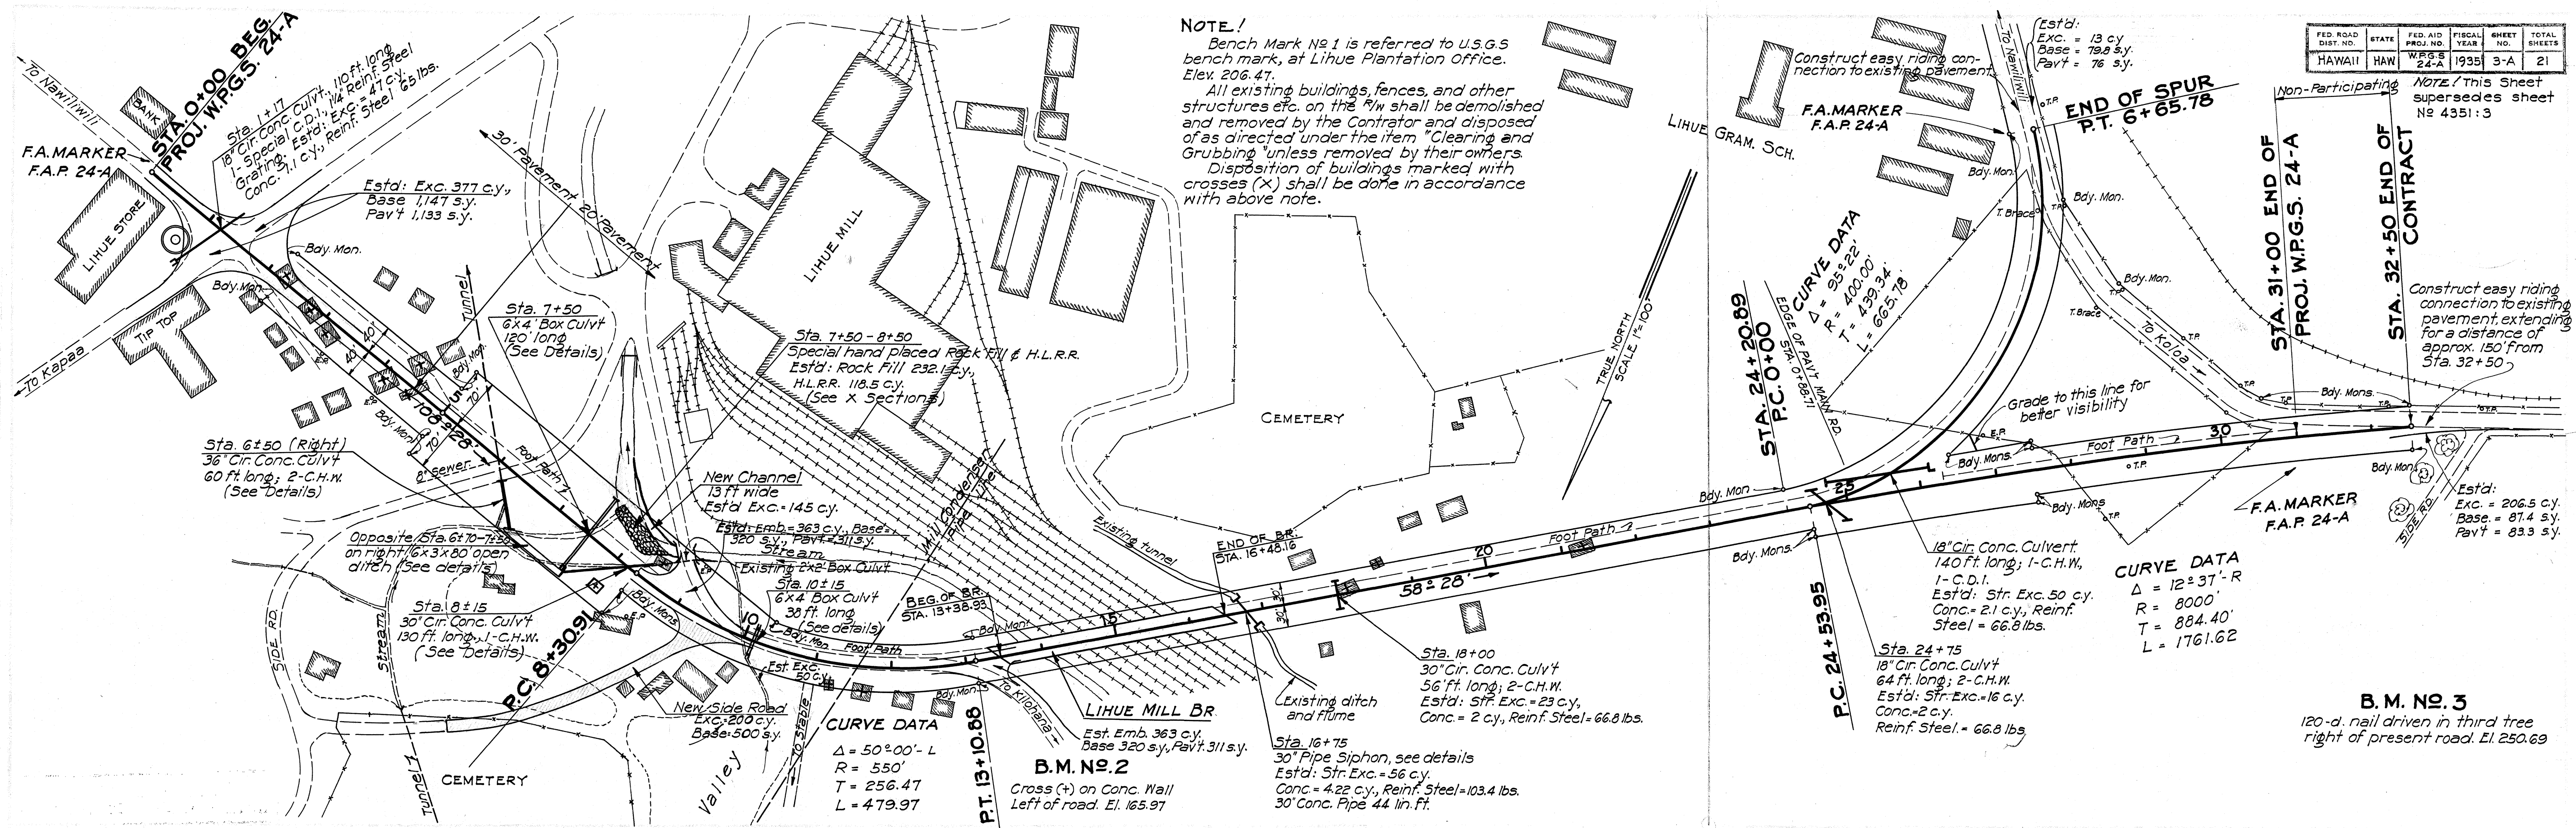

NOTE.
Bench Mark No 1 is referred to U.S.G.S bench mark, at Lihue Plantation Office. Elev. 206.47.
All existing buildings, fences, and other structures etc. on the R/W shall be demolished and removed by the Contractor and disposed of as directed under the item "Clearing and Grubbing" unless removed by their owners. Disposition of buildings marked with crosses (X) shall be done in accordance with above note.

FED. ROAD DIST. NO.	STATE	FED. AID PROJ. NO.	FISCAL YEAR	SHEET NO.	TOTAL SHEETS
HAWAII	HAW	W.P.G.S. 24-A	1935	3-A	21

NOTE: This Sheet supersedes sheet No 4351.3

— LIST OF COMMON ABBREVIATIONS —

- C.R.M. Cement Rubble Masonry.
- D.R.M. Dry Rubble Masonry.
- C.R.M.P. Cement Rubble Masonry Paving.
- H.L.R.R. Hand Laid Rip-Rap.
- W. Wall.
- Conc. Culv't. Circular Conc. Culv't which is either (a) Cast in place circ. conc. culv't or (b) Conc. Pipe Culv't.
- Box Culv't. Various reinf. conc. box culv'ts as detailed.
- C.D.I. Concrete Drop Intake
- M.D.I. Masonry Drop Intake
- C.H.W. Concrete Headwall
- M.H.W. Masonry Headwall
- ⊙ Large Tree
- T.P. Telephone Pole
- E.P. Electric Pole

