


R. M. BELT

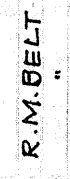

Traced by: James Lowe Jan. 1937

4390.3



PLAN	SURVEYED	BY	DATE
	PLOTTED	R. M. BELT	
NOTE BOOK	ALIGNMENT CHECKED	"	
NO	RT. OF WAY CHECKED	"	

PROFILE	SURVIVED	BY	DATE
NOTE BOOK	PLOTTED	"	
	CRABES CHECKED	"	
	B. L. S. NOTED	"	
NO.	STRUCTURE NOT AT TUS CH		



FED. ROAD DIST. NO.	STATE	FED. AID PROJ. NO.	FISCAL YEAR	SHEET NO.	TOTAL SHEETS
HAWAII	HAW.	12-F	1937	5	29

B.M. #9 EL. 286.90
Spike in Telephone Pole, approx. 50' to left of Sta. 124+50

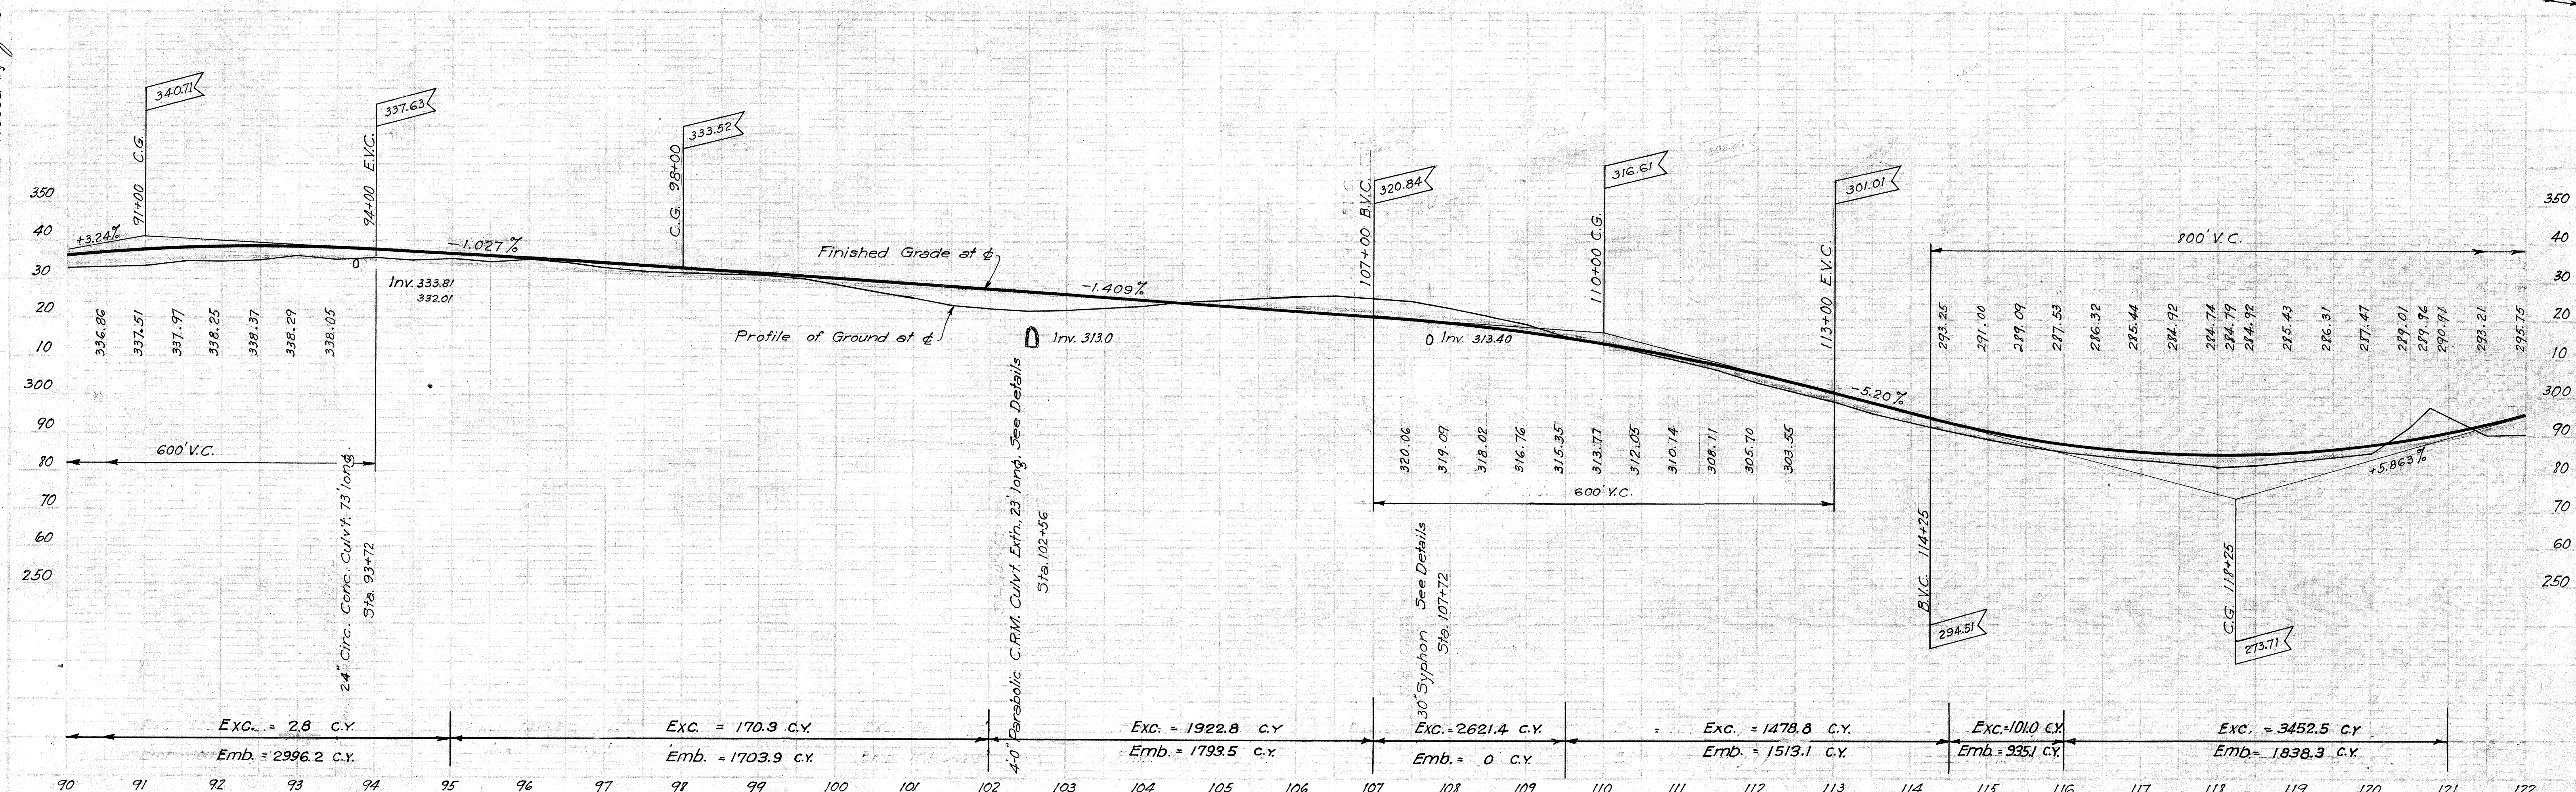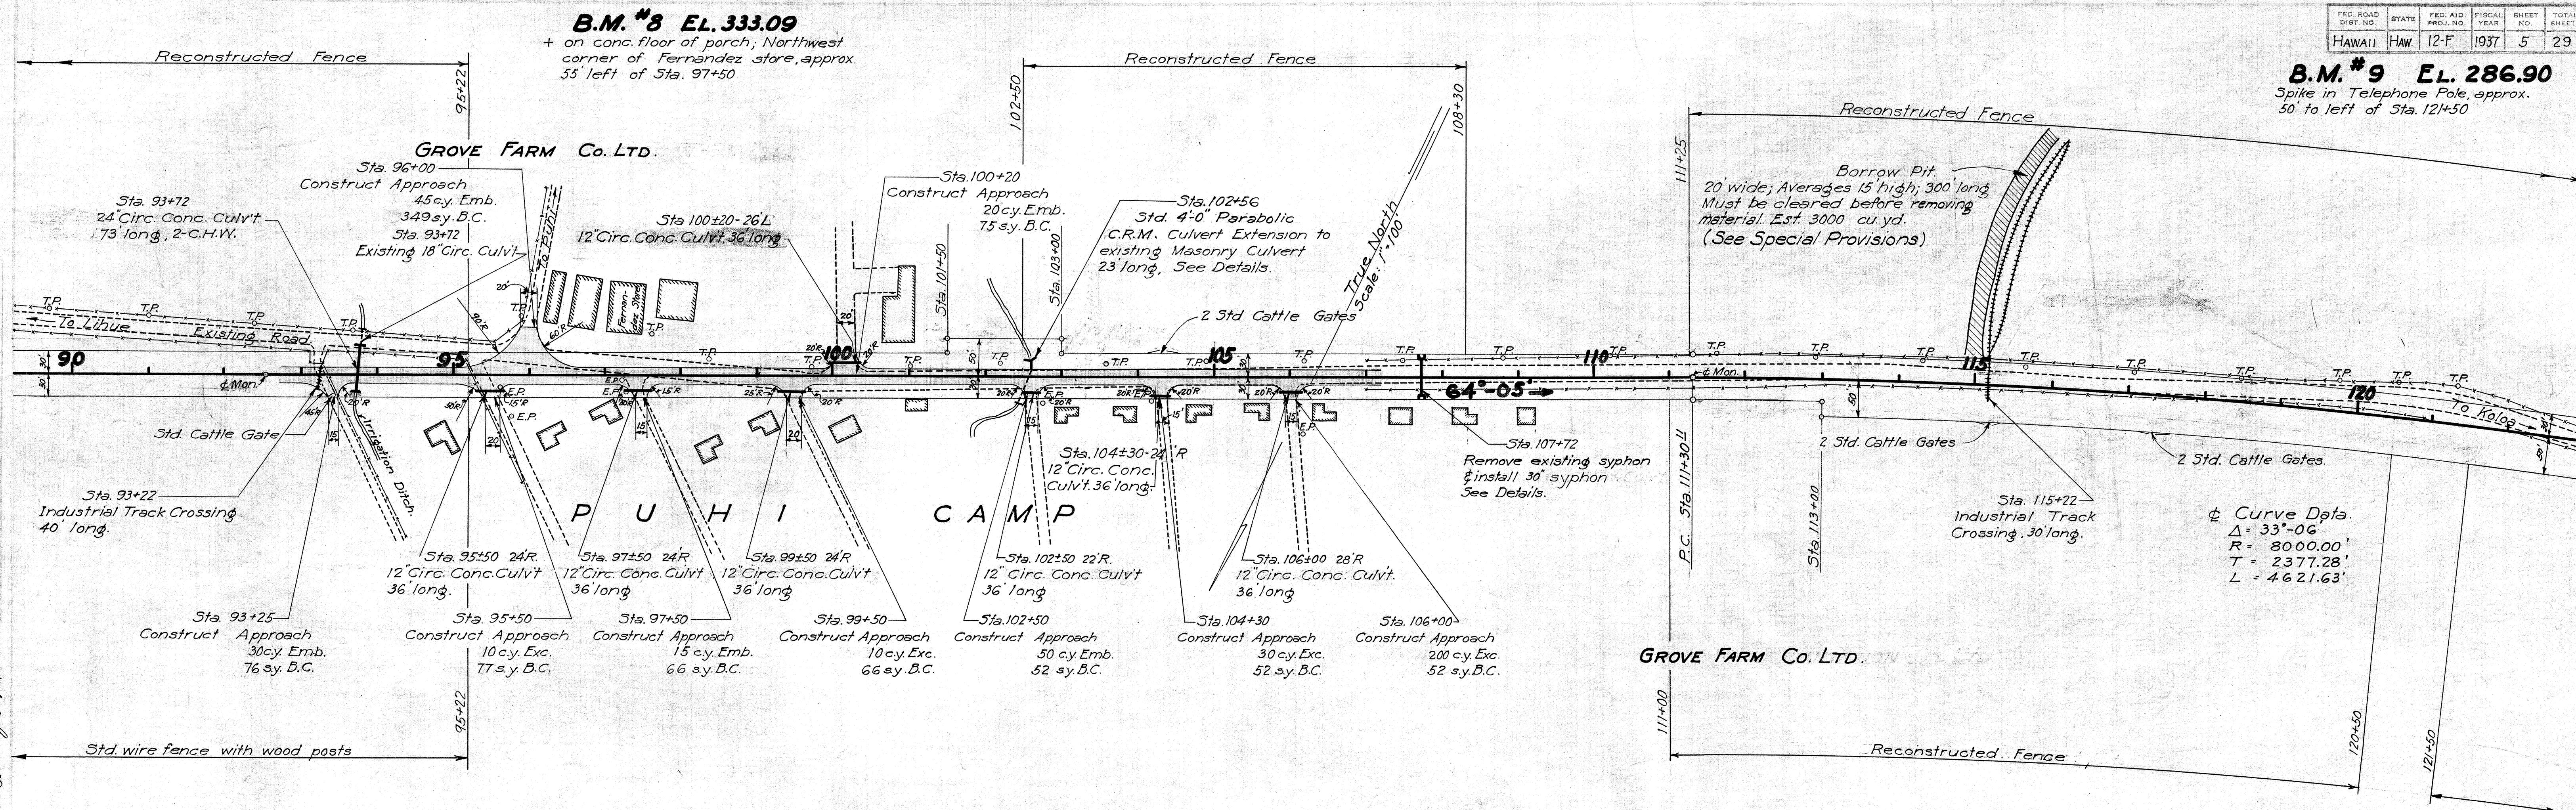

4390.5

PLAN
DATE
R.M. BELT
NOTED BOOK CHECKED
NOTE BOOK CHECKED

PROFILE
DATE
R.M. BELT
NOTED BOOK CHECKED
NOTE BOOK CHECKED

Traced by: James G. Shaw Jan. 1937

