


FED. ROAD DIST. NO.	STATE	FED. AID PROJ. NO.	FISCAL YEAR	SHEET NO.	TOTAL SHEETS
HAWAII	HAW	126(2)	1938	4	4

GROVE FARM CO., LTD.

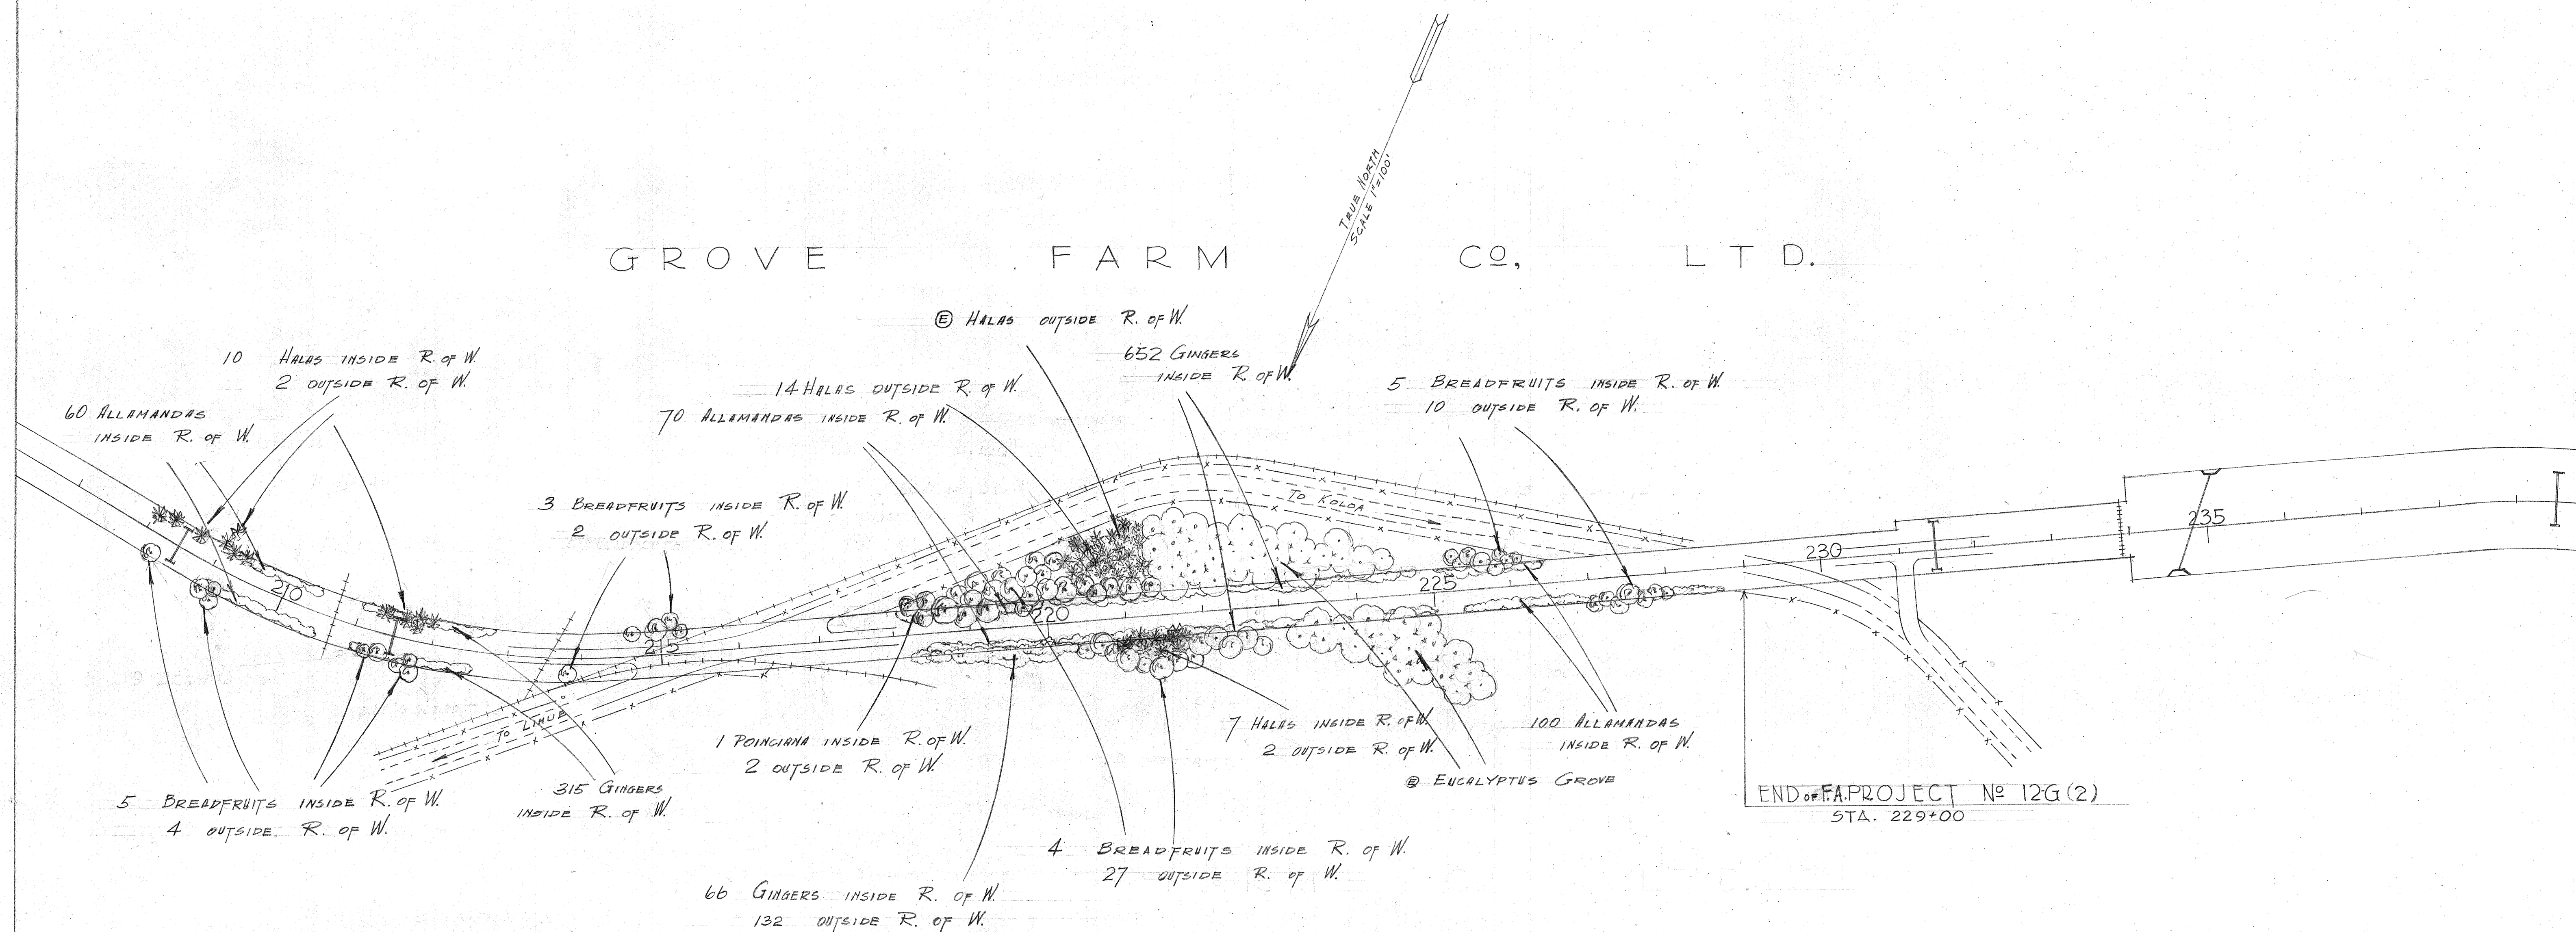

PROJ. NO. - F.A.P. 12-G(2) SHEET NO. 2

4447.4