
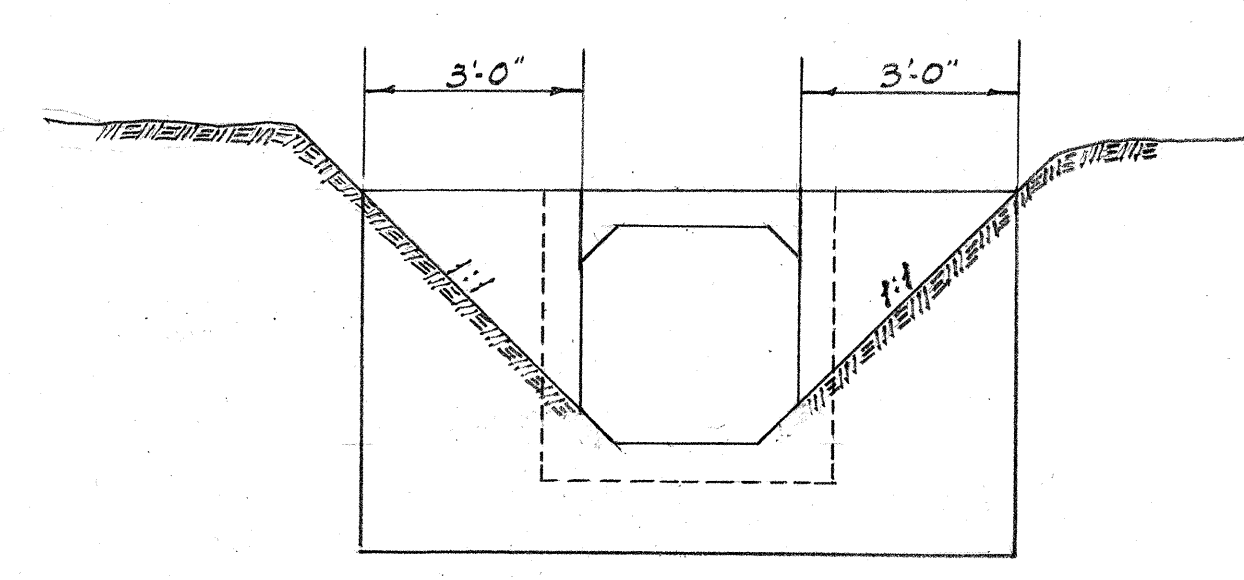
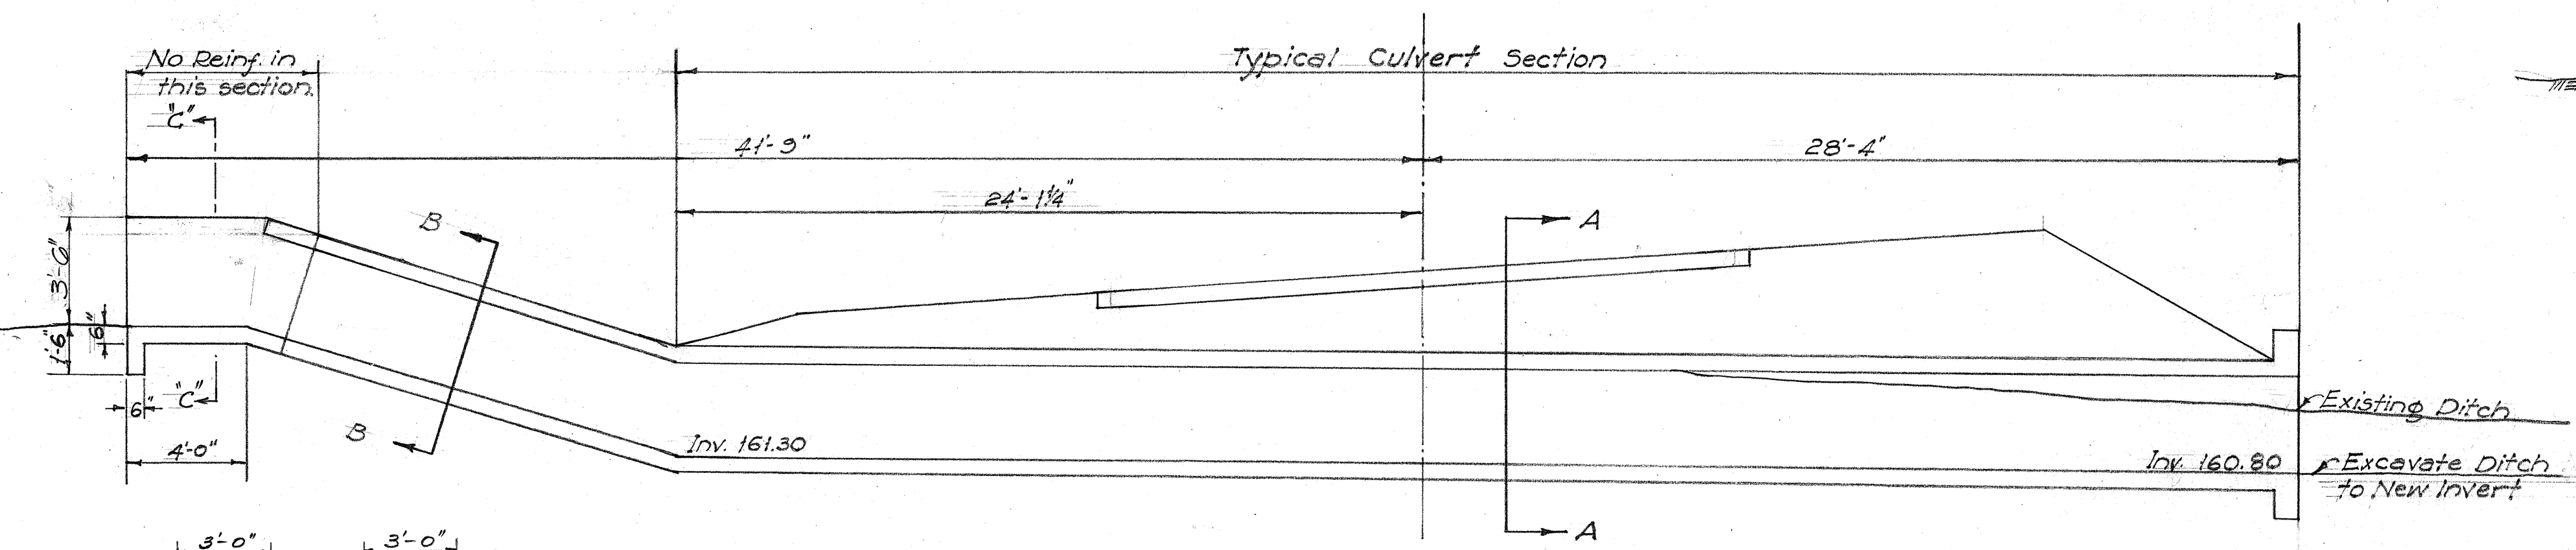
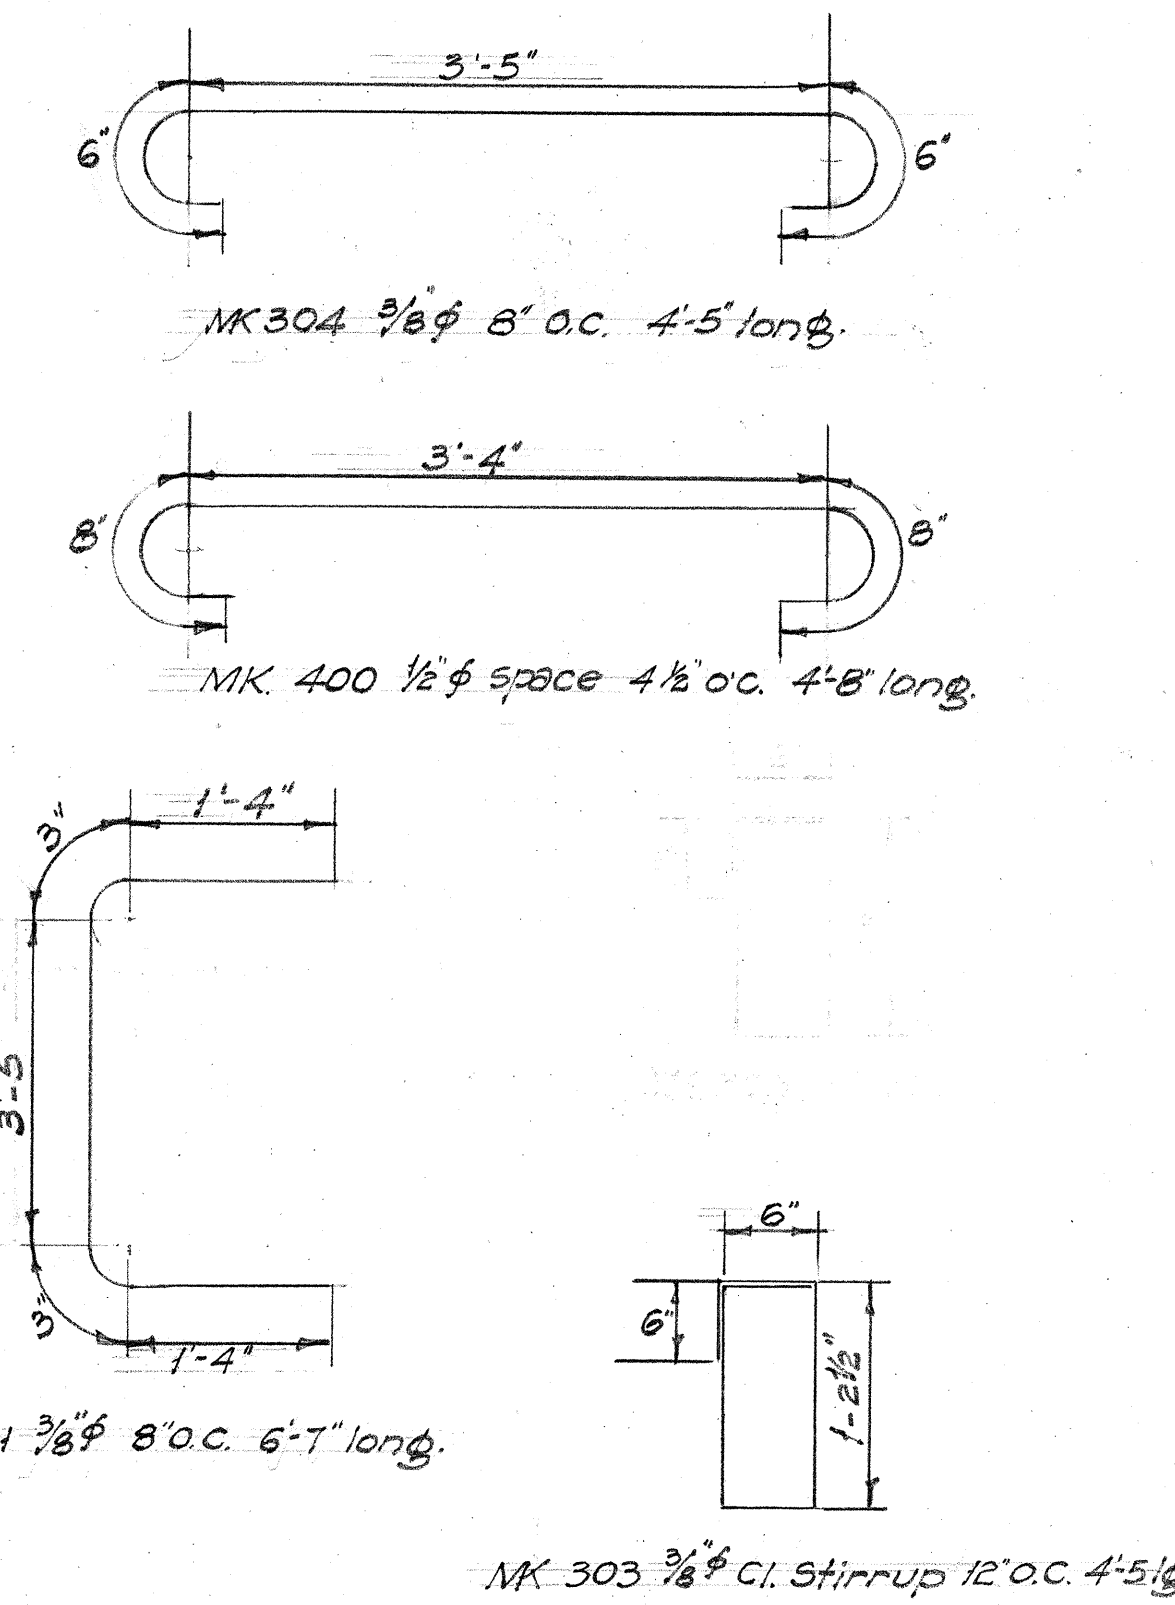
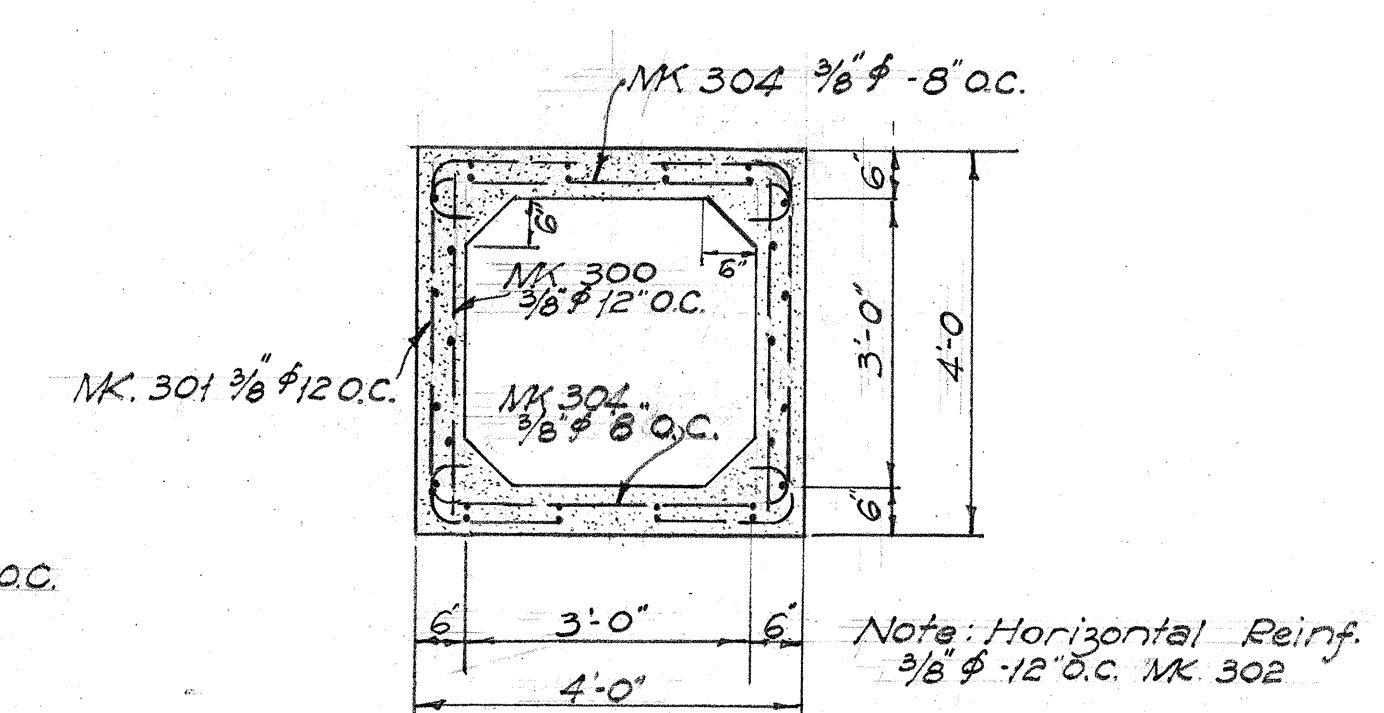
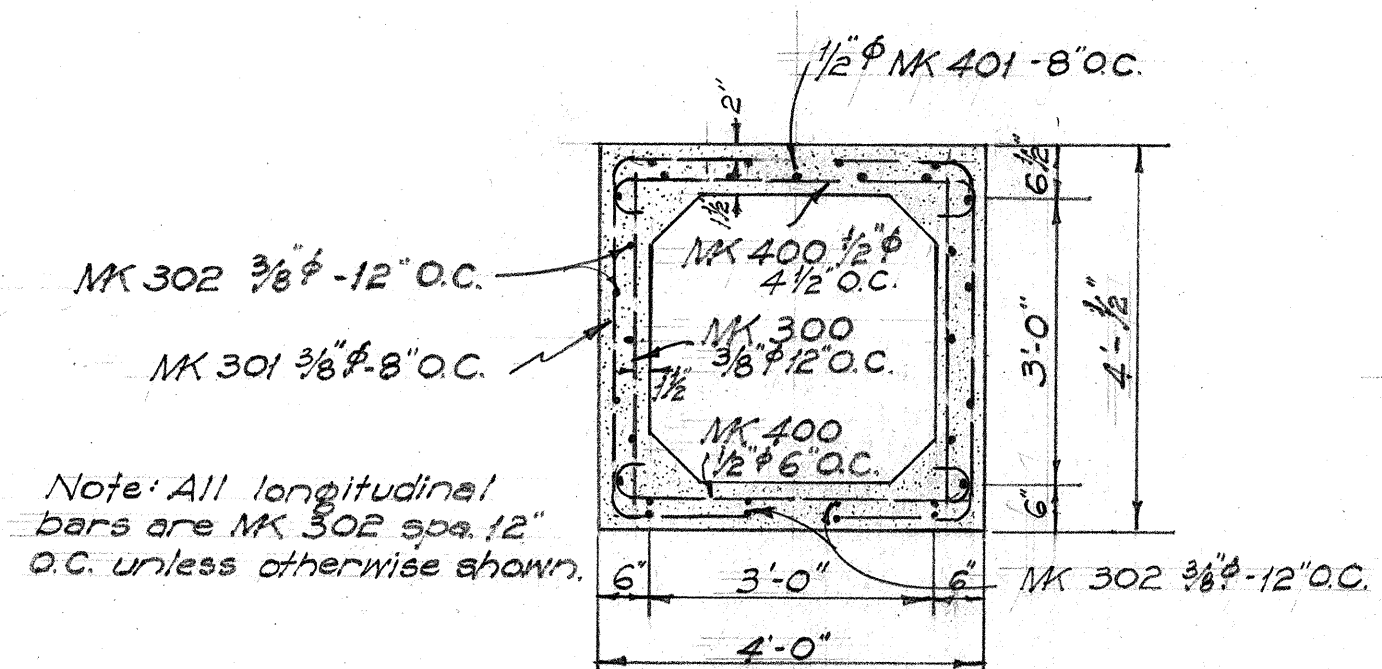
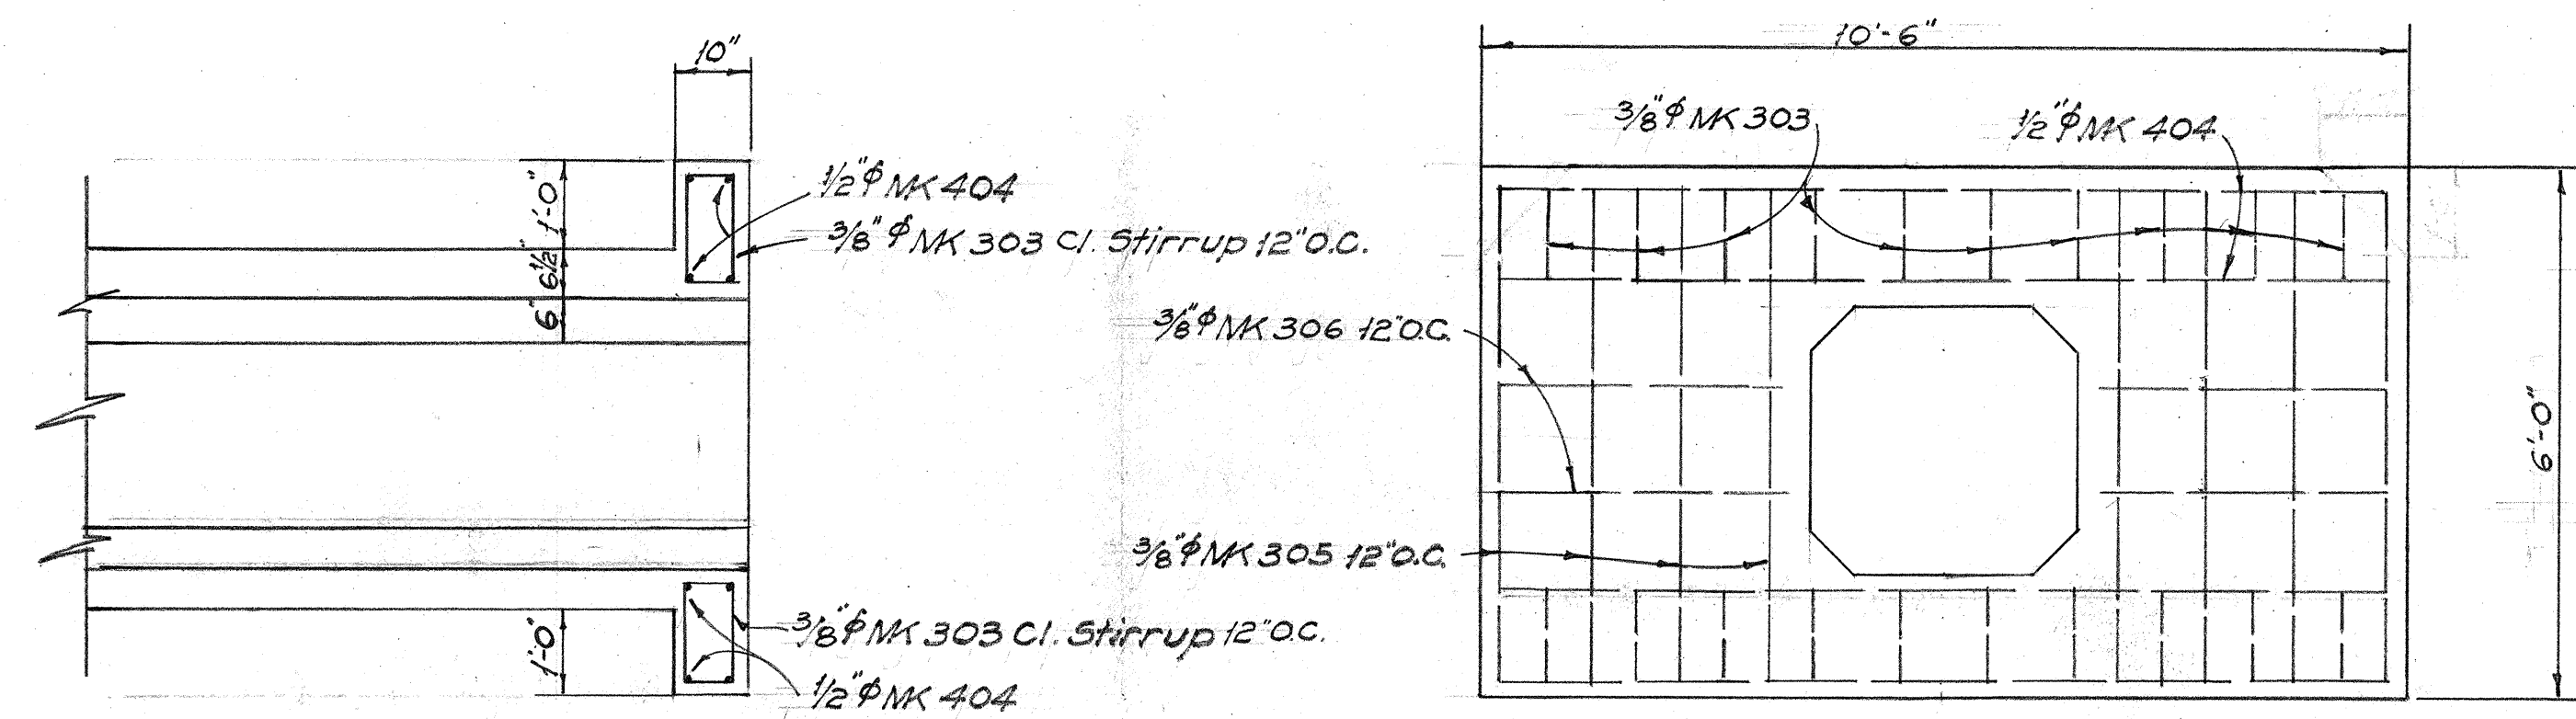


Curve Data
 $\Delta = 28^{\circ}00'$
 $D = 2000'$
 $T = 498.66'$
 $L = 577.58'$

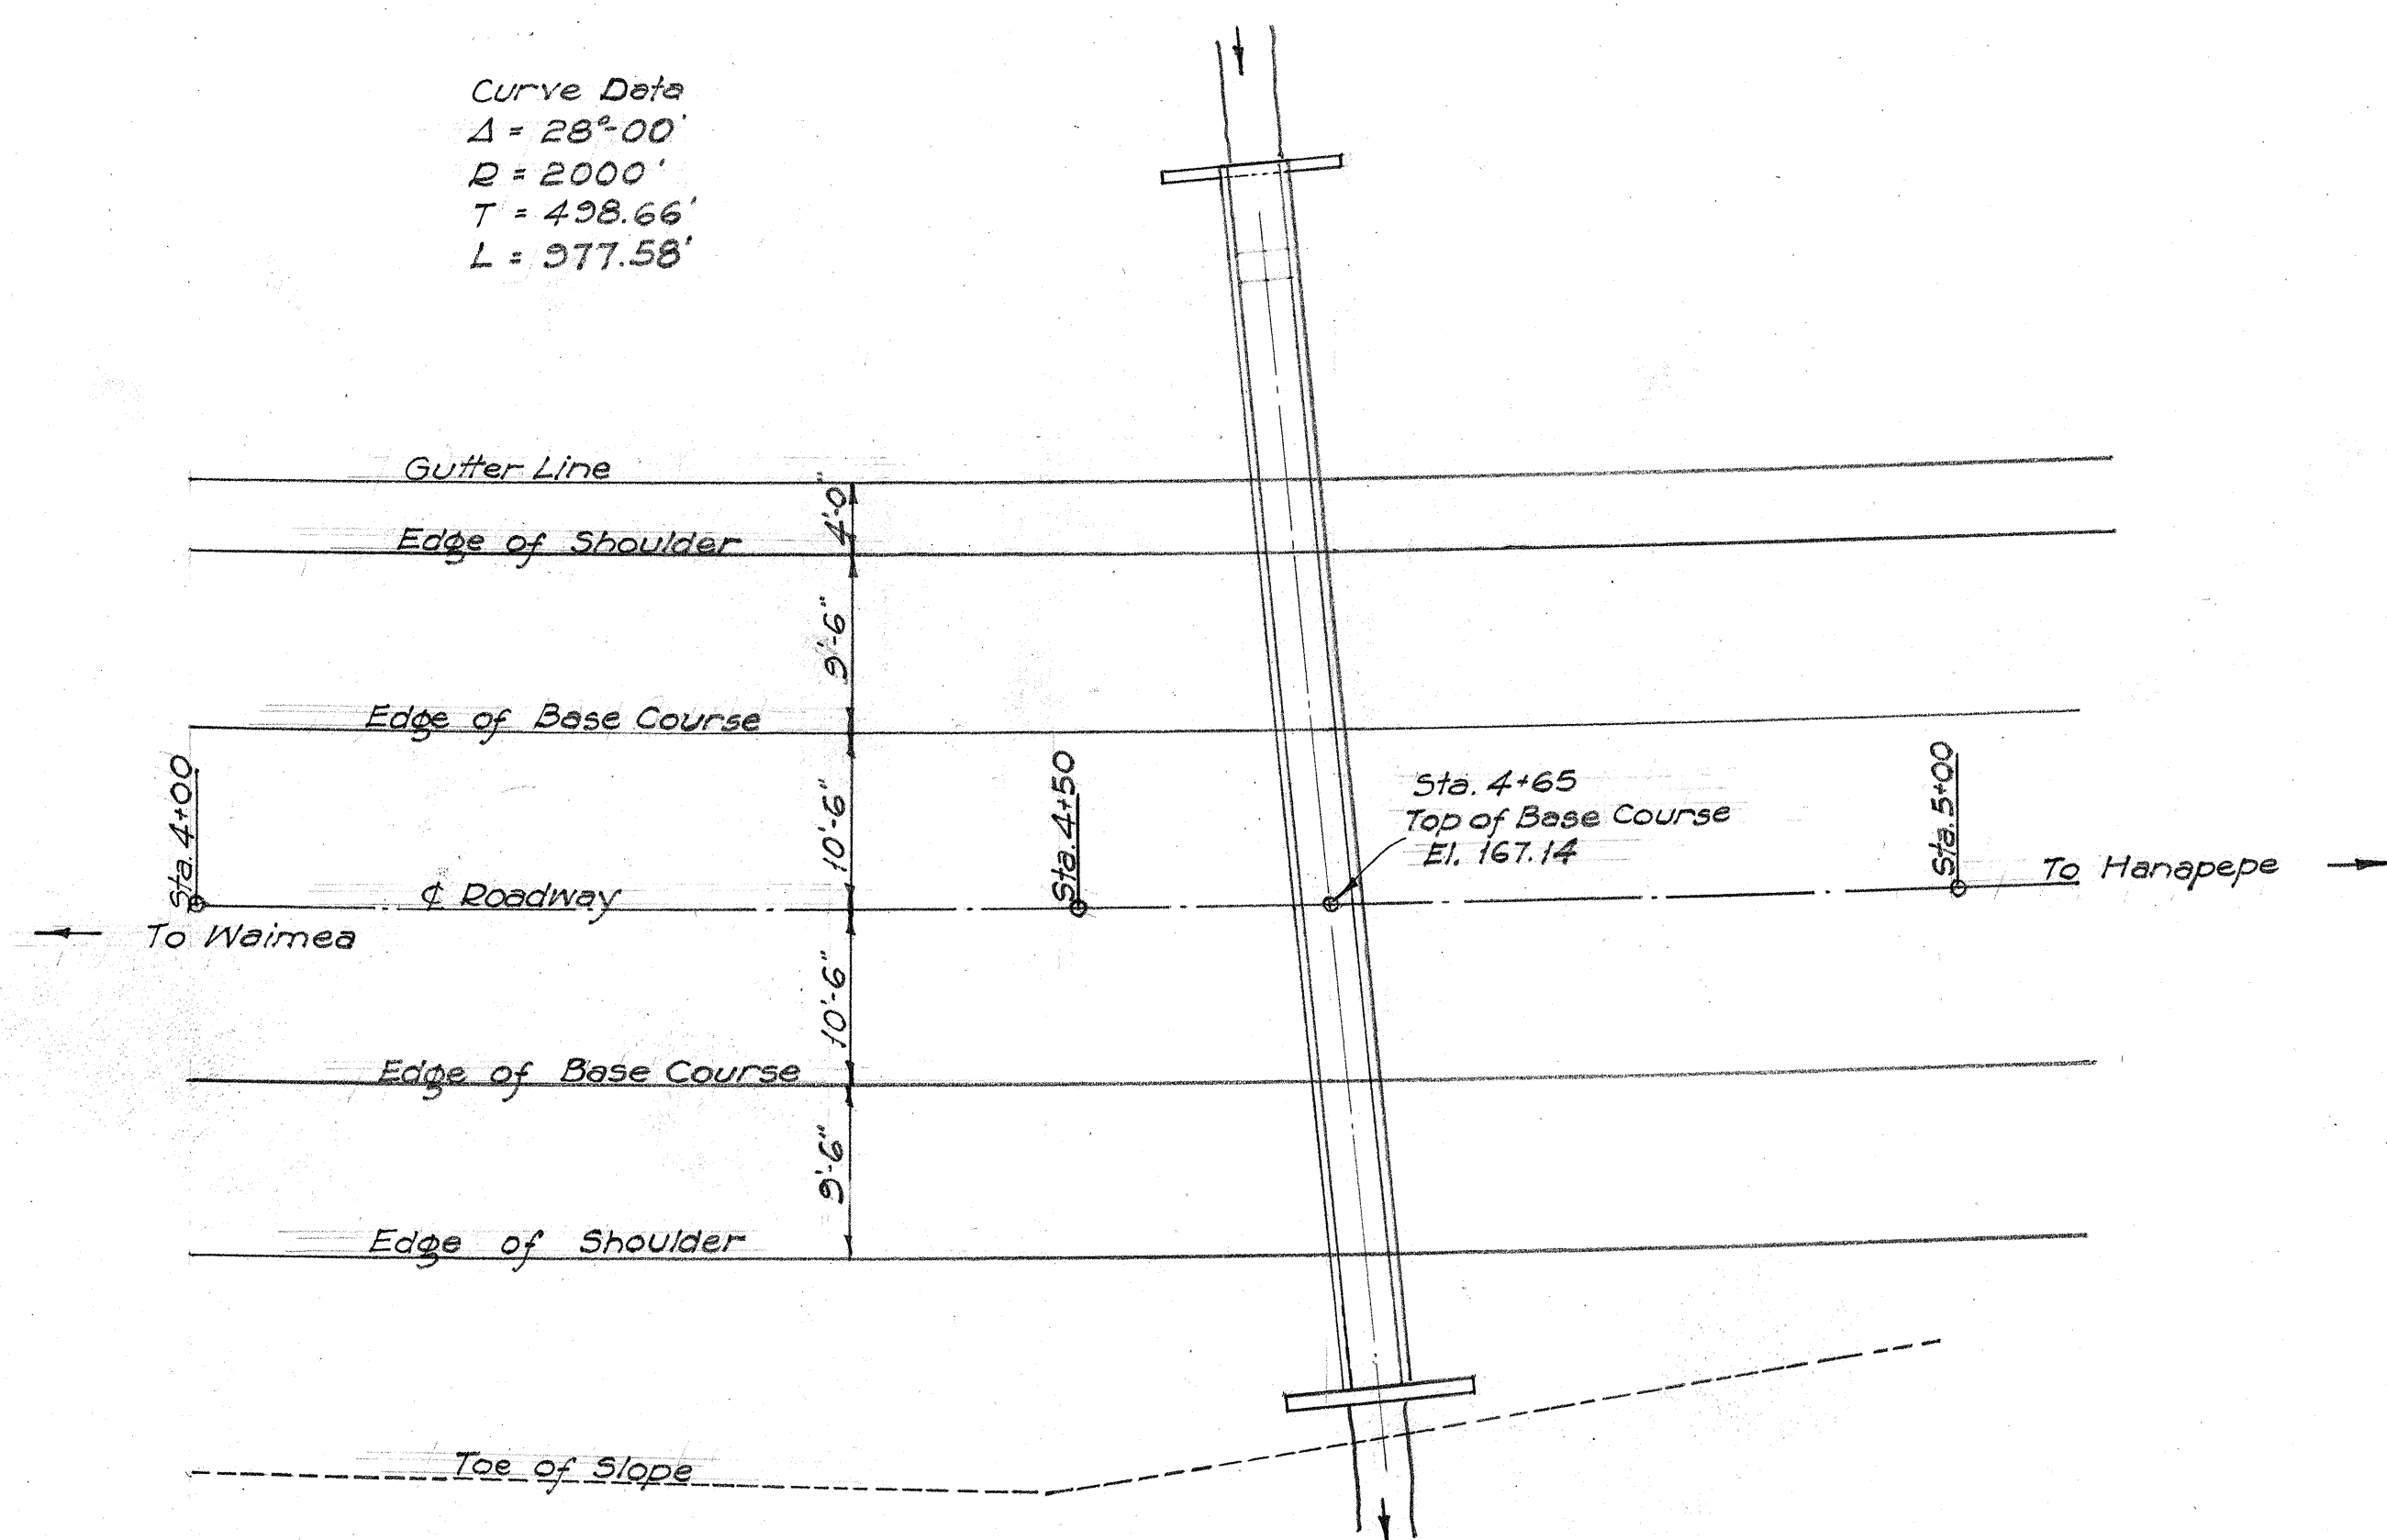

ESTIMATED QUANTITIES	
Class 'A' Concrete	21.4 cu. yd.
Reinforcing Steel	2418 lb.
Structural Excavation	50 cu. yd.

TERRITORIAL HIGHWAY DEPARTMENT
TERRITORY OF HAWAII
3'x3' BOX CULVERT
STA. 4+65
KAUAI BELT RD. F.A.P. 20-B(1)
MAY -1933

SHEET No OF SHEETS

5006.13



ORIGINAL PLAN
DESIGNED BY
DRAWN BY
NOTED BY
QUANTITIES CHECKED BY
CHECKED BY

REVISED July 10, 1939 Sect "A-A" Base Width changed from 5'-5" to 6'-0"







ORIGINAL
PLAN
NOTE BOOK
No.

SURVEY PLOTTED BY
DESIGNED BY
DRAWN BY
QUANTITIES BY
CHECKED BY

DATE
12-23-39
11-25-39
11-25-39
11-25-39
11-25-39

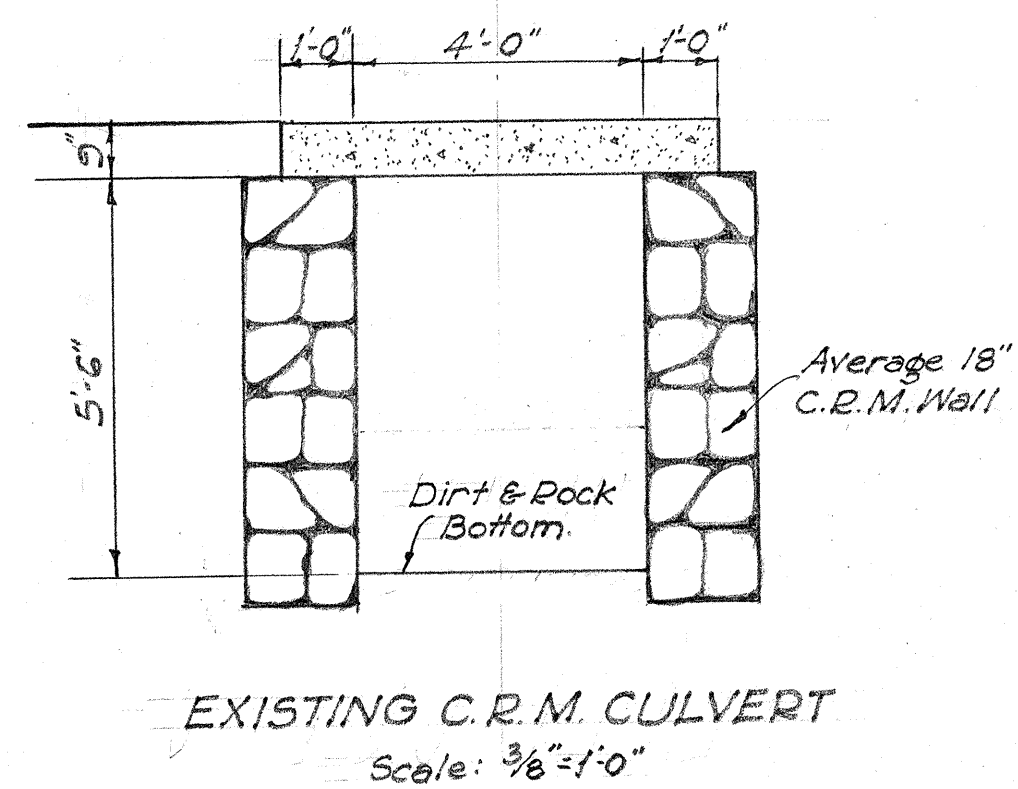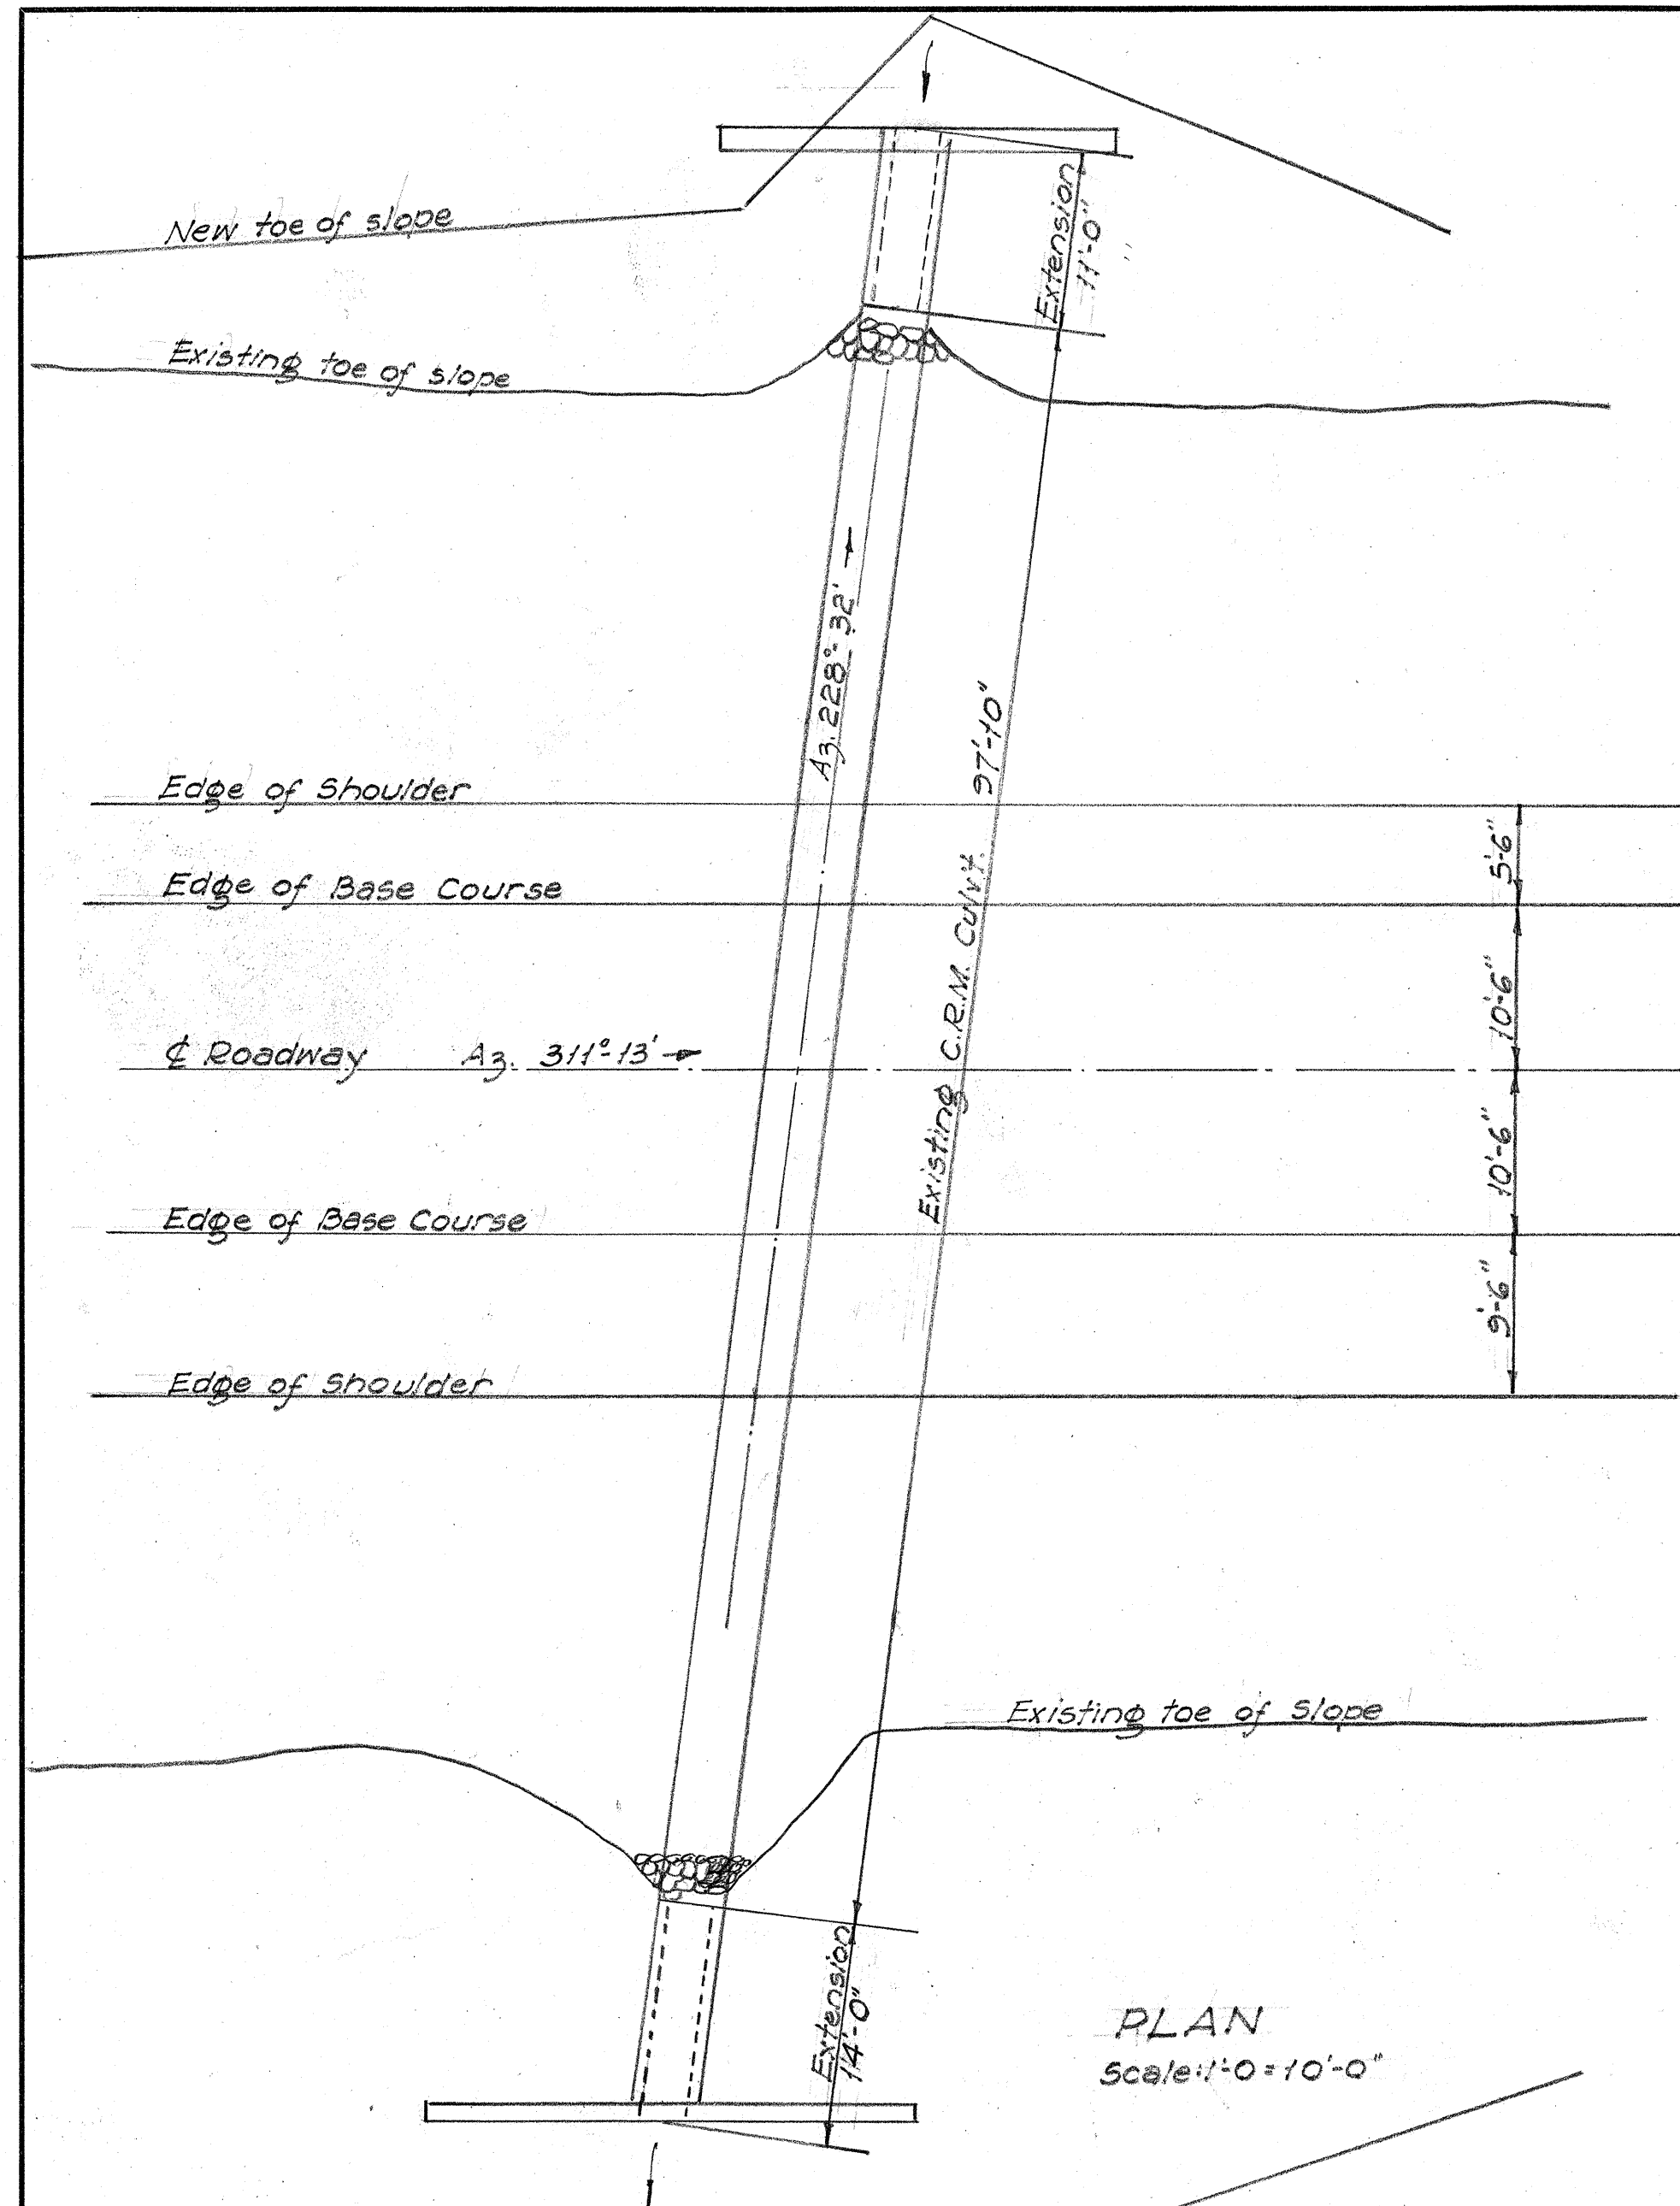

ESTIMATED QUANTITIES	
Structural Excavation	58 c.y.
Class "A" Concrete	3.5 c.y.
Reinforcing Steel	446 LBS.
Cement Rubble Masonry	82.1 c.y.

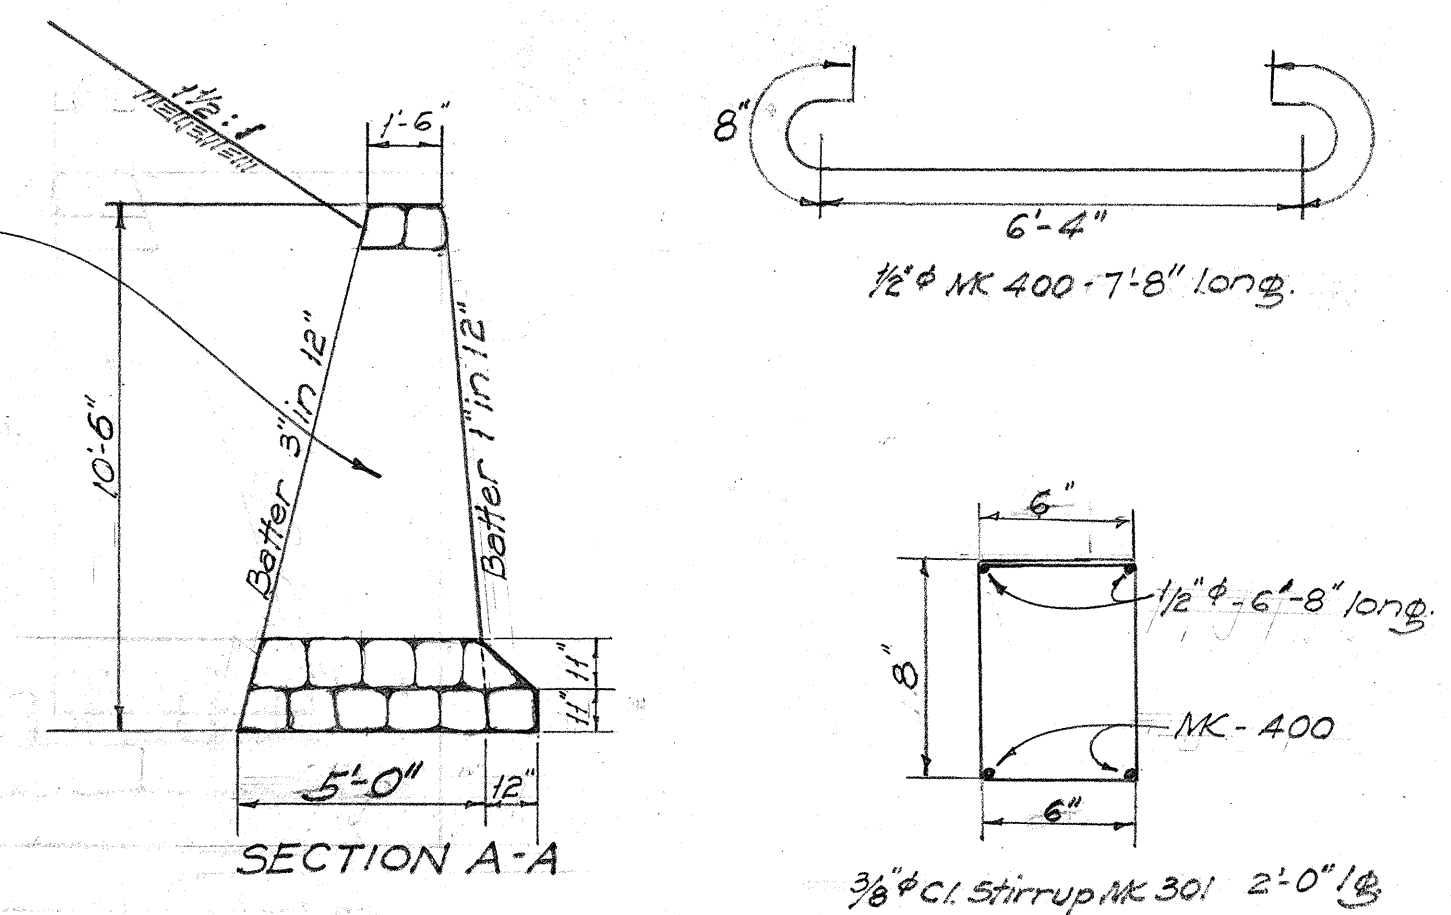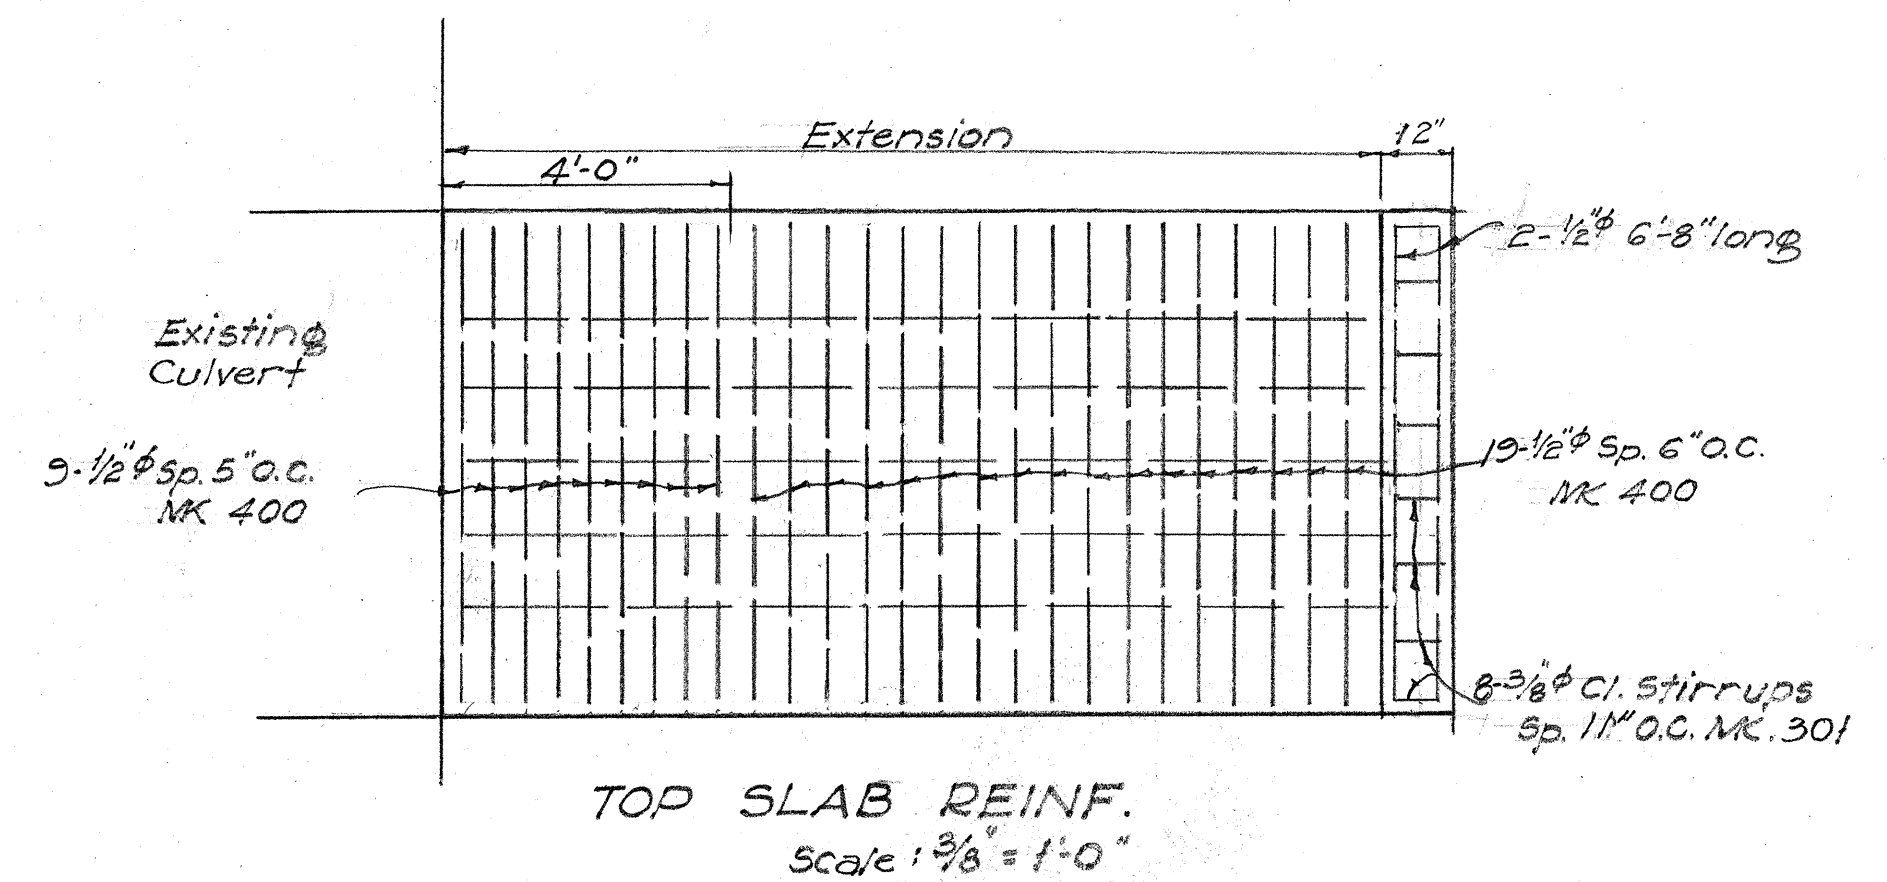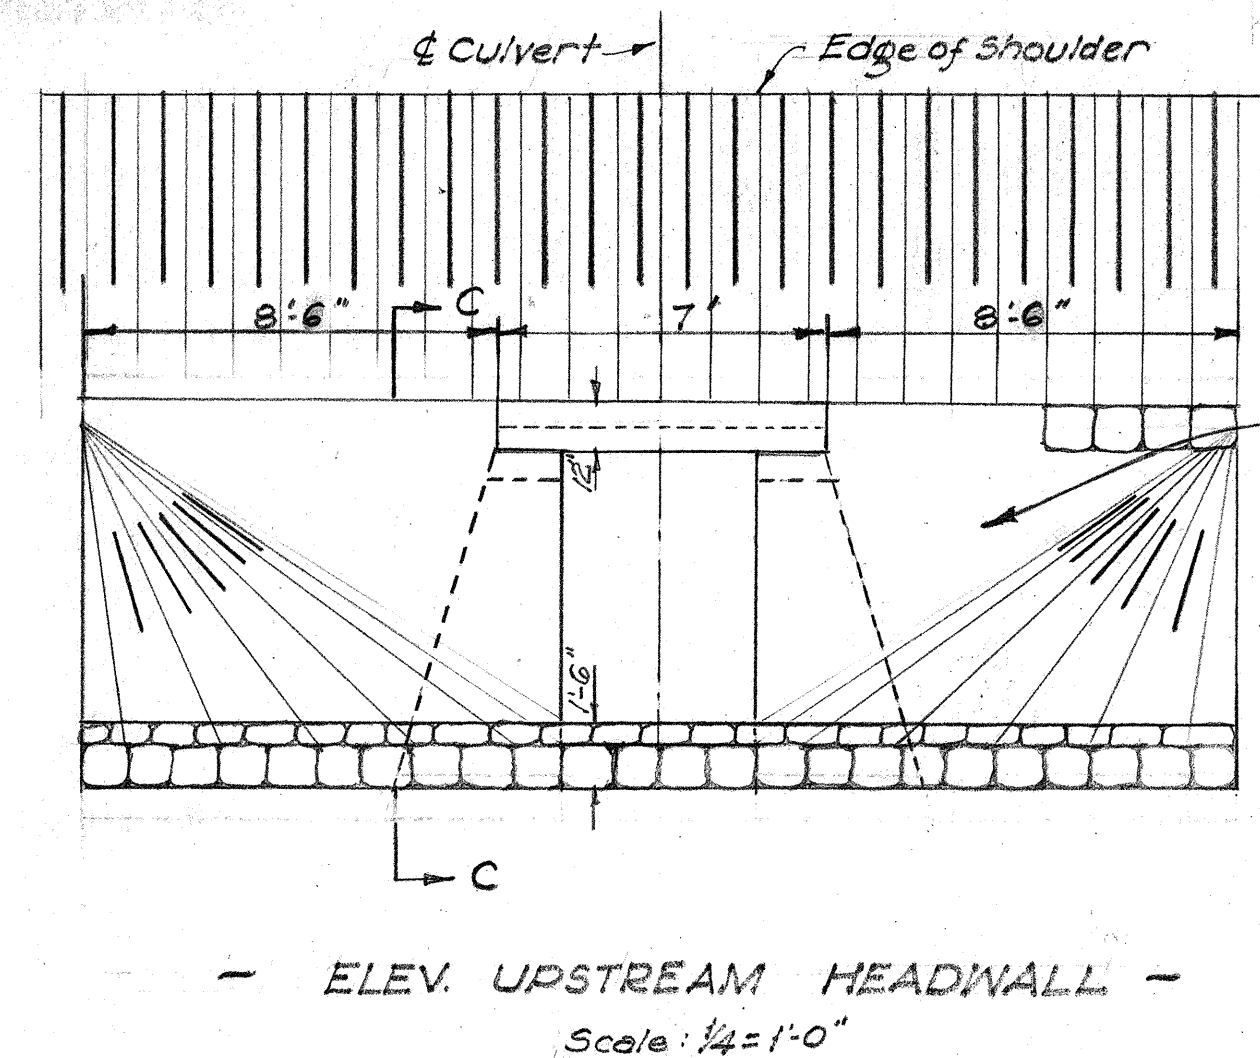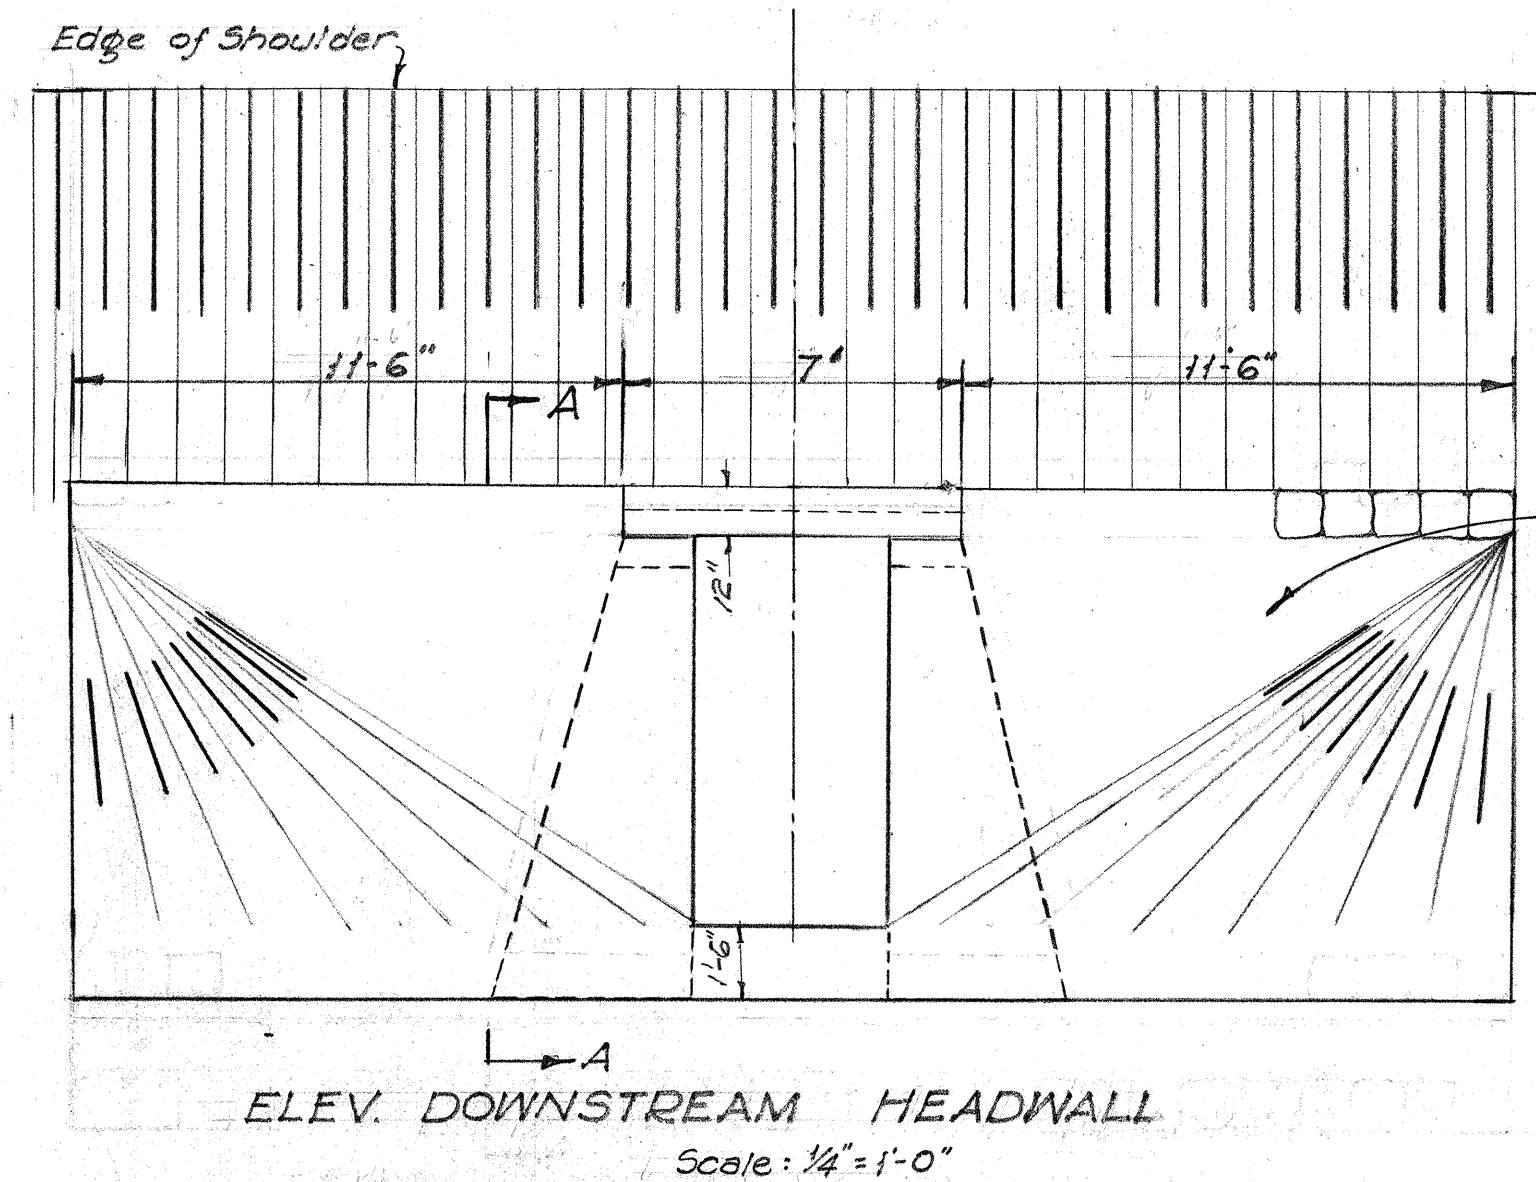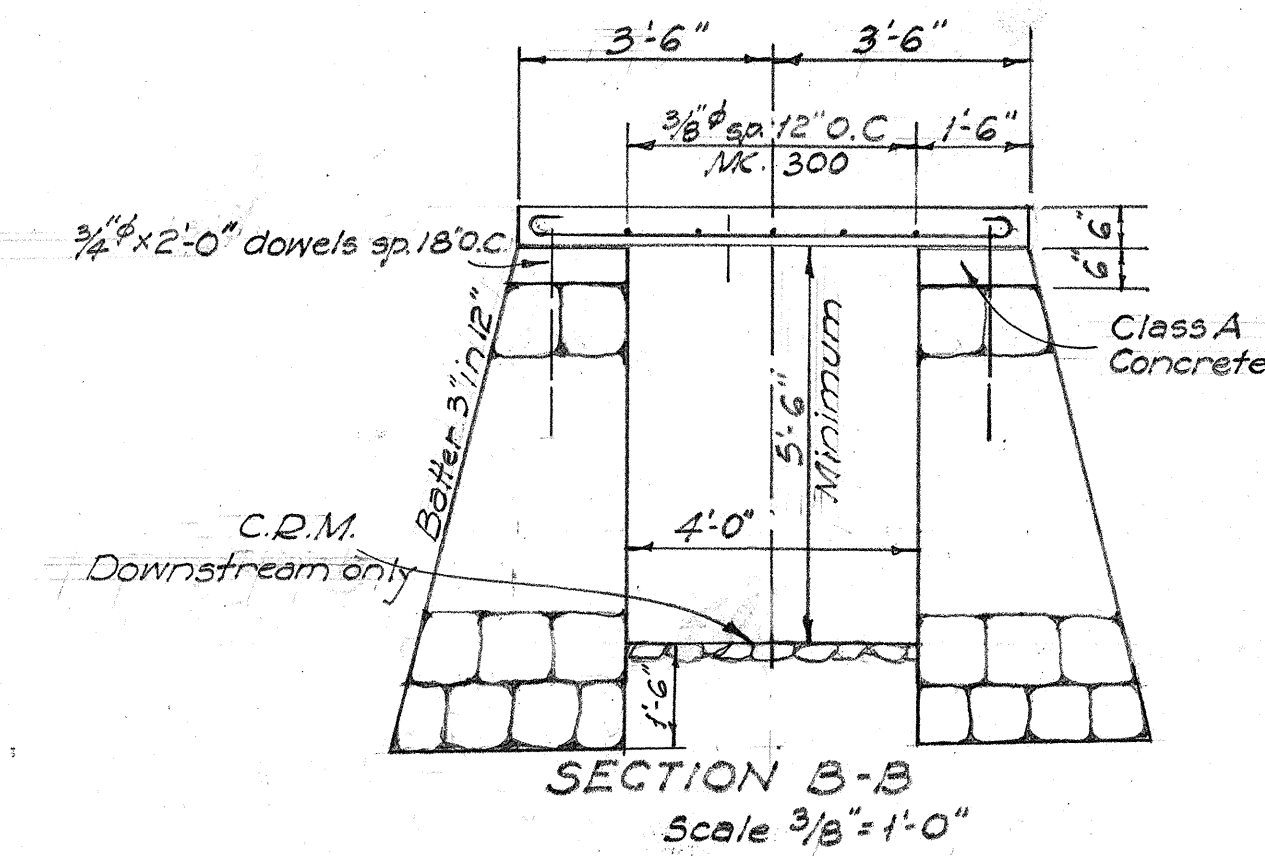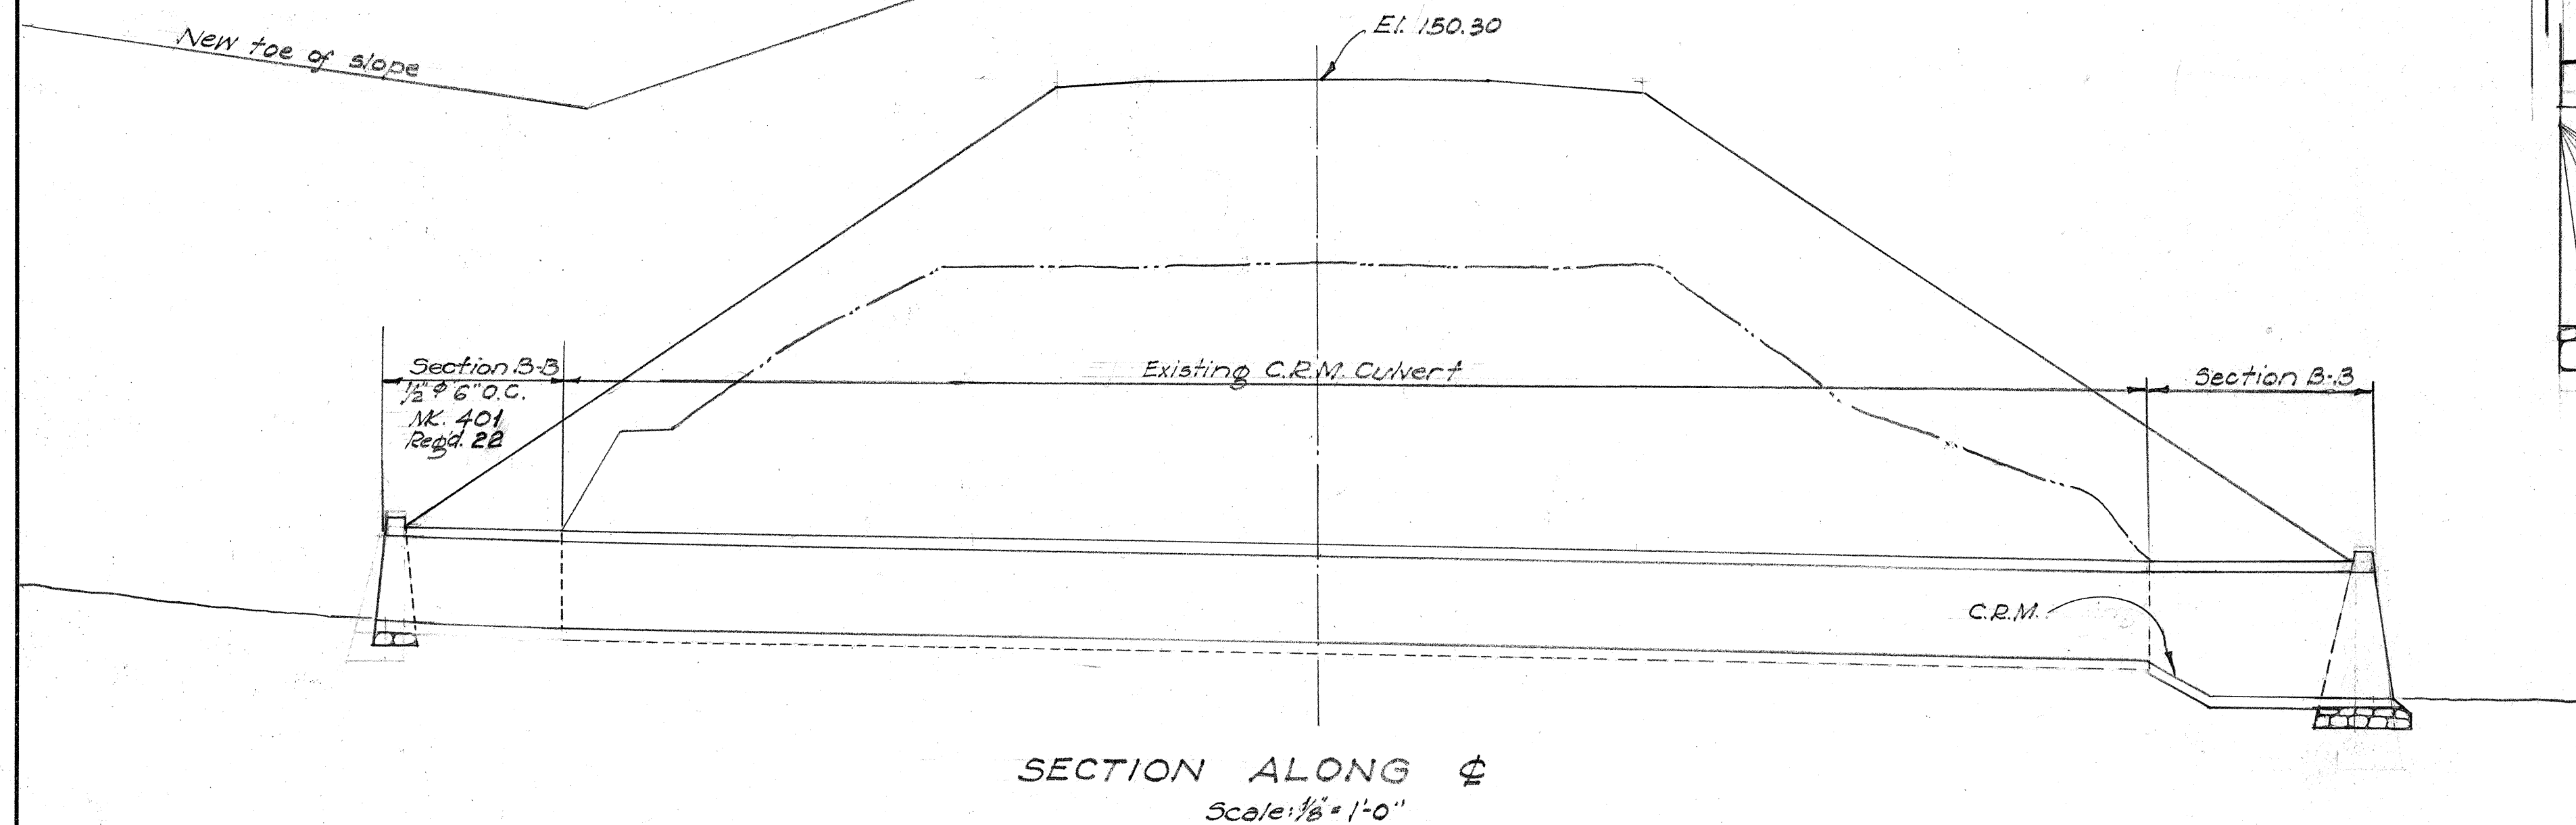

SECTION C-C

TERRITORIAL HIGHWAY DEPARTMENT
TERRITORY OF HAWAII
EXTENSION OF BOX CULVERT
STA. 36+03.28
KAUAI BELT RD. F.A.P. 29-B (1)
MAY - 1939