


Rev. June 28, 1944.

|               |                       |            |
|---------------|-----------------------|------------|
| DATE          | DESIGNED BY           | CHECKED BY |
| 12/1/43       | W. J. ...             | ...        |
| DESIGNED BY   | DRAWN BY              | CHECKED BY |
| ...           | ...                   | ...        |
| QUANTITIES BY | QUANTITIES CHECKED BY |            |
| ...           | ...                   |            |
| NOTE BOOK     |                       |            |
| No.           |                       |            |

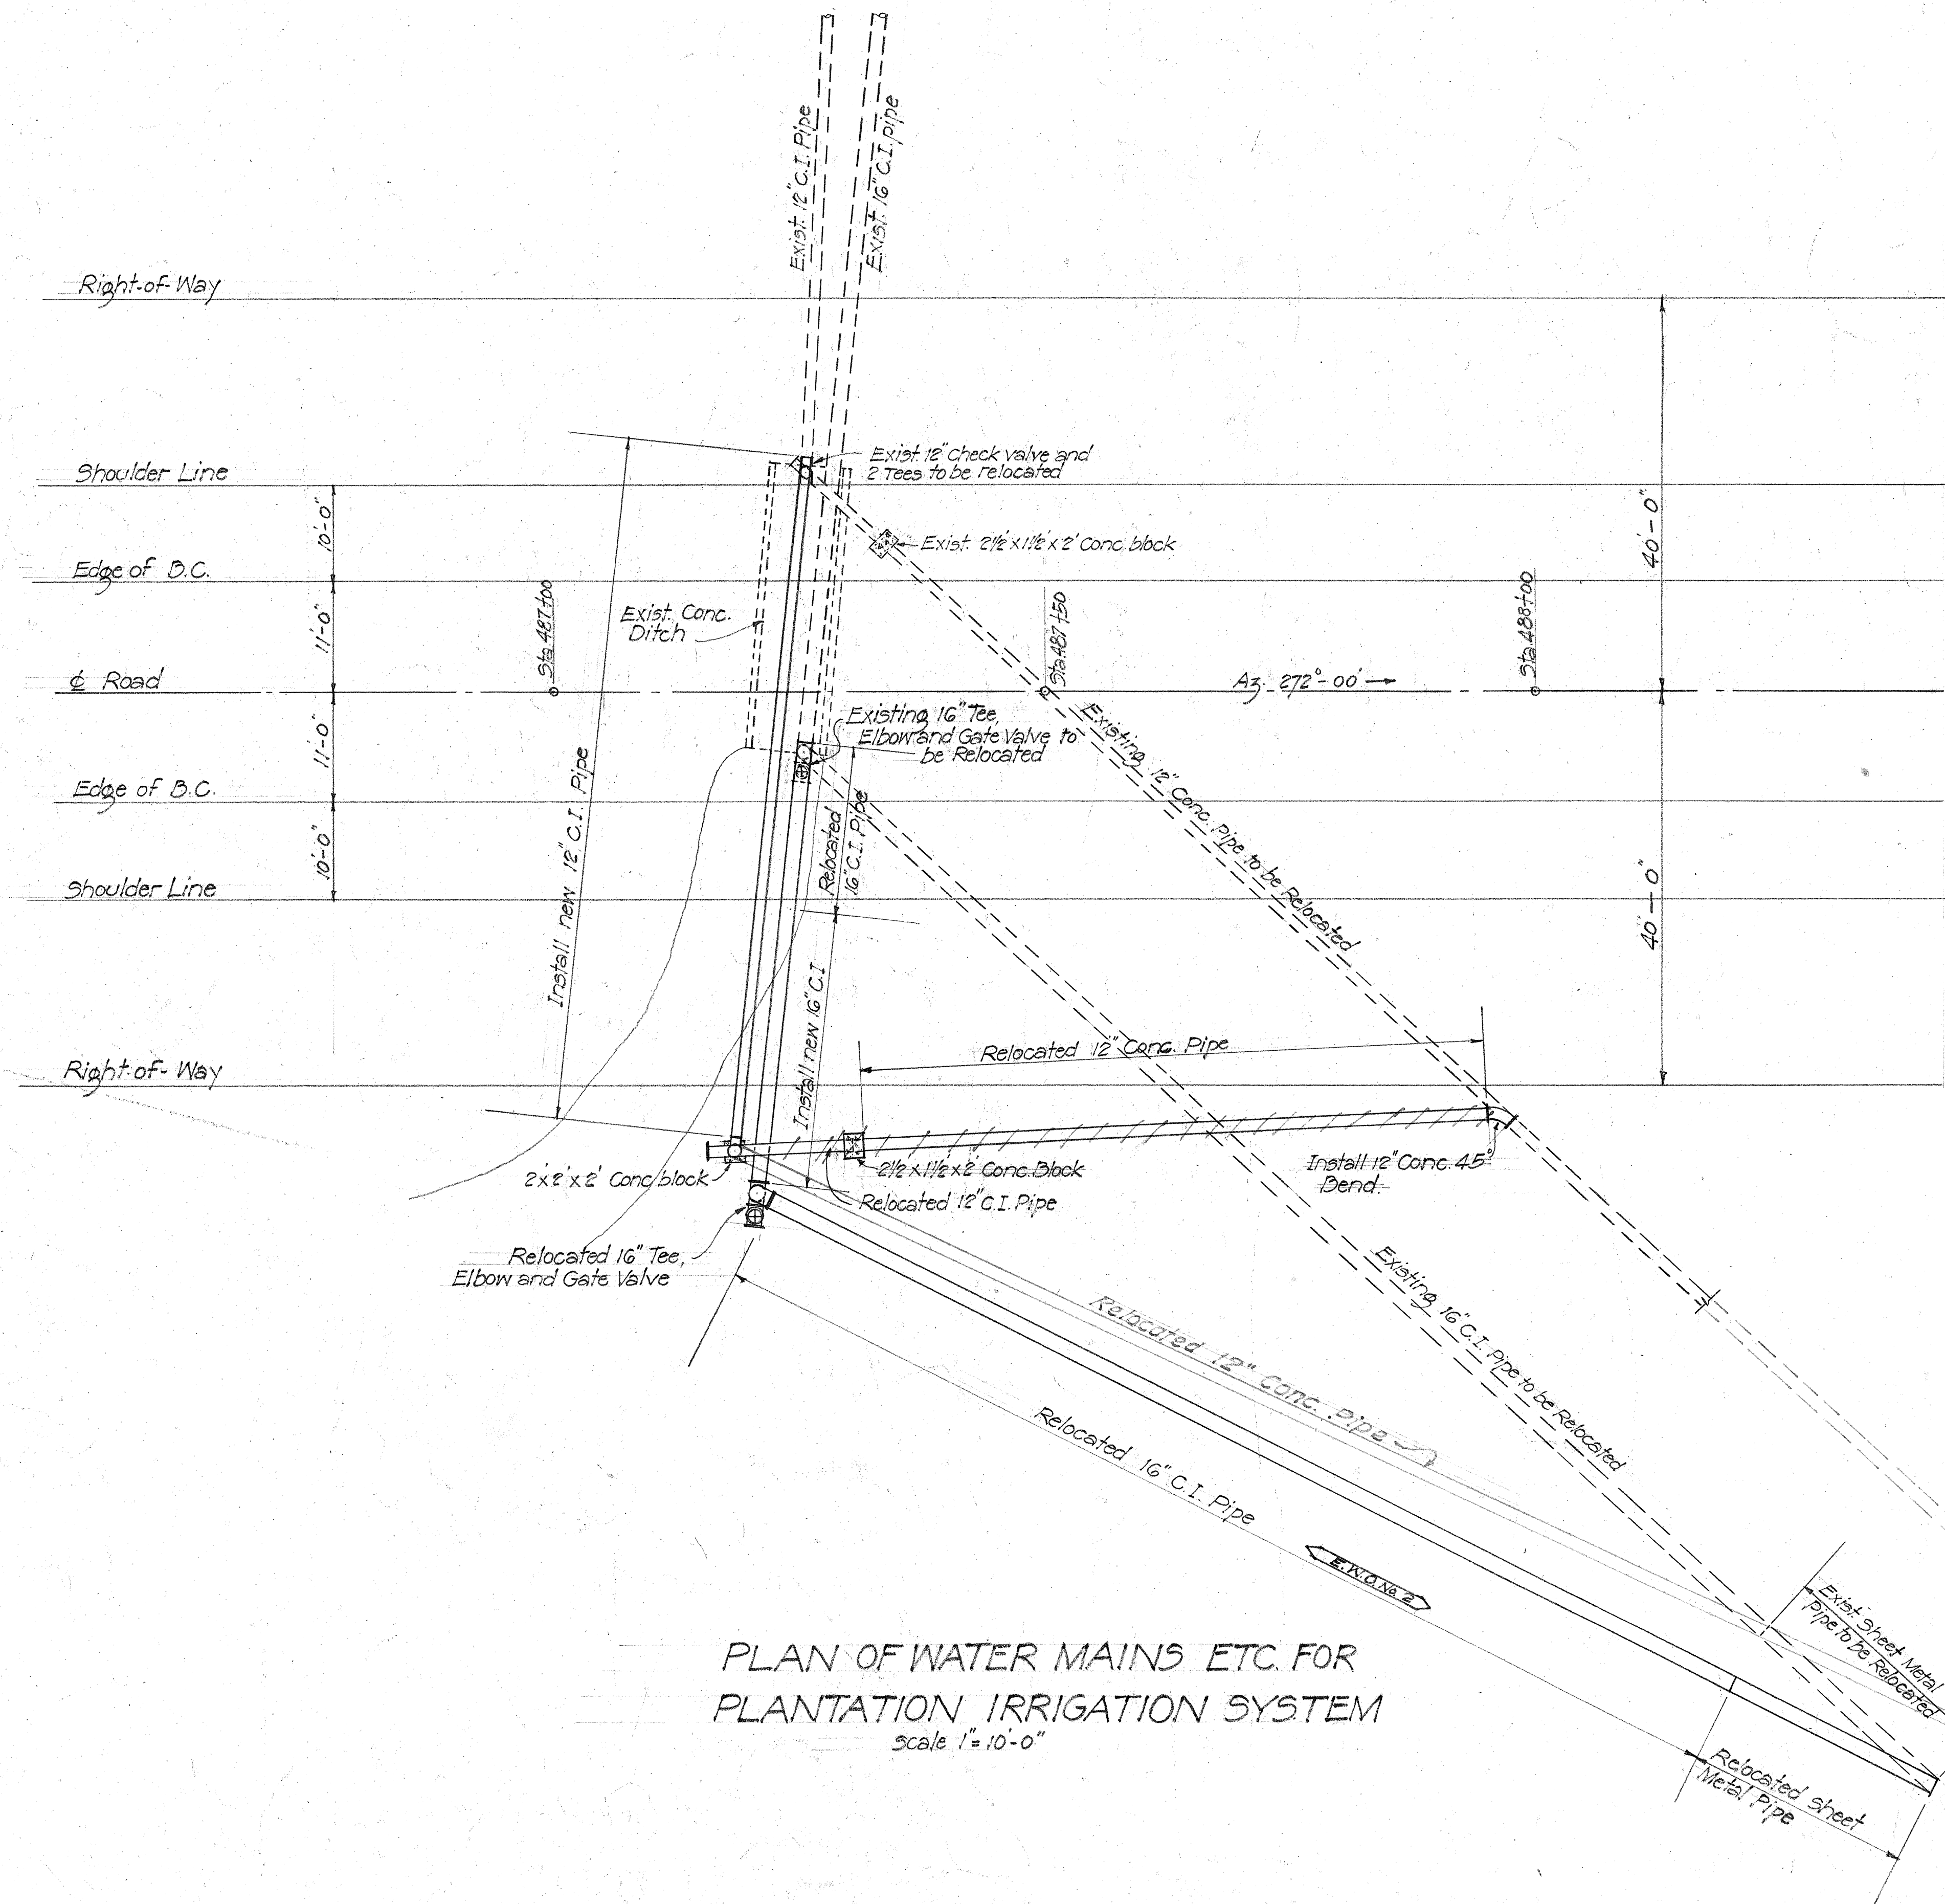

| ESTIMATED QUANTITIES             |             |
|----------------------------------|-------------|
| Class A Concrete                 | 0.6 c.y.    |
| 12" C.I. Pipe                    | 70 lin. ft. |
| 16" C.I. Pipe                    | 28 " "      |
| Relaying Existing 12" C.I. Pipe  | 14 " "      |
| Relaying Existing 16" C.I. Pipe  | 127 " "     |
| Relaying Existing 12" Conc. Pipe | 65 " "      |

PLAN OF WATER MAINS ETC. FOR  
PLANTATION IRRIGATION SYSTEM  
Scale 1" = 10'-0"

TERRITORIAL HIGHWAY DEPARTMENT  
TERRITORY OF HAWAII  
DETAILS OF WATER MAINS  
ETC. FOR PLANTATION IRRIGATION  
SYSTEM  
KAUAI BELT RD.  
Dec 1941  
SHEET No. 23 OF 72 SHEETS