

INDEX TO DRAWINGS	
SHEET NO	DESCRIPTIONS
1	Title Sheet
2-3	Typical Sections
3-16	Plan and Profile
17-18	Standard Details
19-20	Culvert Details
21-23	Standard Bridge Details
24-30	Bridge Details
31-34	Cross Sections

TERRITORY OF HAWAII
TERRITORIAL HIGHWAY DEPARTMENT
HONOLULU, T. H.

PLANS OF MANA-KEKAHA ACCESS ROAD

DA - WR 1

DISTRICT OF WAIMEA
ISLAND OF KAUAI


CONVENTIONAL
Existing Road
Existing Fence
Boundary Line
Center Line
Paved Approaches, etc.

SIGNS


Culverts
Bridges
Railroad

SCALES

PLAN 1 IN. = 100 FT.
PROFILE { HOR. 1 IN. = 100 FT.
VERT. 1 IN. = 10 FT.
CROSS SECTION { HOR. 1 IN. = 10 FT.
VERT. 1 IN. = 10 FT.

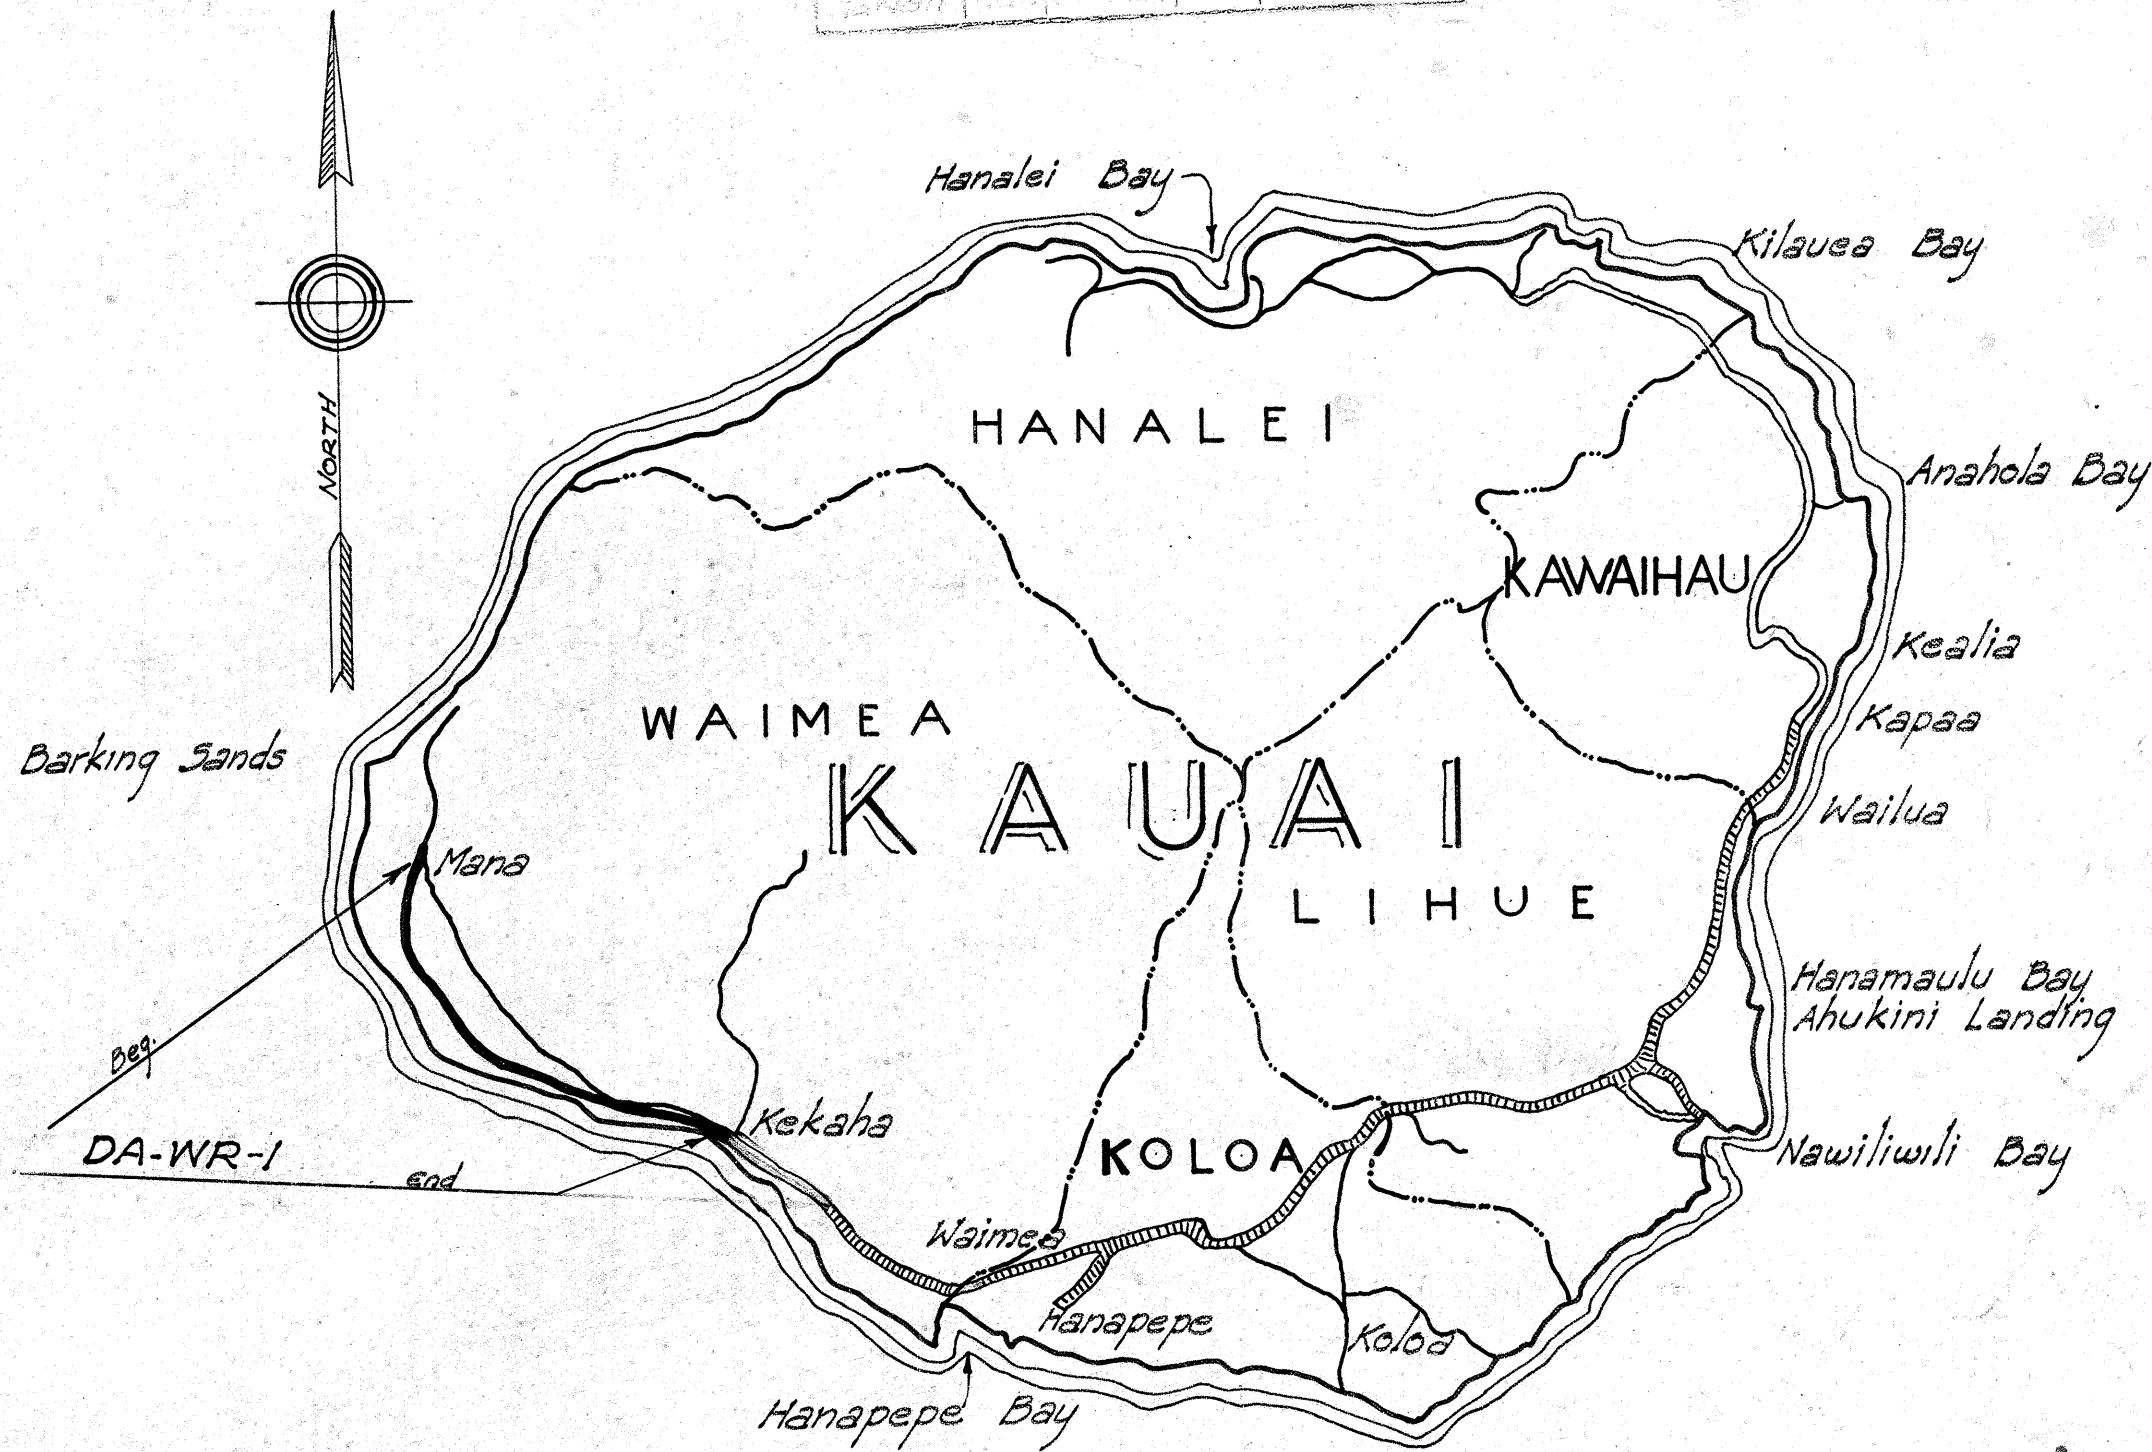

FA Projects previously constructed
or under construction.

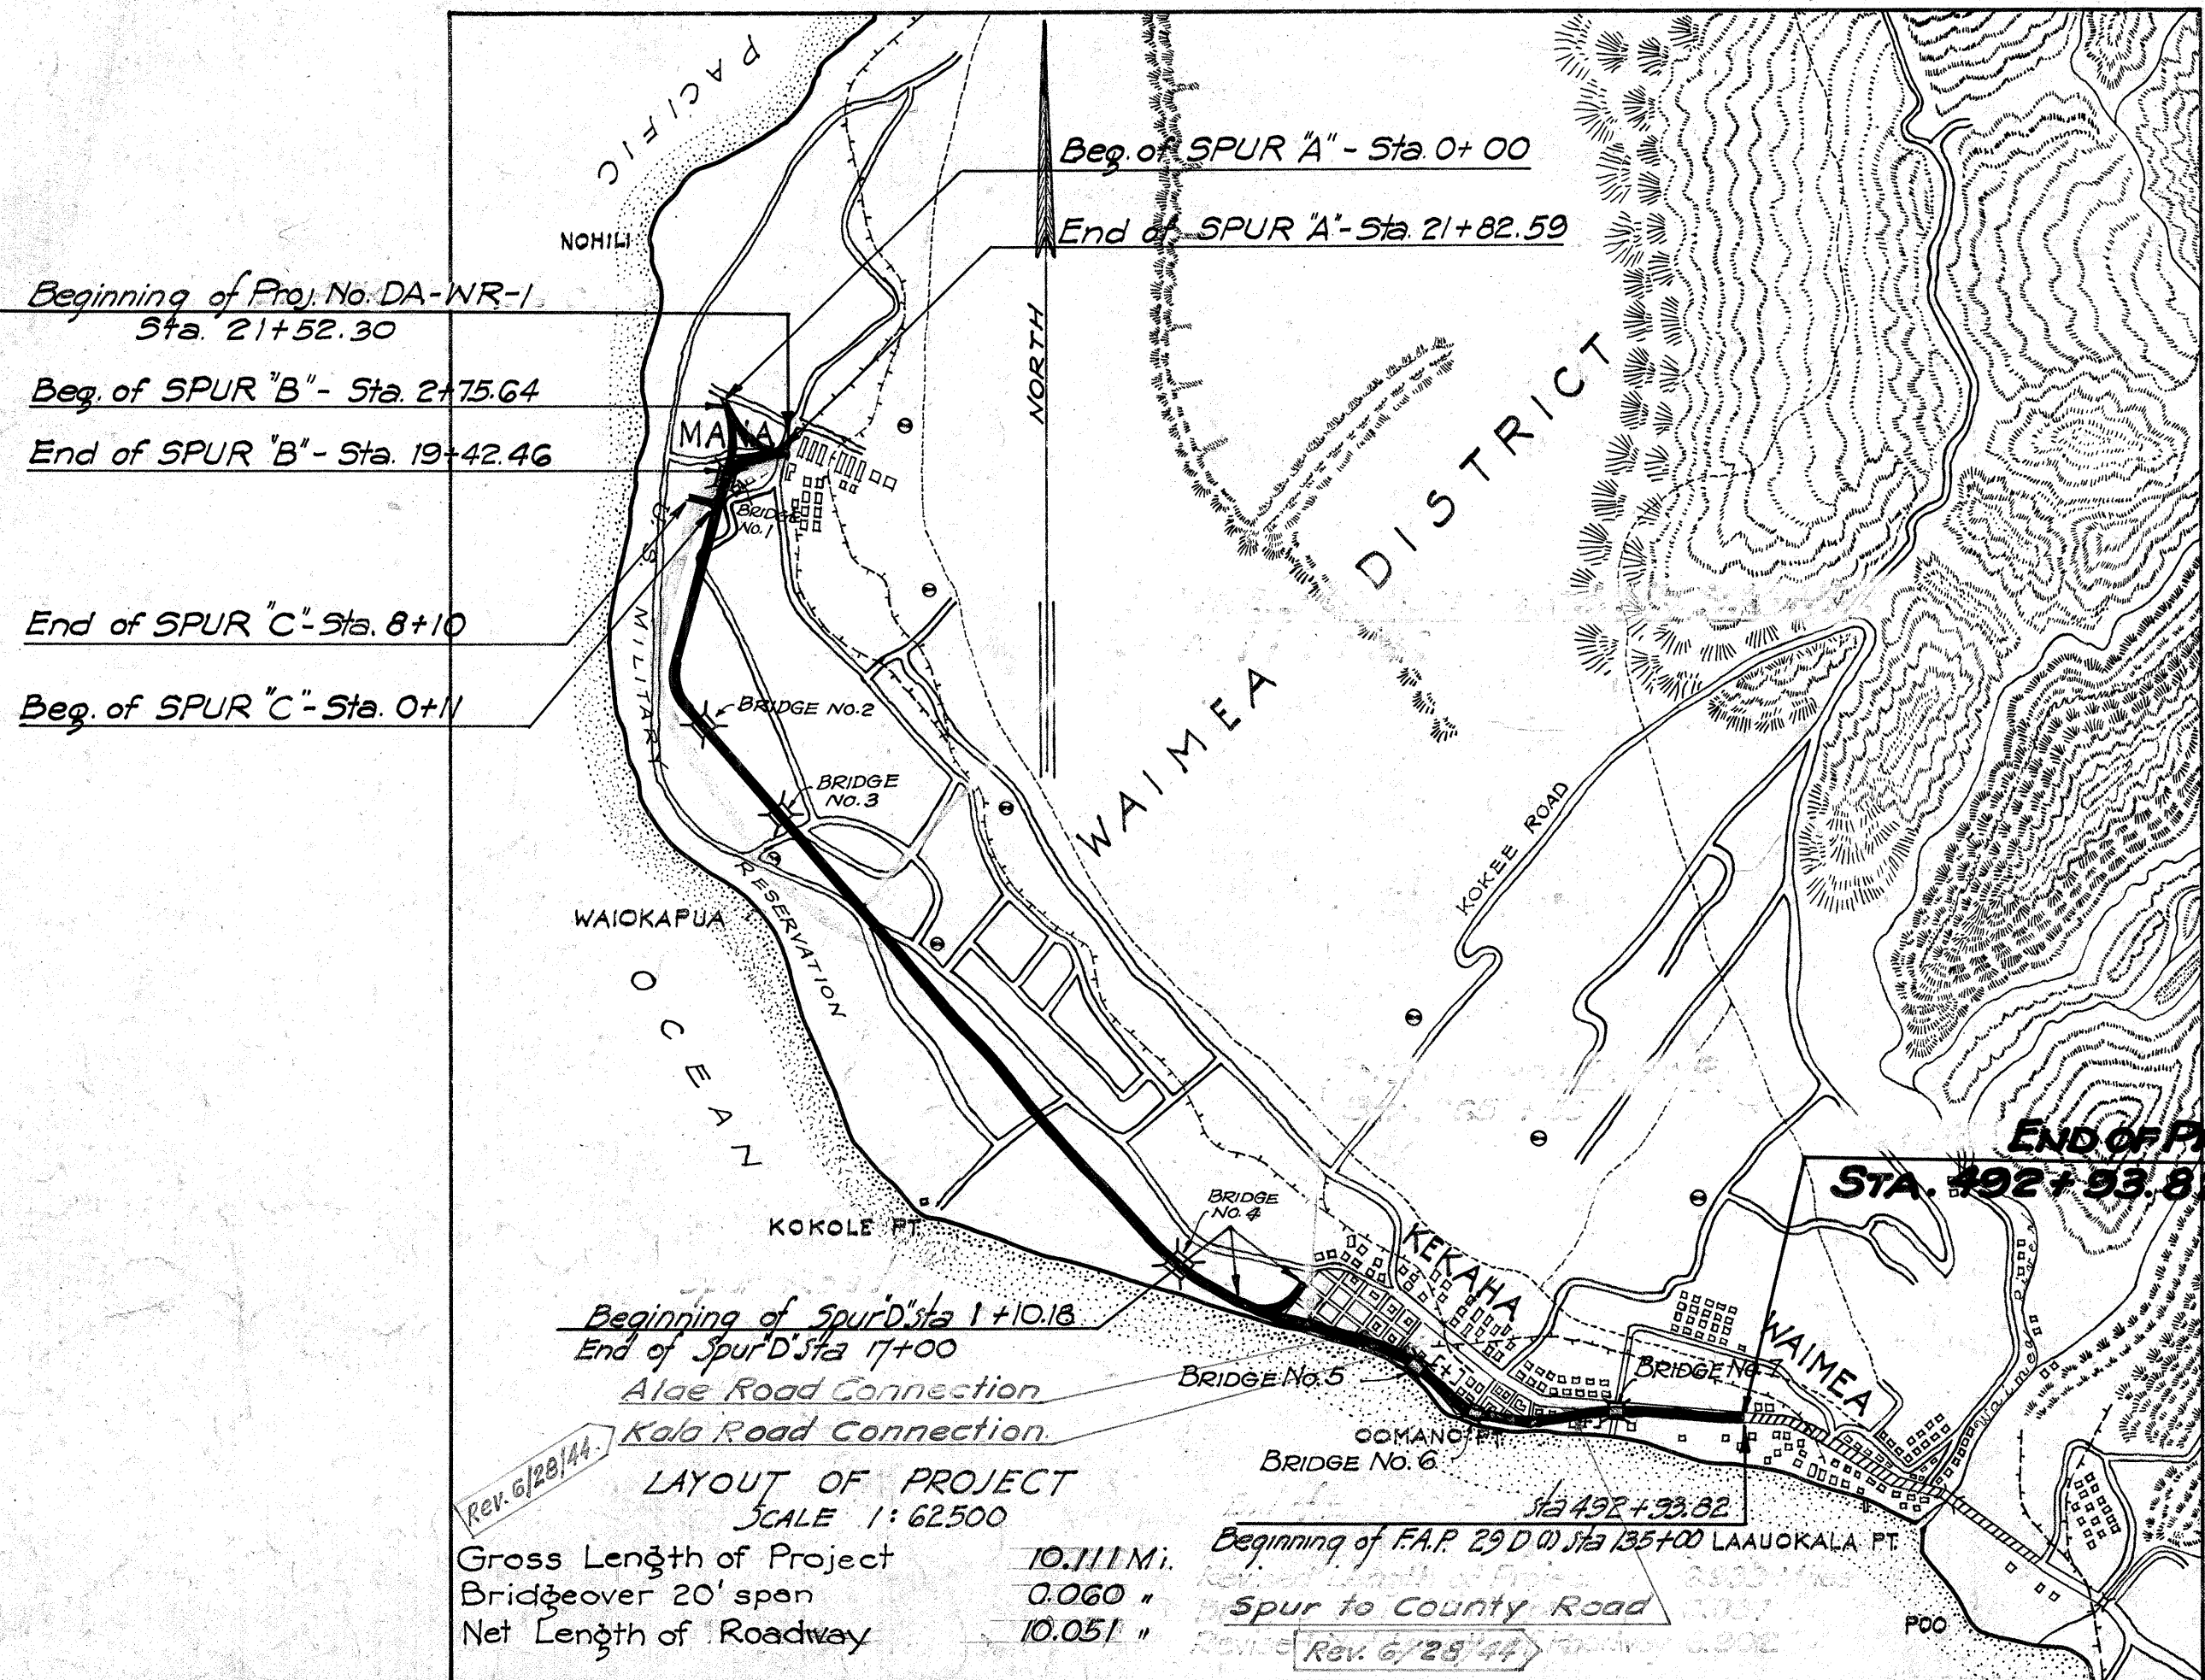

REVISED INDEX TO DRAWINGS				INSERTED	
REF. NO.	DESCRIPTION	SHEET NO.	REV. DATE	SHEET NO.	DATE
1	Title Sheet	5100.1	6/28/44		
2	Typical Sections	" 2	3/43		
3-7	Plan & Profile	" 3-7	6/28/44		
8	"	" 8	No Rev.		
9-20	"	" 9-20	6/28/44		
21-23	"			510020A-20C	
24-25	Standard Details	" 21-22	No Rev.		
26	Miscellaneous Details	" 23	6/28/44		
27	Culvert Details	" 24	"		
28	"	" 25	No Rev.		
29-31	Standard Bridge Details	" 26-28	"		
32-33	Bridge Details	" 29-30	6/28/44		
34-36	"	" 31-33	No Rev.		
37-38	"	" 34-35	6/28/44		
39-42	"	" 36-38	No Rev.		
43	"			" 39A	3/43
44-76	Cross Sections	" 40-72	No Rev.		
77-79	"	"		" 72A-72C	

All changes made during
construction have been shown in
red on these drawings and checked

by *[Signature]*
Resident Engineer
Date 9-7-48

APPROVED

APPROVED

TERRITORIAL HIGHWAY ENGINEER

RECOMMENDED FOR APPROVAL

DISTRICT ENGINEER
PUBLIC ROADS ADMINISTRATION
FEDERAL WORKS AGENCY

RECOMMENDED FOR APPROVAL

CHIEF WESTERN DIVISION
PUBLIC ROADS ADMINISTRATION
FEDERAL WORKS AGENCY

APPROVED

COMMISSIONER
PUBLIC ROADS ADMINISTRATION
FEDERAL WORKS AGENCY

5100.1