




FED. ROAD DIST. NO.	STATE	FED. AID PROJ. NO.	FISCAL YEAR	SHEET NO.	TOTAL SHEETS
HAWAII	HAW	F 29(4)	1946	10	53

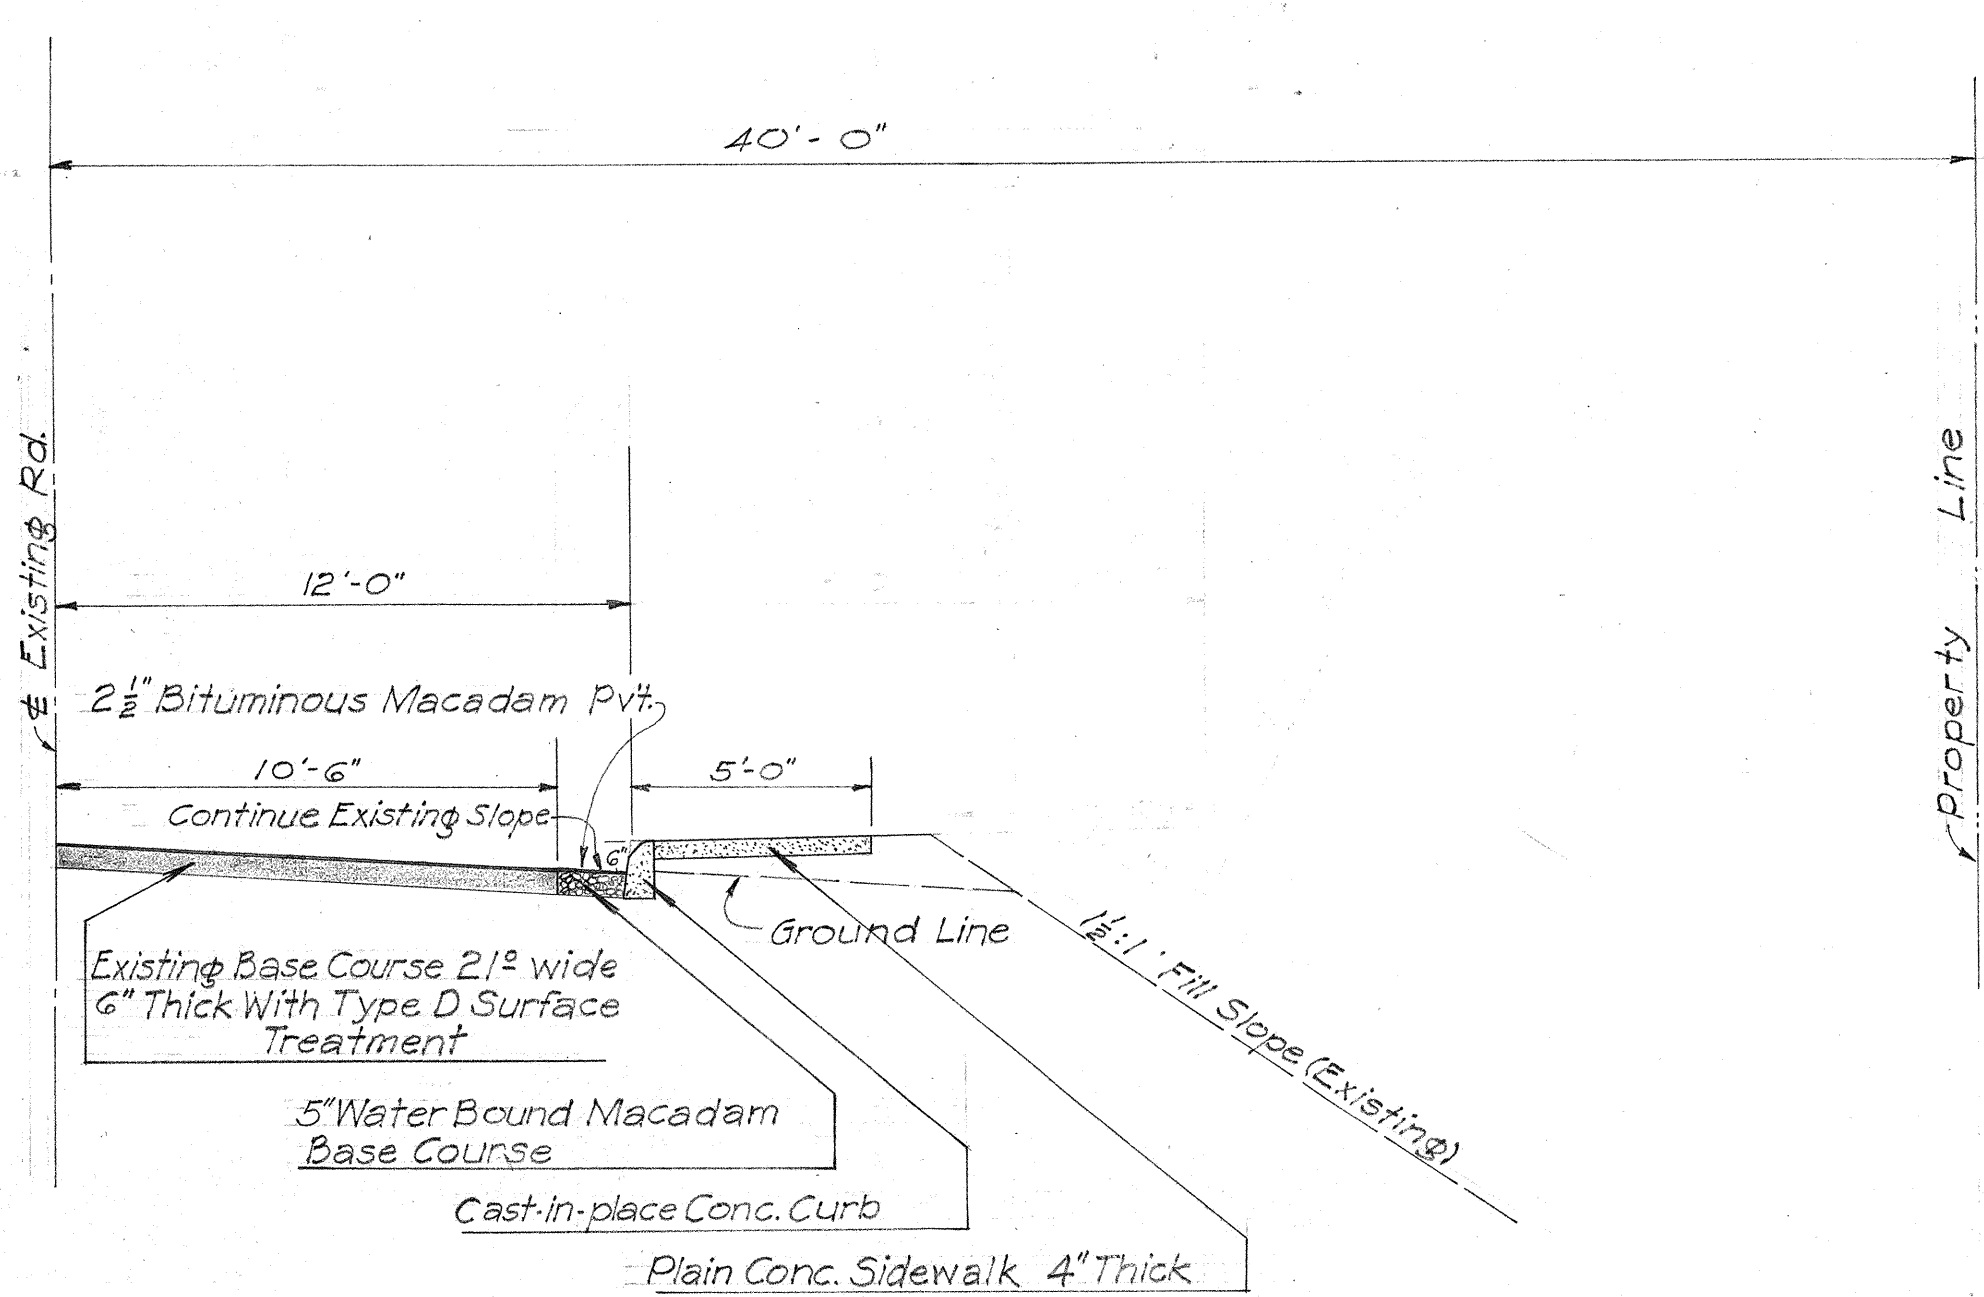


TYPICAL SECTION - SHOWING CURB & SIDEWALK
STA. 5+25 to Sta. 8+50
Scale: 1/4" = 1'-0"

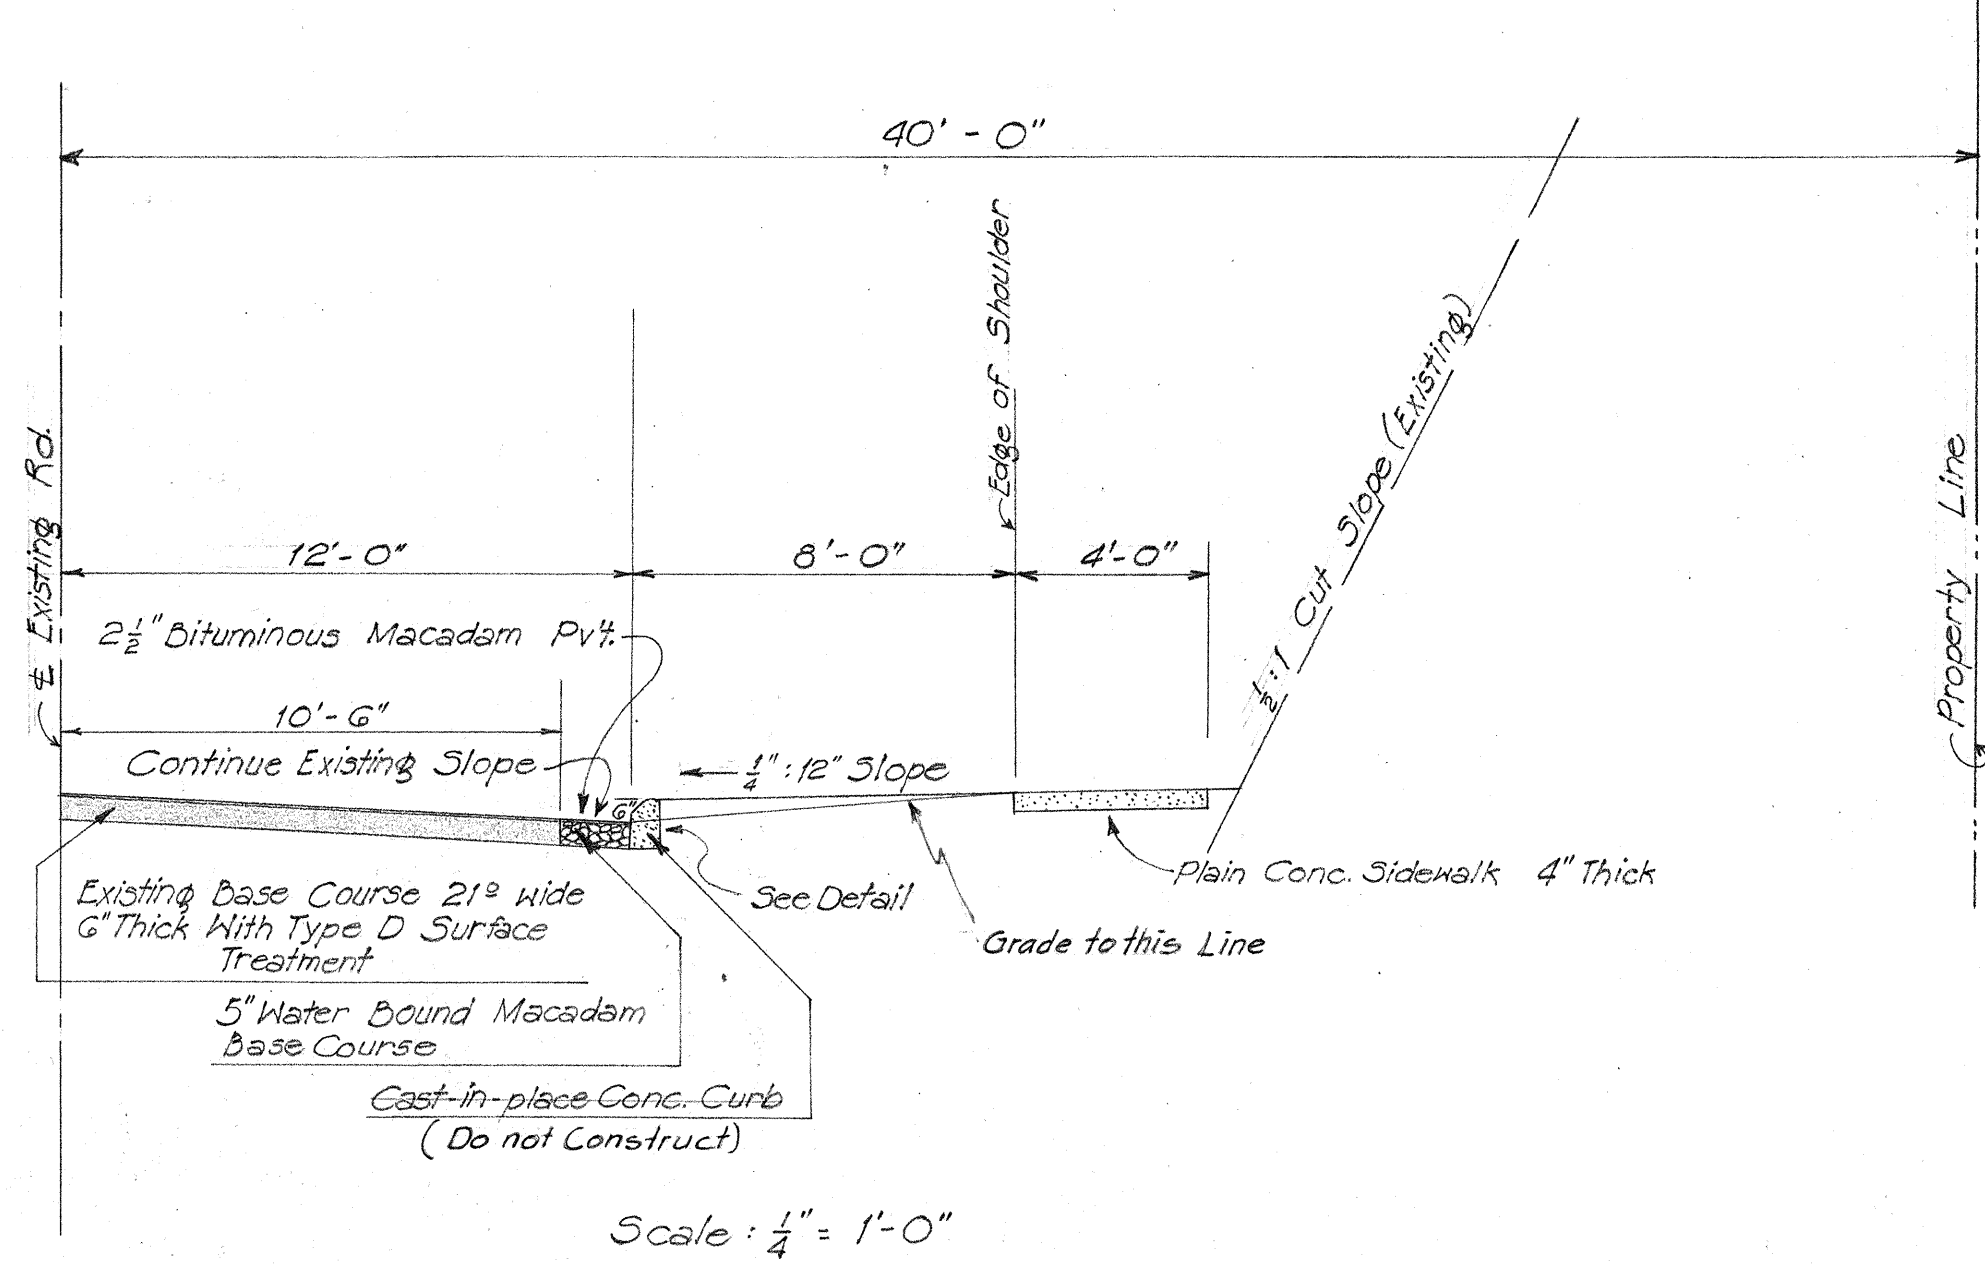

TYPICAL SECTION - SHOWING CURB & SIDEWALK
STA. 0+00 to STA. 5+25 & STA. 8+00 to STA. 27+20
Scale: 1/4" = 1'-0"

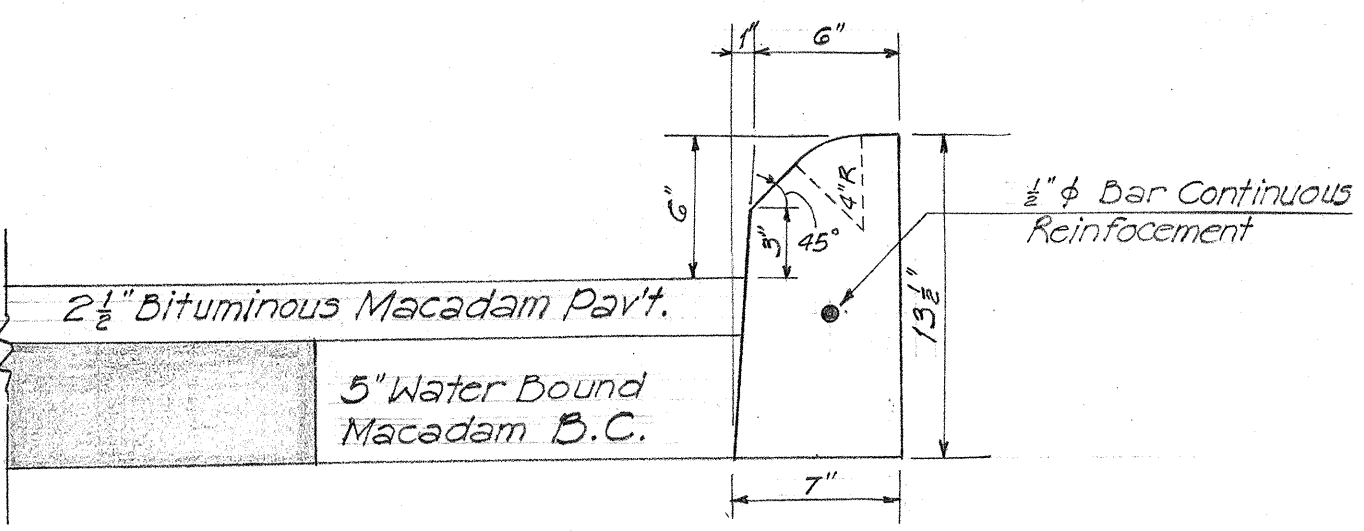

DETAIL of CURB
Scale: 1 1/2" = 1'-0"
NOTE!
Use this Curb Detail in lieu of that shown in Std. Details.

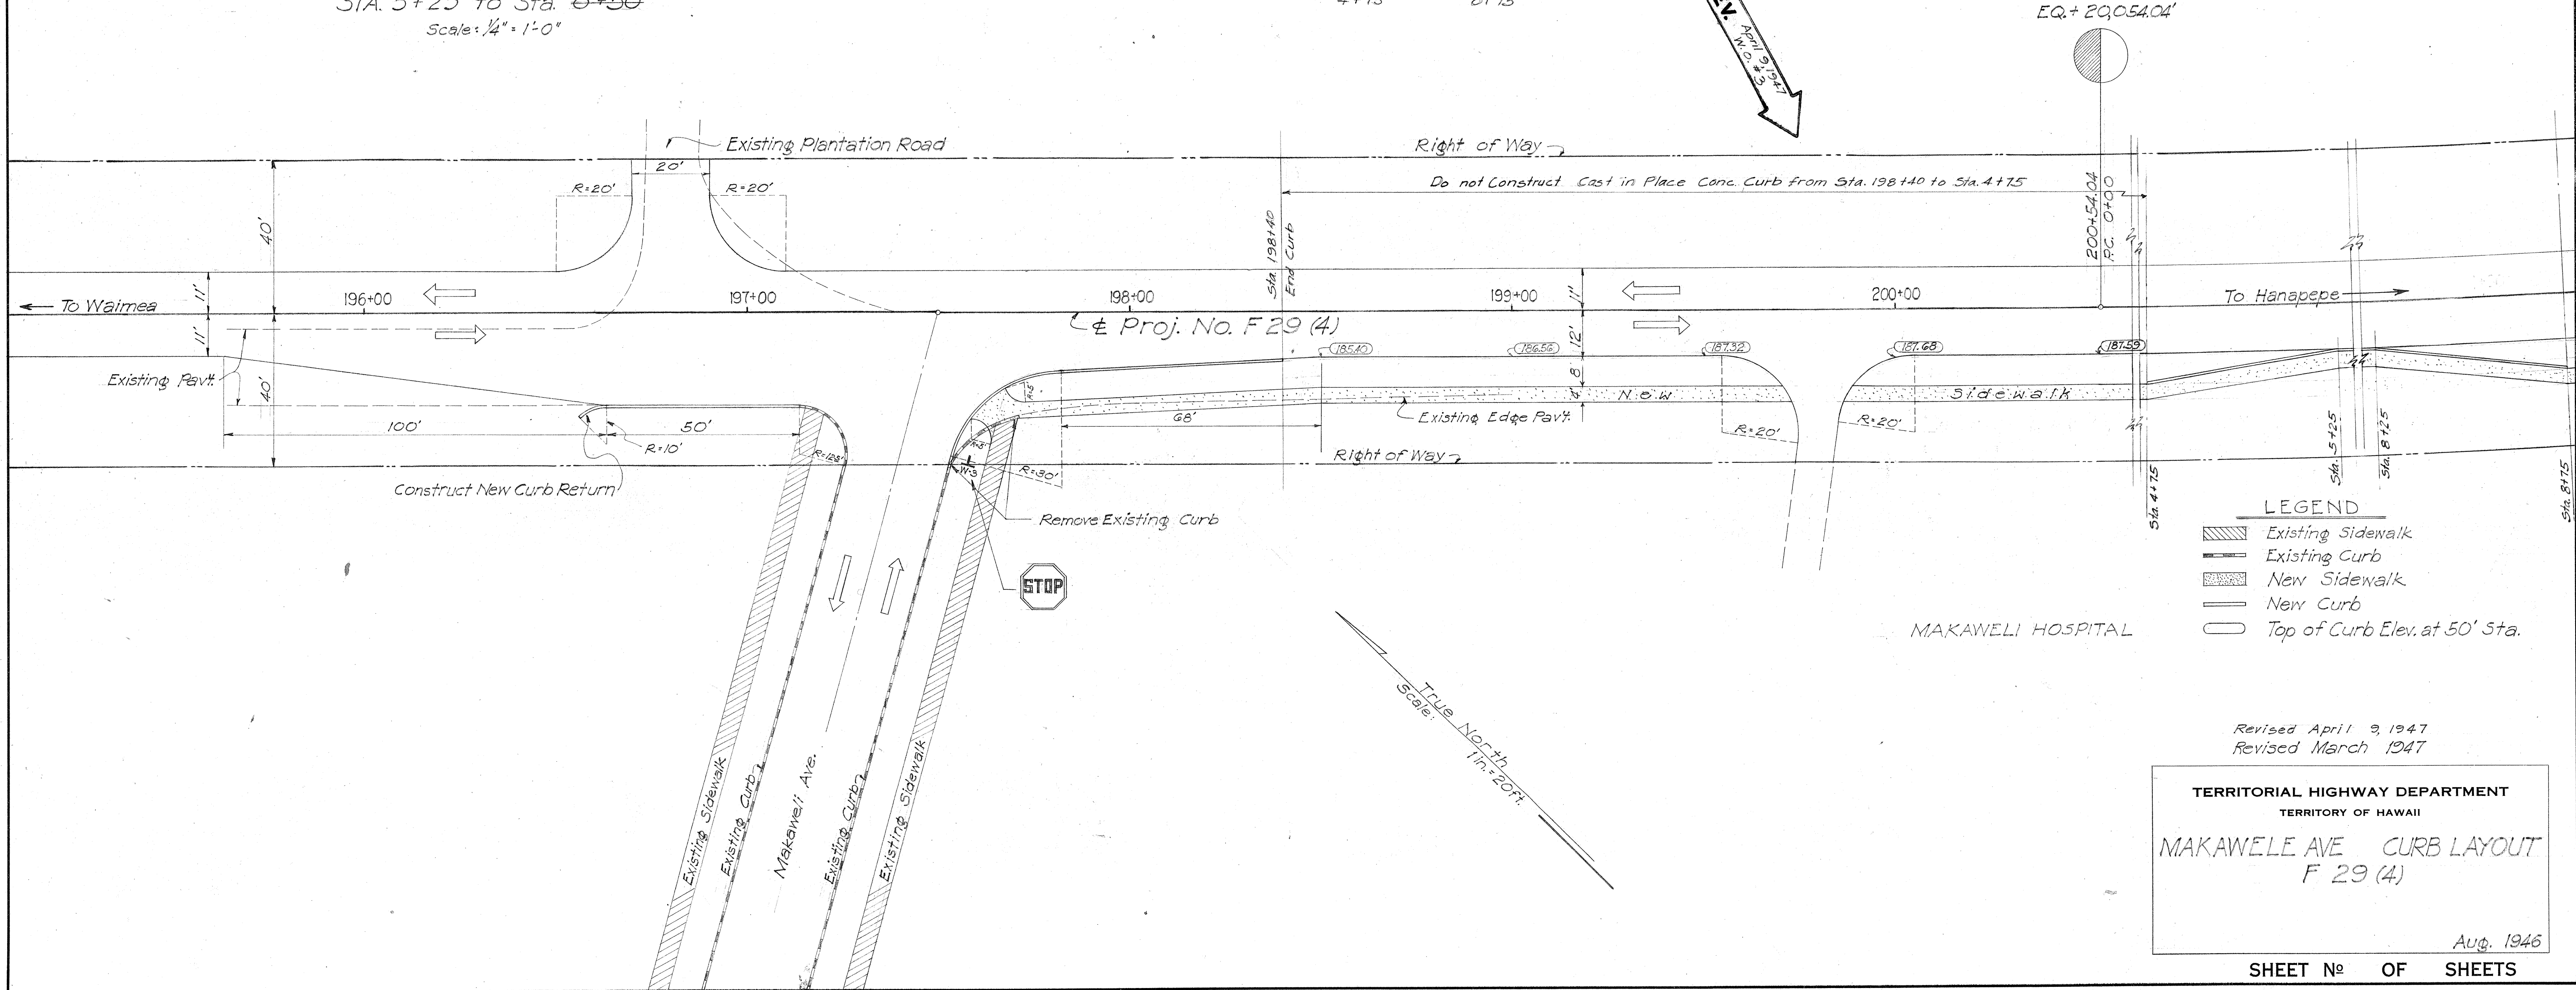

- LEGEND
- Existing Sidewalk
 - Existing Curb
 - New Sidewalk
 - New Curb
 - Top of Curb Elev. at 50' Sta.

Revised April 9, 1947
Revised March 1947

TERRITORIAL HIGHWAY DEPARTMENT
TERRITORY OF HAWAII

MAKAWELE AVE CURB LAYOUT
F 29 (4)

Aug. 1946

SHEET No. 10 OF 53 SHEETS