

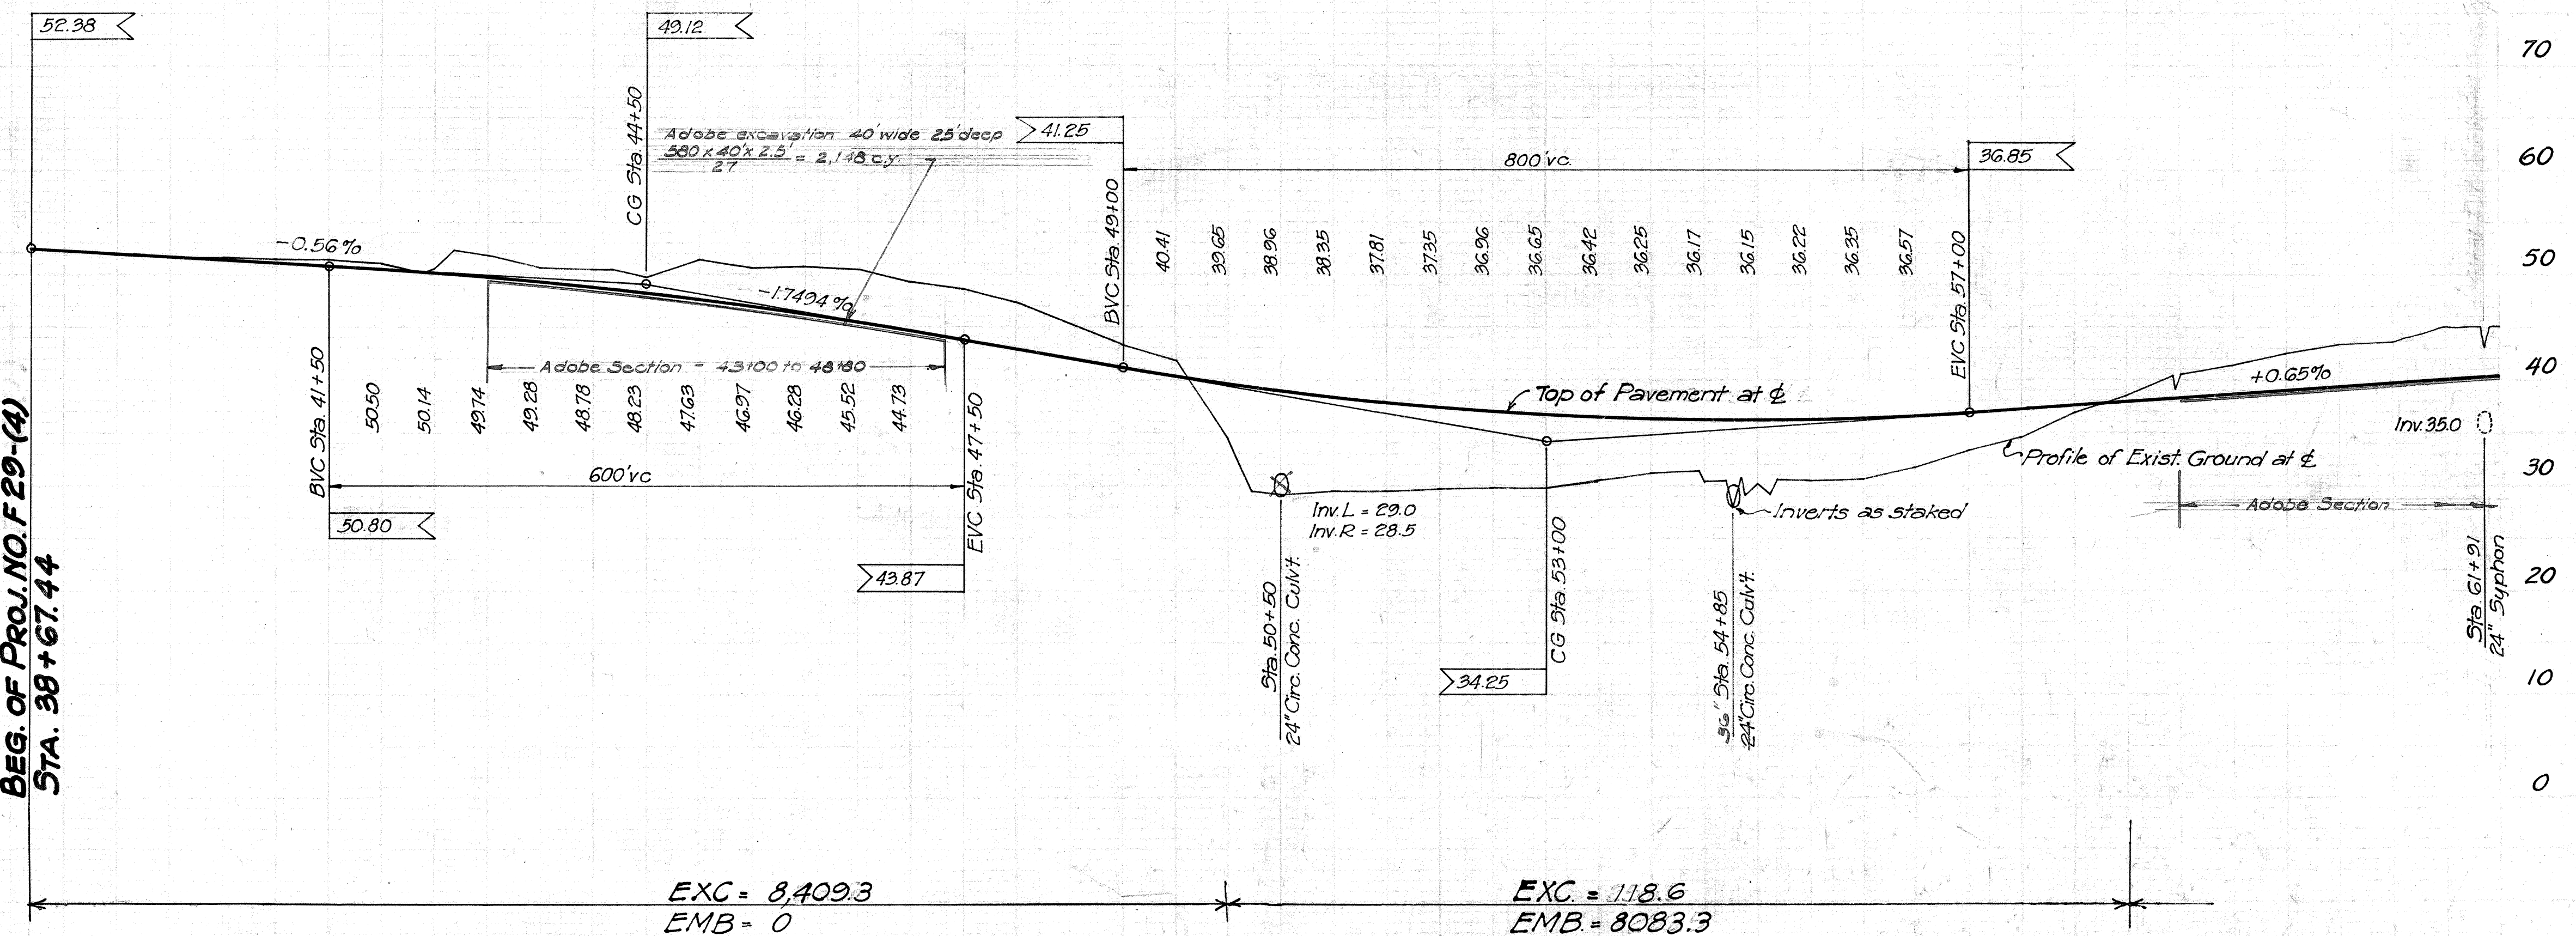
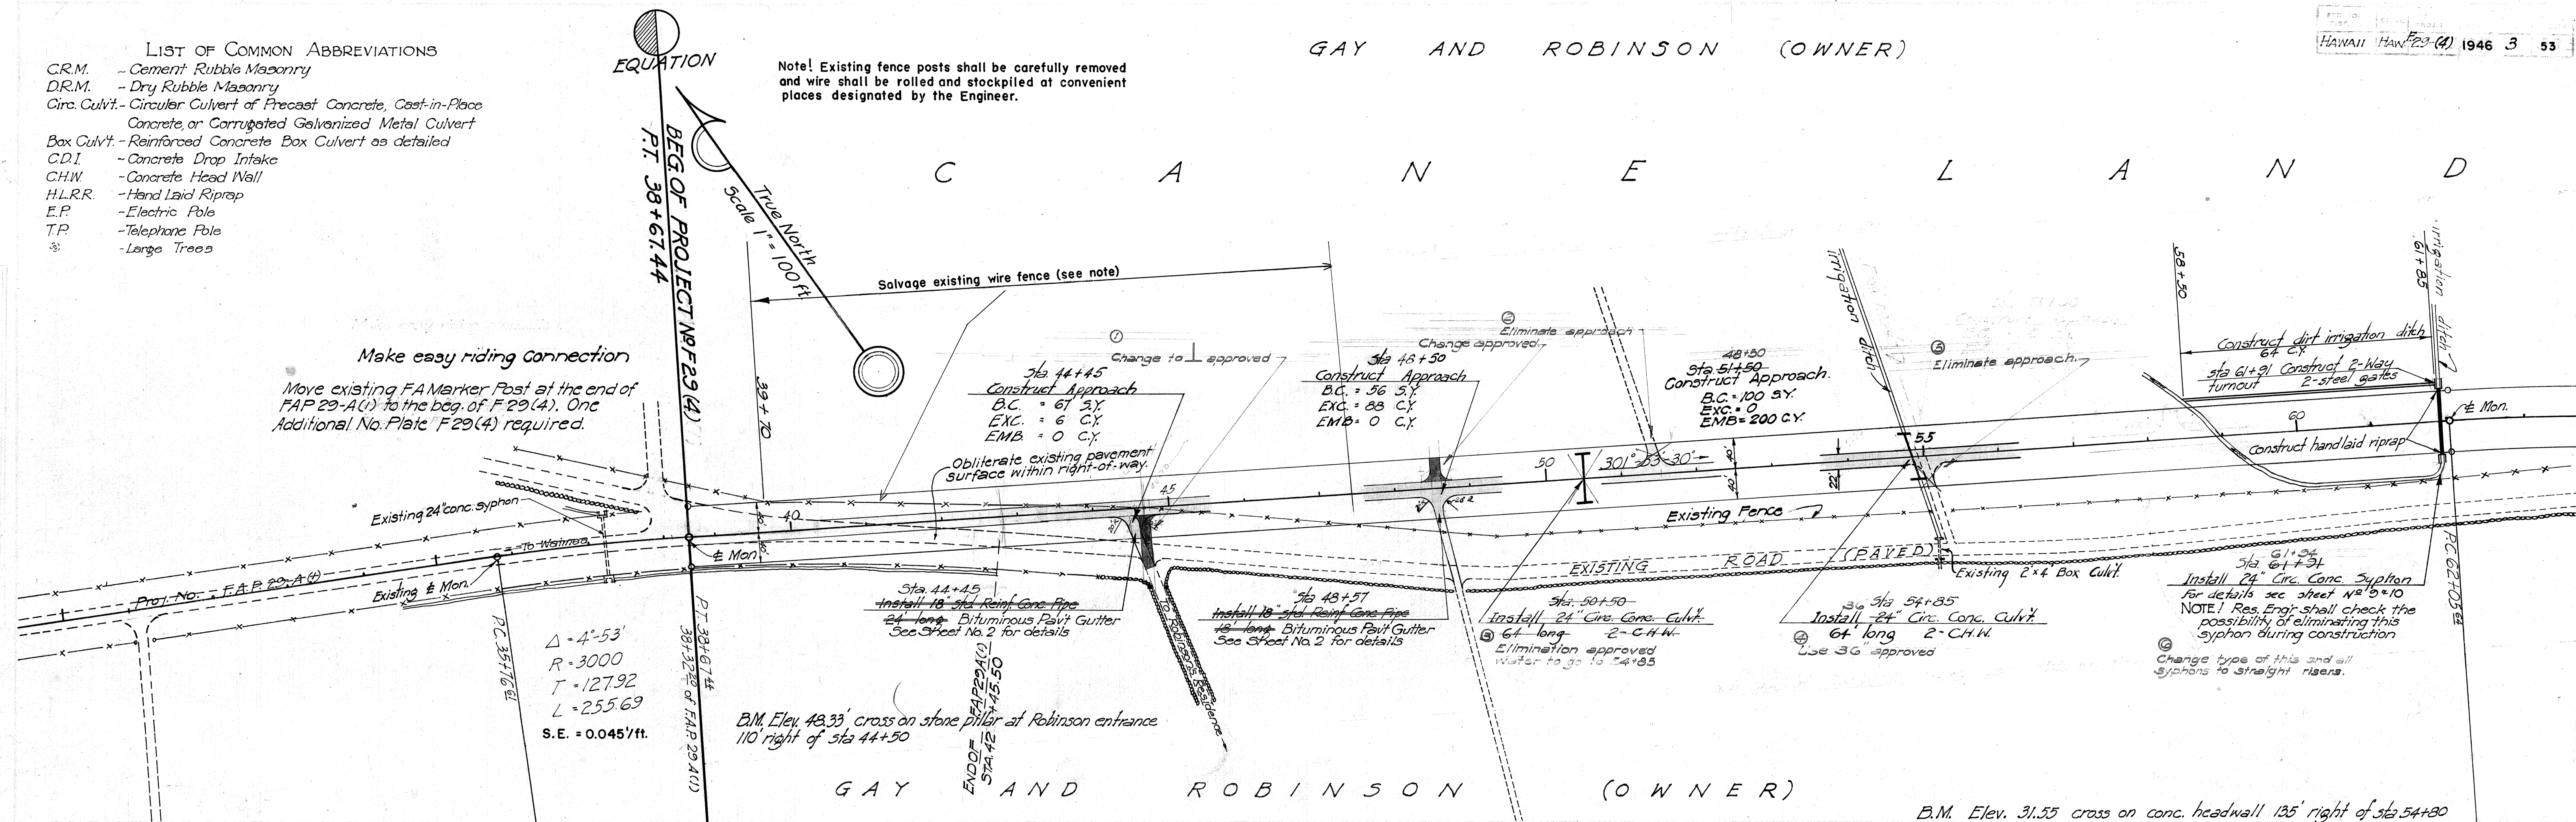


- LIST OF COMMON ABBREVIATIONS
- CR.M. - Cement Rubble Masonry
 - DR.M. - Dry Rubble Masonry
 - Circ. Culvt. - Circular Culvert of Precast Concrete, Cast-in-Place Concrete, or Corrugated Galvanized Metal Culvert
 - Box Culvt. - Reinforced Concrete Box Culvert as detailed
 - C.D.I. - Concrete Drop Intake
 - CH.W. - Concrete Head Wall
 - H.L.R.R. - Hand Laid Riprap
 - E.P. - Electric Pole
 - T.P. - Telephone Pole
 - 3. - Large Trees



GAY AND ROBINSON (OWNER)

Note: Existing fence posts shall be carefully removed and wire shall be rolled and stockpiled at convenient places designated by the Engineer.

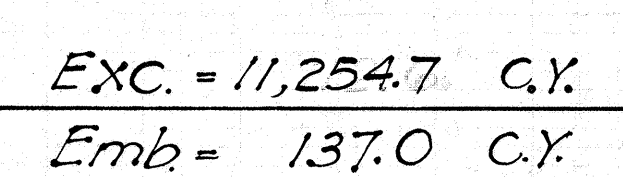



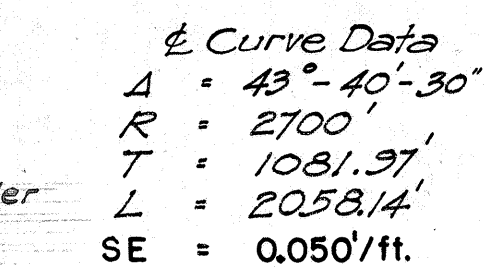


Exc. = 415.8 C.Y.
Emb. = 15,655.0 C.Y.

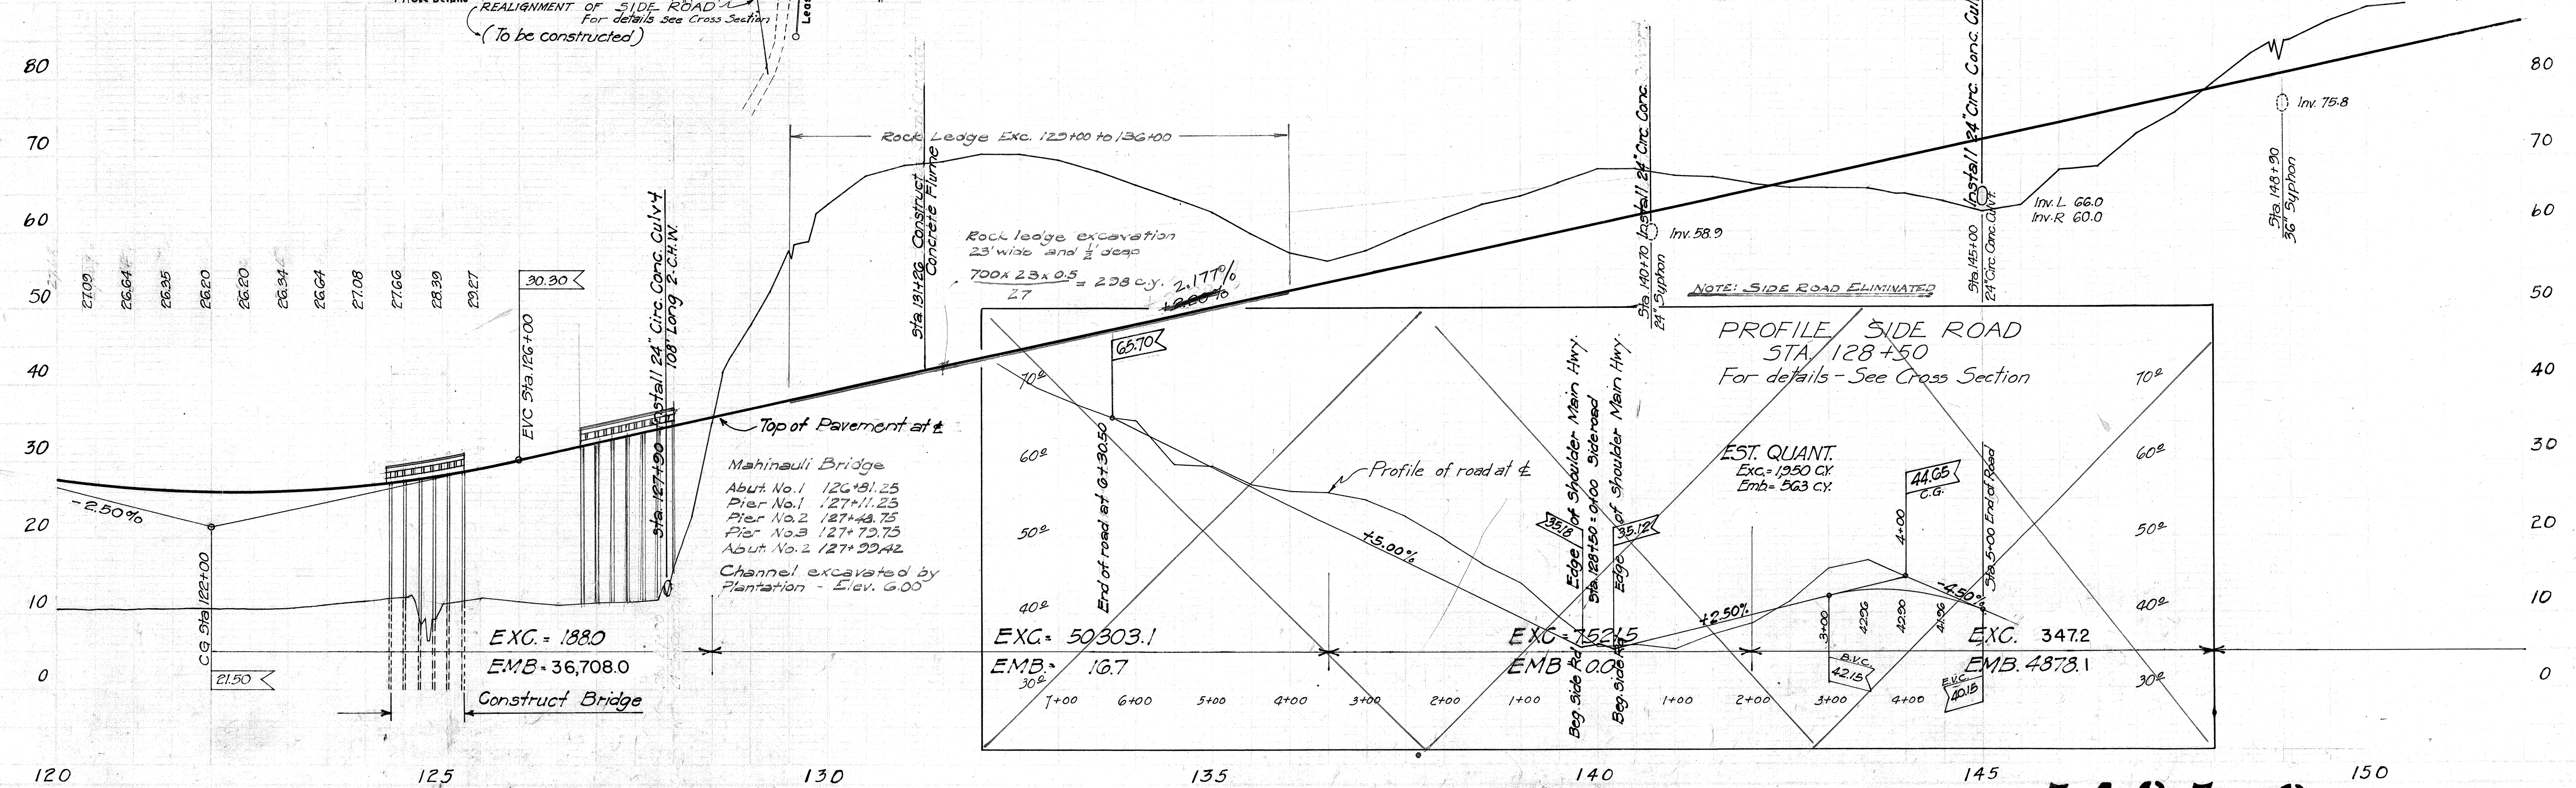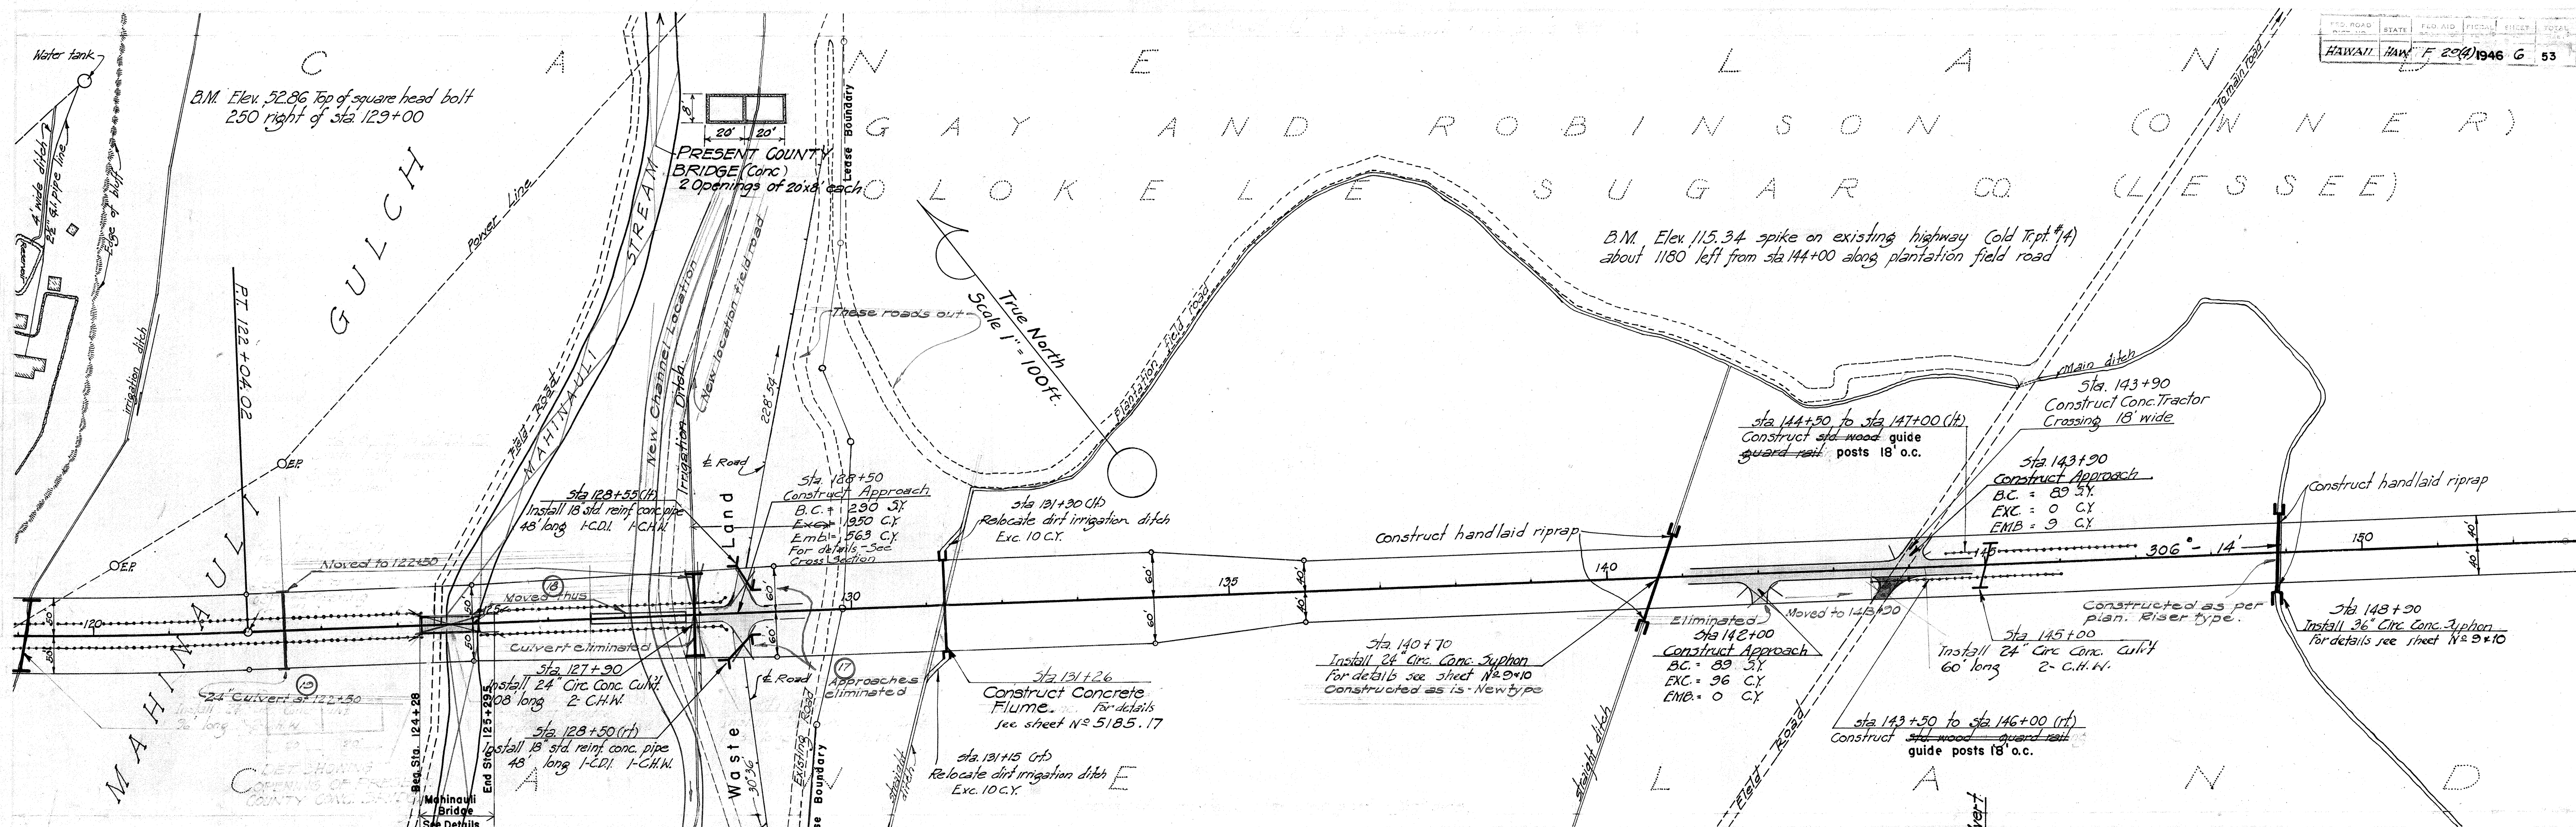


5185.7

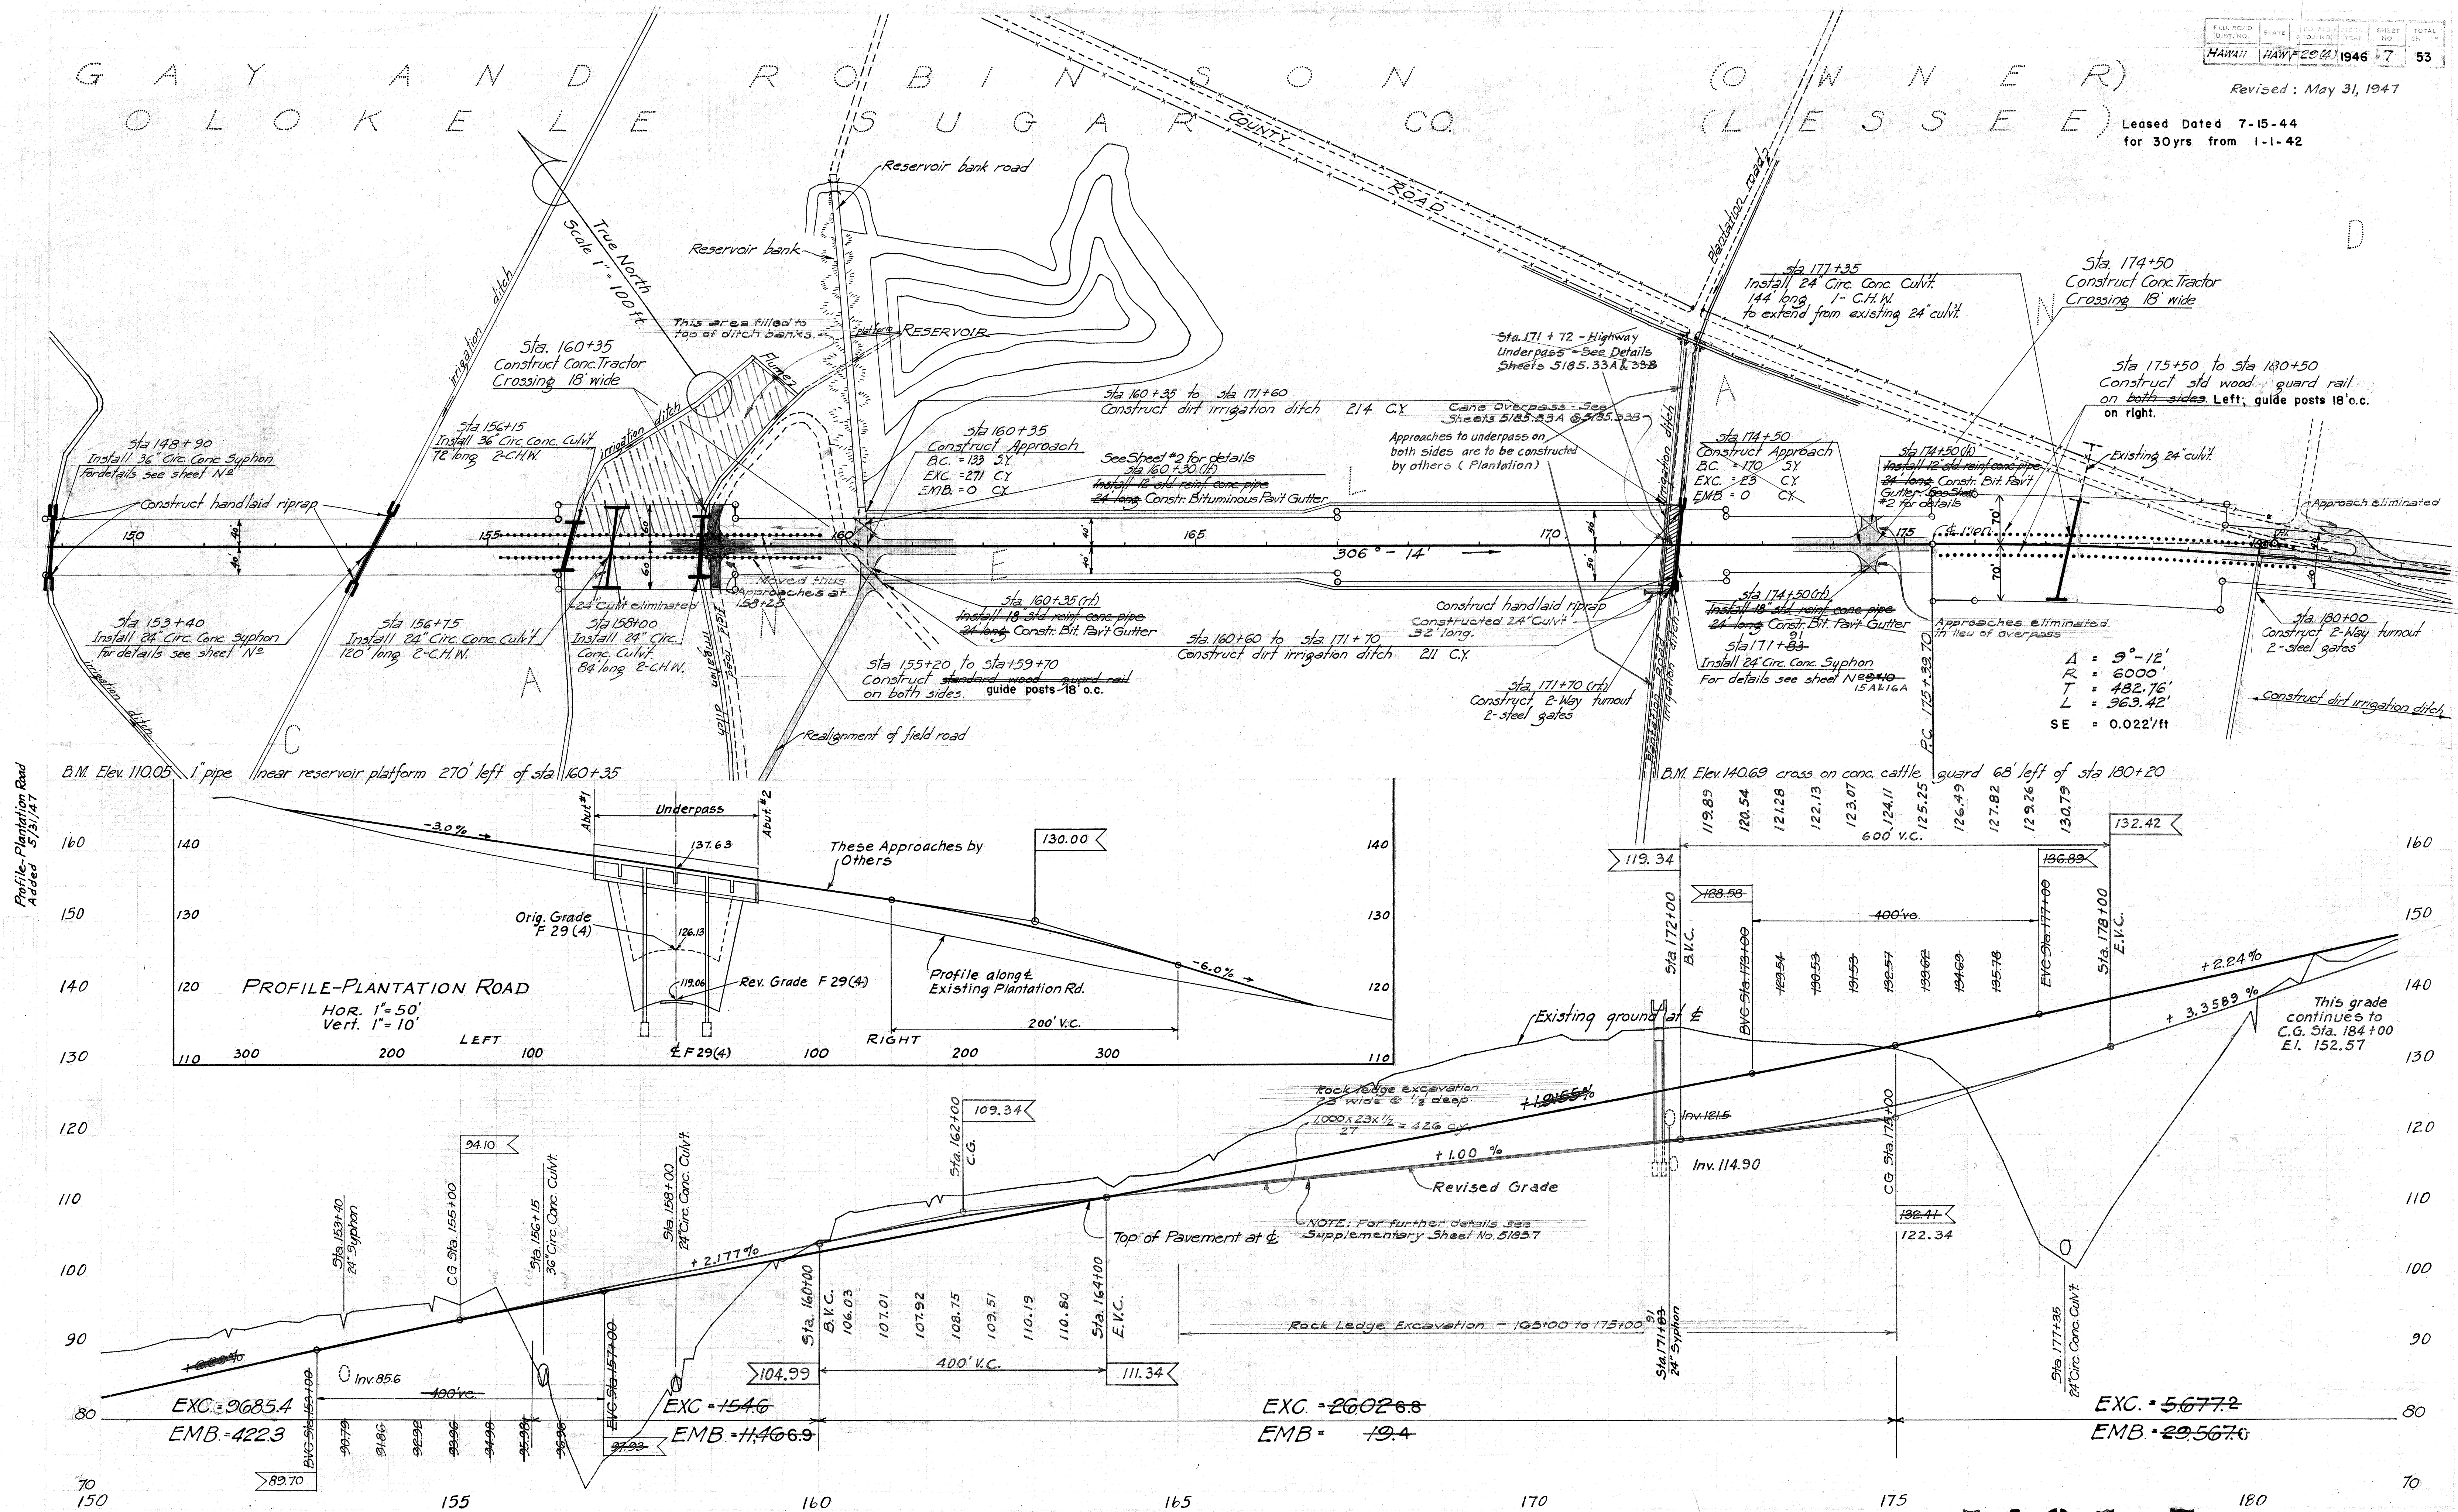

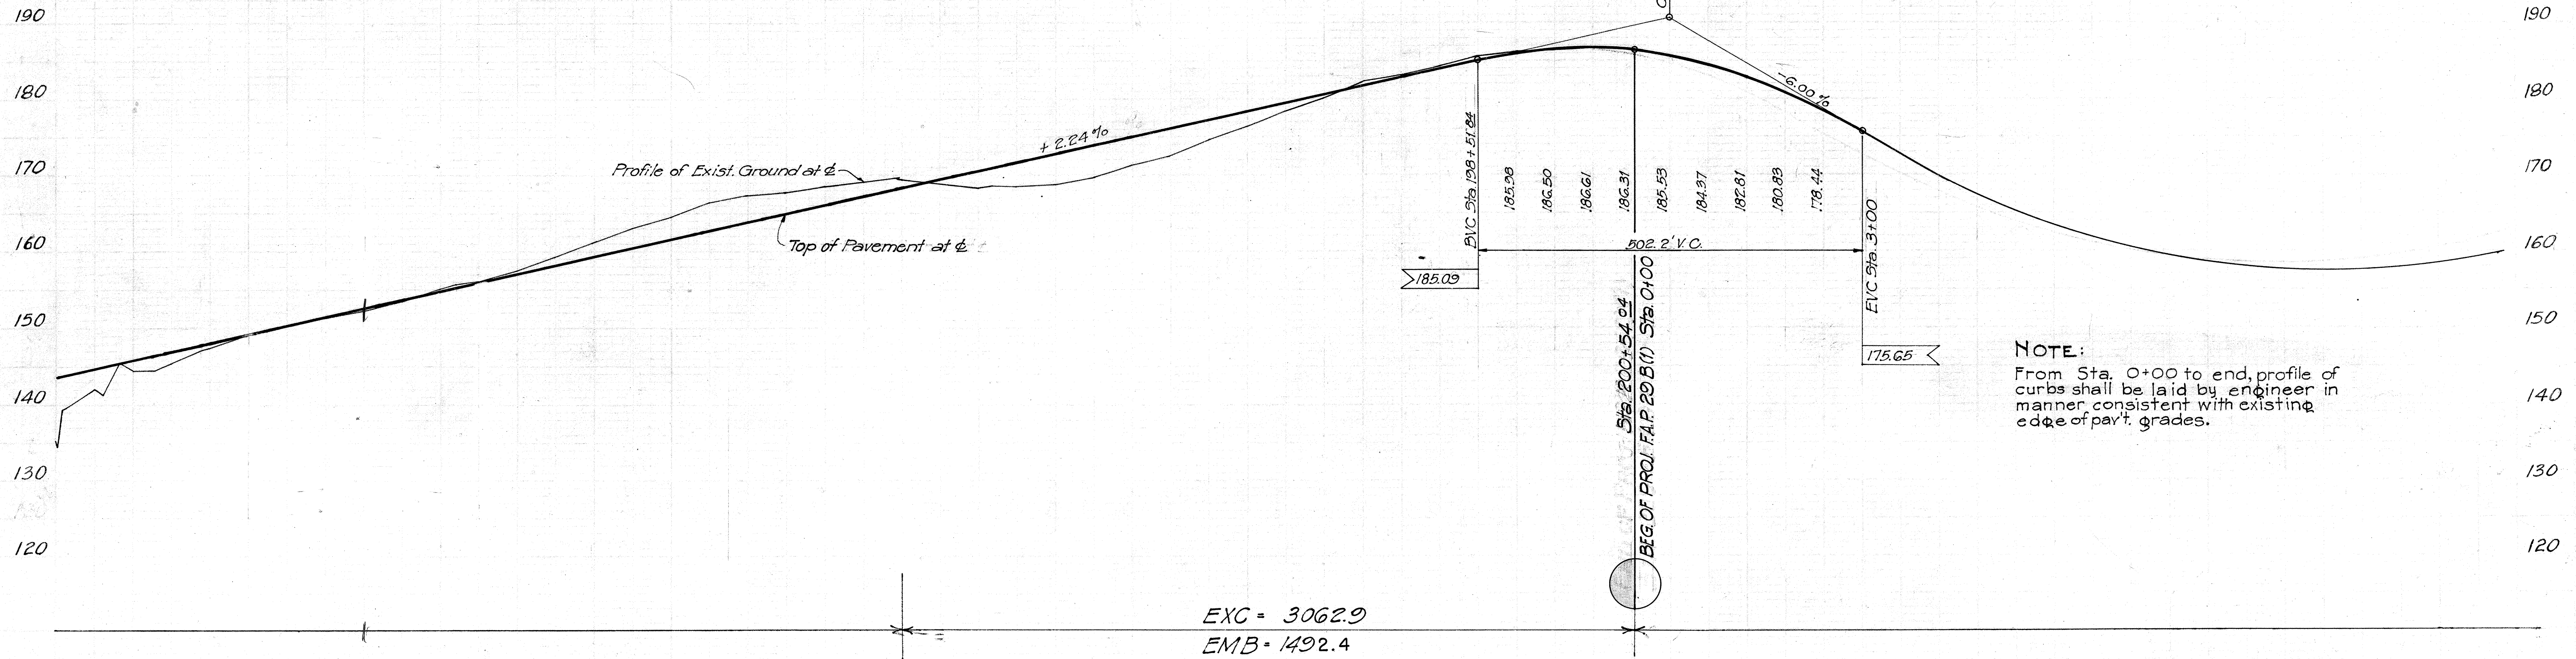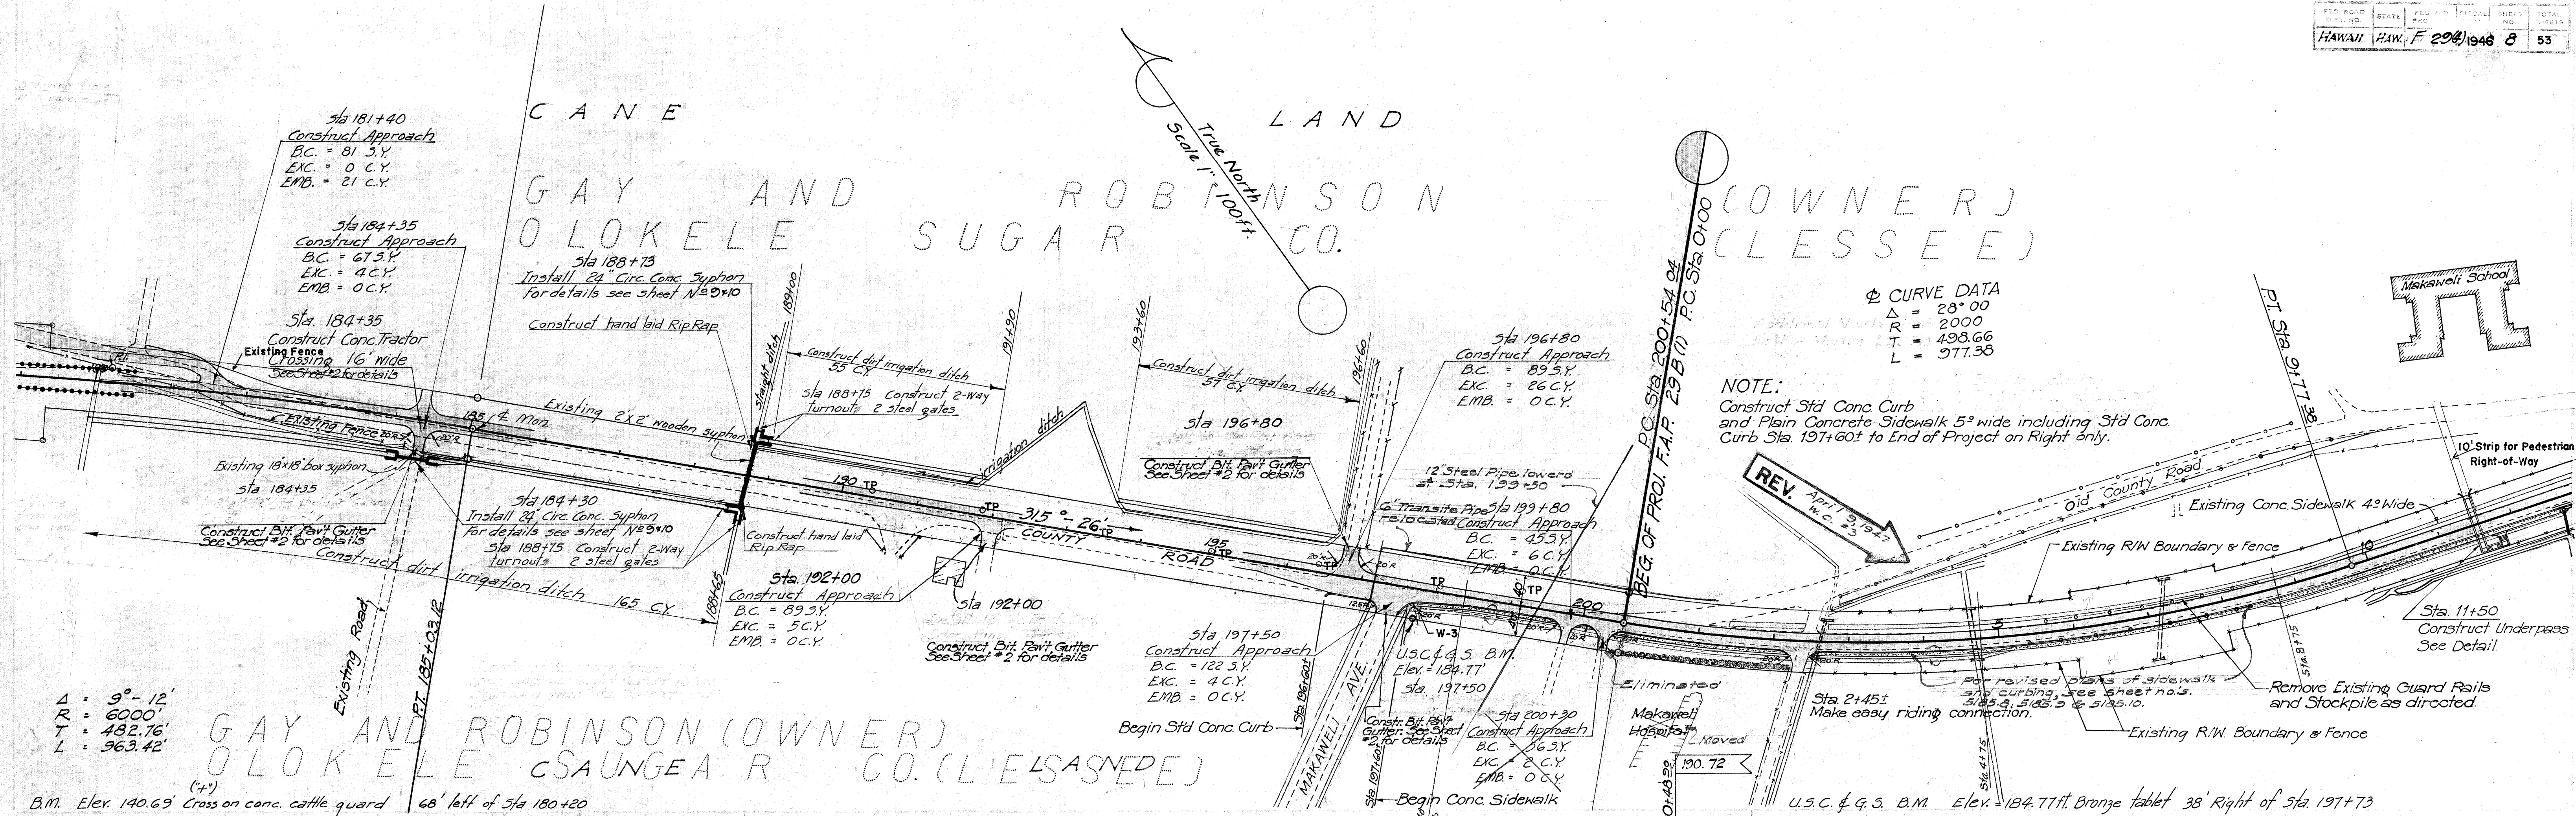

PLAN
NOTES:
1. SEE DETAIL FOR CATCH BASIN
2. SEE DETAIL FOR UNDERPASS
3. SEE DETAIL FOR CURB AND SIDEWALK
4. SEE DETAIL FOR FUME
5. SEE DETAIL FOR APPROACH
6. SEE DETAIL FOR CATCH BASIN
7. SEE DETAIL FOR UNDERPASS
8. SEE DETAIL FOR CURB AND SIDEWALK
9. SEE DETAIL FOR FUME
10. SEE DETAIL FOR APPROACH

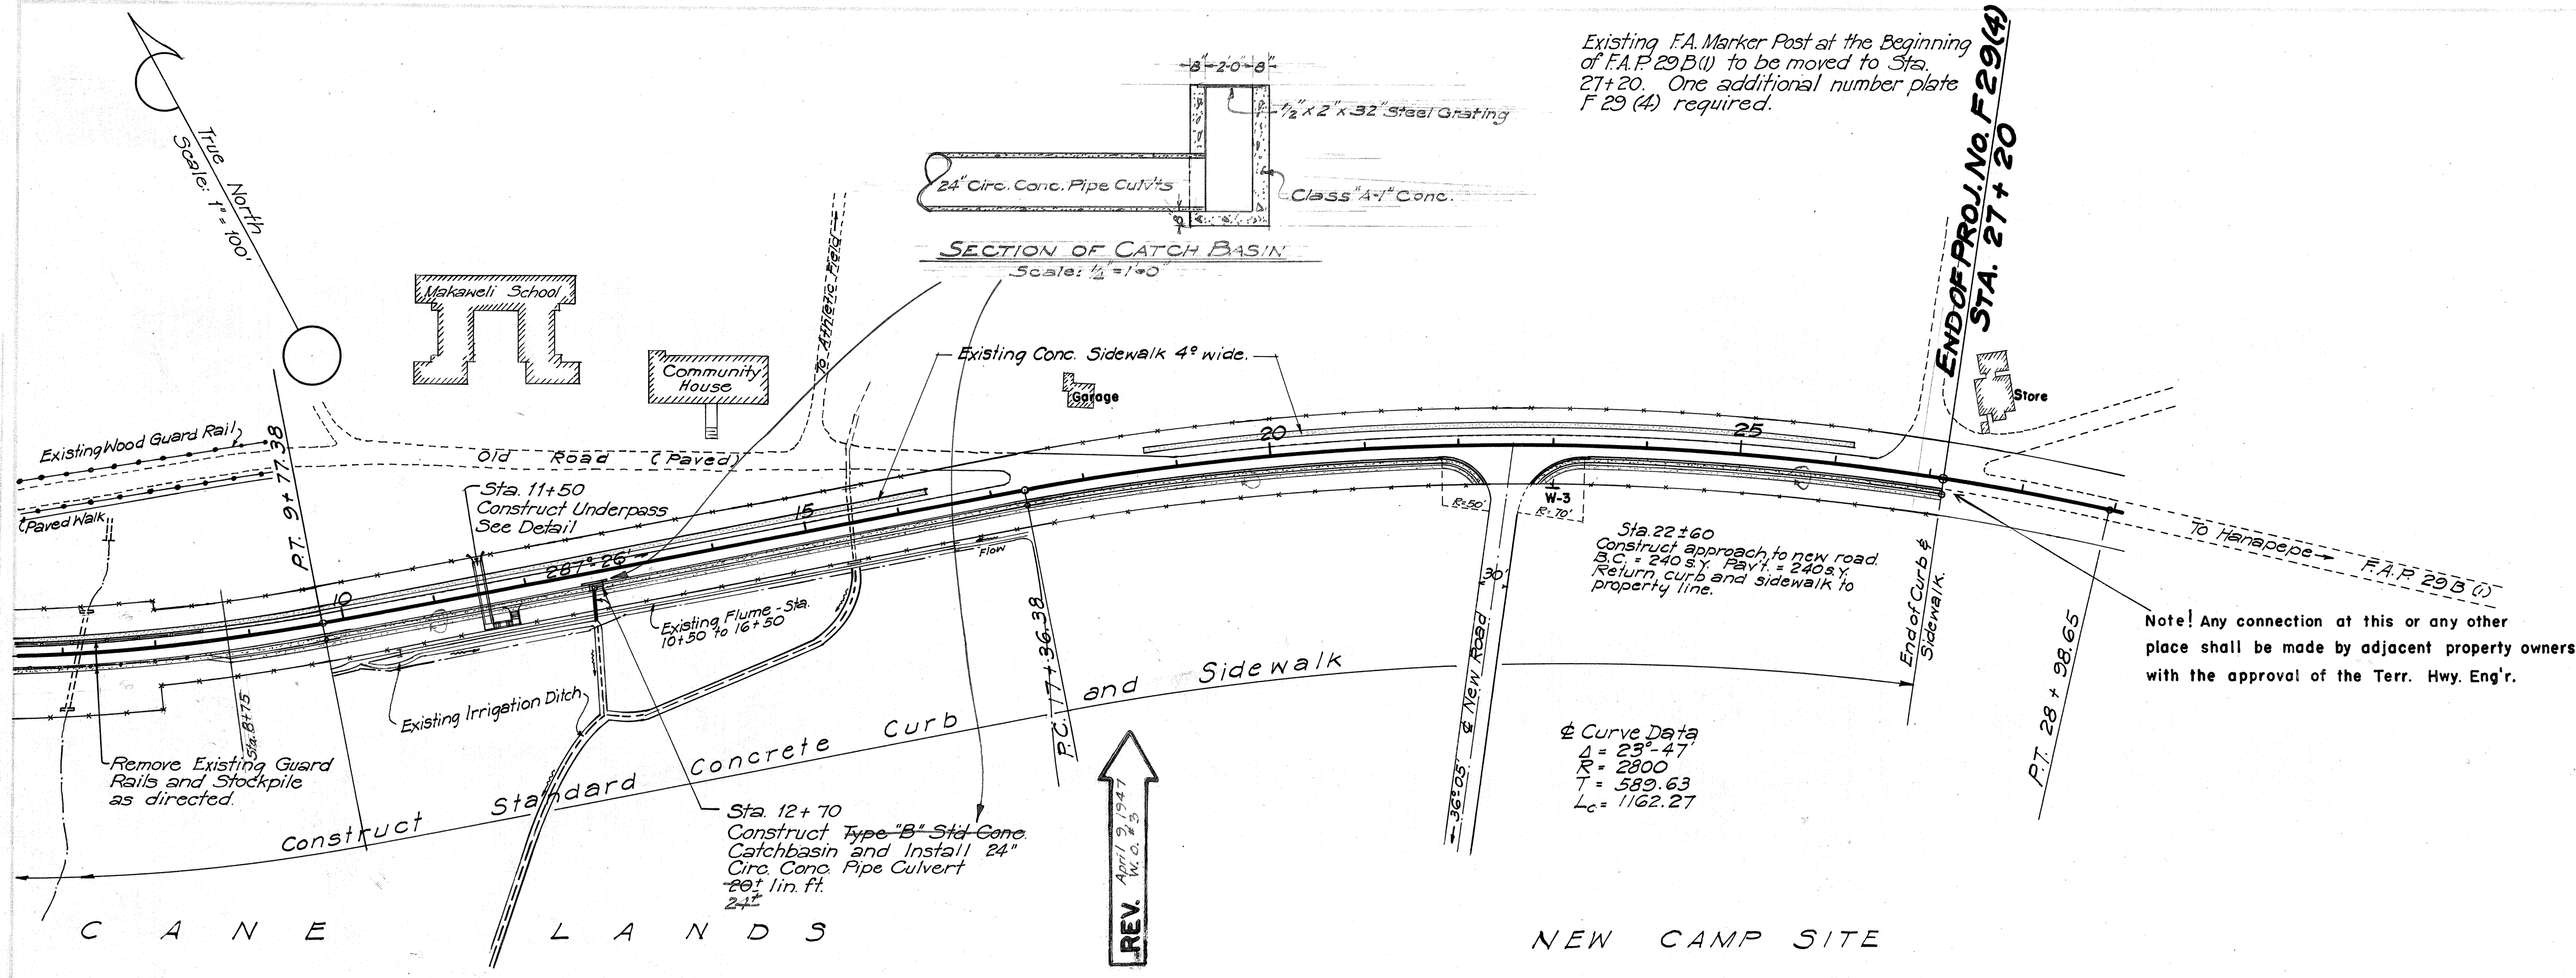

PROFILE
NOTES:
1. SEE DETAIL FOR CATCH BASIN
2. SEE DETAIL FOR UNDERPASS
3. SEE DETAIL FOR CURB AND SIDEWALK
4. SEE DETAIL FOR FUME
5. SEE DETAIL FOR APPROACH
6. SEE DETAIL FOR CATCH BASIN
7. SEE DETAIL FOR UNDERPASS
8. SEE DETAIL FOR CURB AND SIDEWALK
9. SEE DETAIL FOR FUME
10. SEE DETAIL FOR APPROACH