


FED. ROAD DIST. NO.	STATE	FED. AID PROJ. NO.	FISCAL YEAR	SHEET NO.	TOTAL SHEETS
HAWAII	HAW.	F 29(4)	1947	15A	53

Revised: Apr. 1947.
24" Syphon at Sta. 171+83 moved to Sta. 171+91.

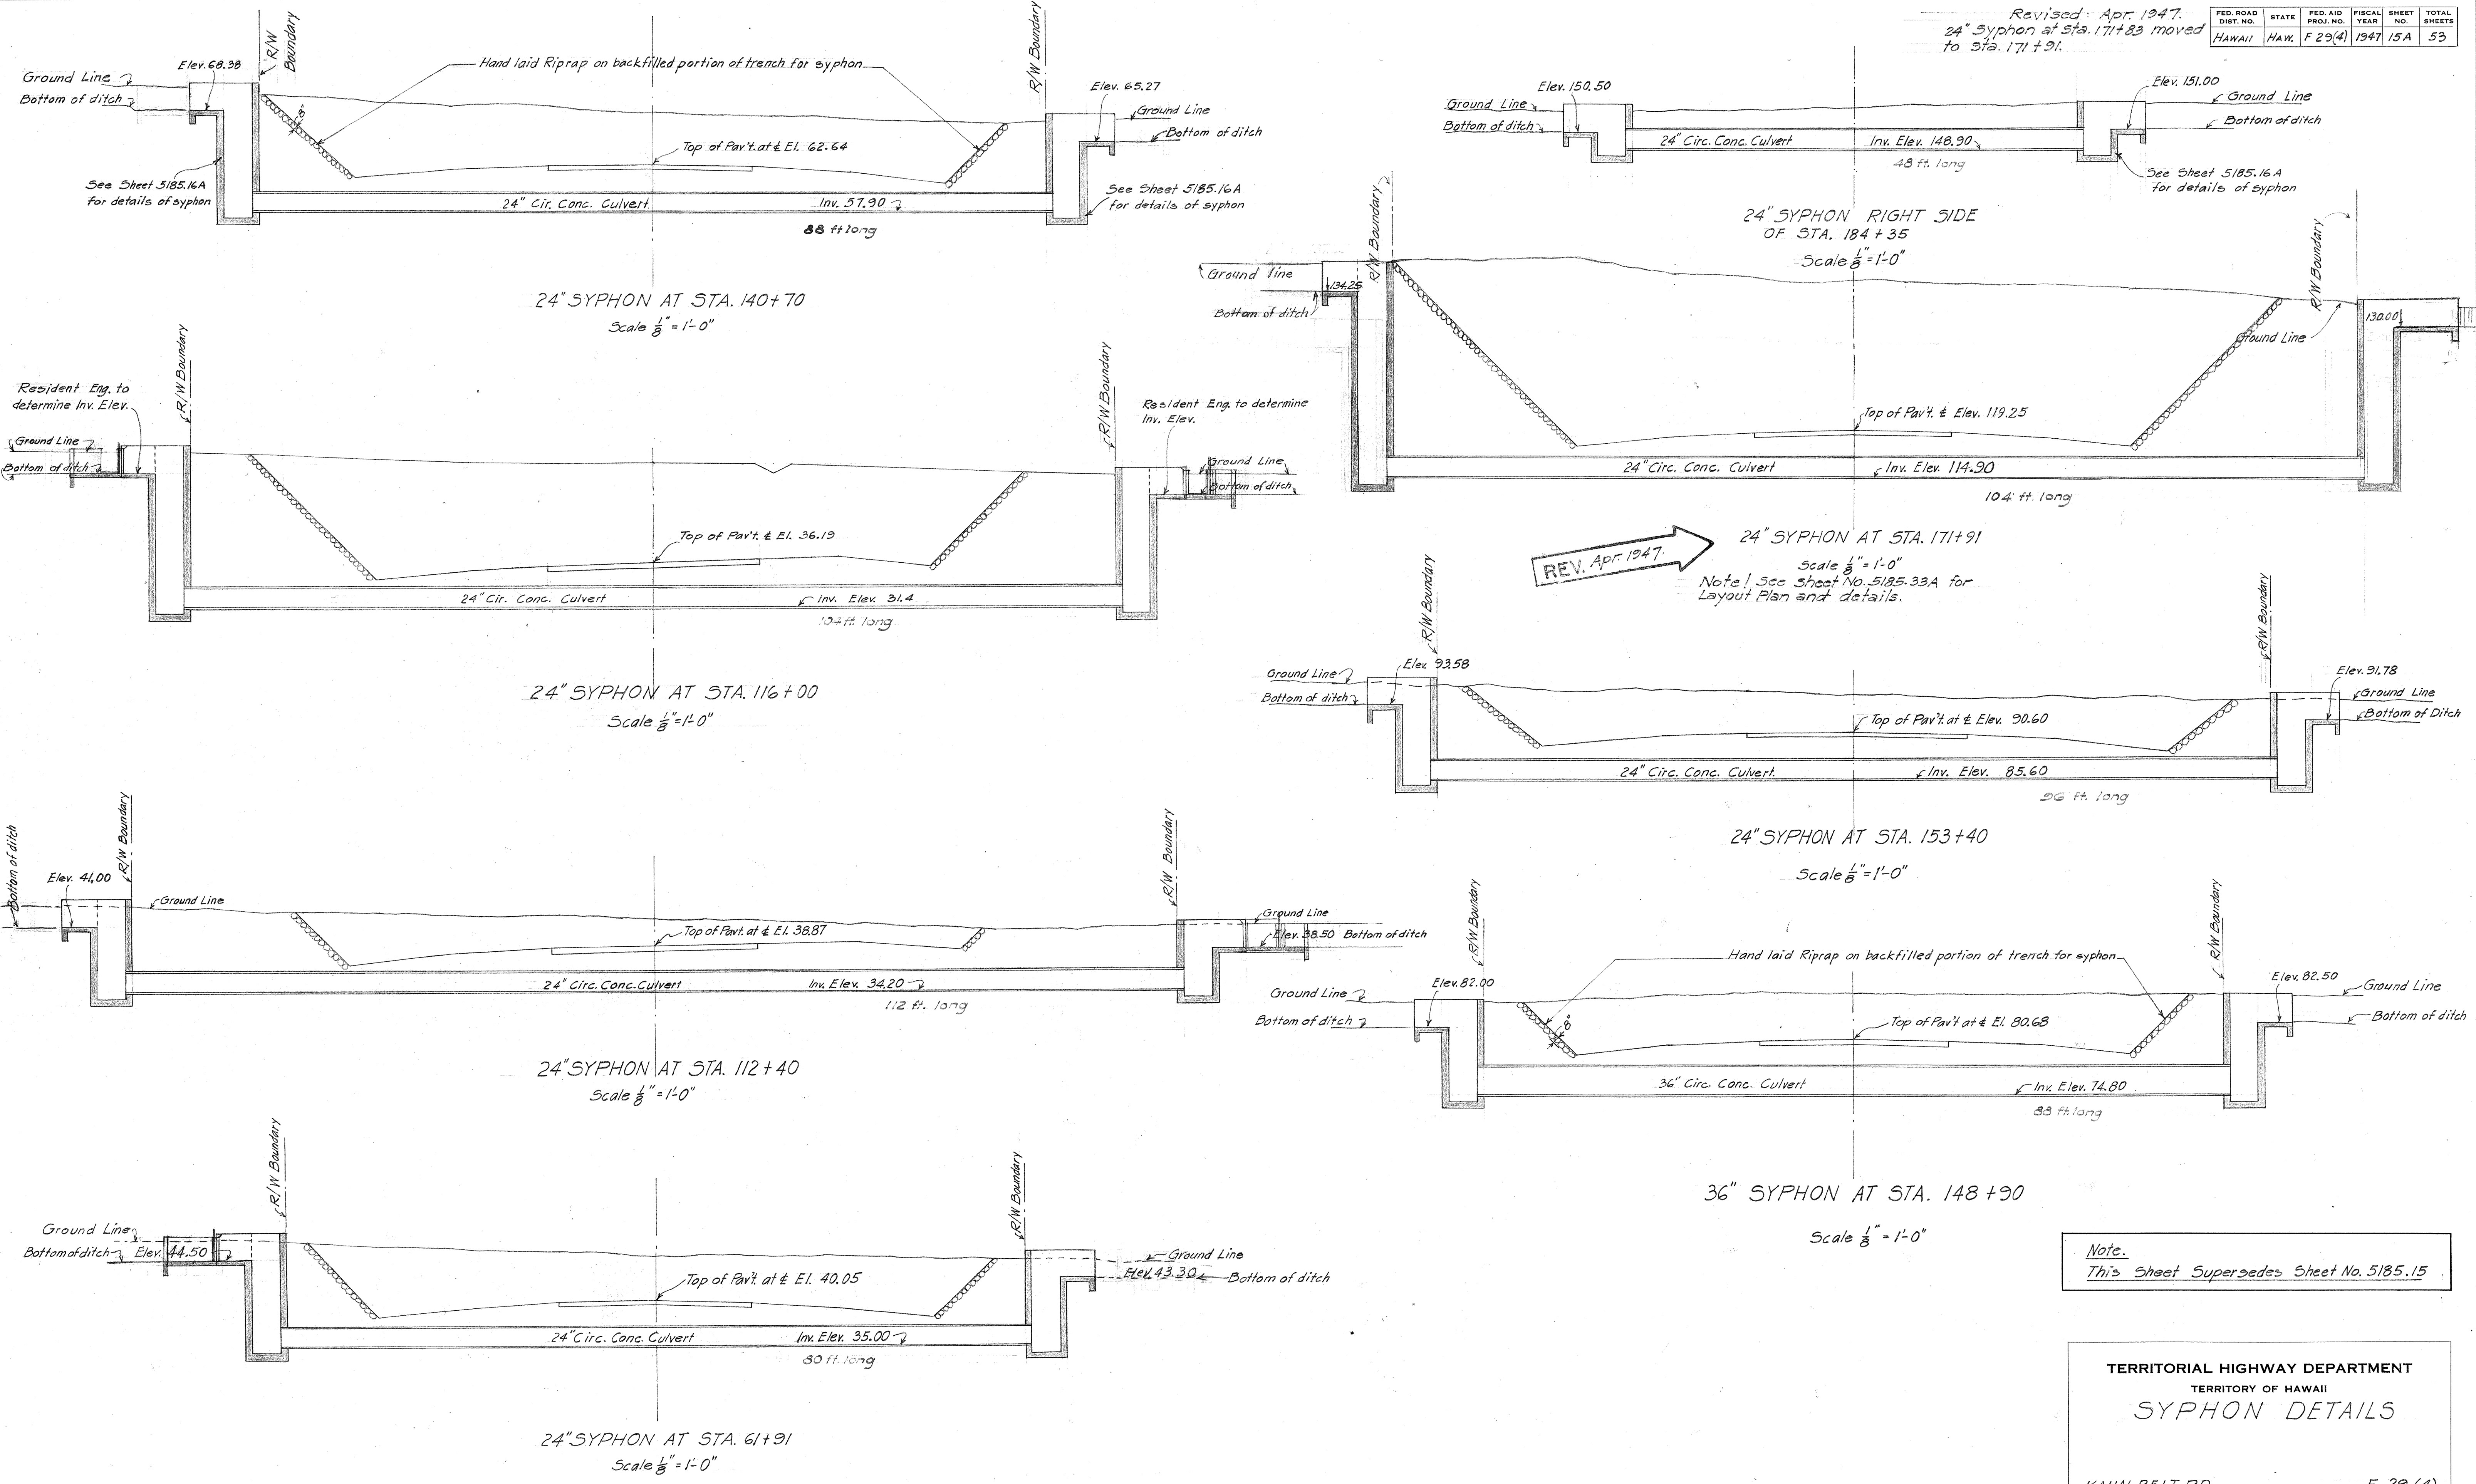

Note.
This Sheet Supersedes Sheet No. 5185.15


TERRITORIAL HIGHWAY DEPARTMENT
TERRITORY OF HAWAII
SYPHON DETAILS

KAUALA BELT RD. F 29 (4)
March 1947
SHEET No. 15 OF 53

5185.15A

ORIGINAL PLAN	DATE
DESIGNED BY	3/47
TRACED BY	3/47
QUANTITIES BY	3/47
CHECKED BY	3/47
NOTE BOOK	
No.	

Revised: Apr. 1947.
changes made to turnout and syphon intake and outlet details.
Estimated quantities changed.

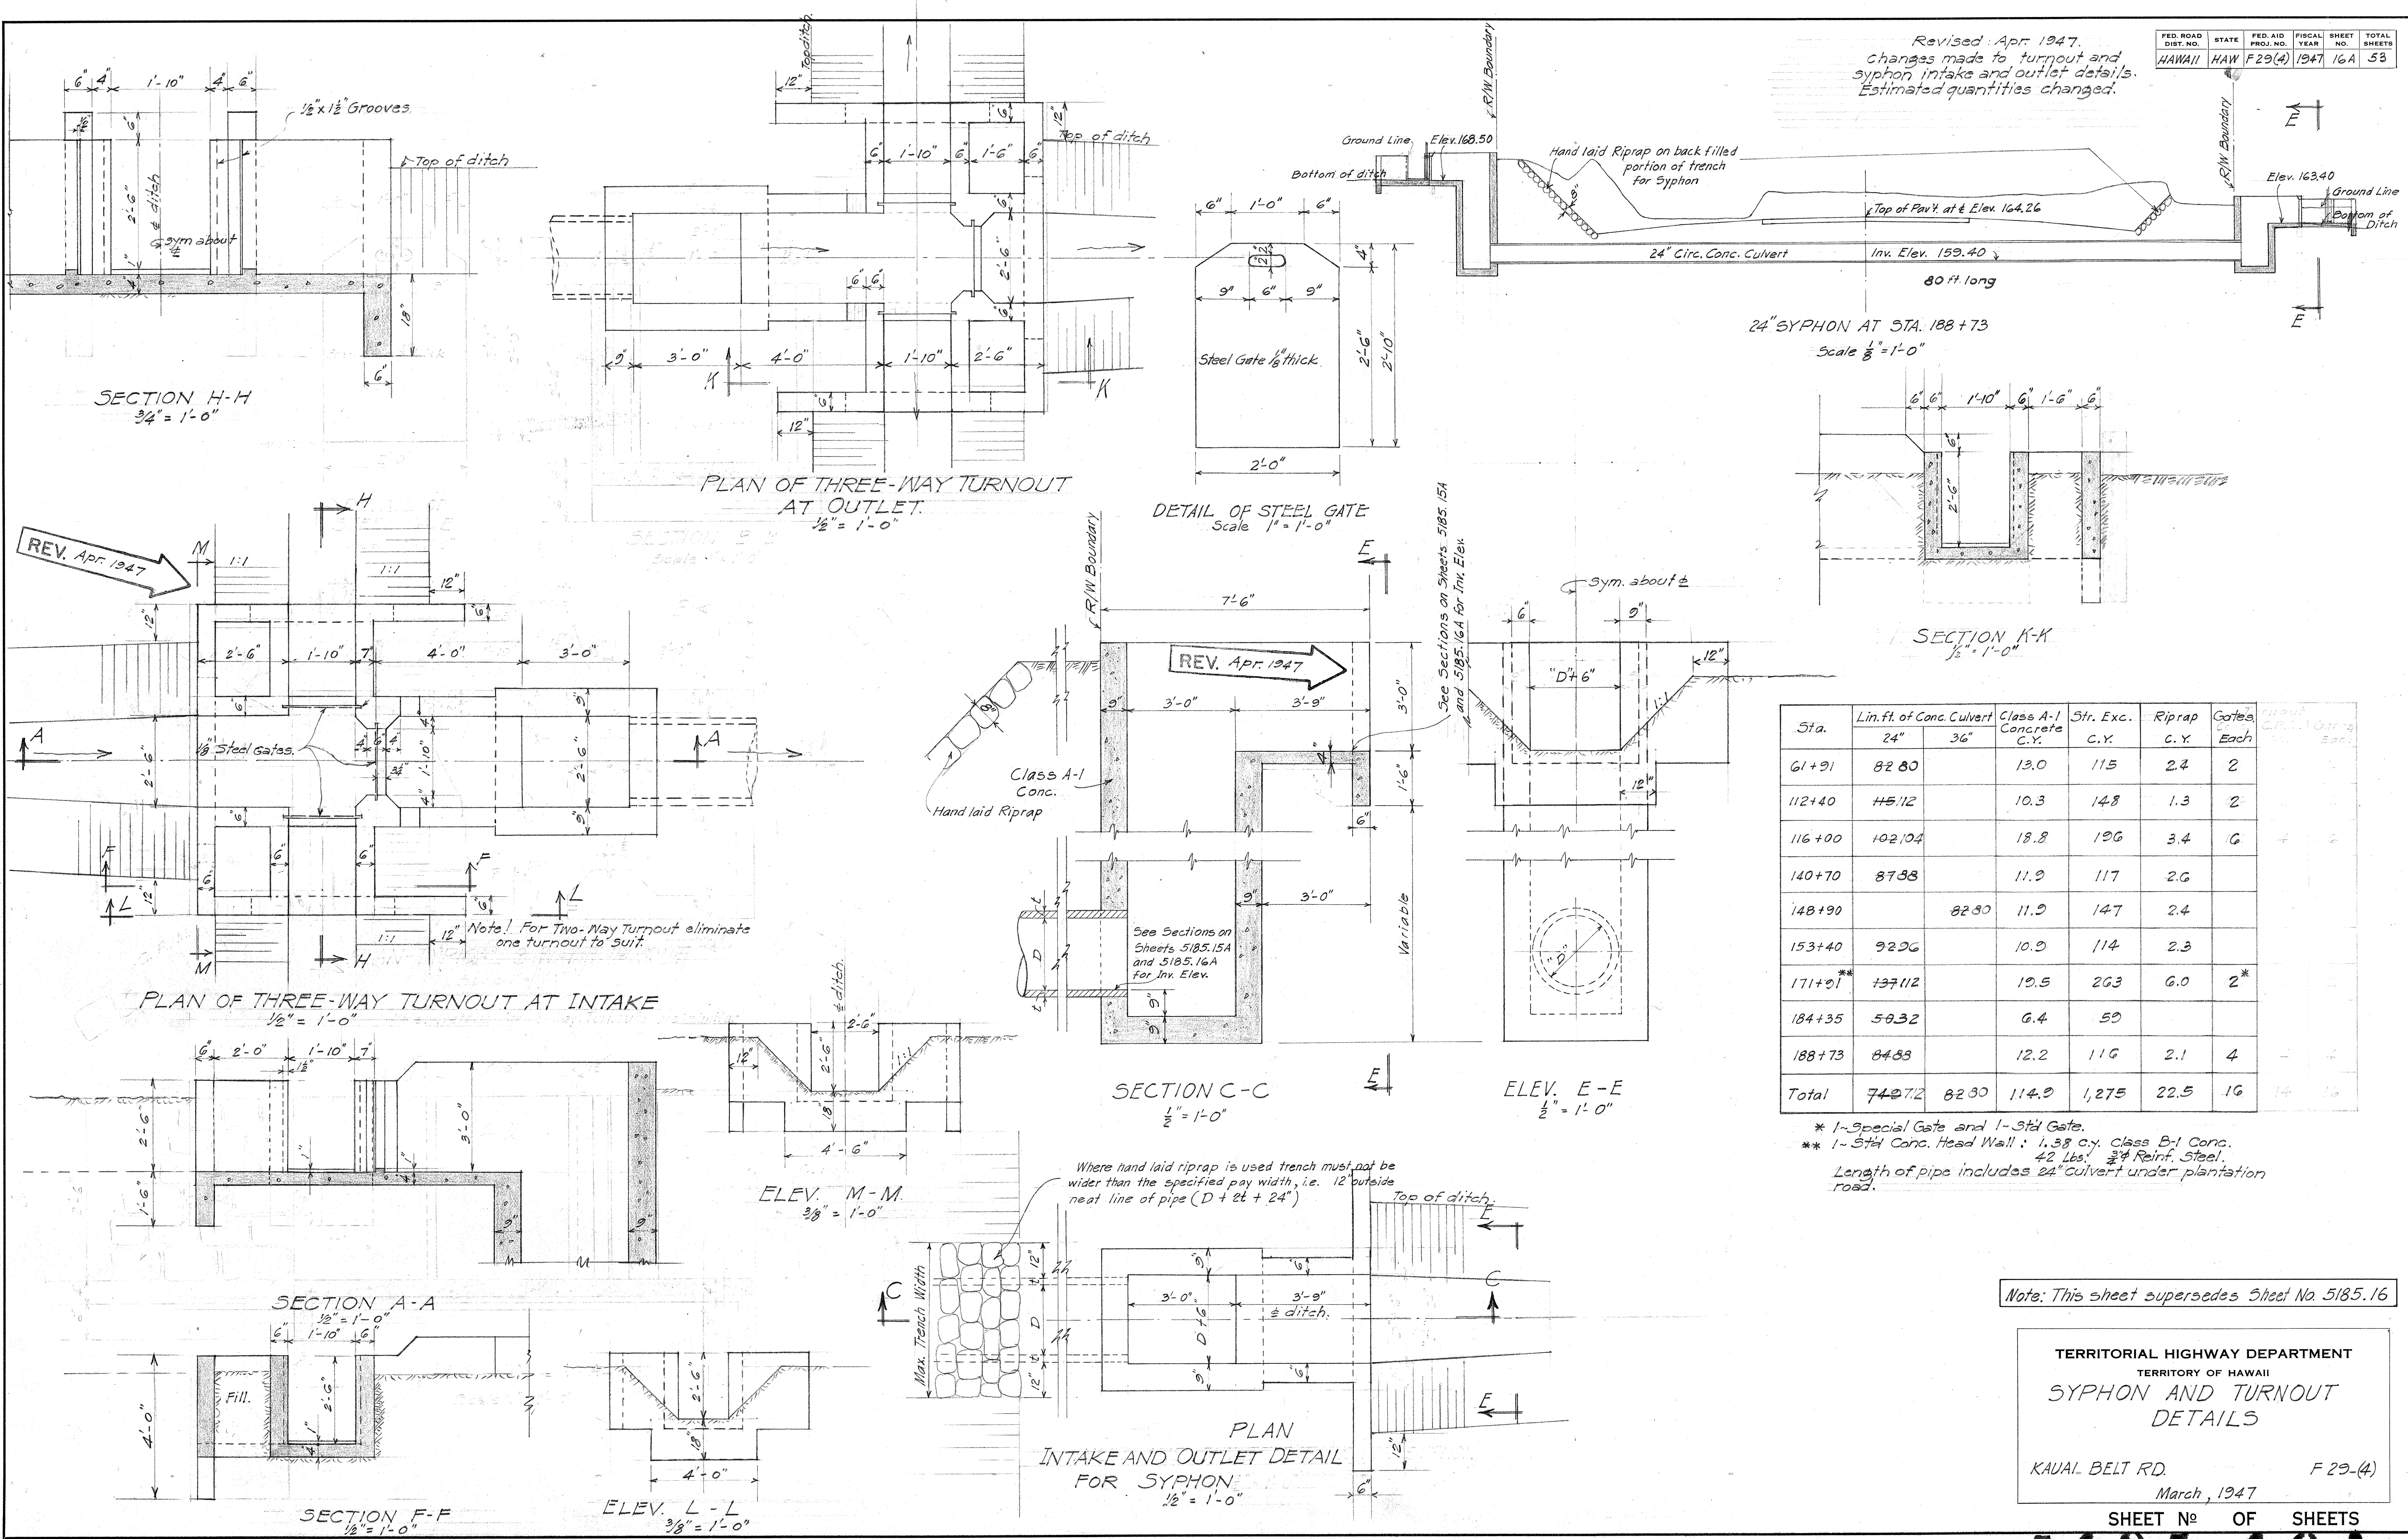

TERRITORIAL HIGHWAY DEPARTMENT
TERRITORY OF HAWAII
SYPHON AND TURNOUT DETAILS
KAUAL BELT RD. F29-(4)
March, 1947
SHEET No. OF SHEETS

5185.16A

ORIGINAL PLAN
DESIGNED BY: [Signature]
DRAWN BY: [Signature]
CHECKED BY: [Signature]
DATE: 3/17/47