




FED. ROAD DIST. NO.	STATE	FED. AID PROJ. NO.	FISCAL YEAR	SHEET NO.	TOTAL SHEETS
HAWAII	HAWAII	F 12 (16)	1948	2	2

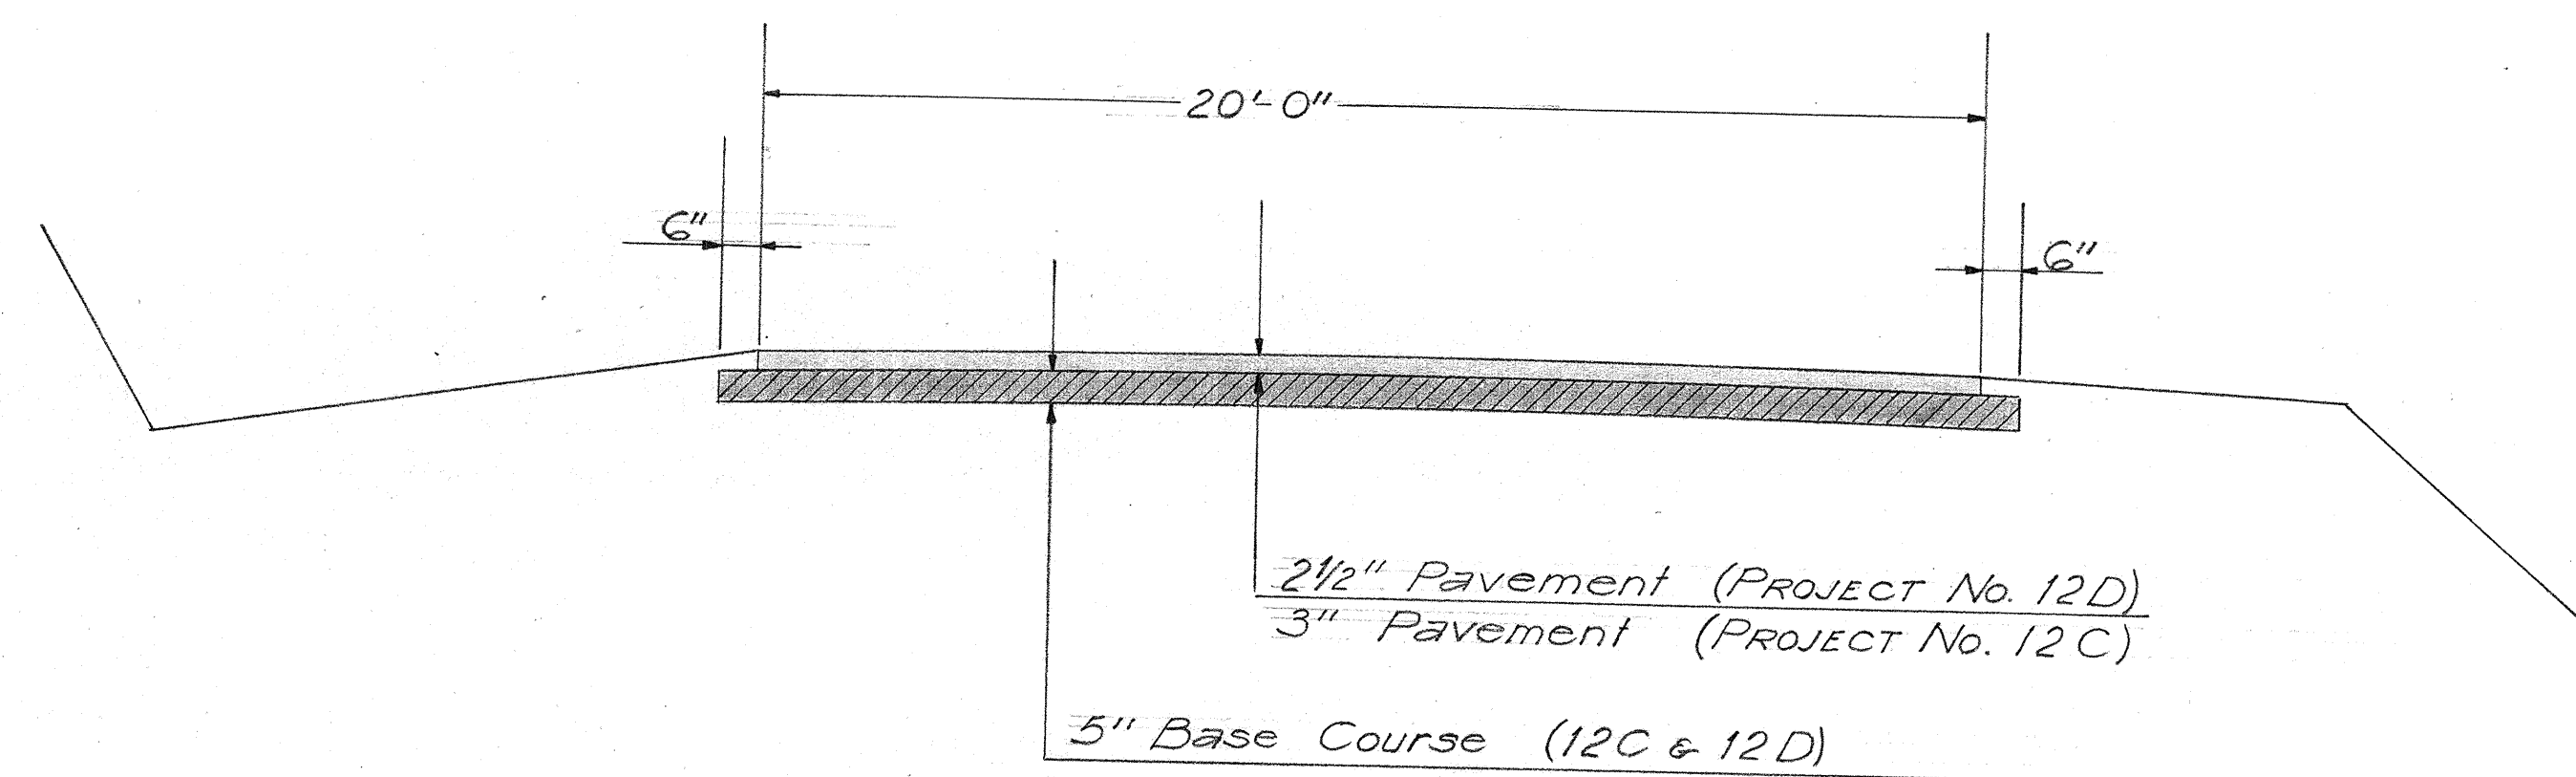

TYPICAL SECTION
AS ORIGINALLY CONSTRUCTED
F.A. PROJECTS No. 12C & 12D
NOT TO SCALE

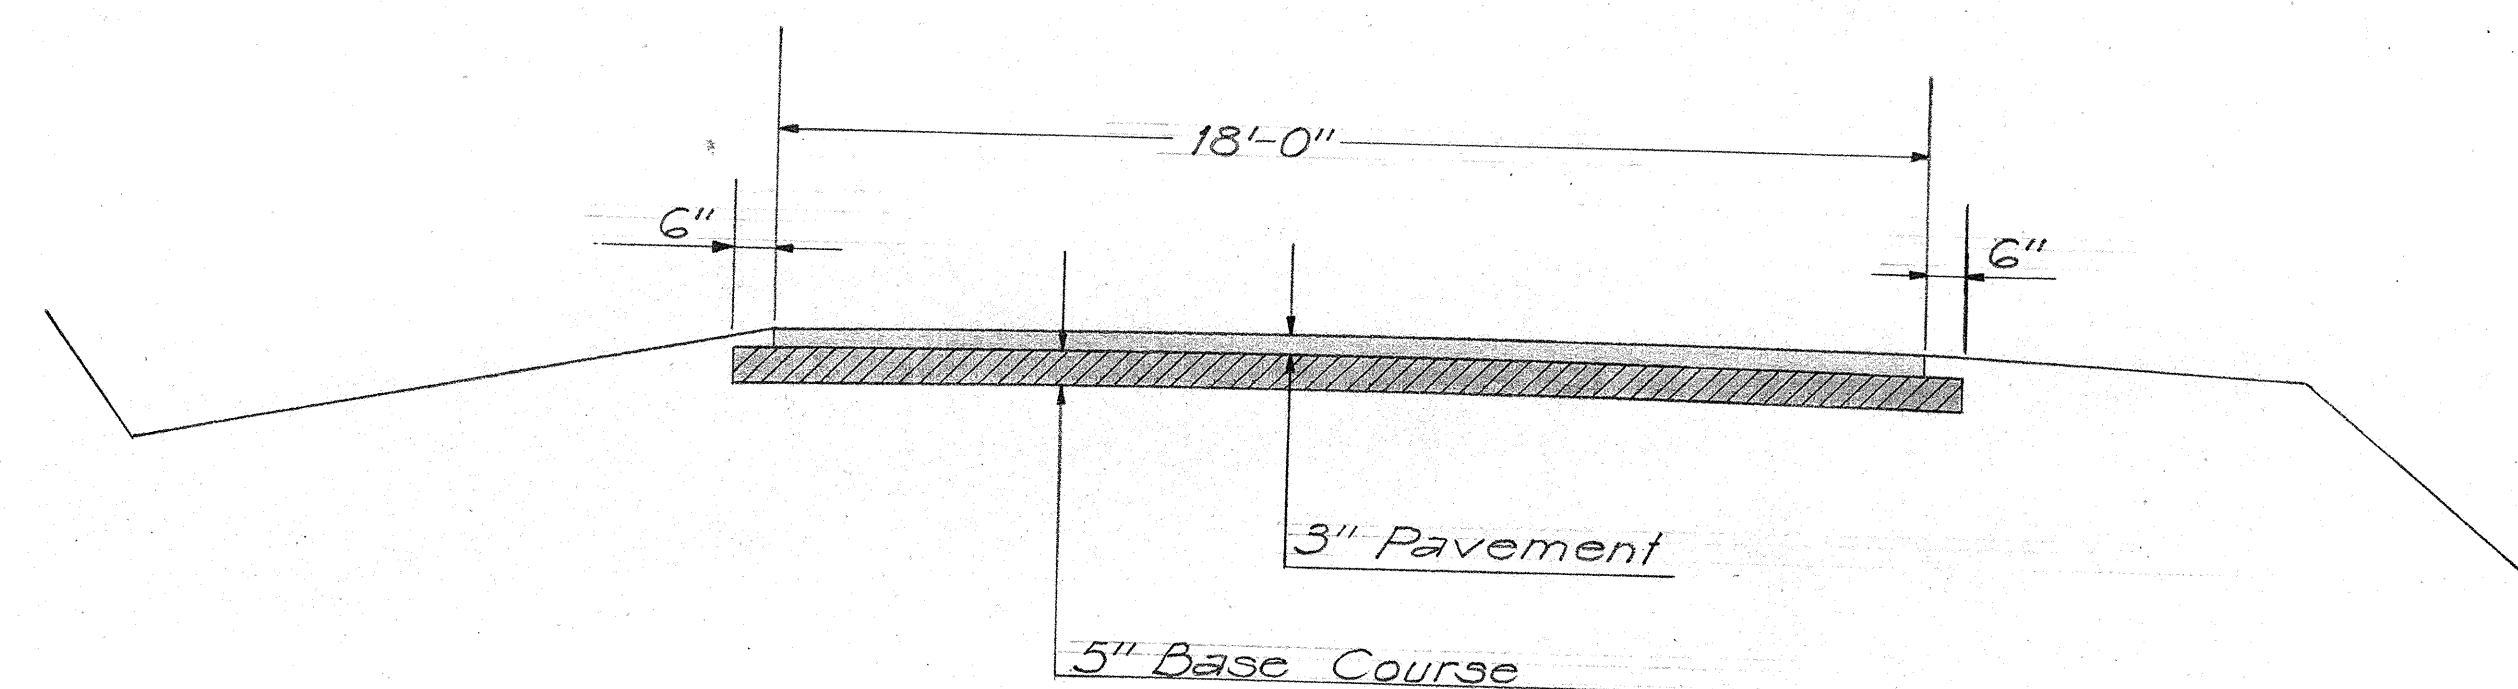

TYPICAL SECTION
AS ORIGINALLY CONSTRUCTED
F.A. PROJECT No. 12B
NOT TO SCALE

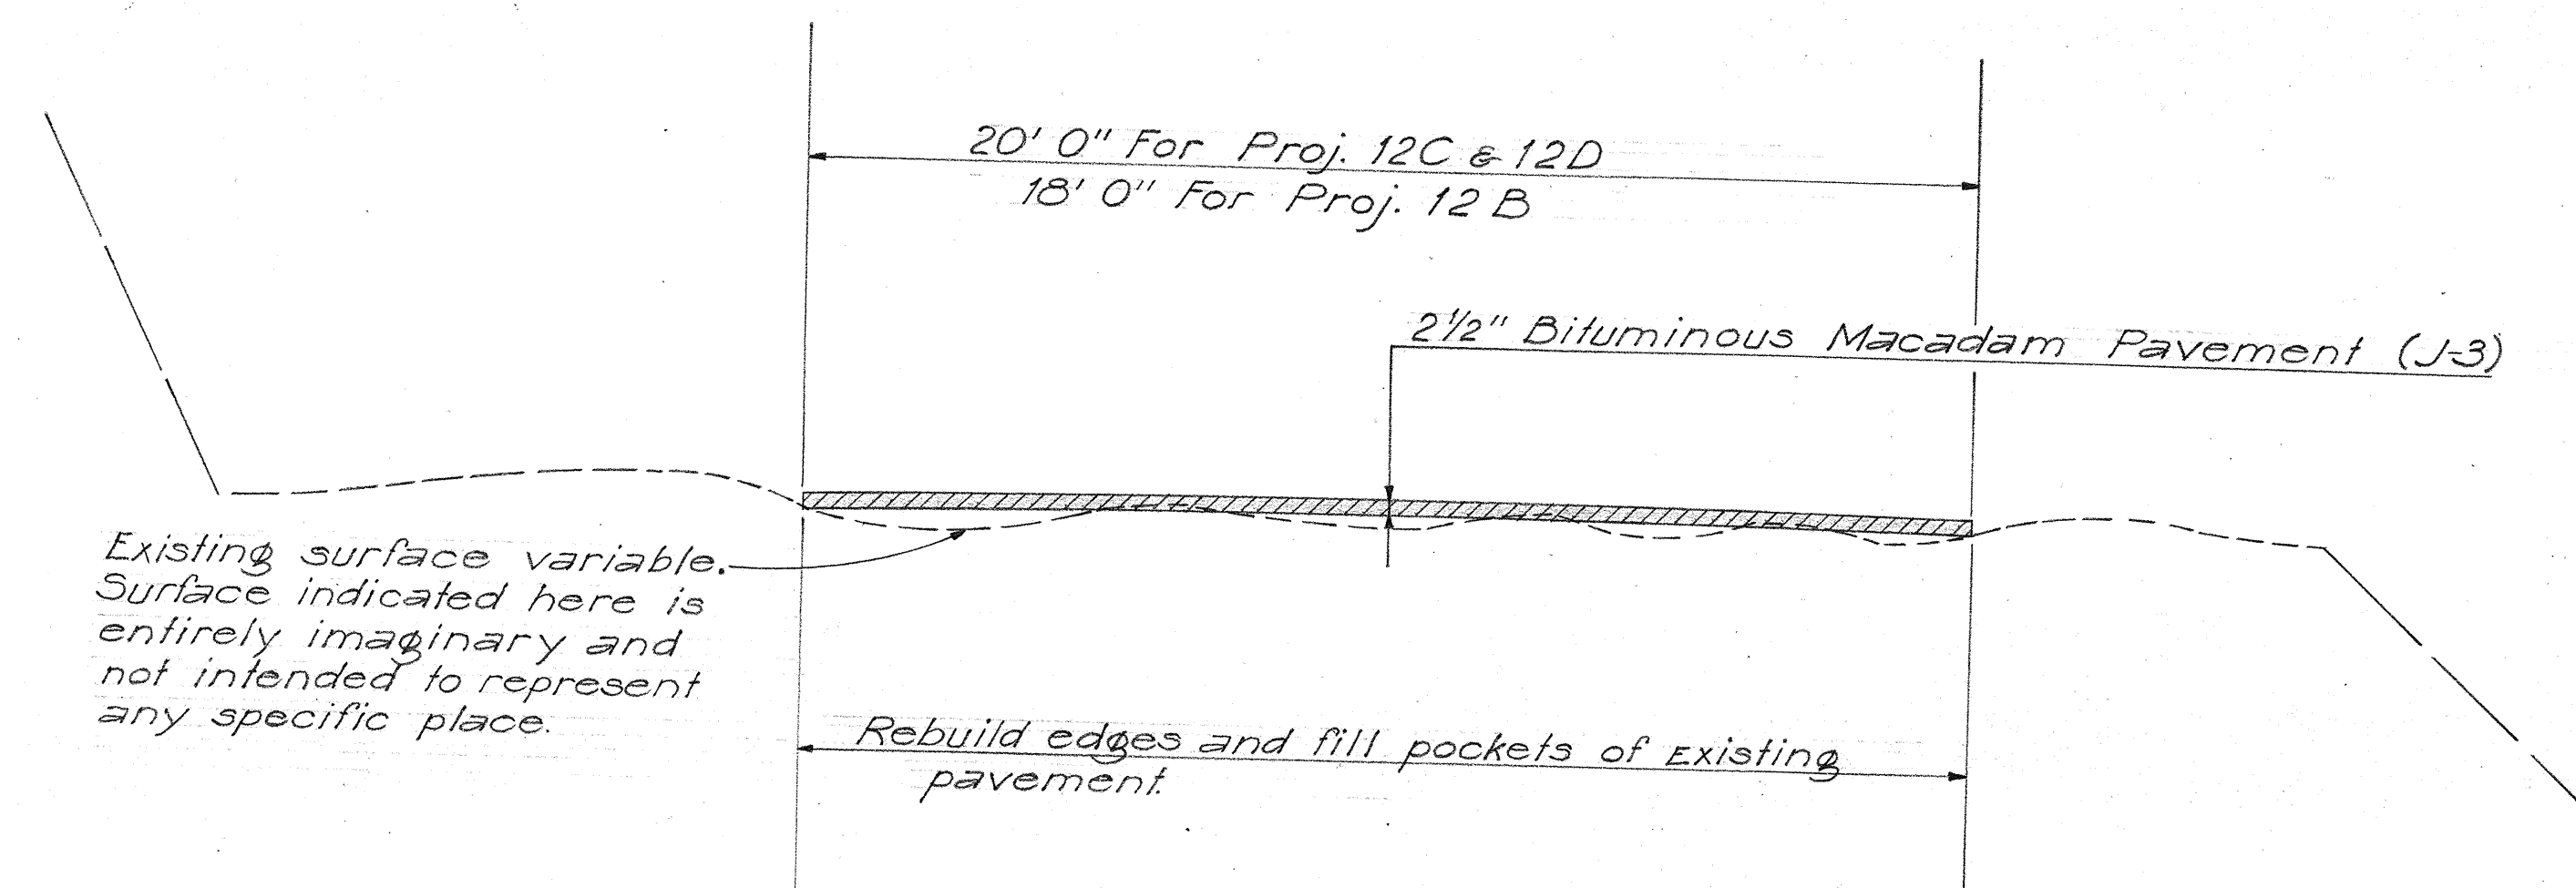

TYPICAL SECTION
OF WORK TO BE DONE
NOT TO SCALE

NOTE: No shoulder grading to be performed under this contract.

ORIGINAL PLAN	NOTE BOOK No.
SURVEY PLOTTED BY	DATE
DESIGNED BY	
TRACED BY	
QUANTITIES BY	
CHECKED BY	
CHECKED BY	

TERRITORIAL HIGHWAY DEPARTMENT
TERRITORY OF HAWAII
TYPICAL SECTIONS
PAVING OF PORTION OF
KAUAI BELT ROAD
SCALE: As Noted
F.A.P. F 12 (16) JAN. 16, 1948

SHEET No 2 OF 2 SHEETS

5297.2