


| FED. ROAD DIST. NO. | STATE | FED. AID PROJ. NO. | FISCAL YEAR | SHEET NO. | TOTAL SHEETS |
|---------------------|-------|--------------------|-------------|-----------|--------------|
| HAWAII              | HAW.  | F 12(17)           | 1950        | 19        | 20           |

22

| FINAL SURVEY | DATE | BY |
|--------------|------|----|
| SURVEYED     |      |    |
| PLOTTED      |      |    |
| NOTED        |      |    |
| CHECKED      |      |    |
| NO.          |      |    |

| ORIGINAL SURVEY | DATE | BY |
|-----------------|------|----|
| SURVEYED        |      |    |
| PLOTTED         |      |    |
| NOTED           |      |    |
| CHECKED         |      |    |
| NO.             |      |    |

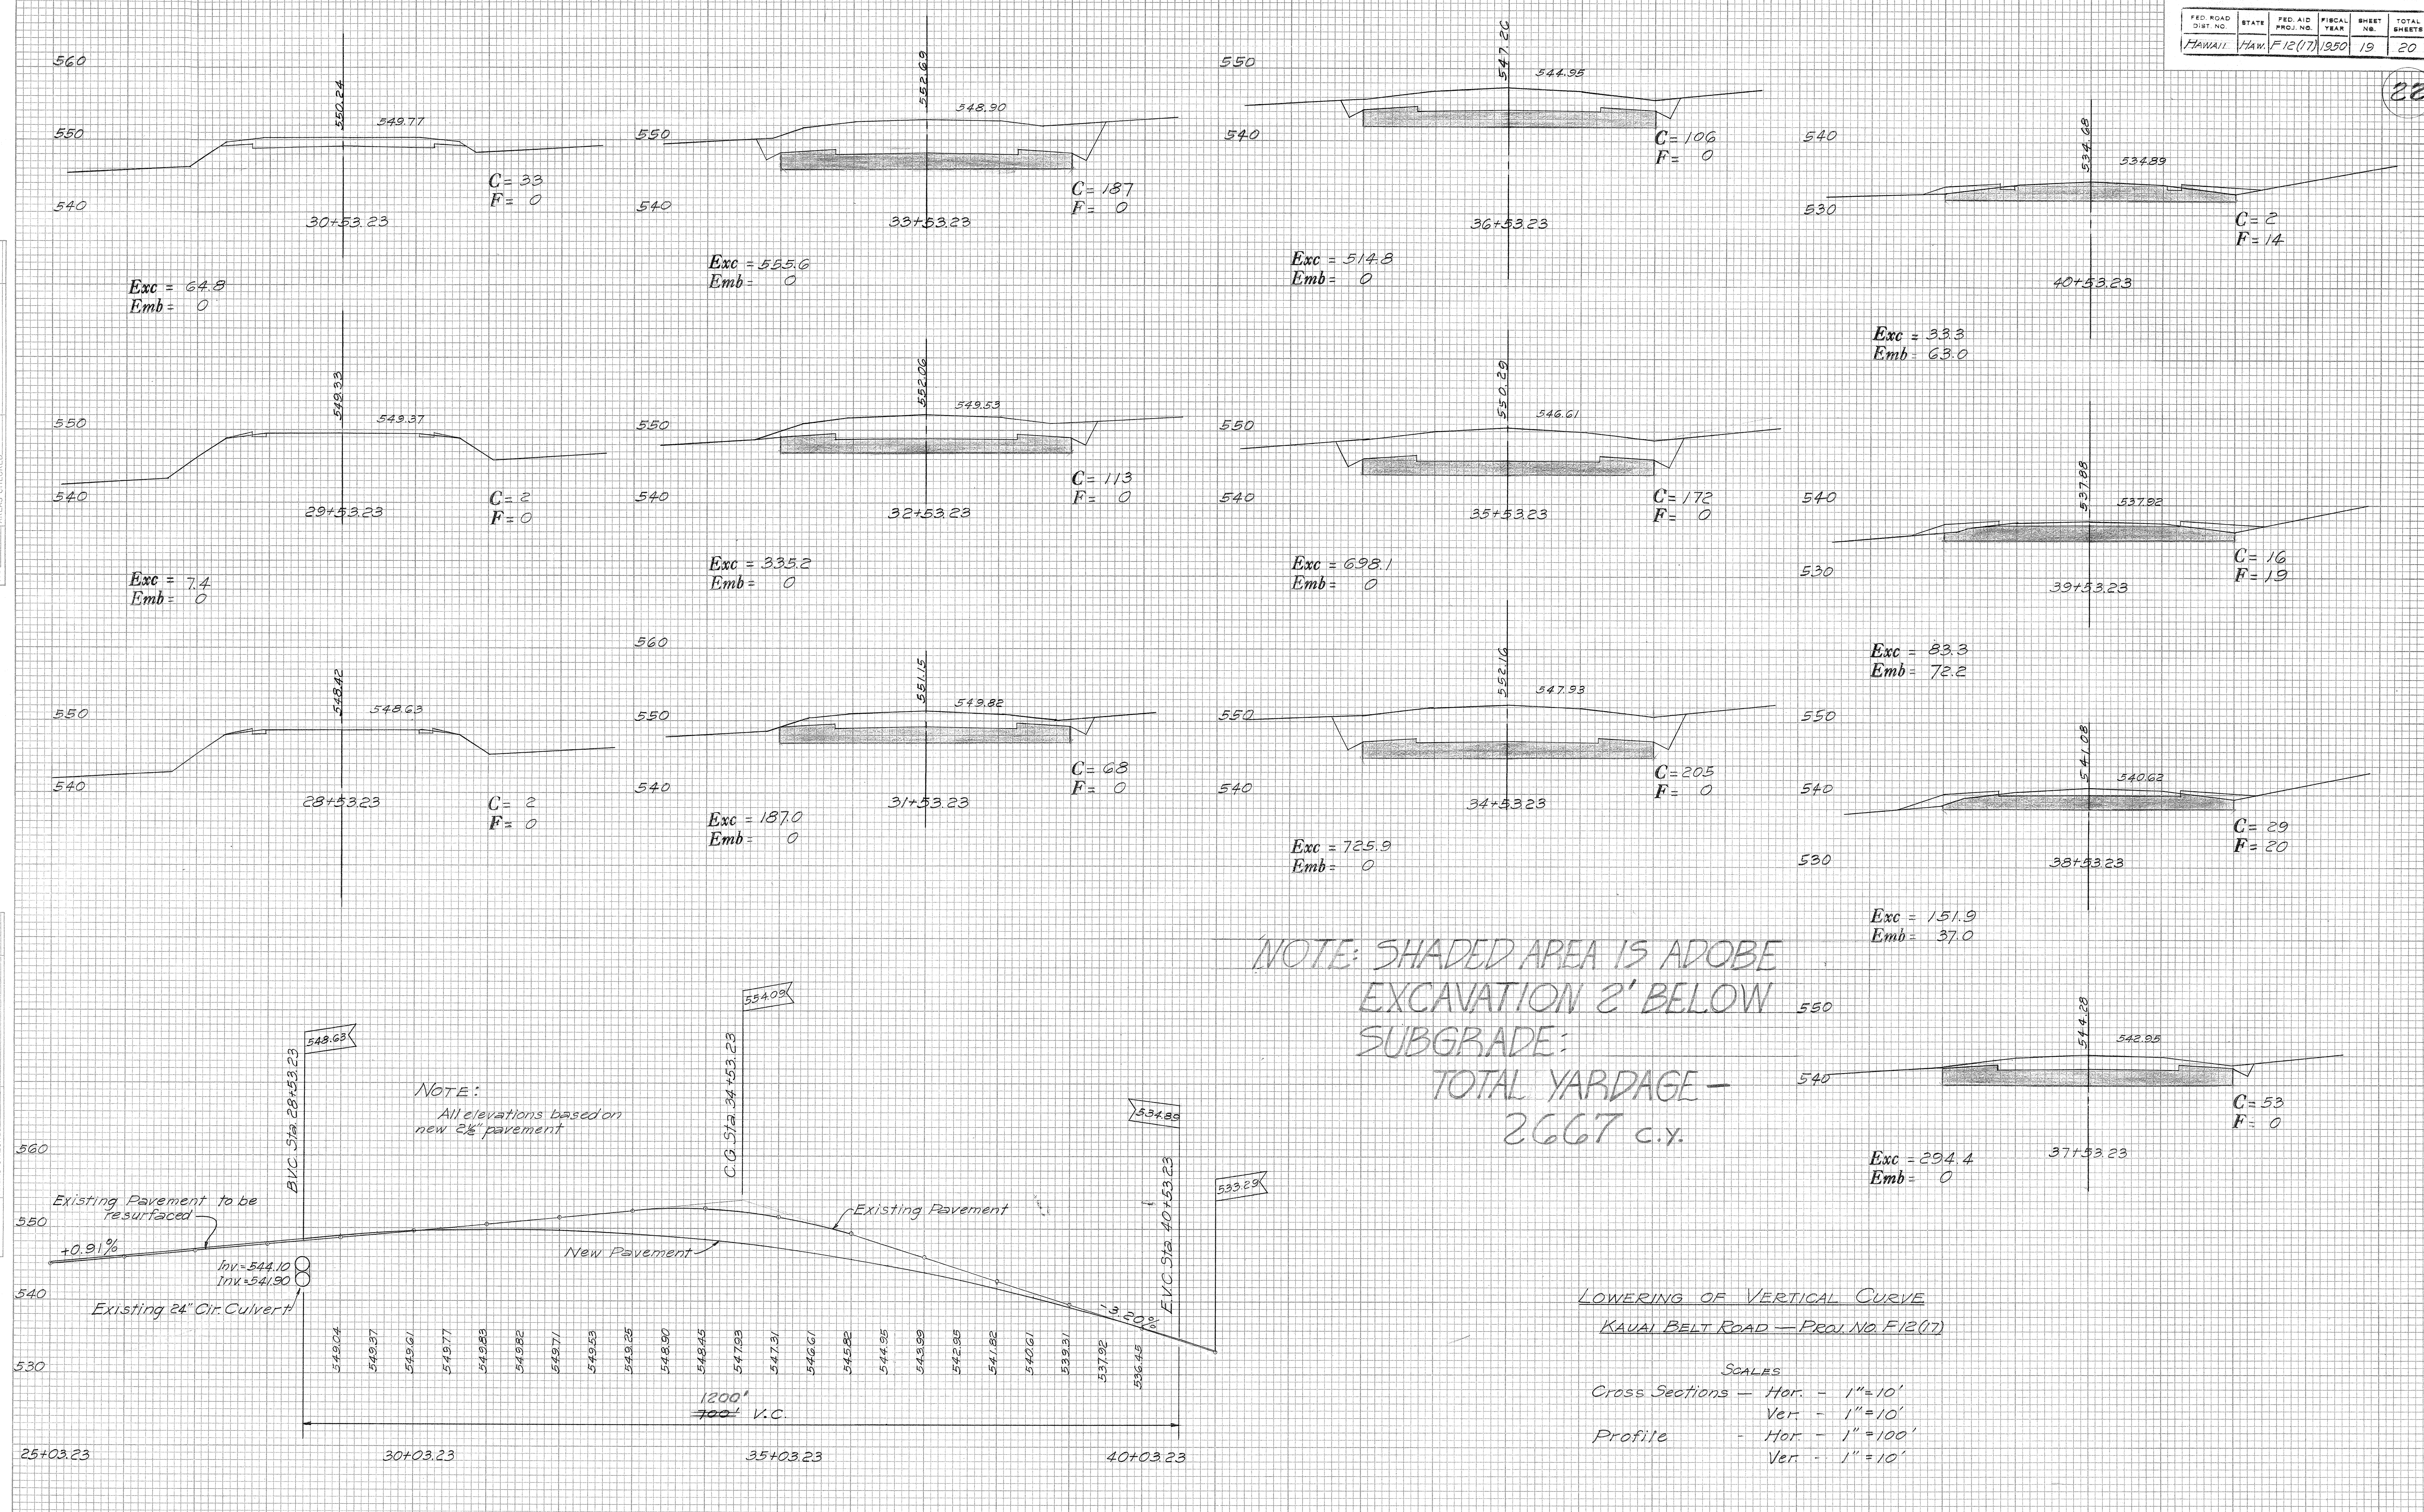




| FED. ROAD DIST. NO. | STATE | FED. AID PROJ. NO. | FISCAL YEAR | SHEET NO. | TOTAL SHEETS |
|---------------------|-------|--------------------|-------------|-----------|--------------|
| HAWAII              | HAW   | F12(17)            | 1950        | 19        | 20           |

| FINAL SURVEY NO. | SURVEYED BY | DATE |
|------------------|-------------|------|
| NO.              |             |      |

| ORIGINAL SURVEY NO. | SURVEYED BY | DATE |
|---------------------|-------------|------|
| NO.                 |             |      |

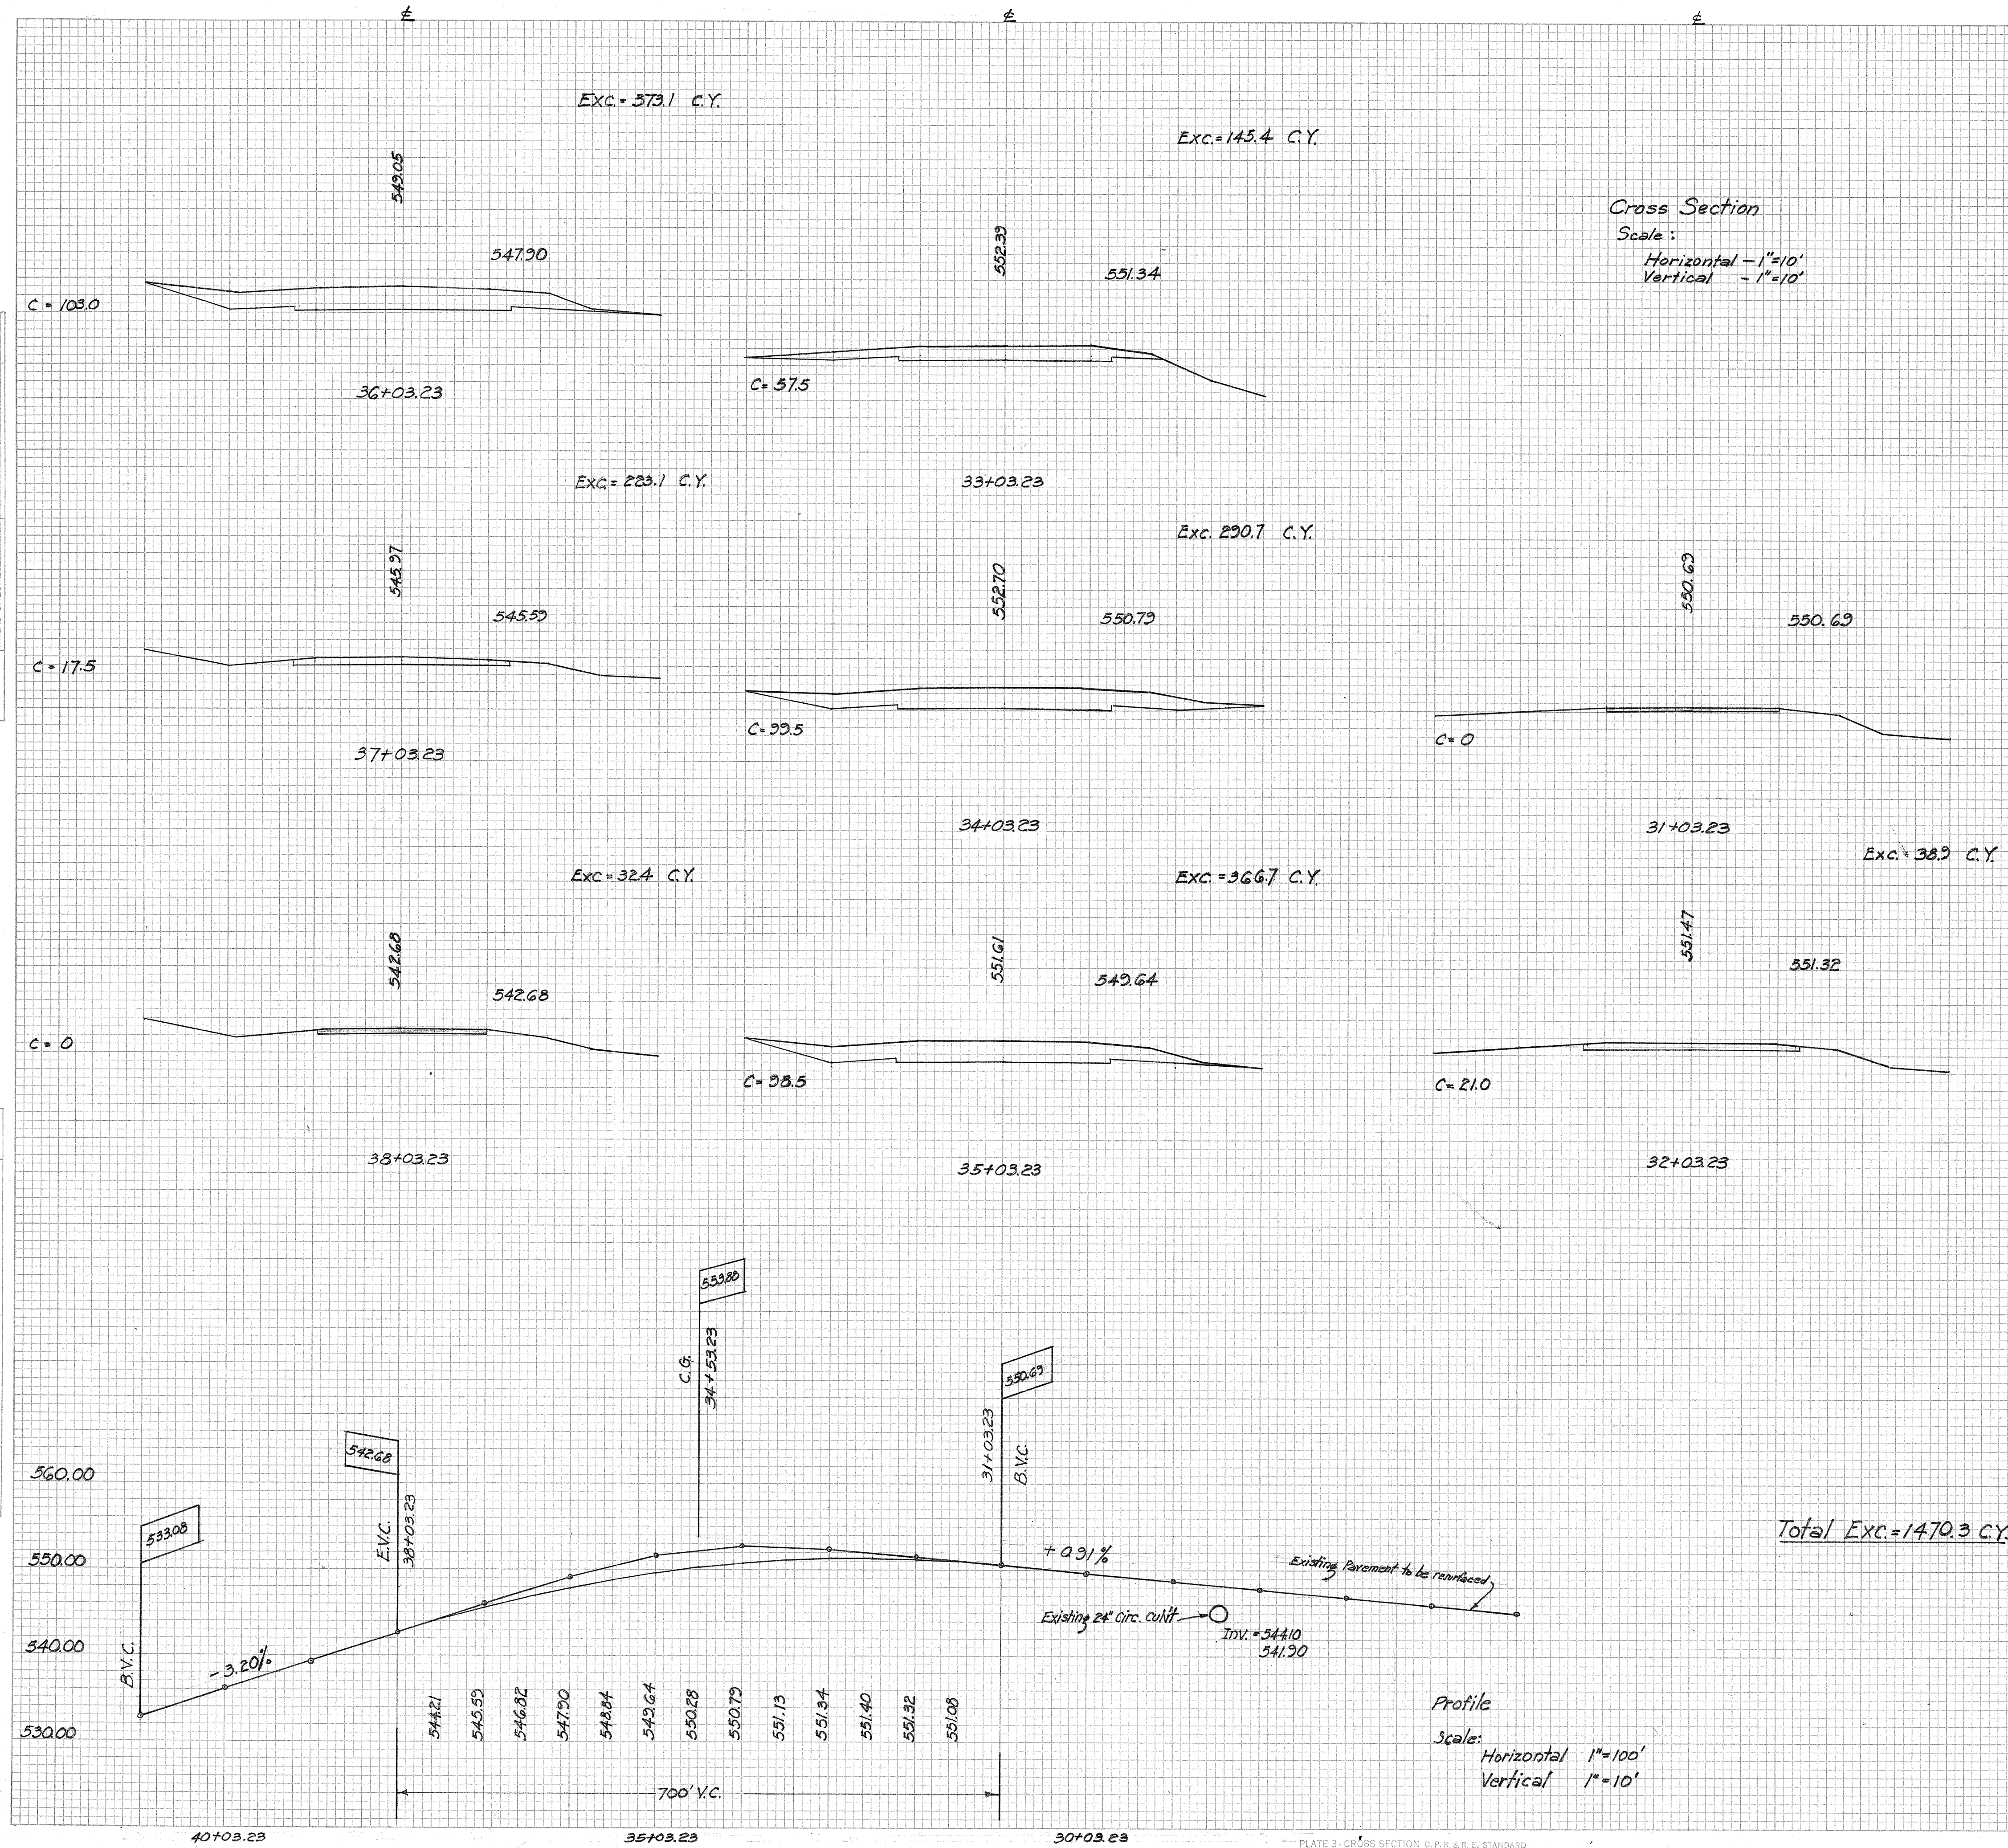

KAUAI BELT ROAD  
F12(17)











| FED. ROAD DIST. NO. | STATE | FED. AID PROJ. NO. | FISCAL YEAR | SHEET NO. | TOTAL SHEETS |
|---------------------|-------|--------------------|-------------|-----------|--------------|
| HAWAII              | HAW   | F12(17)            | 1950        | 20        | 20           |

23

|      |    |              |          |         |          |     |
|------|----|--------------|----------|---------|----------|-----|
| DATE | BY | FINAL SURVEY | SURVEYED | PLOTTED | TEMPLATE | NO. |
|      |    |              |          |         |          |     |
|      |    |              |          |         |          |     |

|      |    |                 |          |         |          |     |
|------|----|-----------------|----------|---------|----------|-----|
| DATE | BY | ORIGINAL SURVEY | SURVEYED | PLOTTED | TEMPLATE | NO. |
|      |    |                 |          |         |          |     |
|      |    |                 |          |         |          |     |

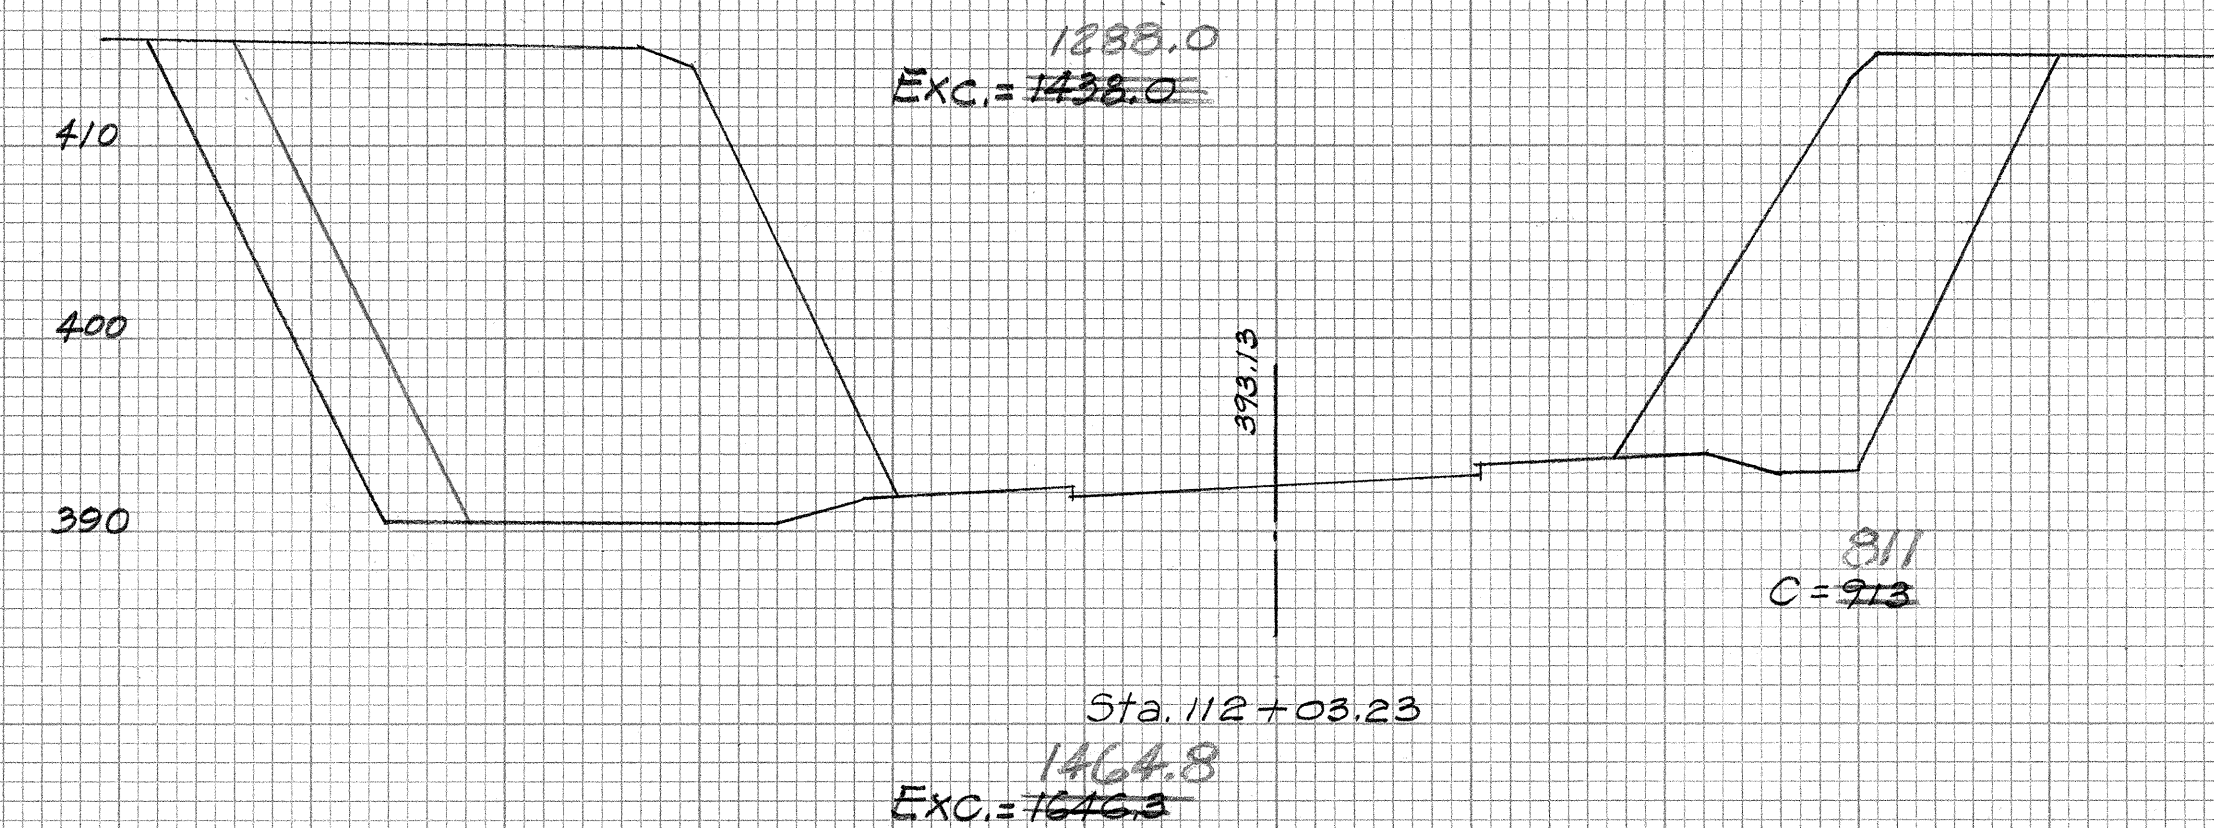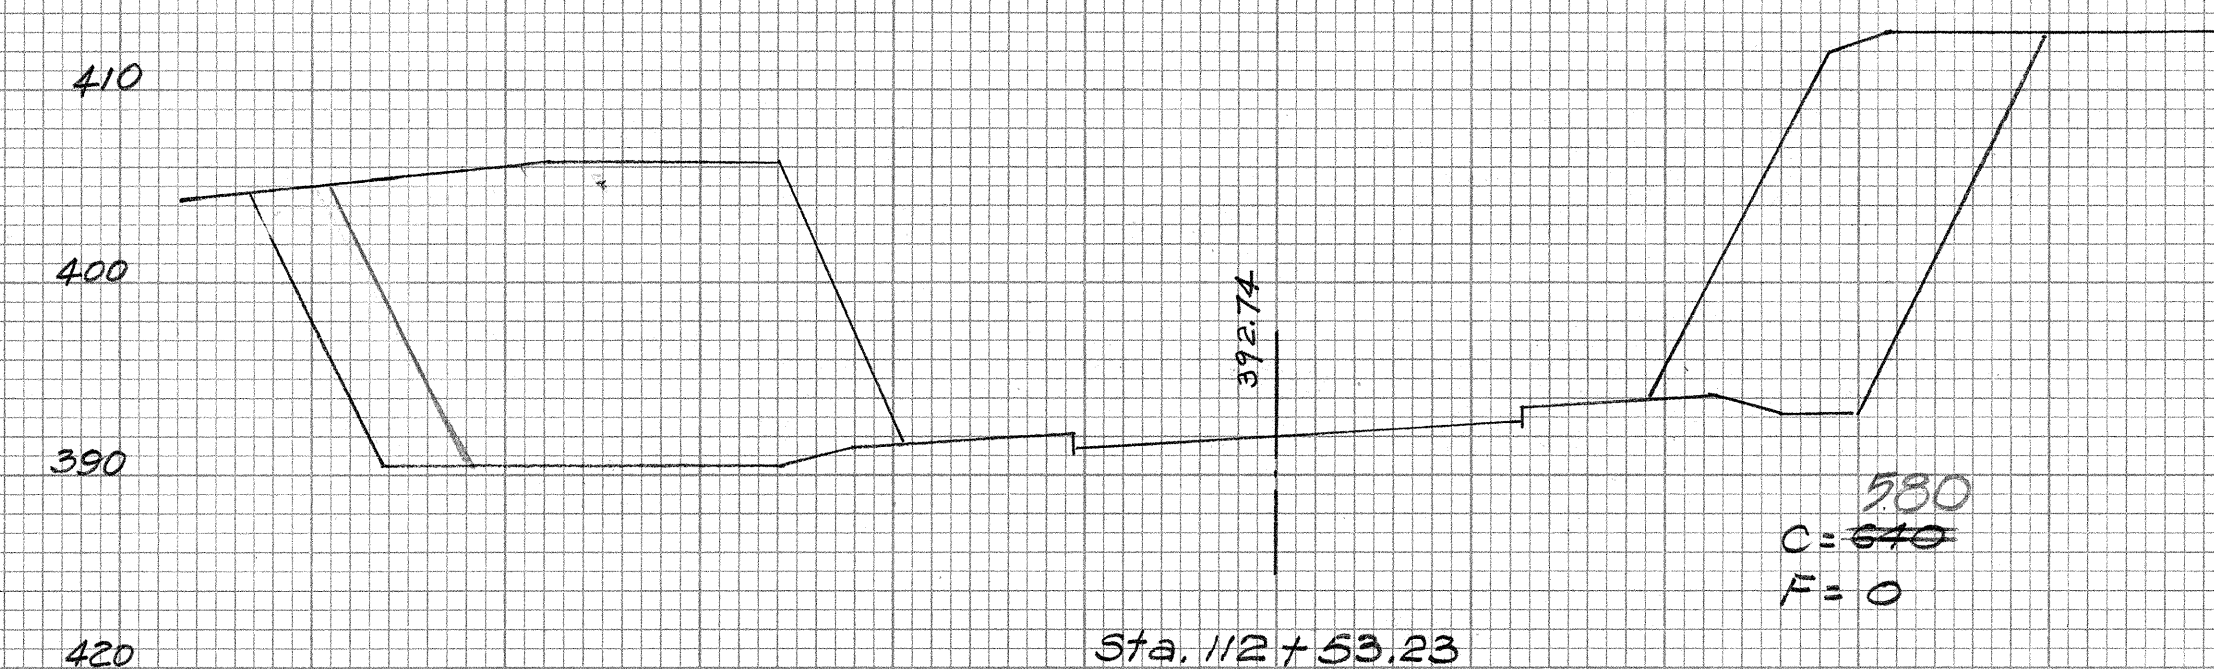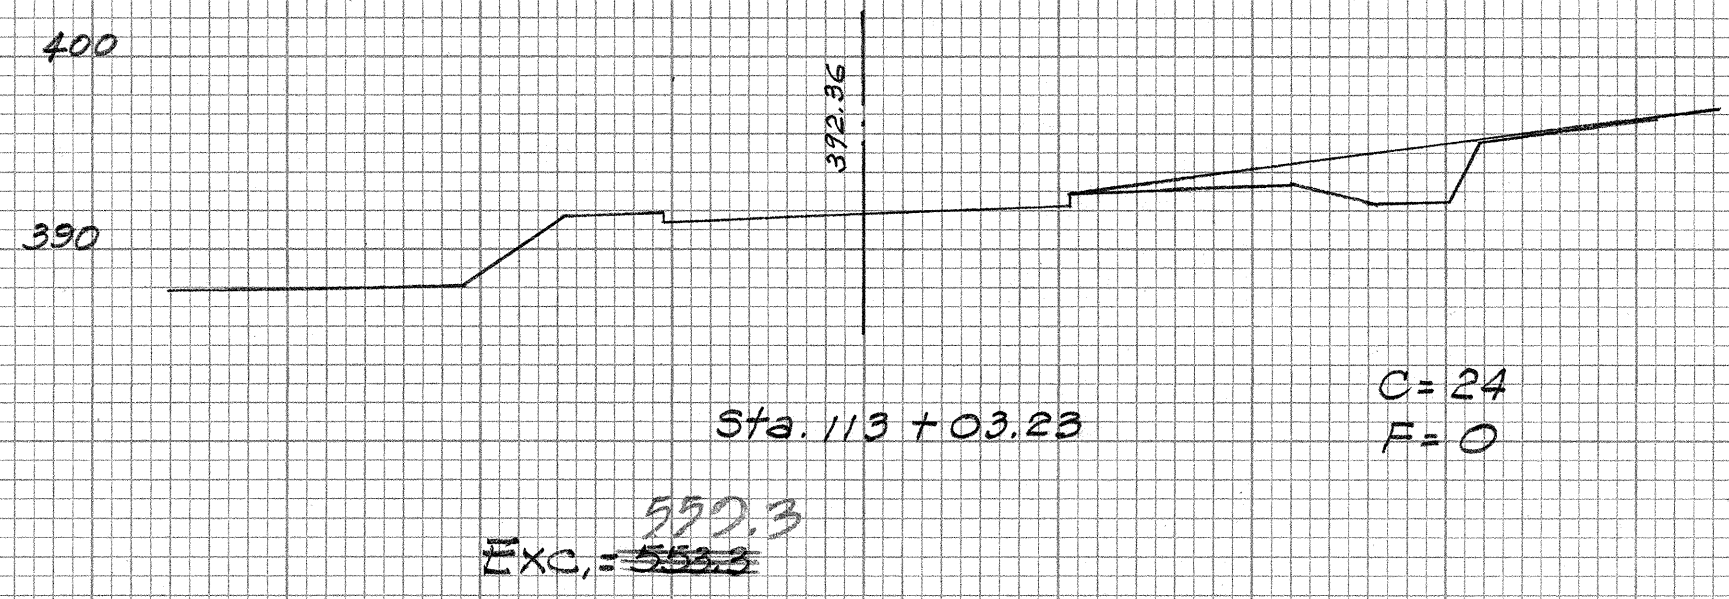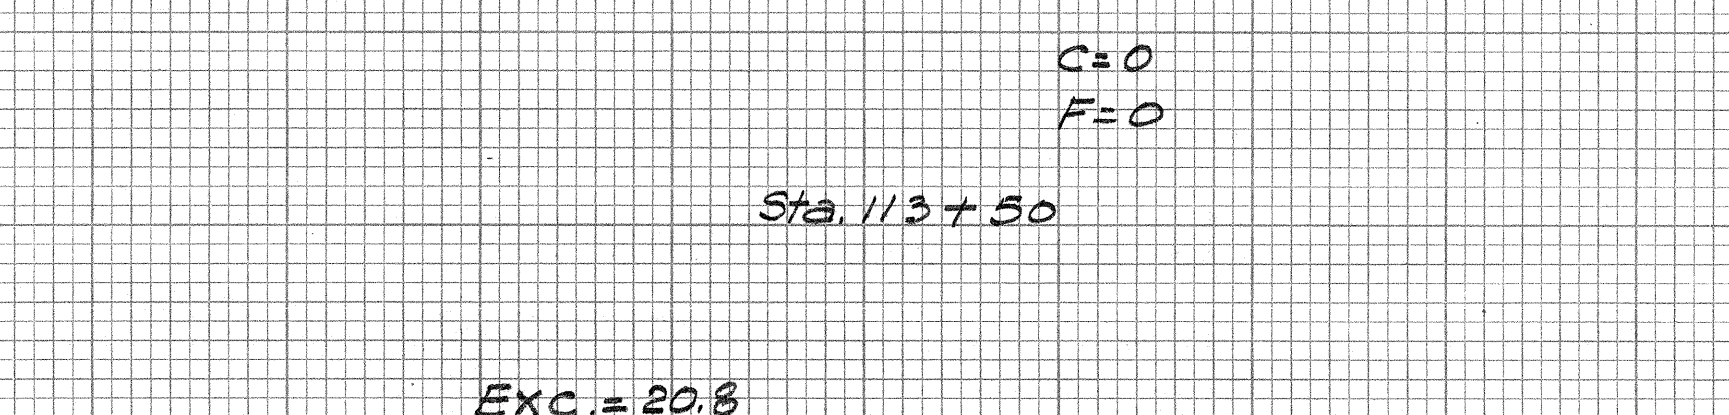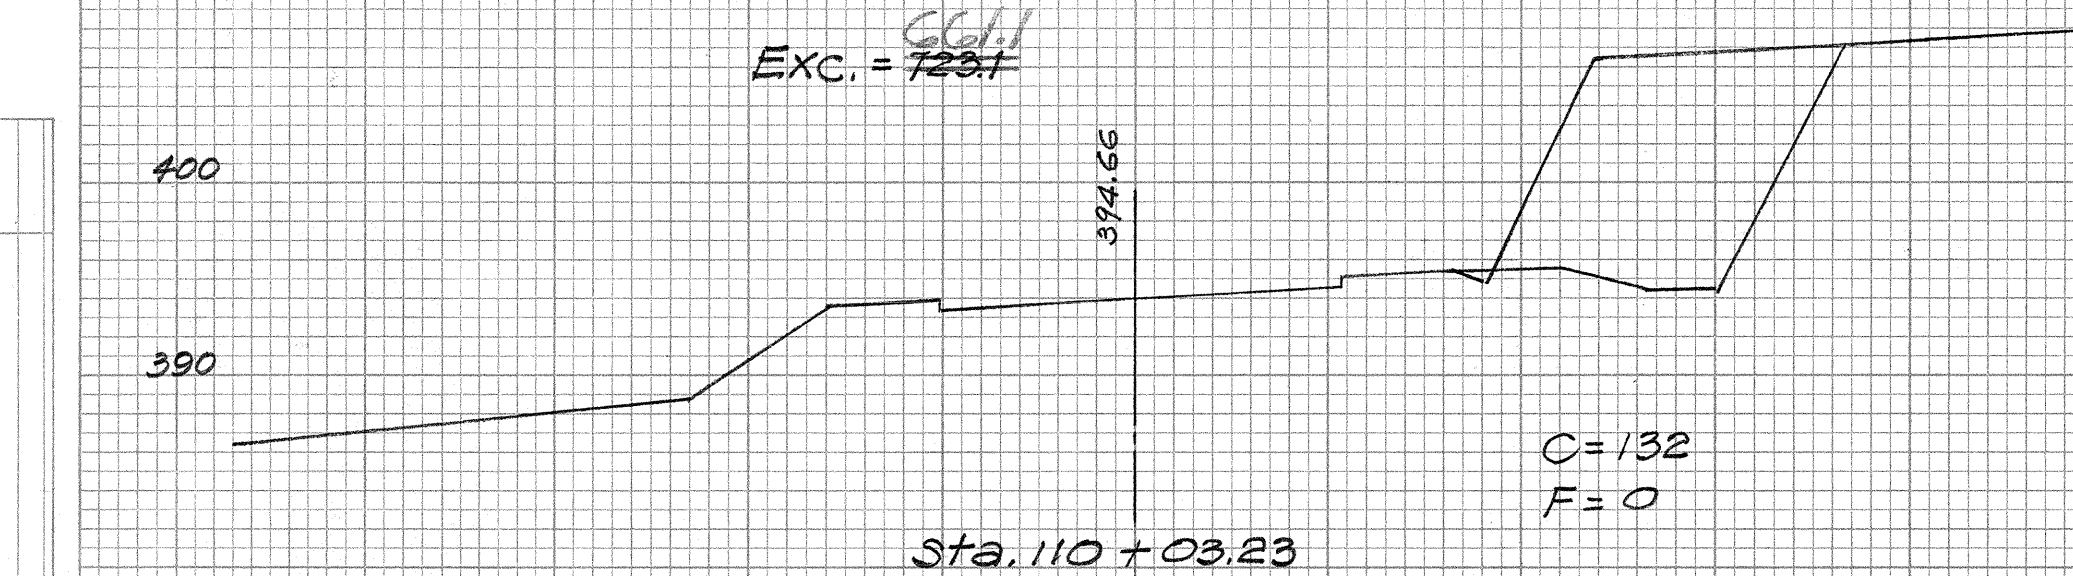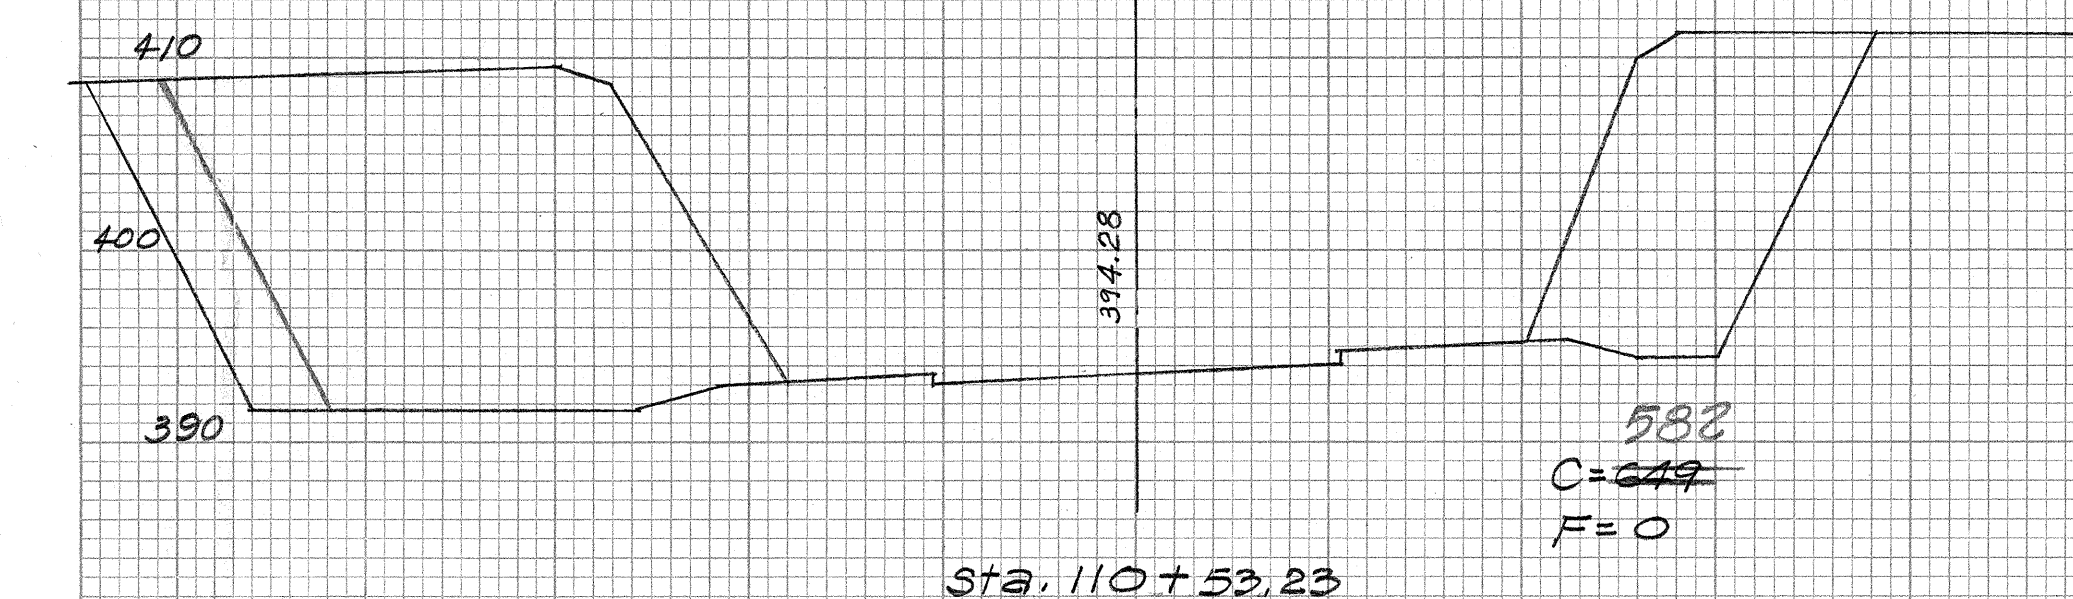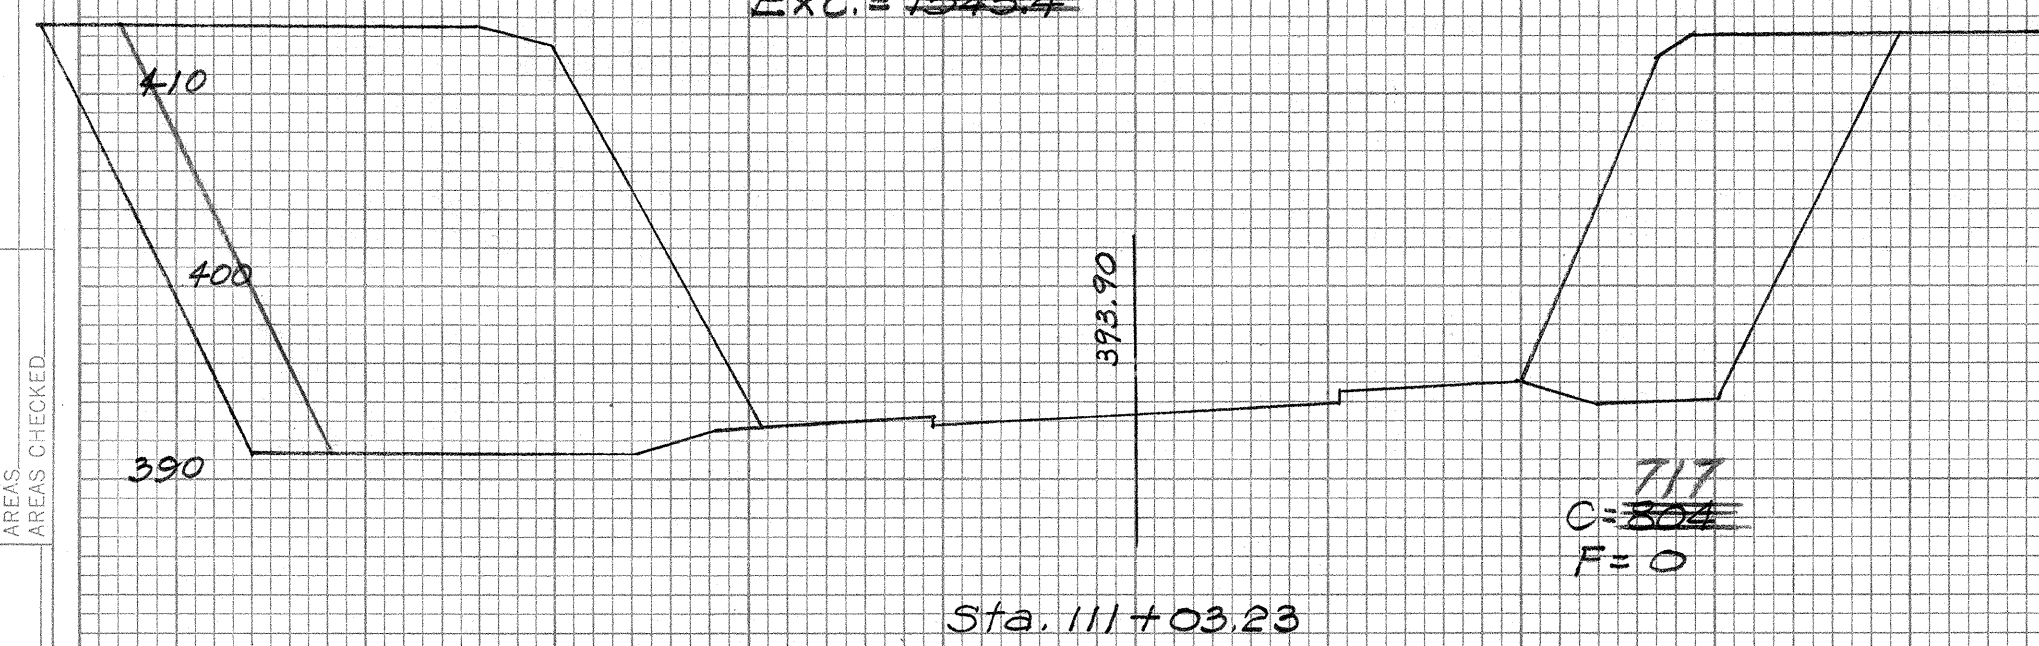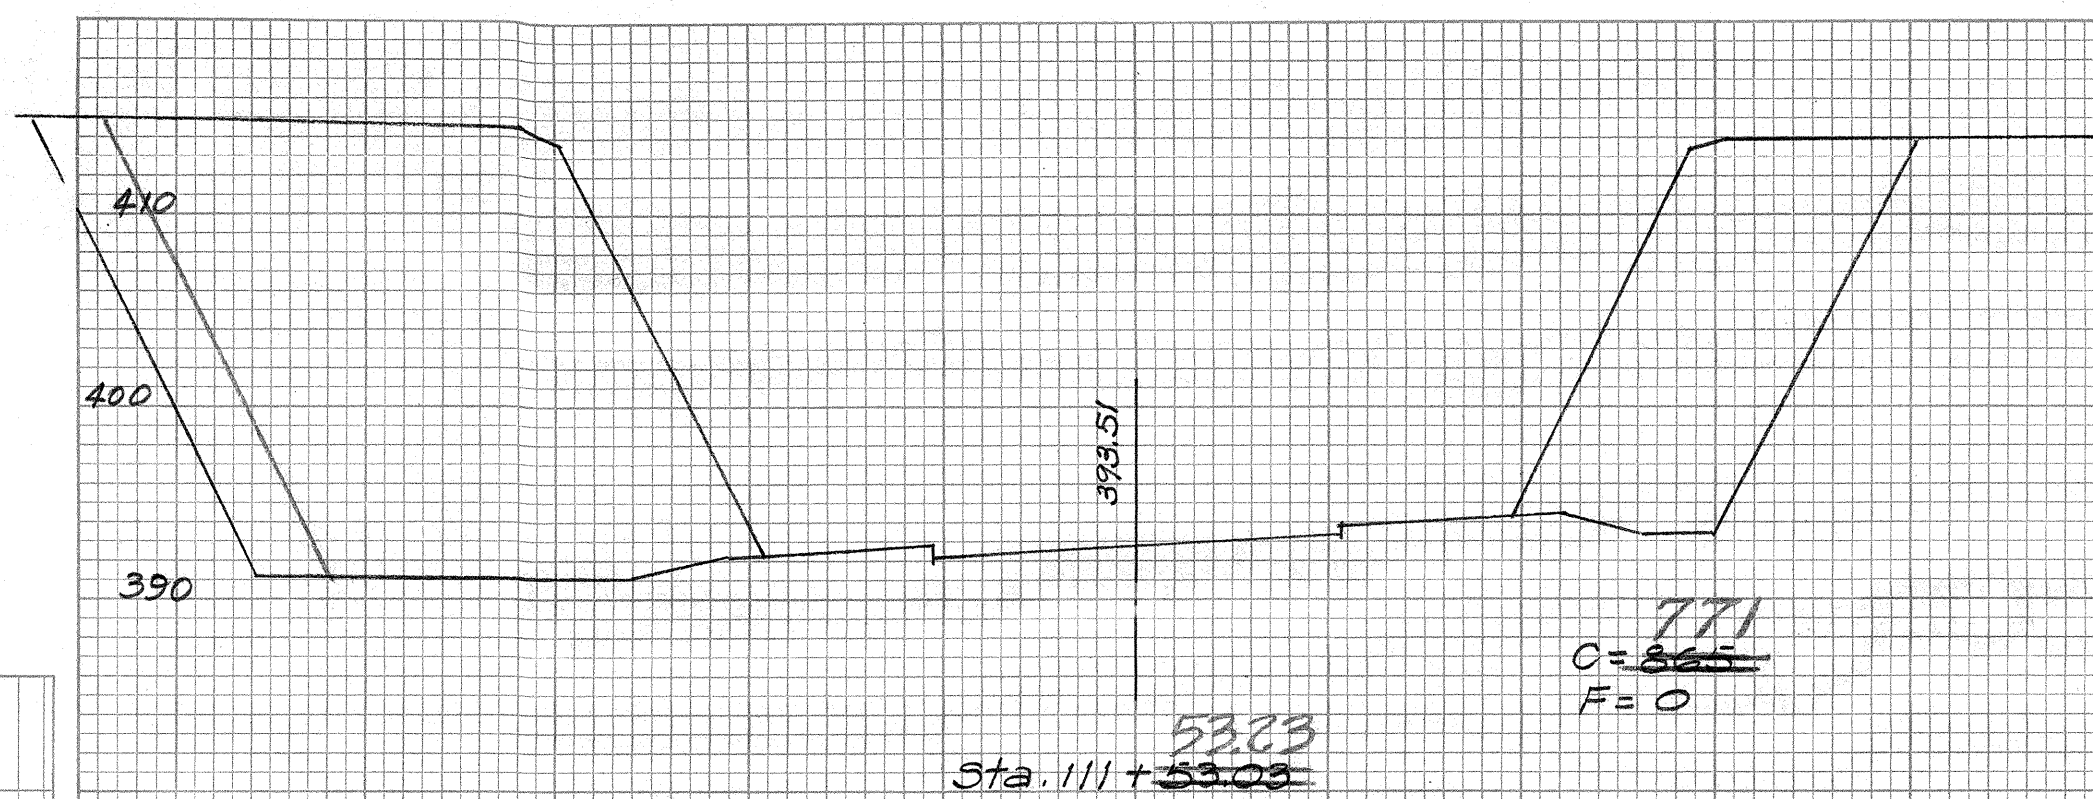

PROPOSED LOCATION OF BORROW PIT  
PROJECT F12(17)  
KAUAI BELT ROAD

5455.20