

INDEX TO DRAWINGS	
SHEET NO.	DESCRIPTIONS
1	Title Sheet
2	Typical Sections
3-13	Plan and Profile
14-18	Standard Details
19-20	Cross Sections



TERRITORY OF HAWAII
TERRITORIAL HIGHWAY DEPARTMENT
HONOLULU T. H.

PLANS OF

KAUAI BELT ROAD
(WIDENING AND RESURFACING)
FEDERAL AID PROJECT NO. F 12 (17)
DISTRICTS OF KOLOA AND LIHUE
ISLAND OF KAUAI

SCALES

PLAN: 1 INCH = 100 FT.
 PROFILE: VERT. 1 INCH = 20 FT.
 HOR. 1 INCH = 100 FT.
 CROSS-SECTION: VERT. 1 INCH = 10 FT.
 HOR. 1 INCH = 10 FT.

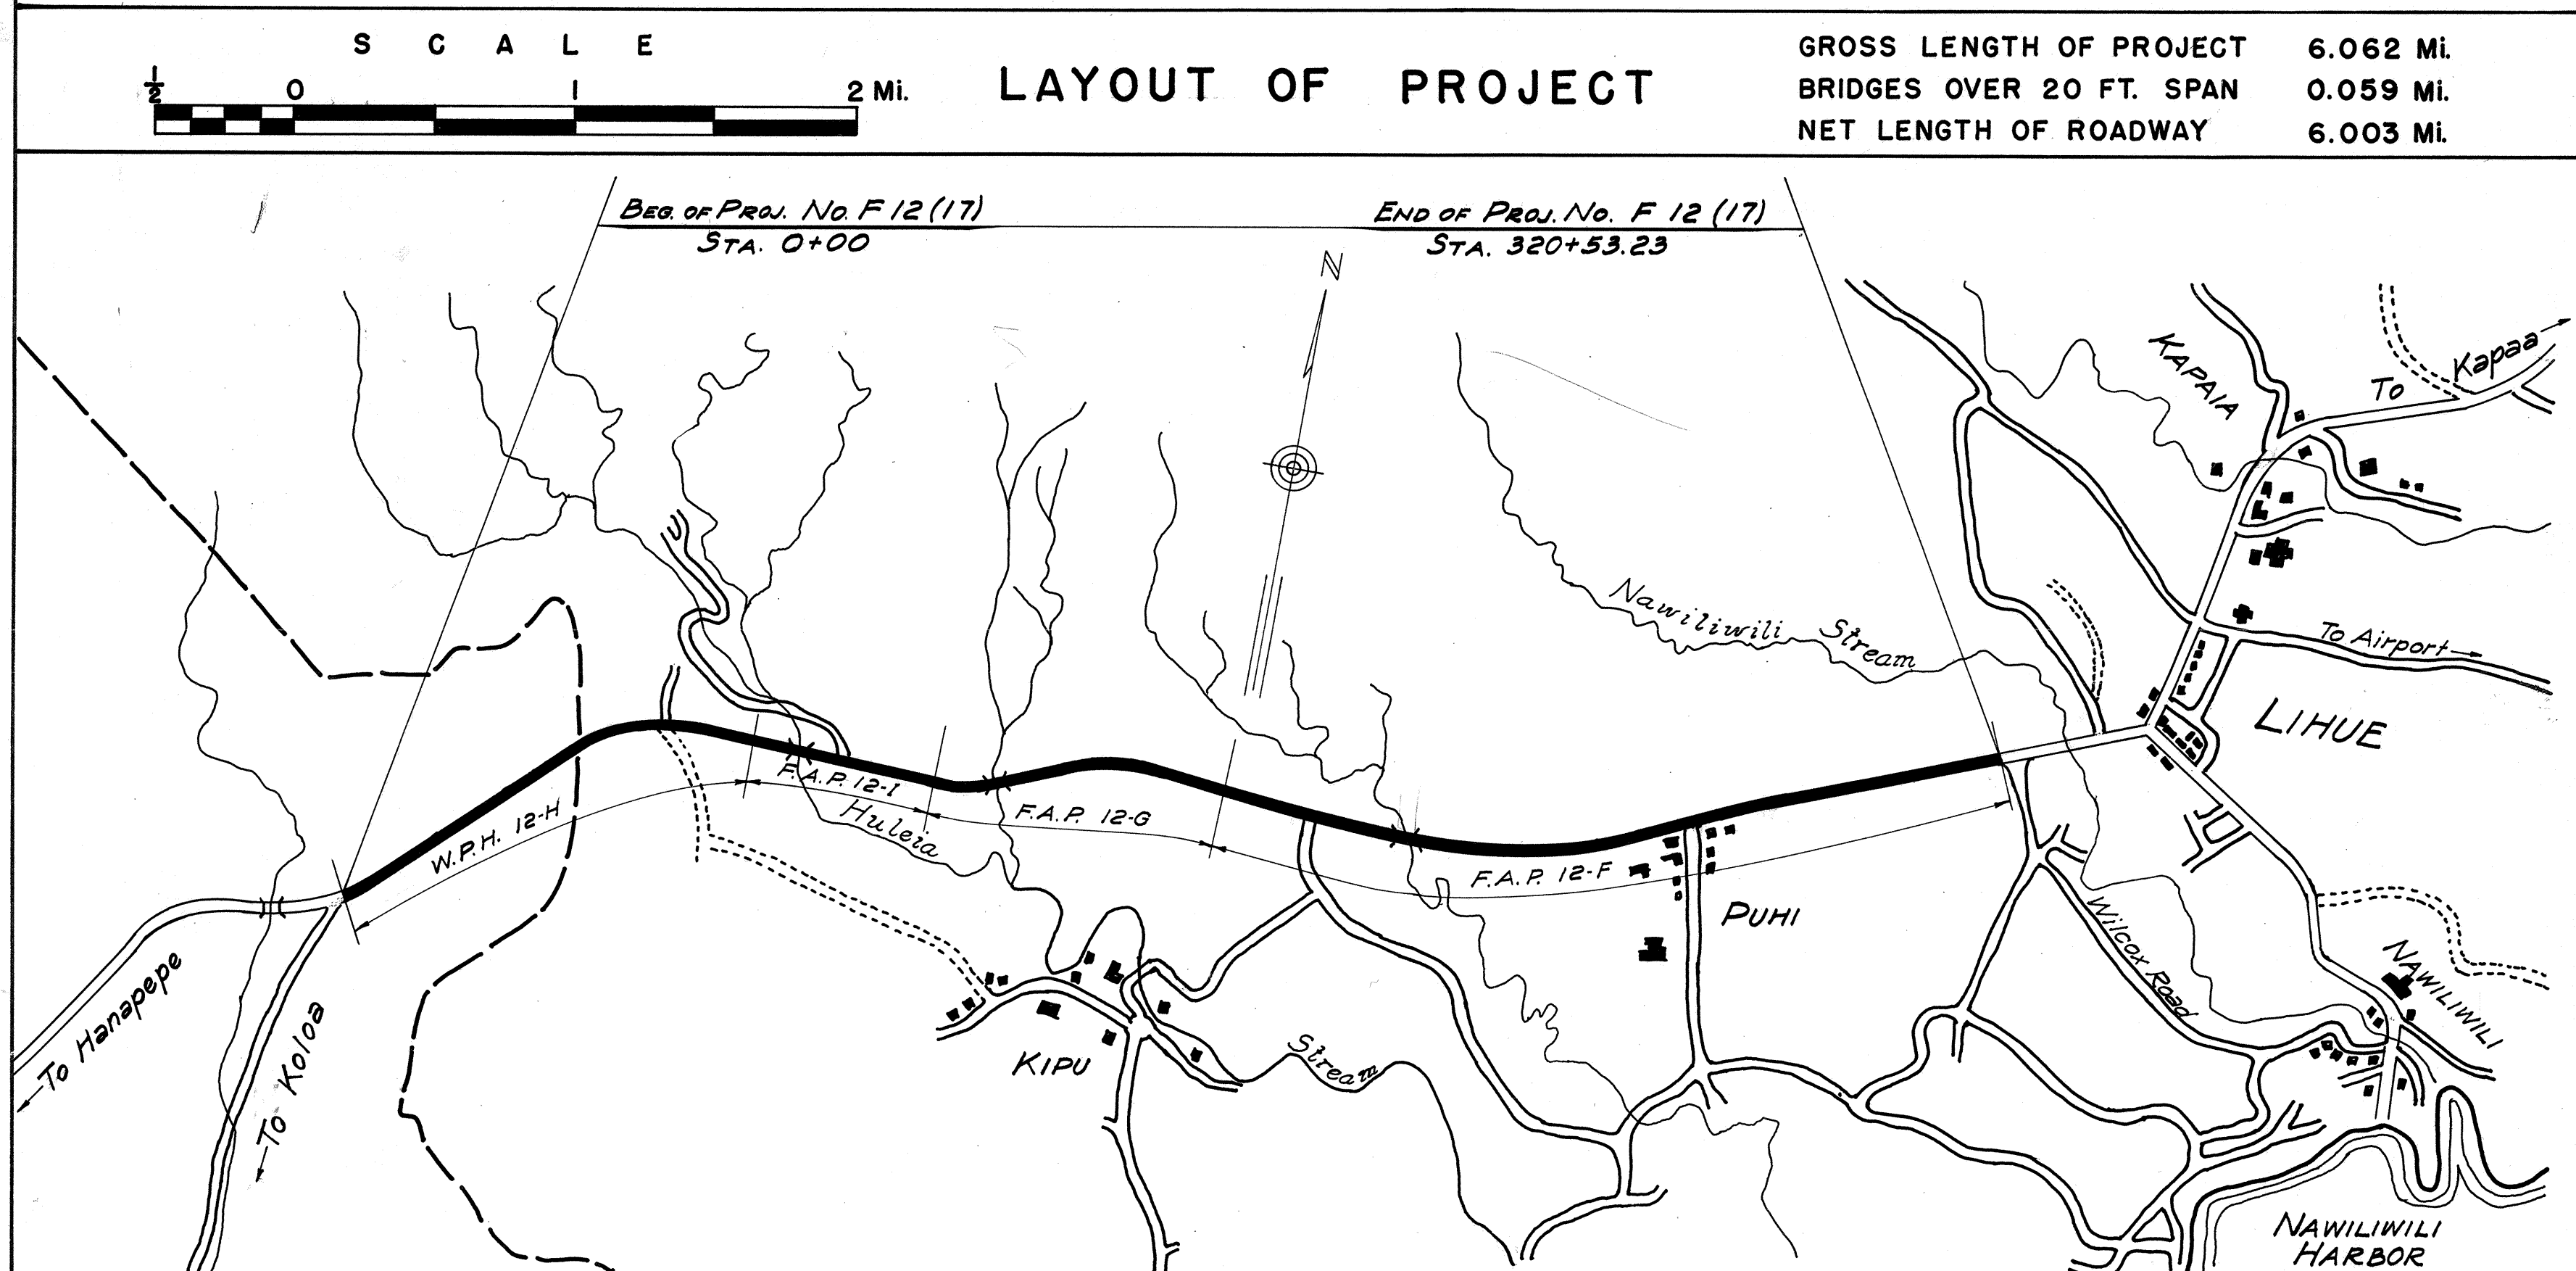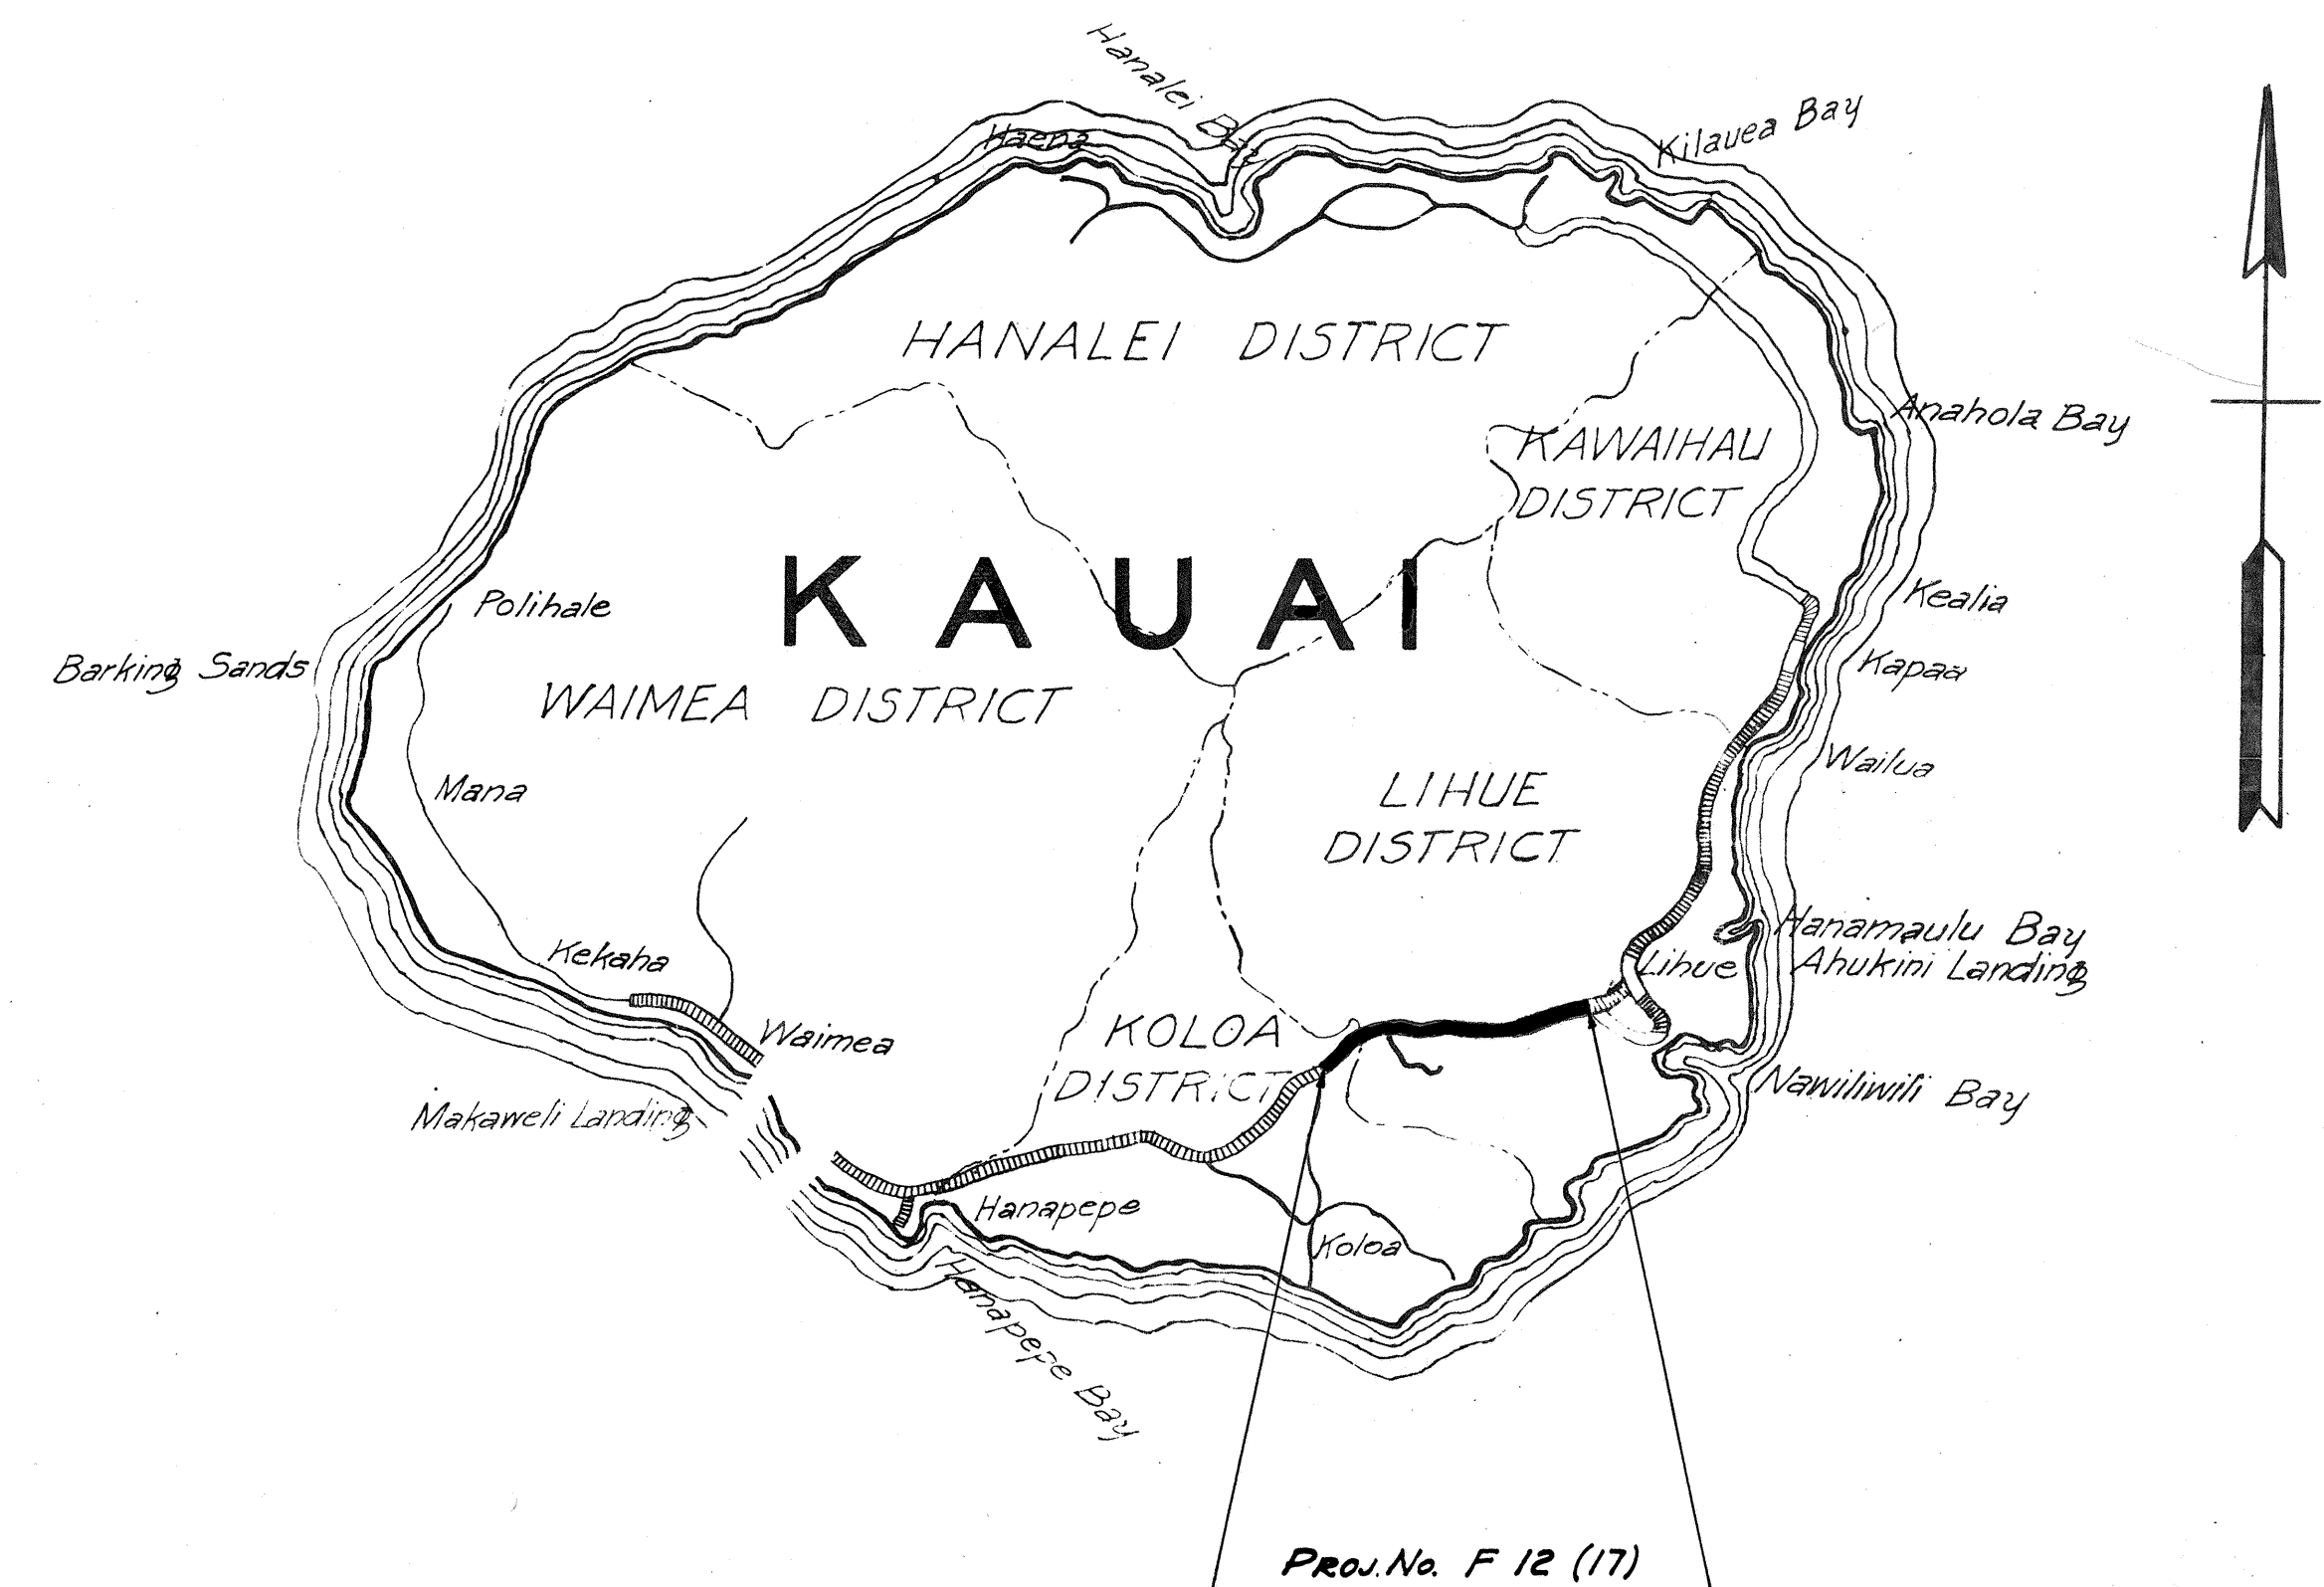

NOTE:
ALL CHANGES MADE DURING CONSTRUCTION
HAVE BEEN NOTED IN RED ON THESE
TRACINGS AND CHECKED BY:

[Signature]
DISTRICT ENGINEER
March 27, 1951
DATE

APPROVED: *[Signature]*
TERRITORIAL HIGHWAY ENGINEER

RECOMMENDED FOR APPROVAL:	DATE.....
DISTRICT ENGINEER PUBLIC ROADS ADMINISTRATION FEDERAL WORKS AGENCY	
APPROVED:	DATE.....
DIVISION ENGINEER PUBLIC ROADS ADMINISTRATION FEDERAL WORKS AGENCY	