
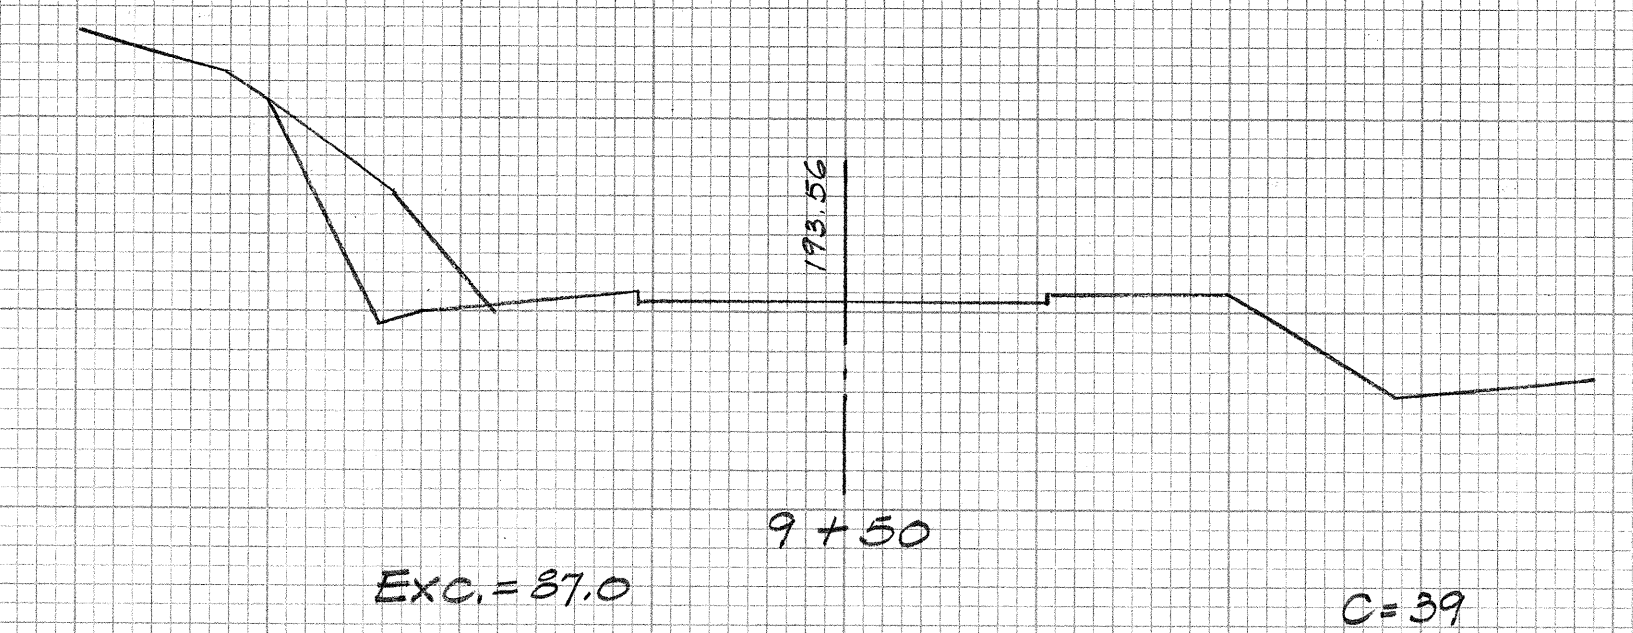
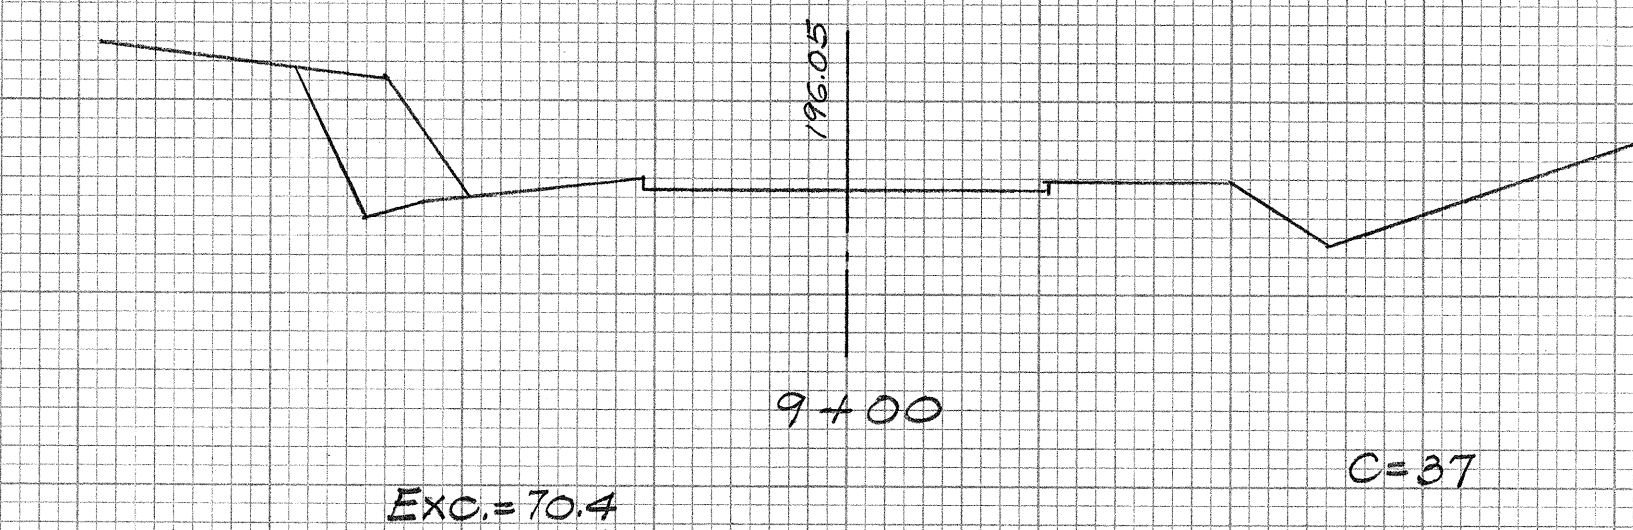
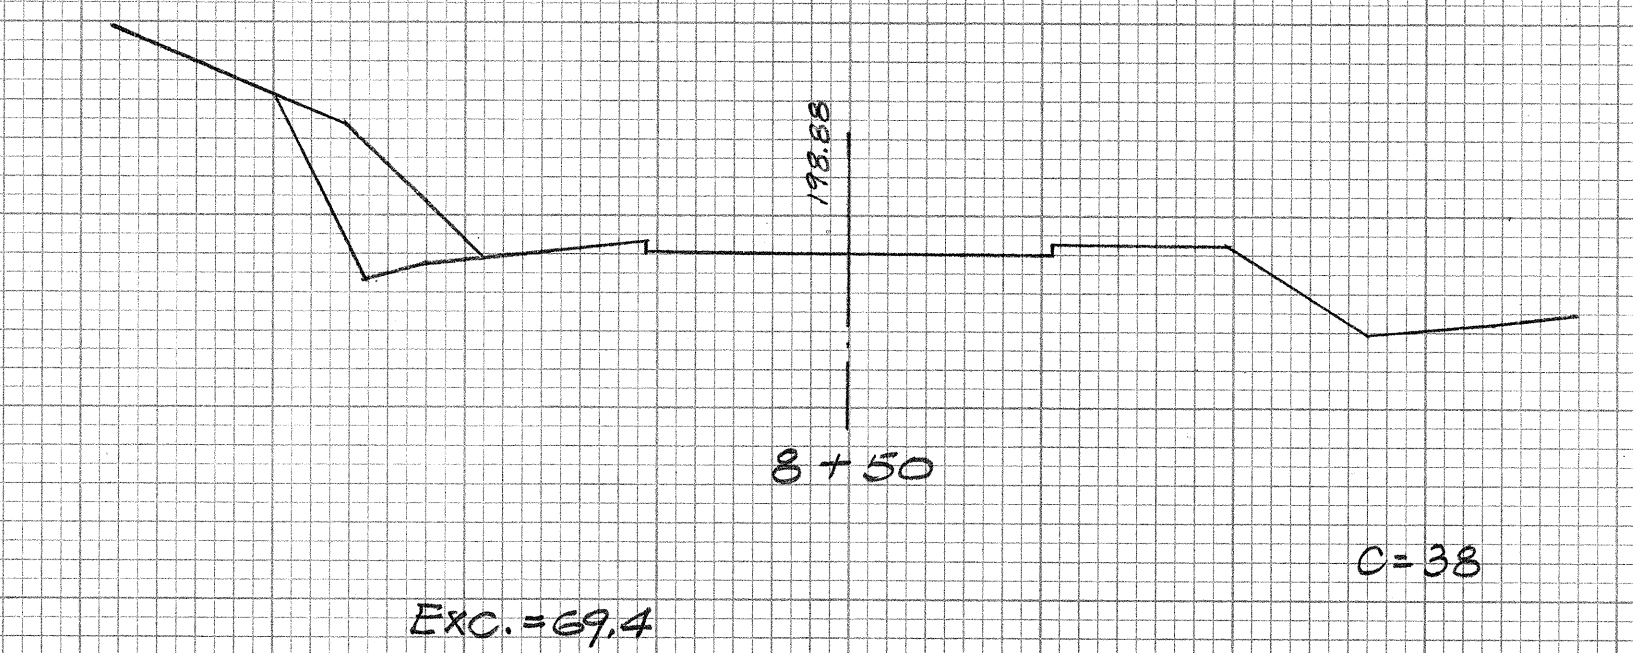
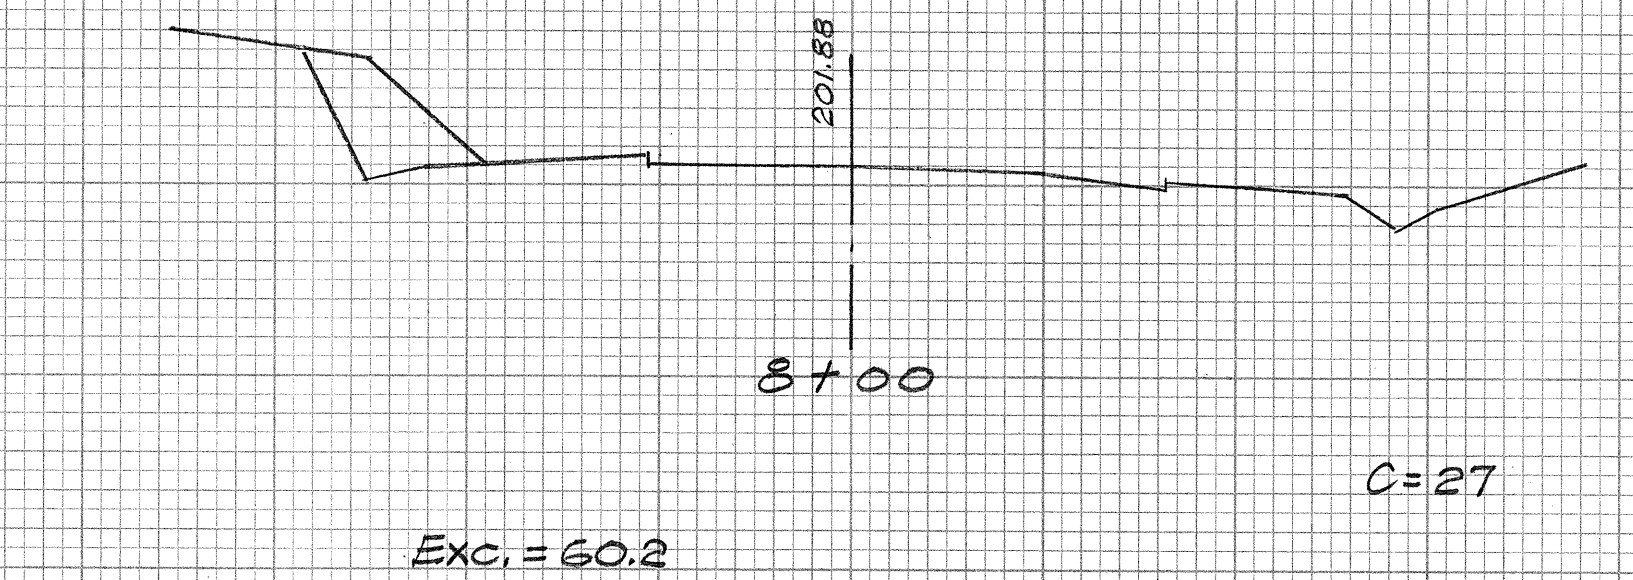
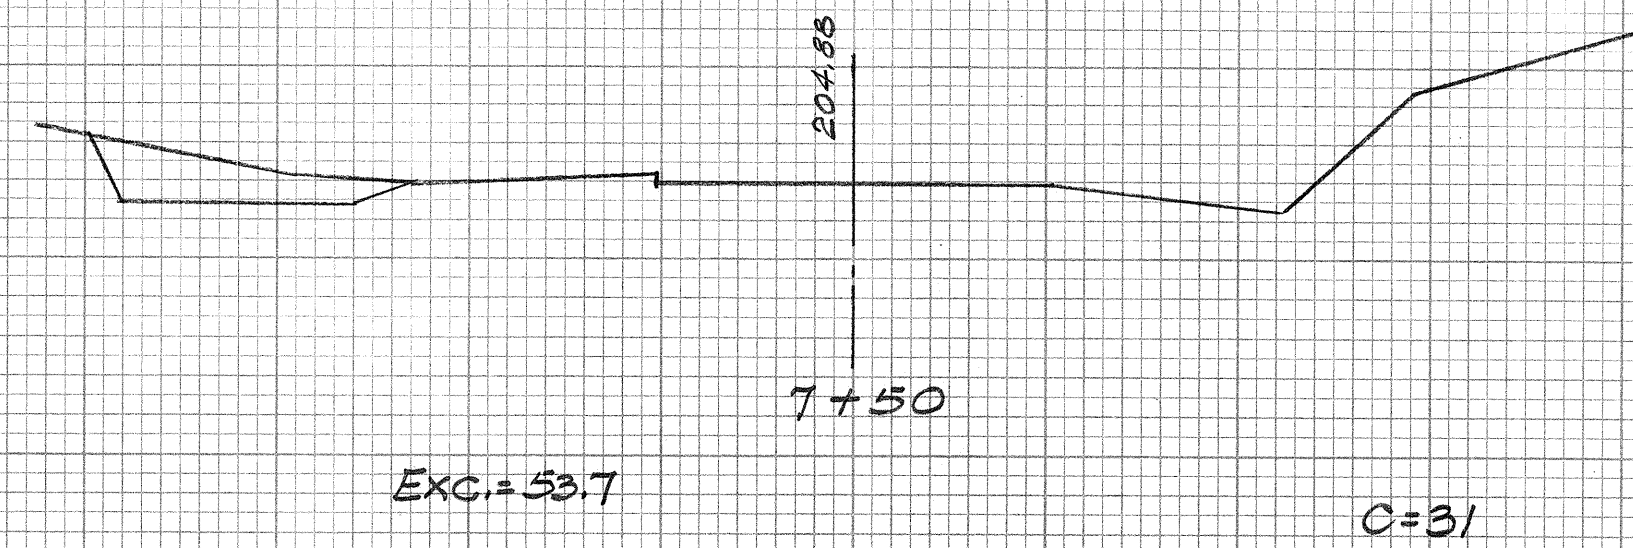
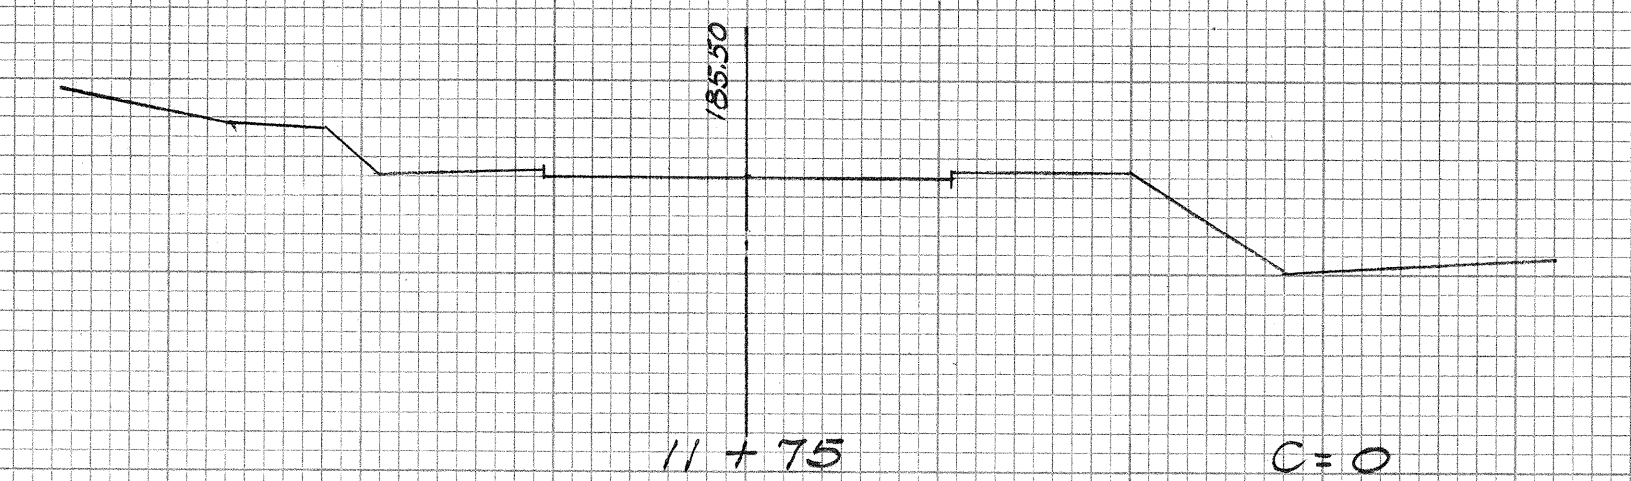
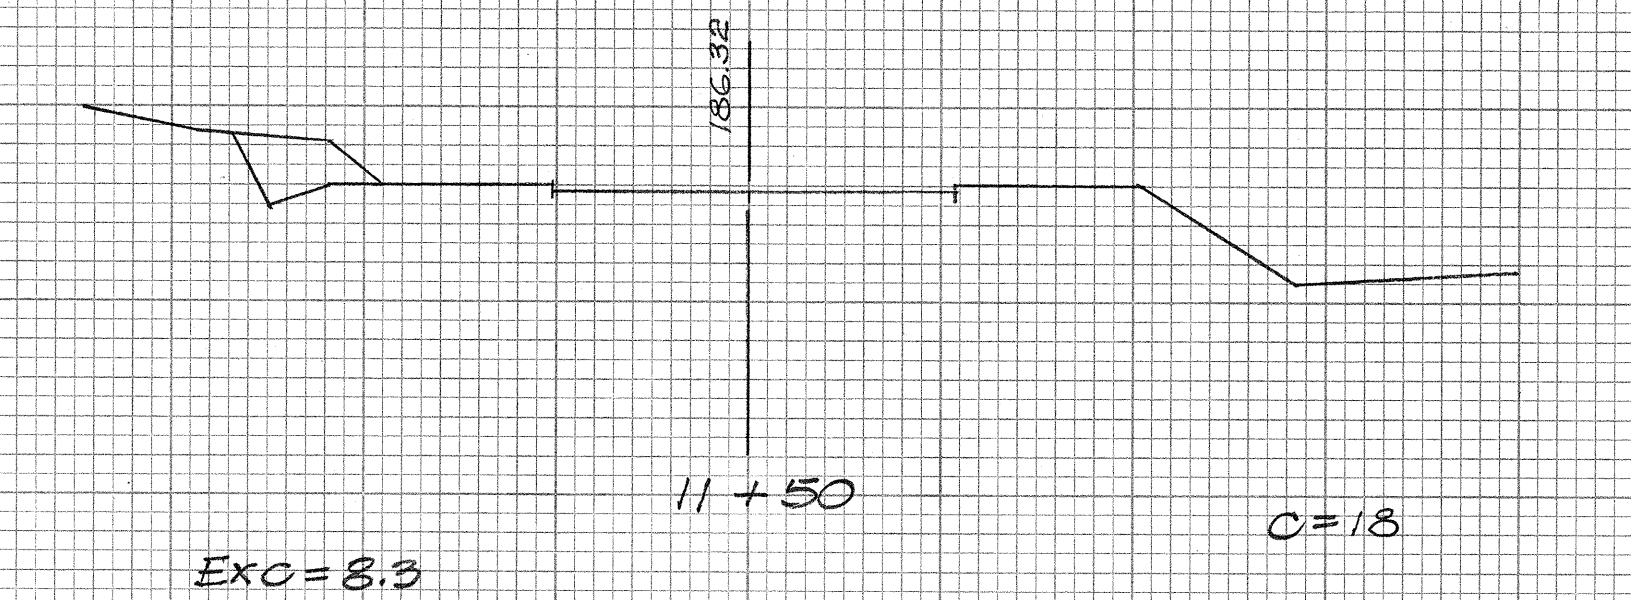
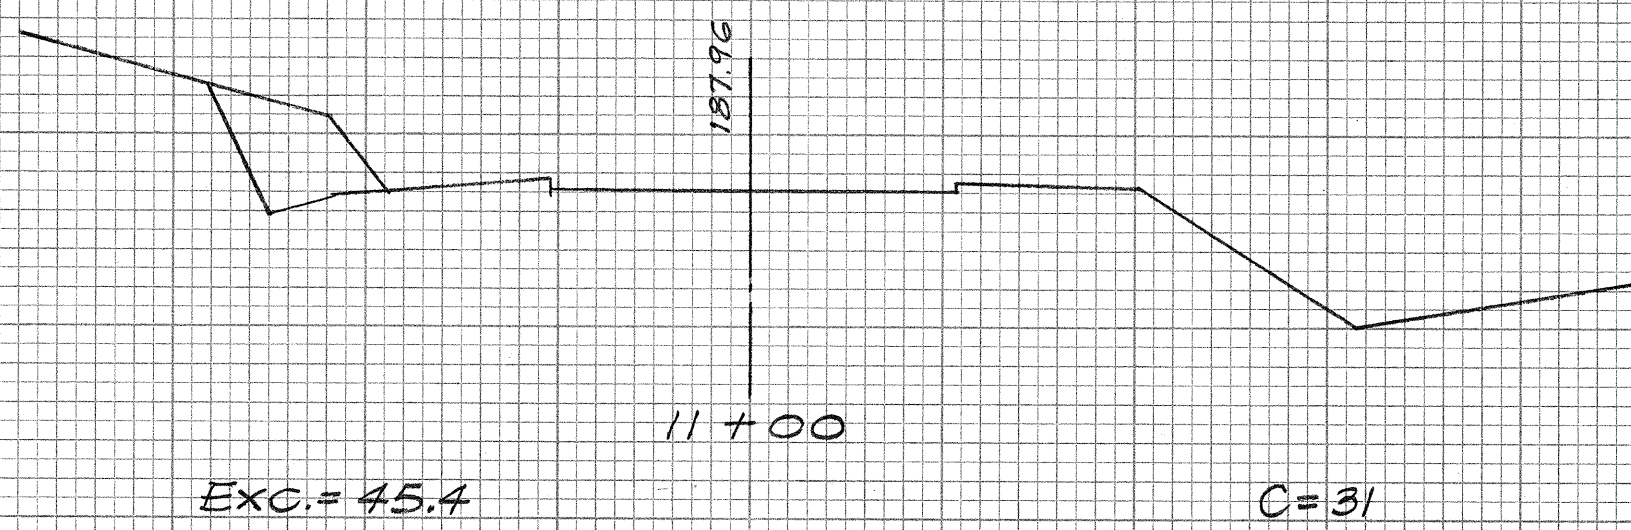
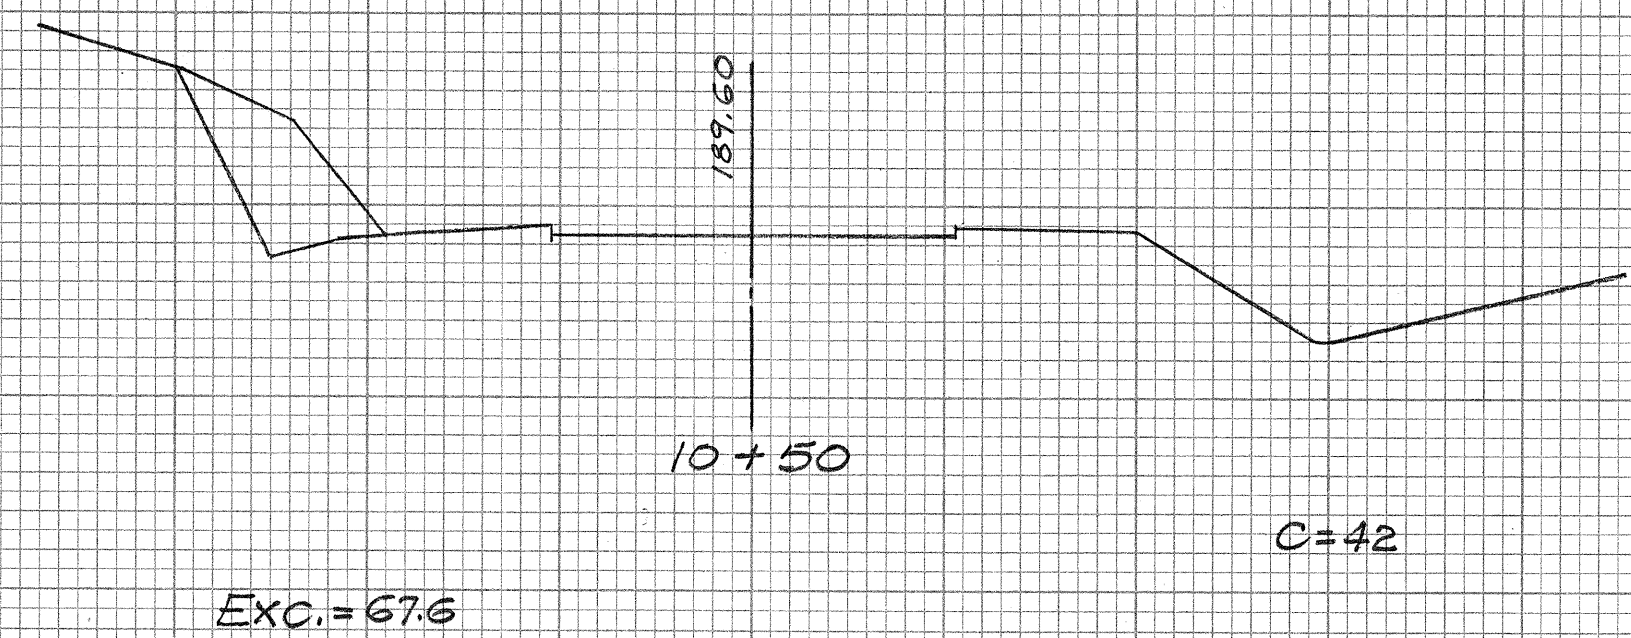


24

FINAL SURVEY NO.	SURVEYED BY	DATE
NOTE BOOK NO.	PLOTTED BY	
	TEMPLATE NO.	
	AREAS CHECKED	

ORIGINAL SURVEY NO.	SURVEYED BY	DATE
NOTE BOOK NO.	PLOTTED BY	
	TEMPLATE NO.	
	AREAS CHECKED	

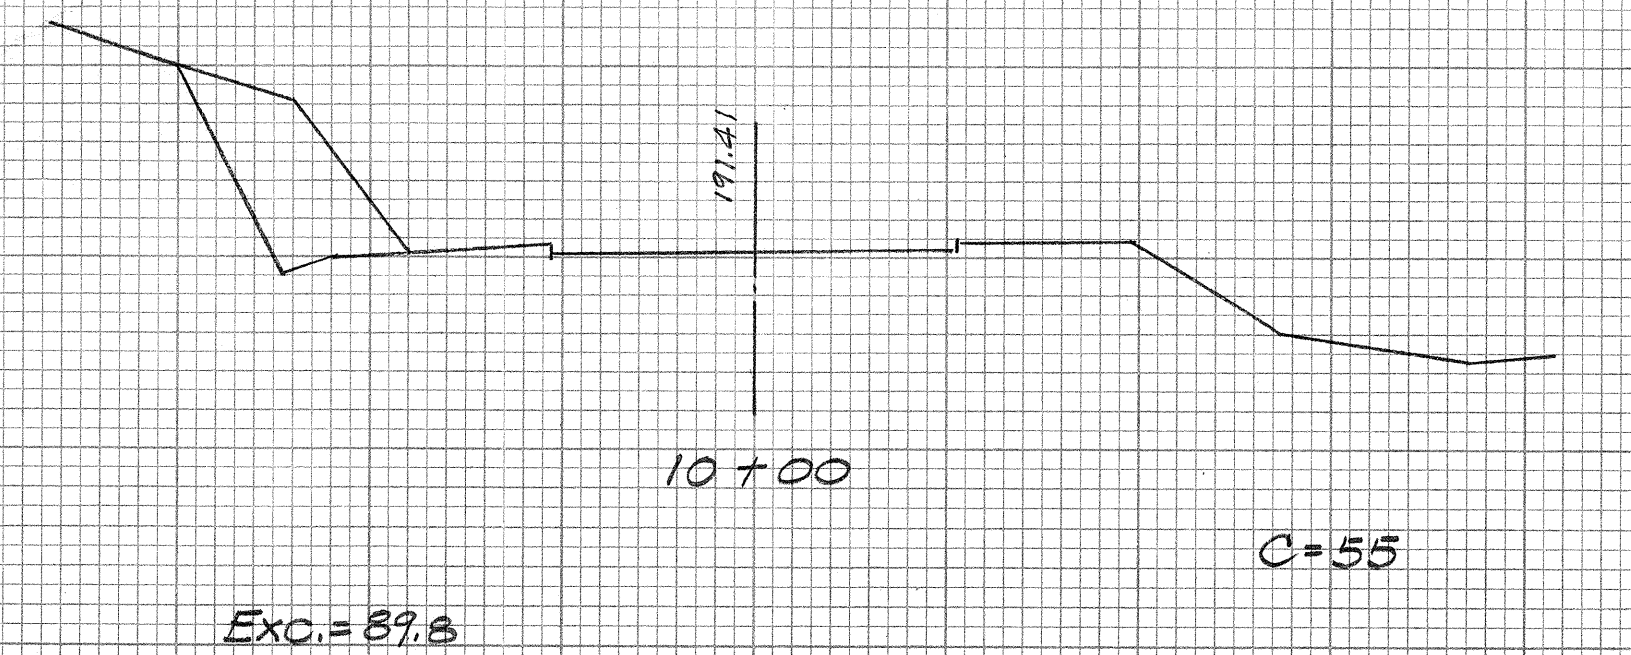

CROSS SECTION FOR
PROPOSED BORROW PIT

VOID
MATERIAL NOT UTILIZED