

FED. ROAD DIST. NO.	STATE	FED. AID PROJ. NO.	FISCAL YEAR	SHEET NO.	TOTAL SHEETS
Hawaii	Hon	F12(10)	1952	14	25

ORIGINAL SURVEY	SURVEYED
NOTE BOOK NO.	TEPIPAF AREAS
BOOK CHECKED	AREAS CHECKED

DATE	BY	DATE
SURVEY		
NOTE BOOK NO.		
BOOK CHECKED		


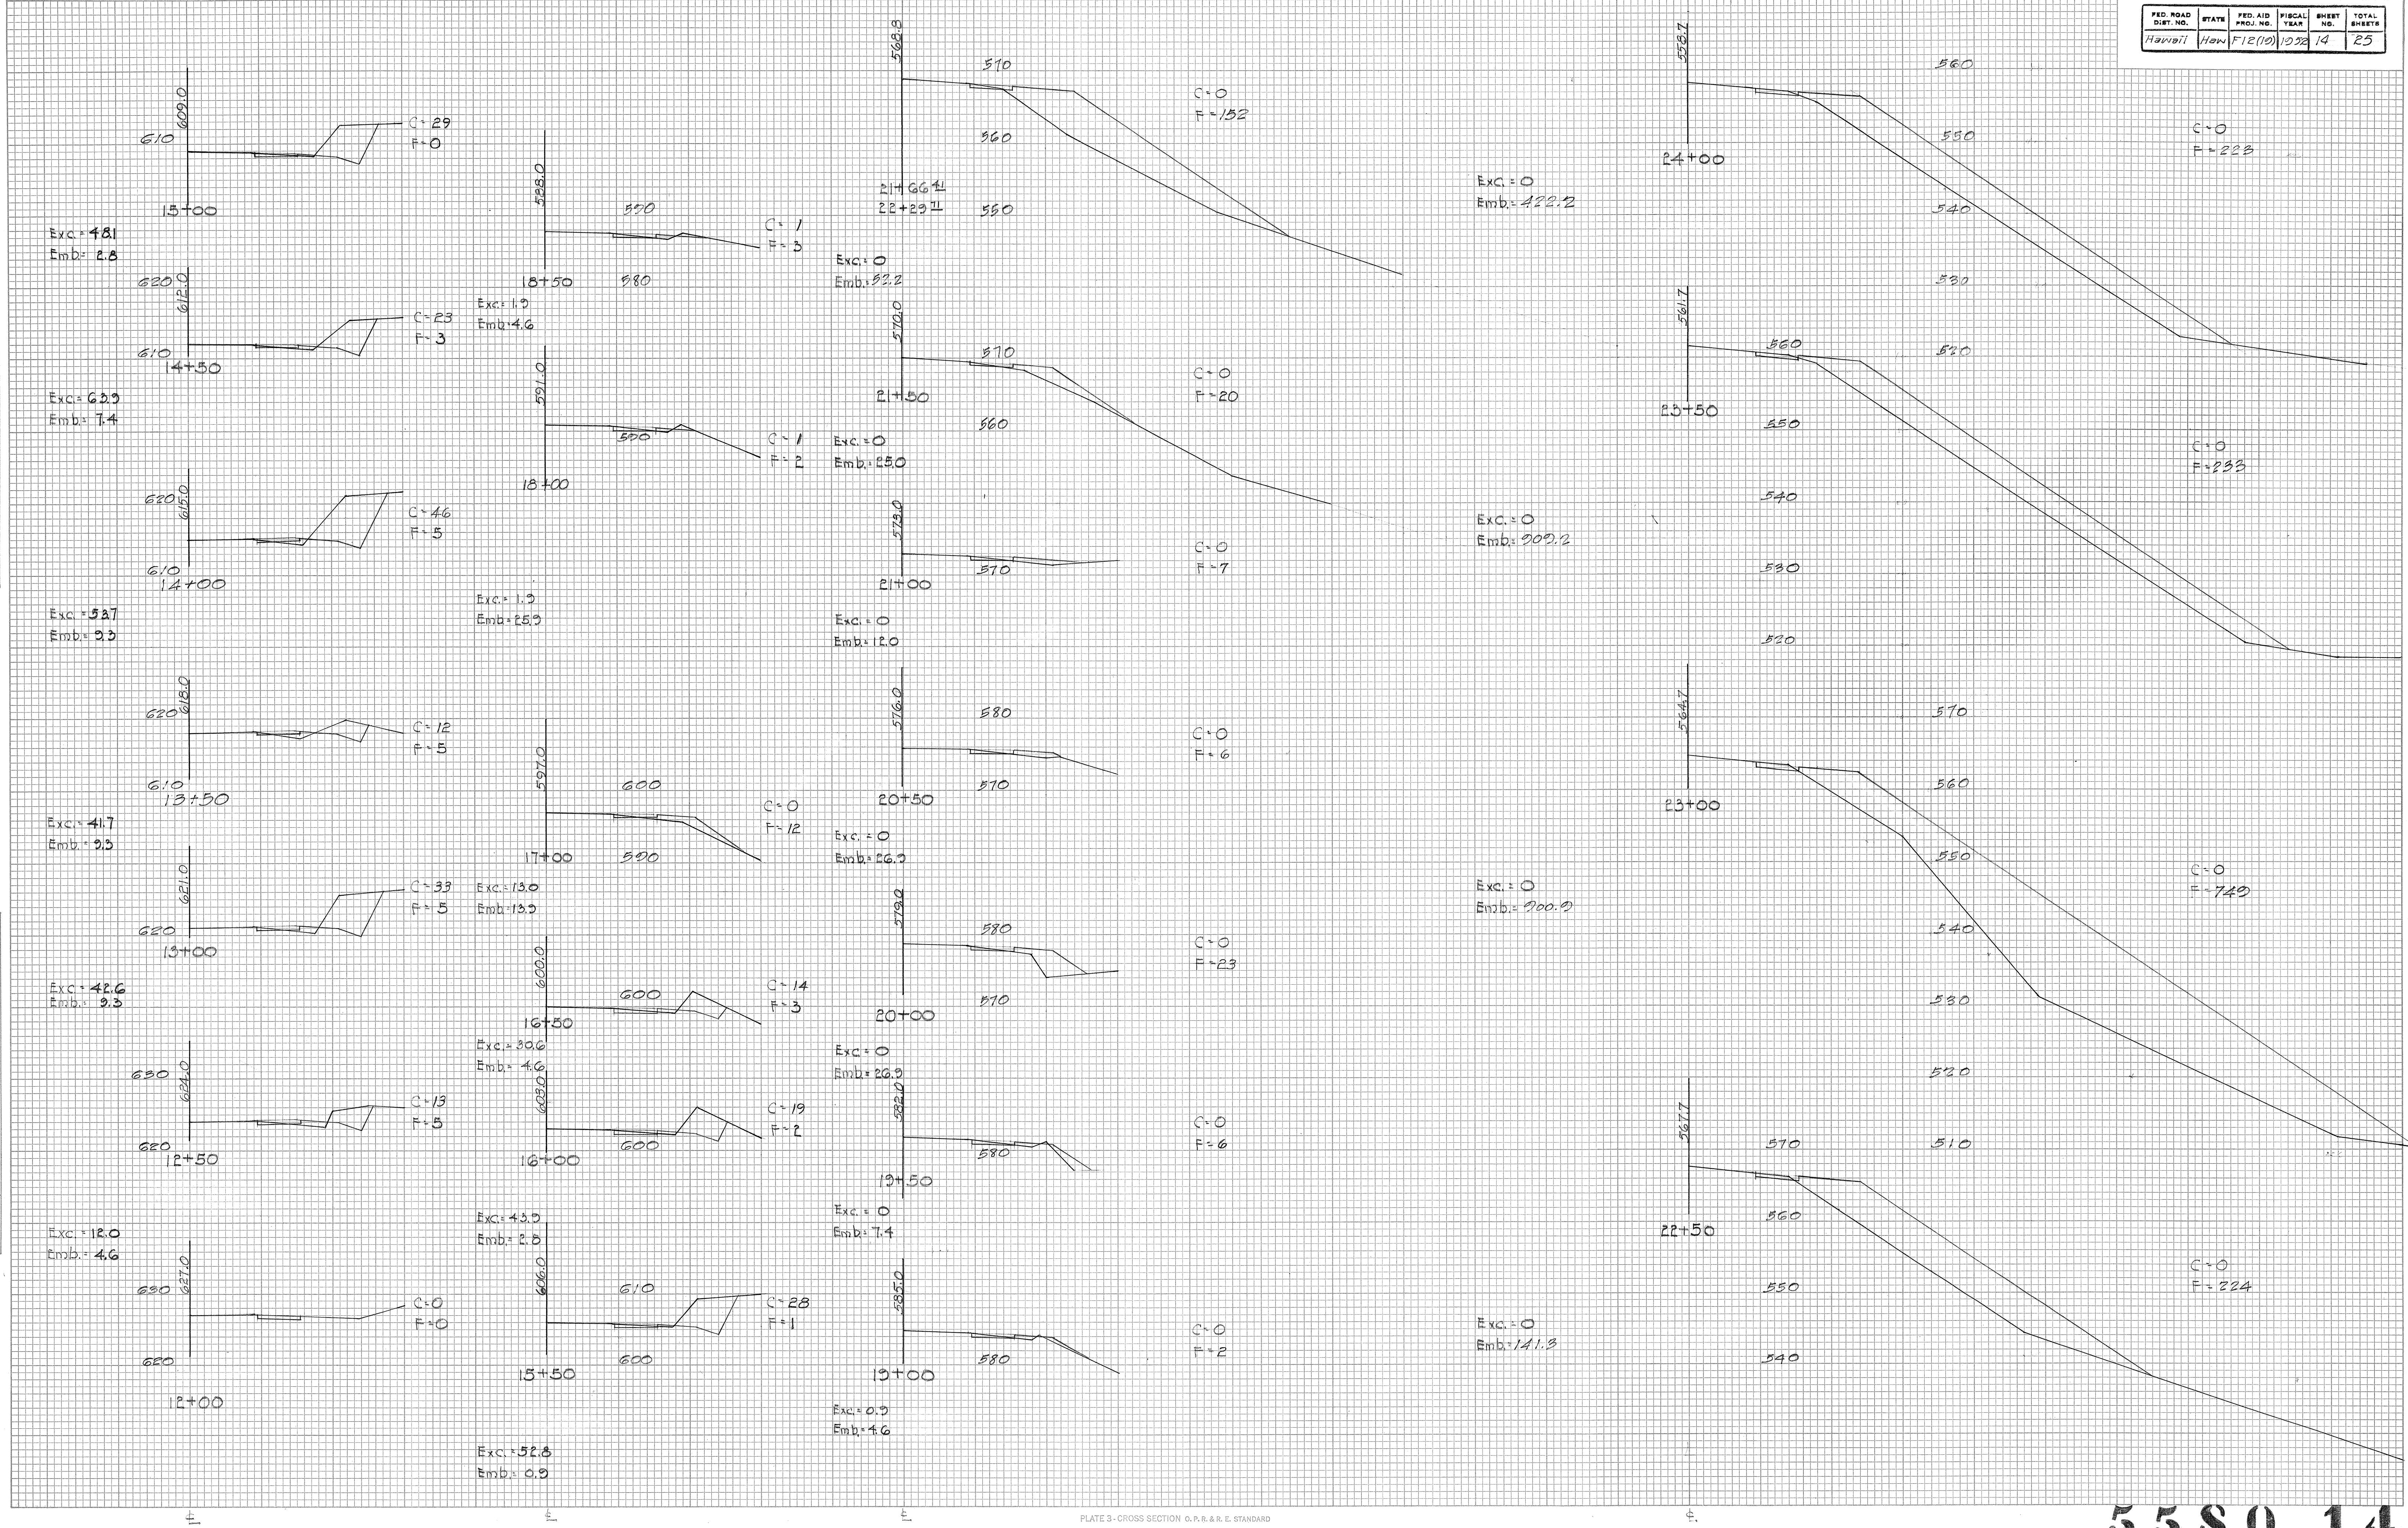


PLATE 3 - CROSS SECTION O.P.R. & R.E. STANDARD
KEUFFEL & ESSER CO., NEW YORK.

FED. ROAD DIST. NO.	STATE	FED. AID PROJ. NO.	FISCAL YEAR	SHEET NO.	TOTAL SHEETS
Hawaii	Haw	F12(0)	1992	15	25

FINAL SURVEY	SURVEYED
PLOTTED	TEMPLATE
NOTE BOOK	AREAS CHECKED
NO.	


ORIGINAL SURVEY	BY	DATE
PLOTTED		
NOTE BOOK	TEMPLATE	
NO.	AREAS CHECKED	

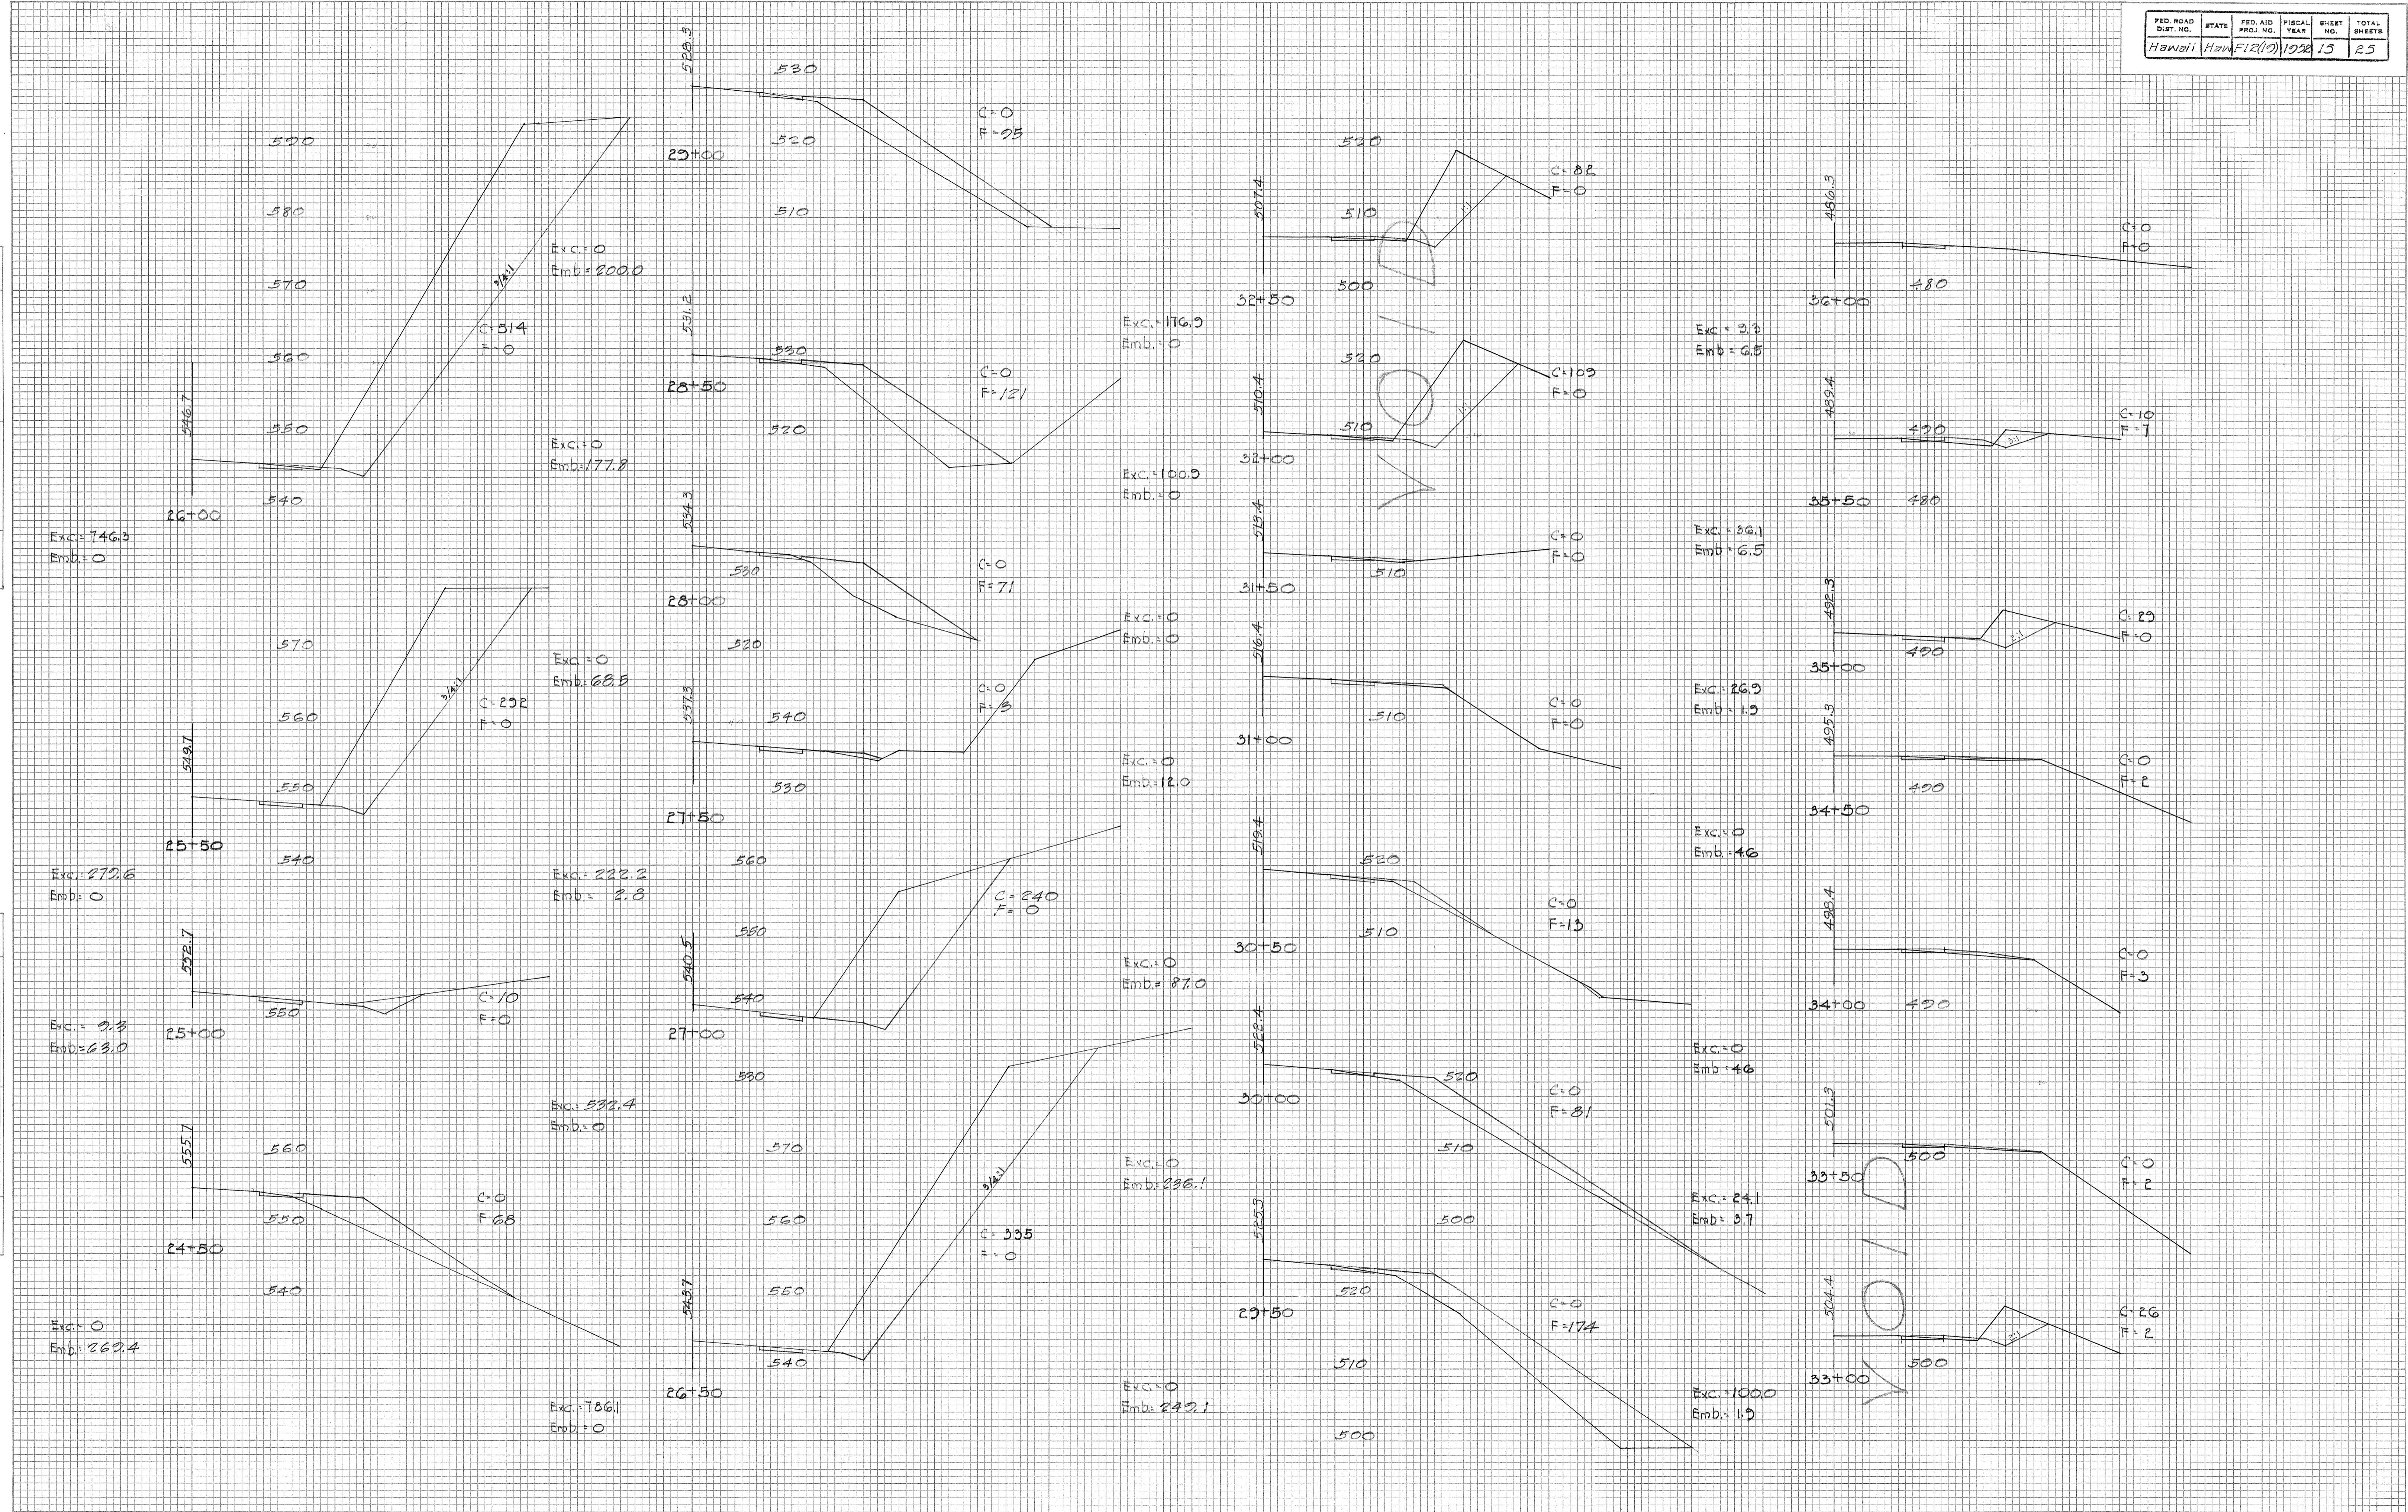


FED. ROAD DIST. NO.	STATE	FED. AID PROJ. NO.	FISCAL YEAR	SHEET NO.	TOTAL SHEETS
Hawaii Hwy F12(9) 1922				16	25

FINAL SURVEY	SURVEYED BY	DATE
SURVEYED PLOTTED	NOTE BOOK NO.	AREAS CHECKED

ORIGINAL SURVEY	BY	DATE
SURVEYED PLOTTED	NOTE BOOK NO.	AREAS CHECKED

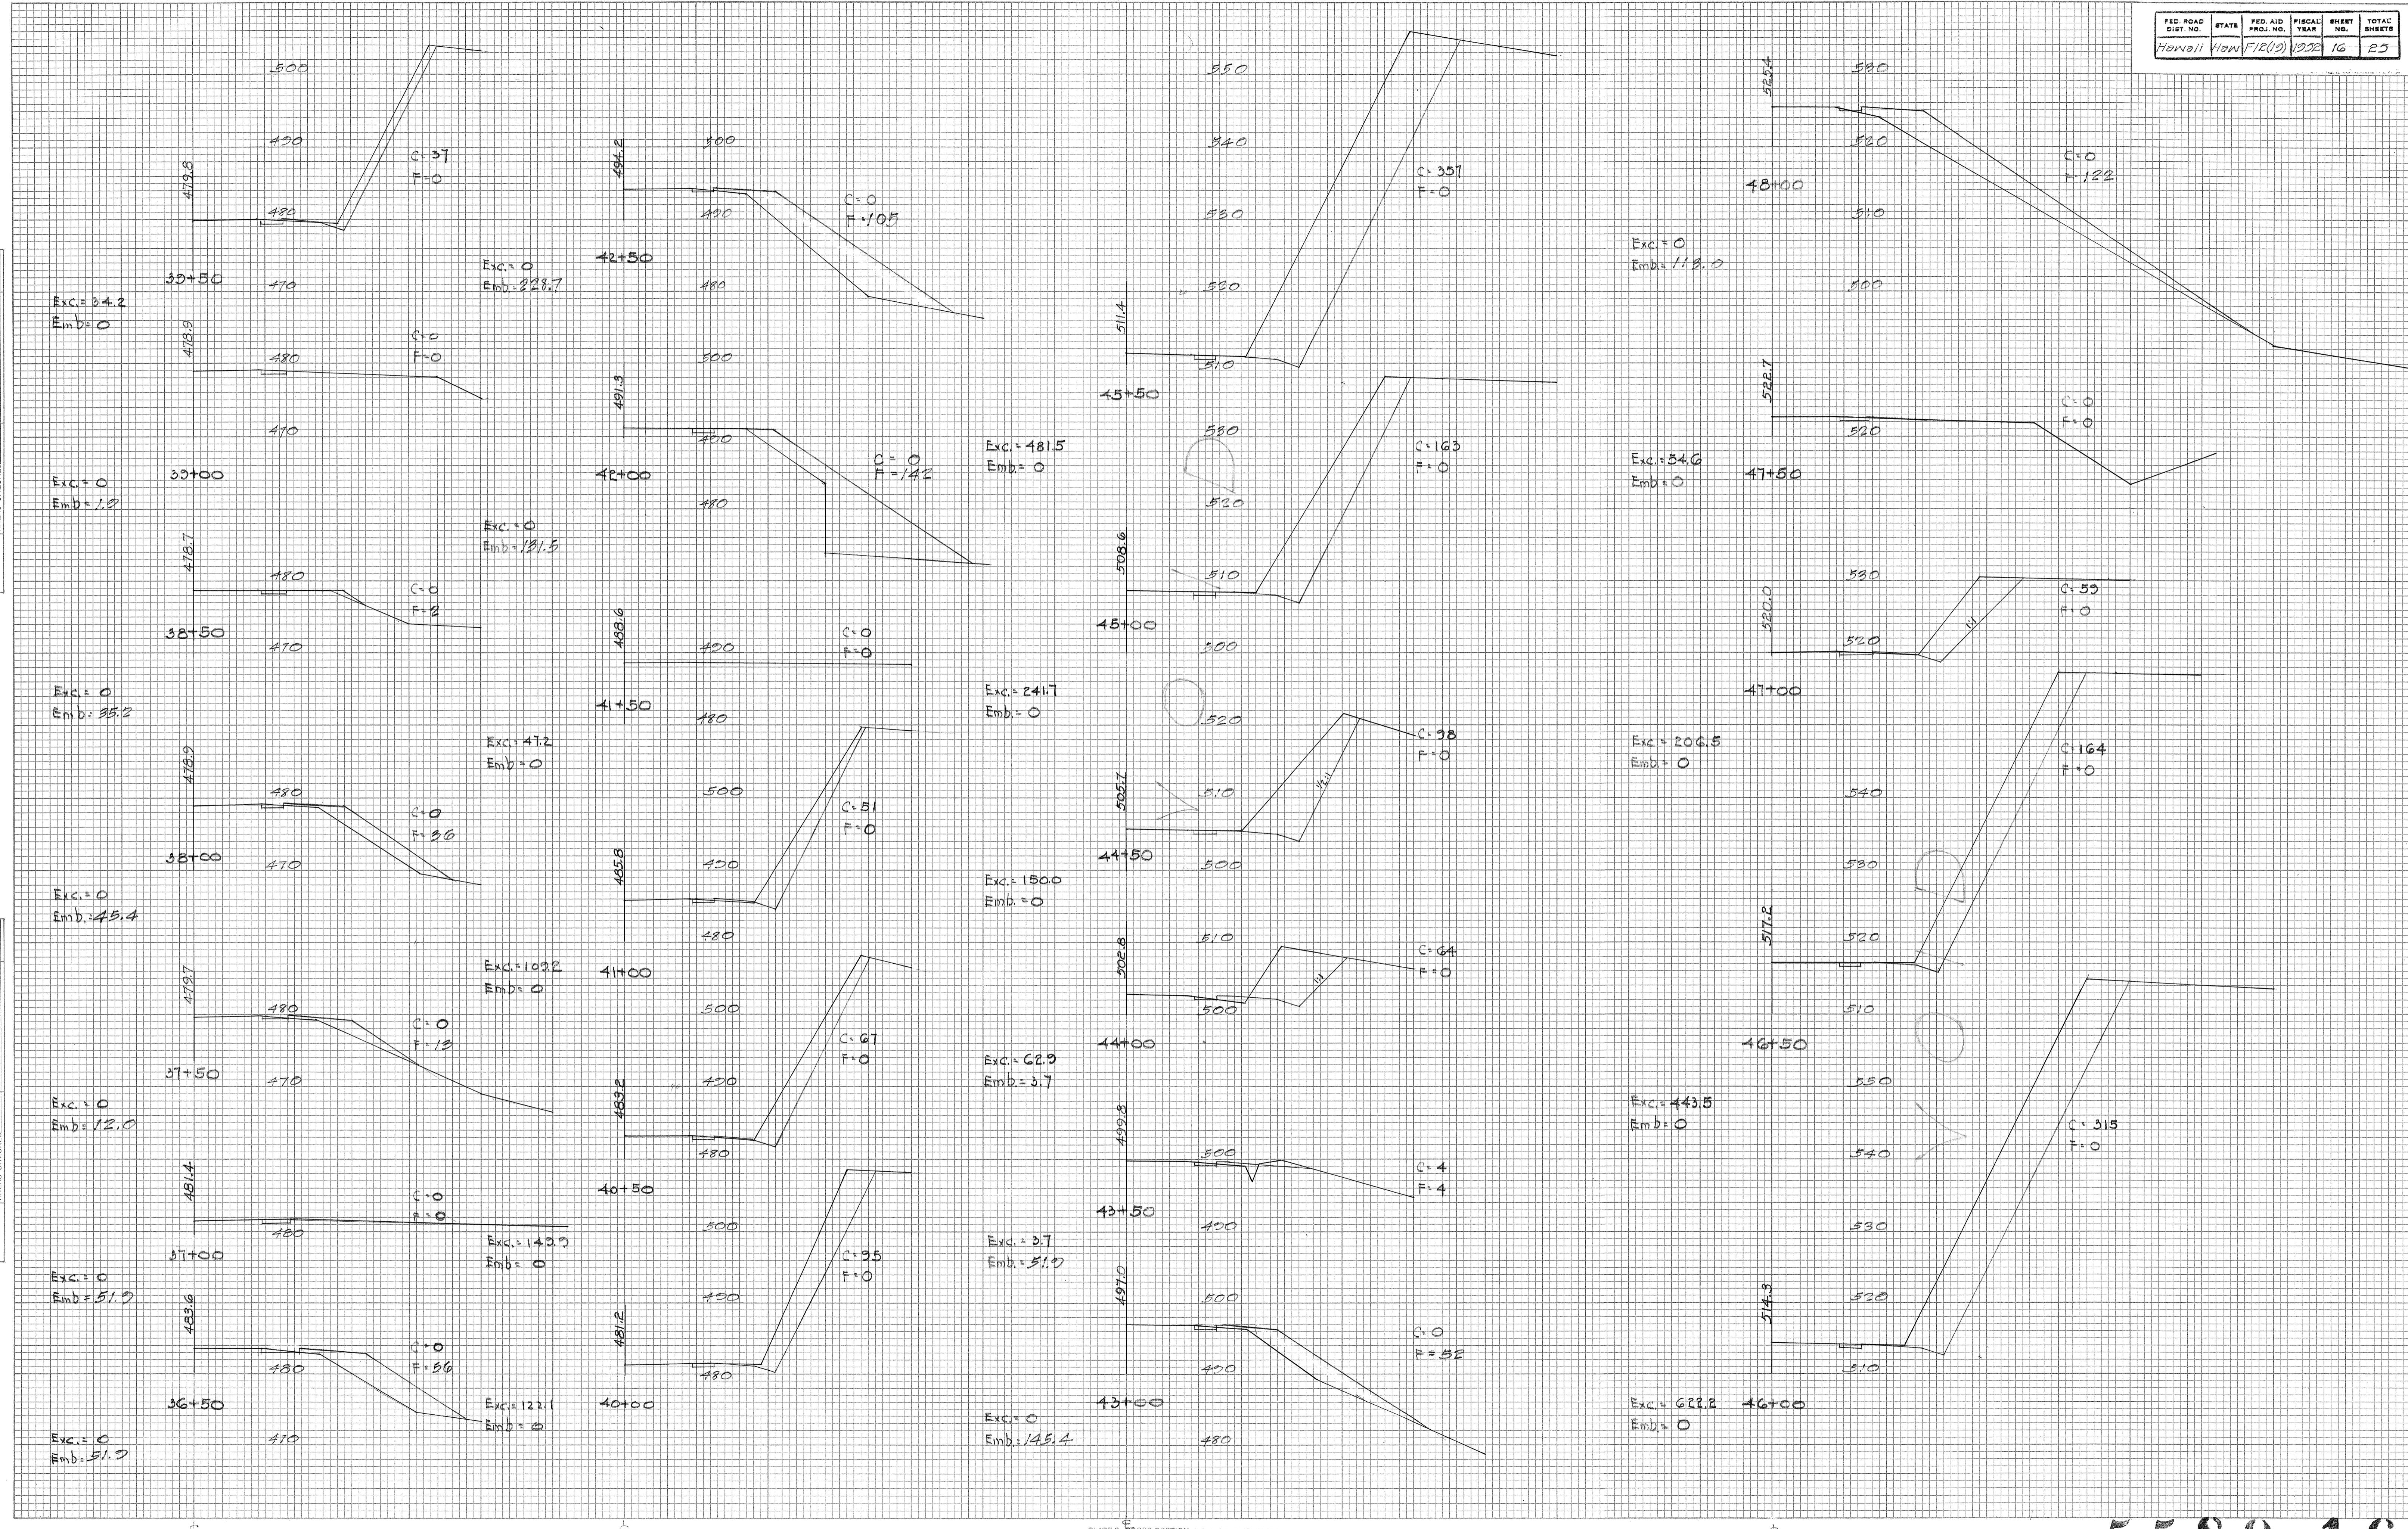

FED. ROAD DIST. NO.	STATE	FED. AID PROJ. NO.	FISCAL YEAR	SHEET NO.	TOTAL SHEETS
Hawaii	Han	F12(19)	1952	17	25

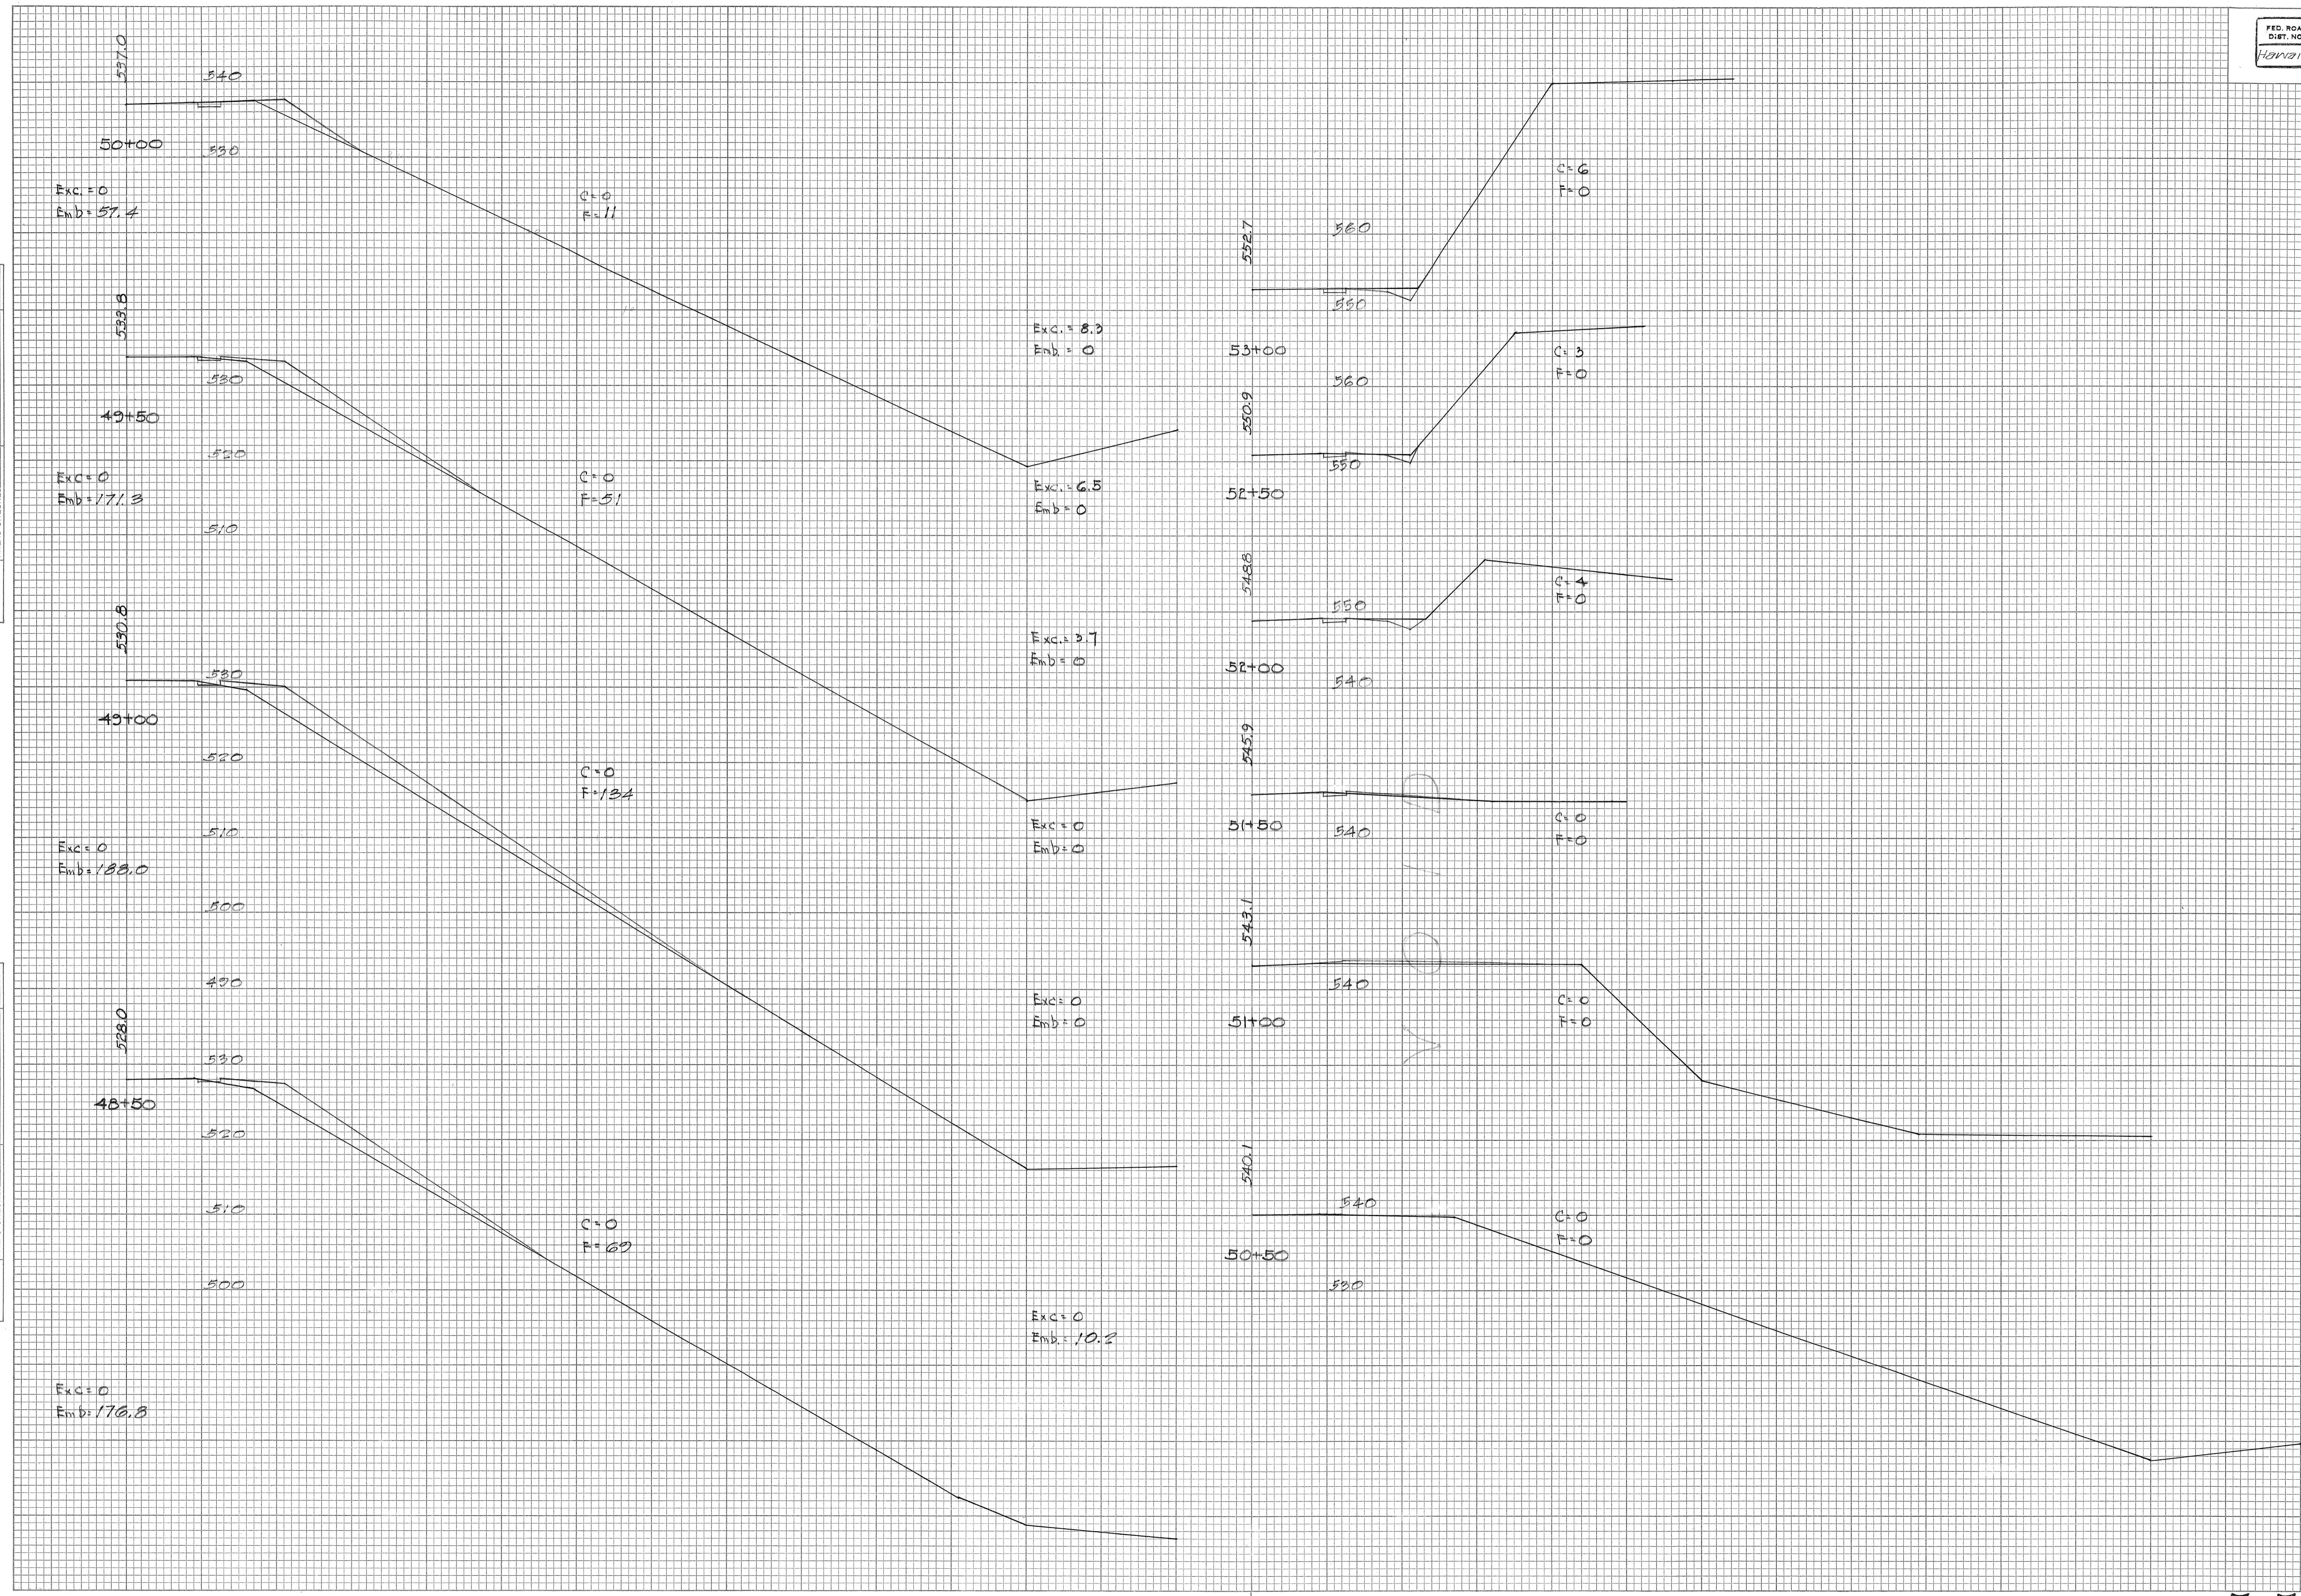

ROAD T. NO.	STATE	FED. AID PROJ. NO.	FISCAL YEAR	SHOOT NO.	TOTAL SHEETS
Hawai	Haw	F12(19)	1952	18	25

FINAL SURVEY	SURVEYED PLOTTED TEMPLATE	BY	DATE
NOTE BOOK AREAS	AREAS CHECKED	NO.	

ORIGINAL SURVEY	SURVEYED	BY	DATE
	PLOTTED		
	TEMPLATE		
	AREAS		
NOTE BOOK			AREAS CHECKED

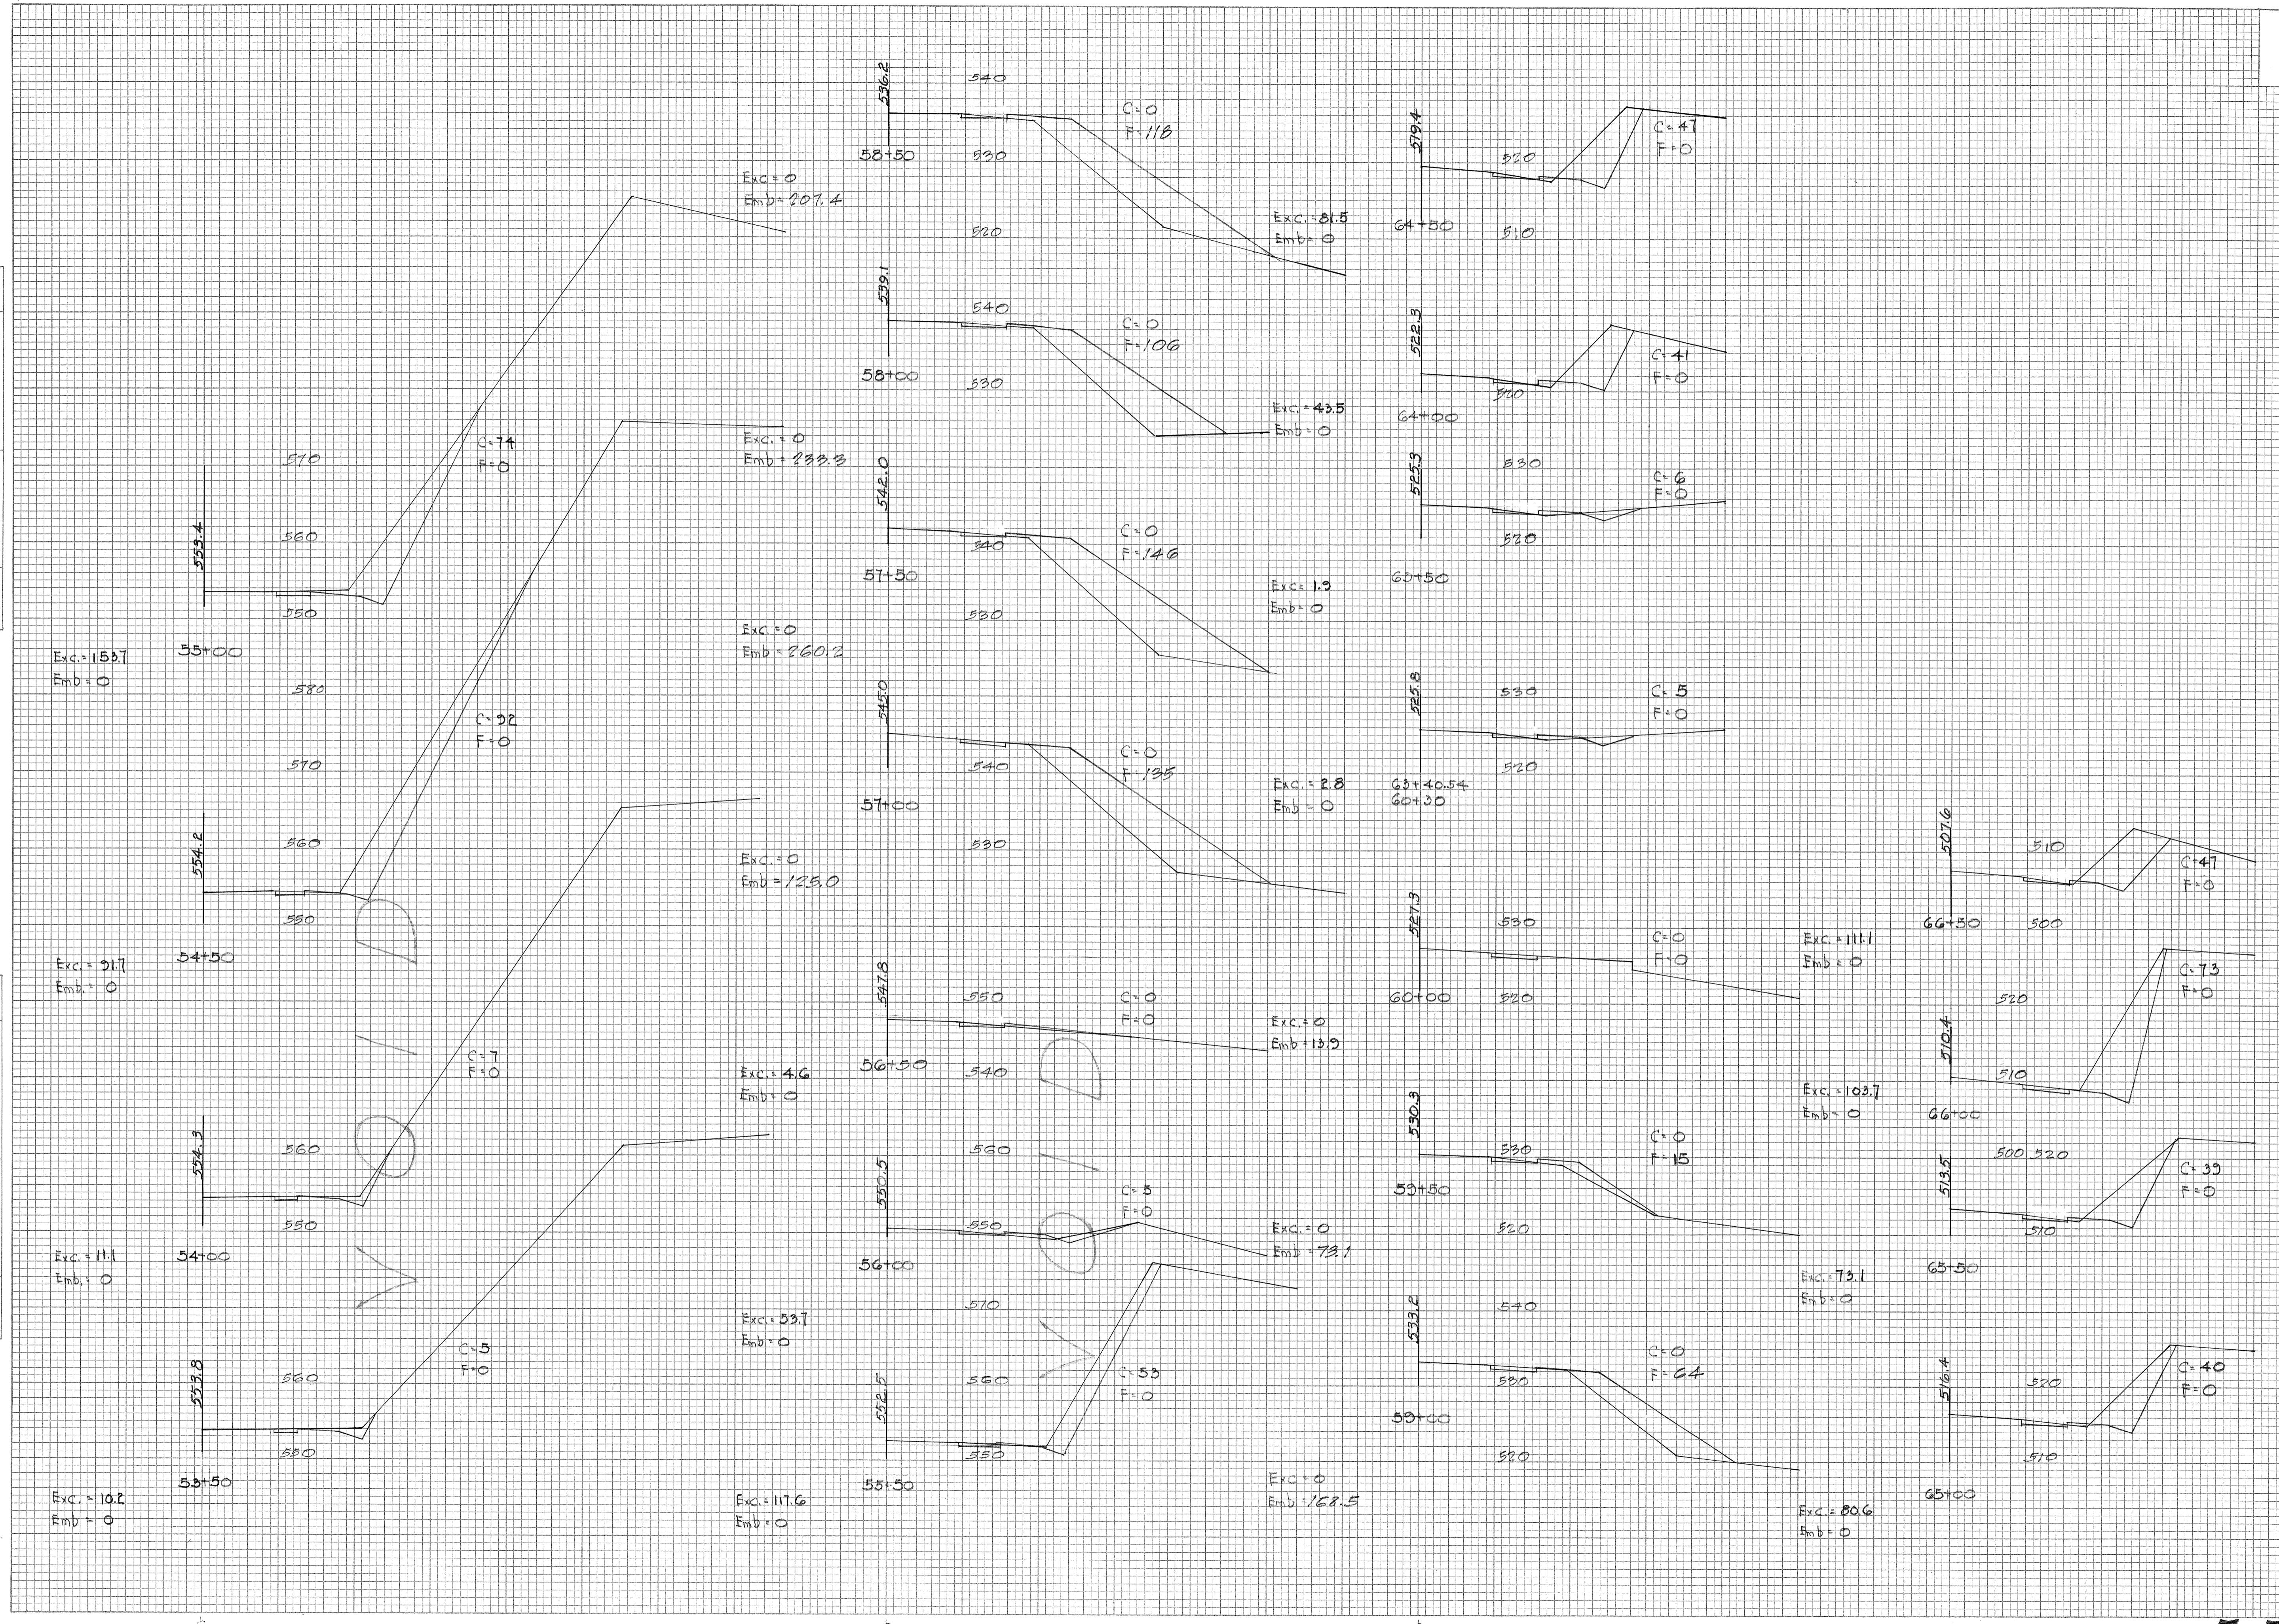


PLATE 3 - CROSS SECTION O. P. R. & R. E. STANDARD
KEUFFEL & ESSER CO., NEW YORK.

K & E CO. No. 345-3 MADE IN U.S.A. 28334

ROAD NO.	STATE	FED. AID PROJ. NO.	FISCAL YEAR	SHEET NO.	TOTAL SHEETS
1aii	Haw	F12(19)	1952	19	25

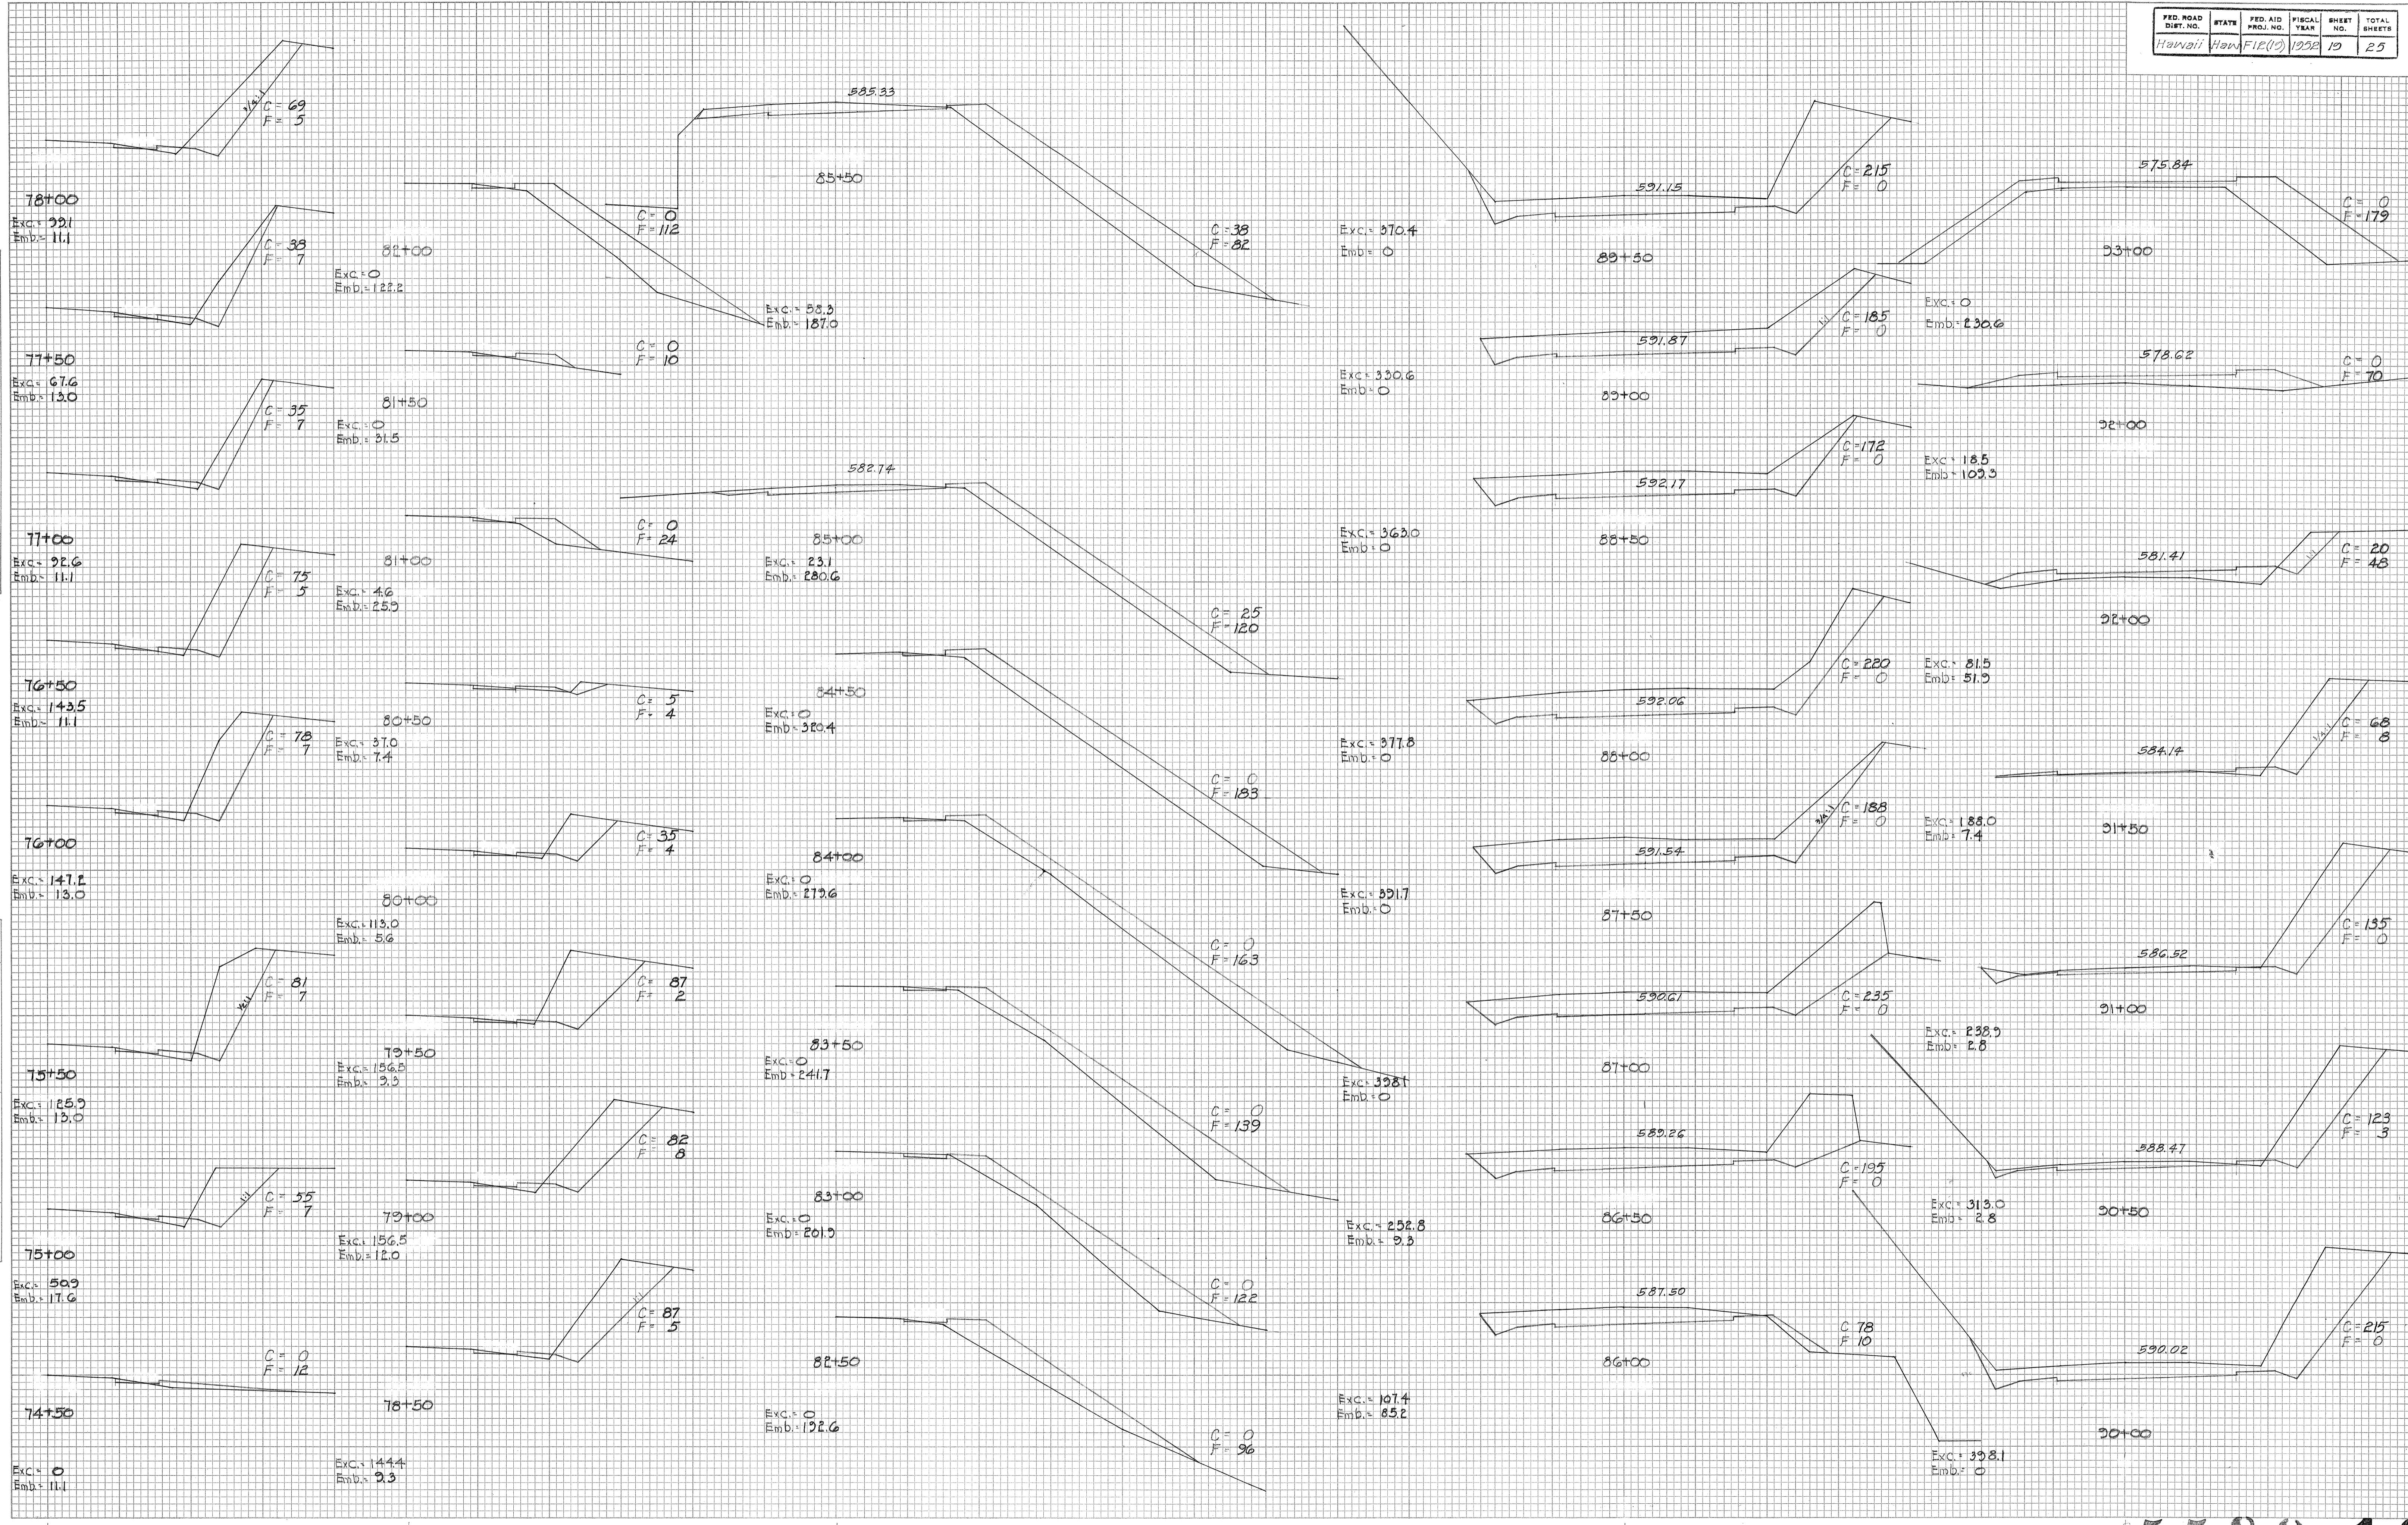
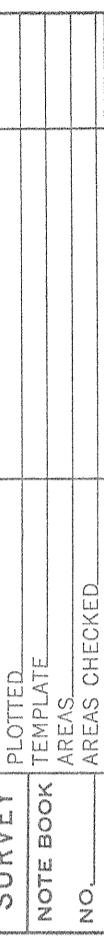


PLATE 3 - CROSS SECTION O.P.R. & R.E. STANDARD
KEUFFEL & ESSER CO., NEW YORK.

ROAD T. NO.	STATE	FED. AID PROJ. NO.	FISCAL YEAR	HEET NO.	TOTAL SHEETS
vaii	Haw	F12(19)	1952	20	25

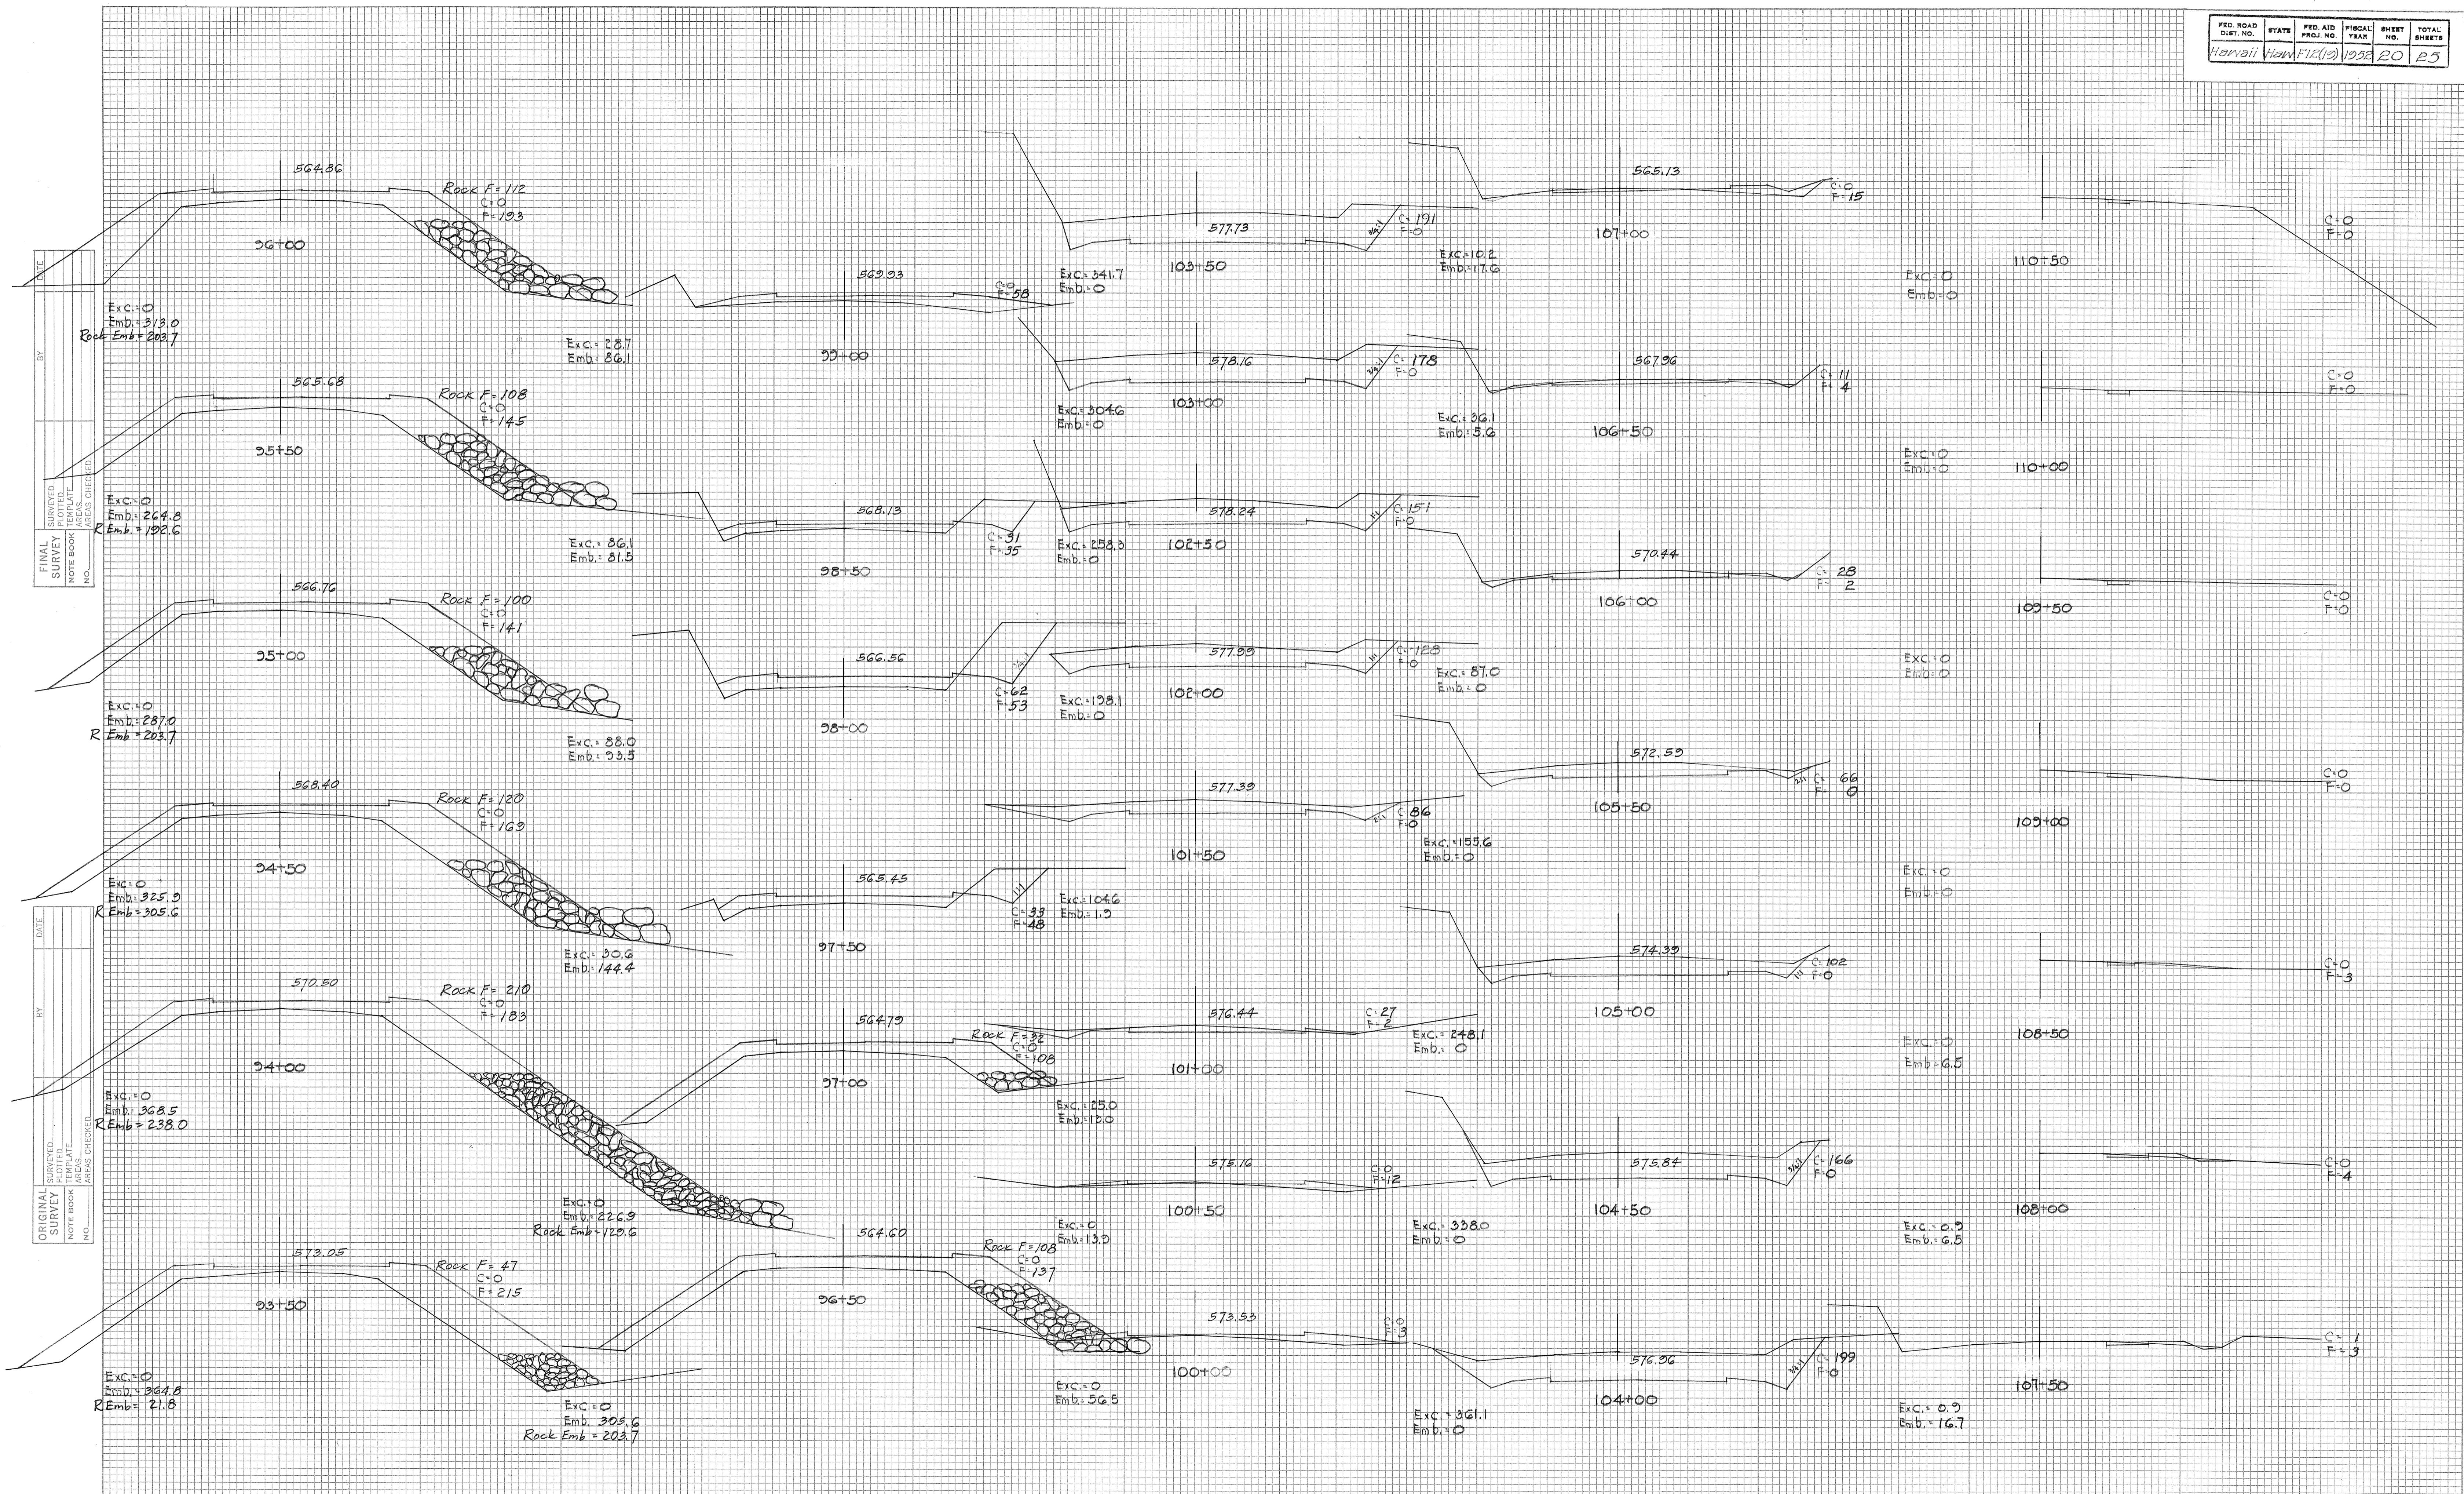



PLATE 3 - CROSS SECTION O. P. R. & R. E. STANDARD
KEUFFEL & ESSER CO., NEW YORK.

K & E CO. No. 345-3 MADE IN U.S.A. 28834

FED. ROAD DIST. NO.	STATE	FED. AID PROJ. NO.	FISCAL YEAR	SHEET NO.	TOTAL SHEETS
Hawaii Hwy F12(9)	1938	P1	25		

ORIGINAL SURVEY	SURVEY PLOTTED	DATE
NO.	NOTE BOOK	BY
NO.	TEPLATE	
NO.	AREAS CHECKED	


ORIGINAL SURVEY	SURVEY PLOTTED	DATE
NO.	NOTE BOOK	BY
NO.	TEPLATE	
NO.	AREAS CHECKED	

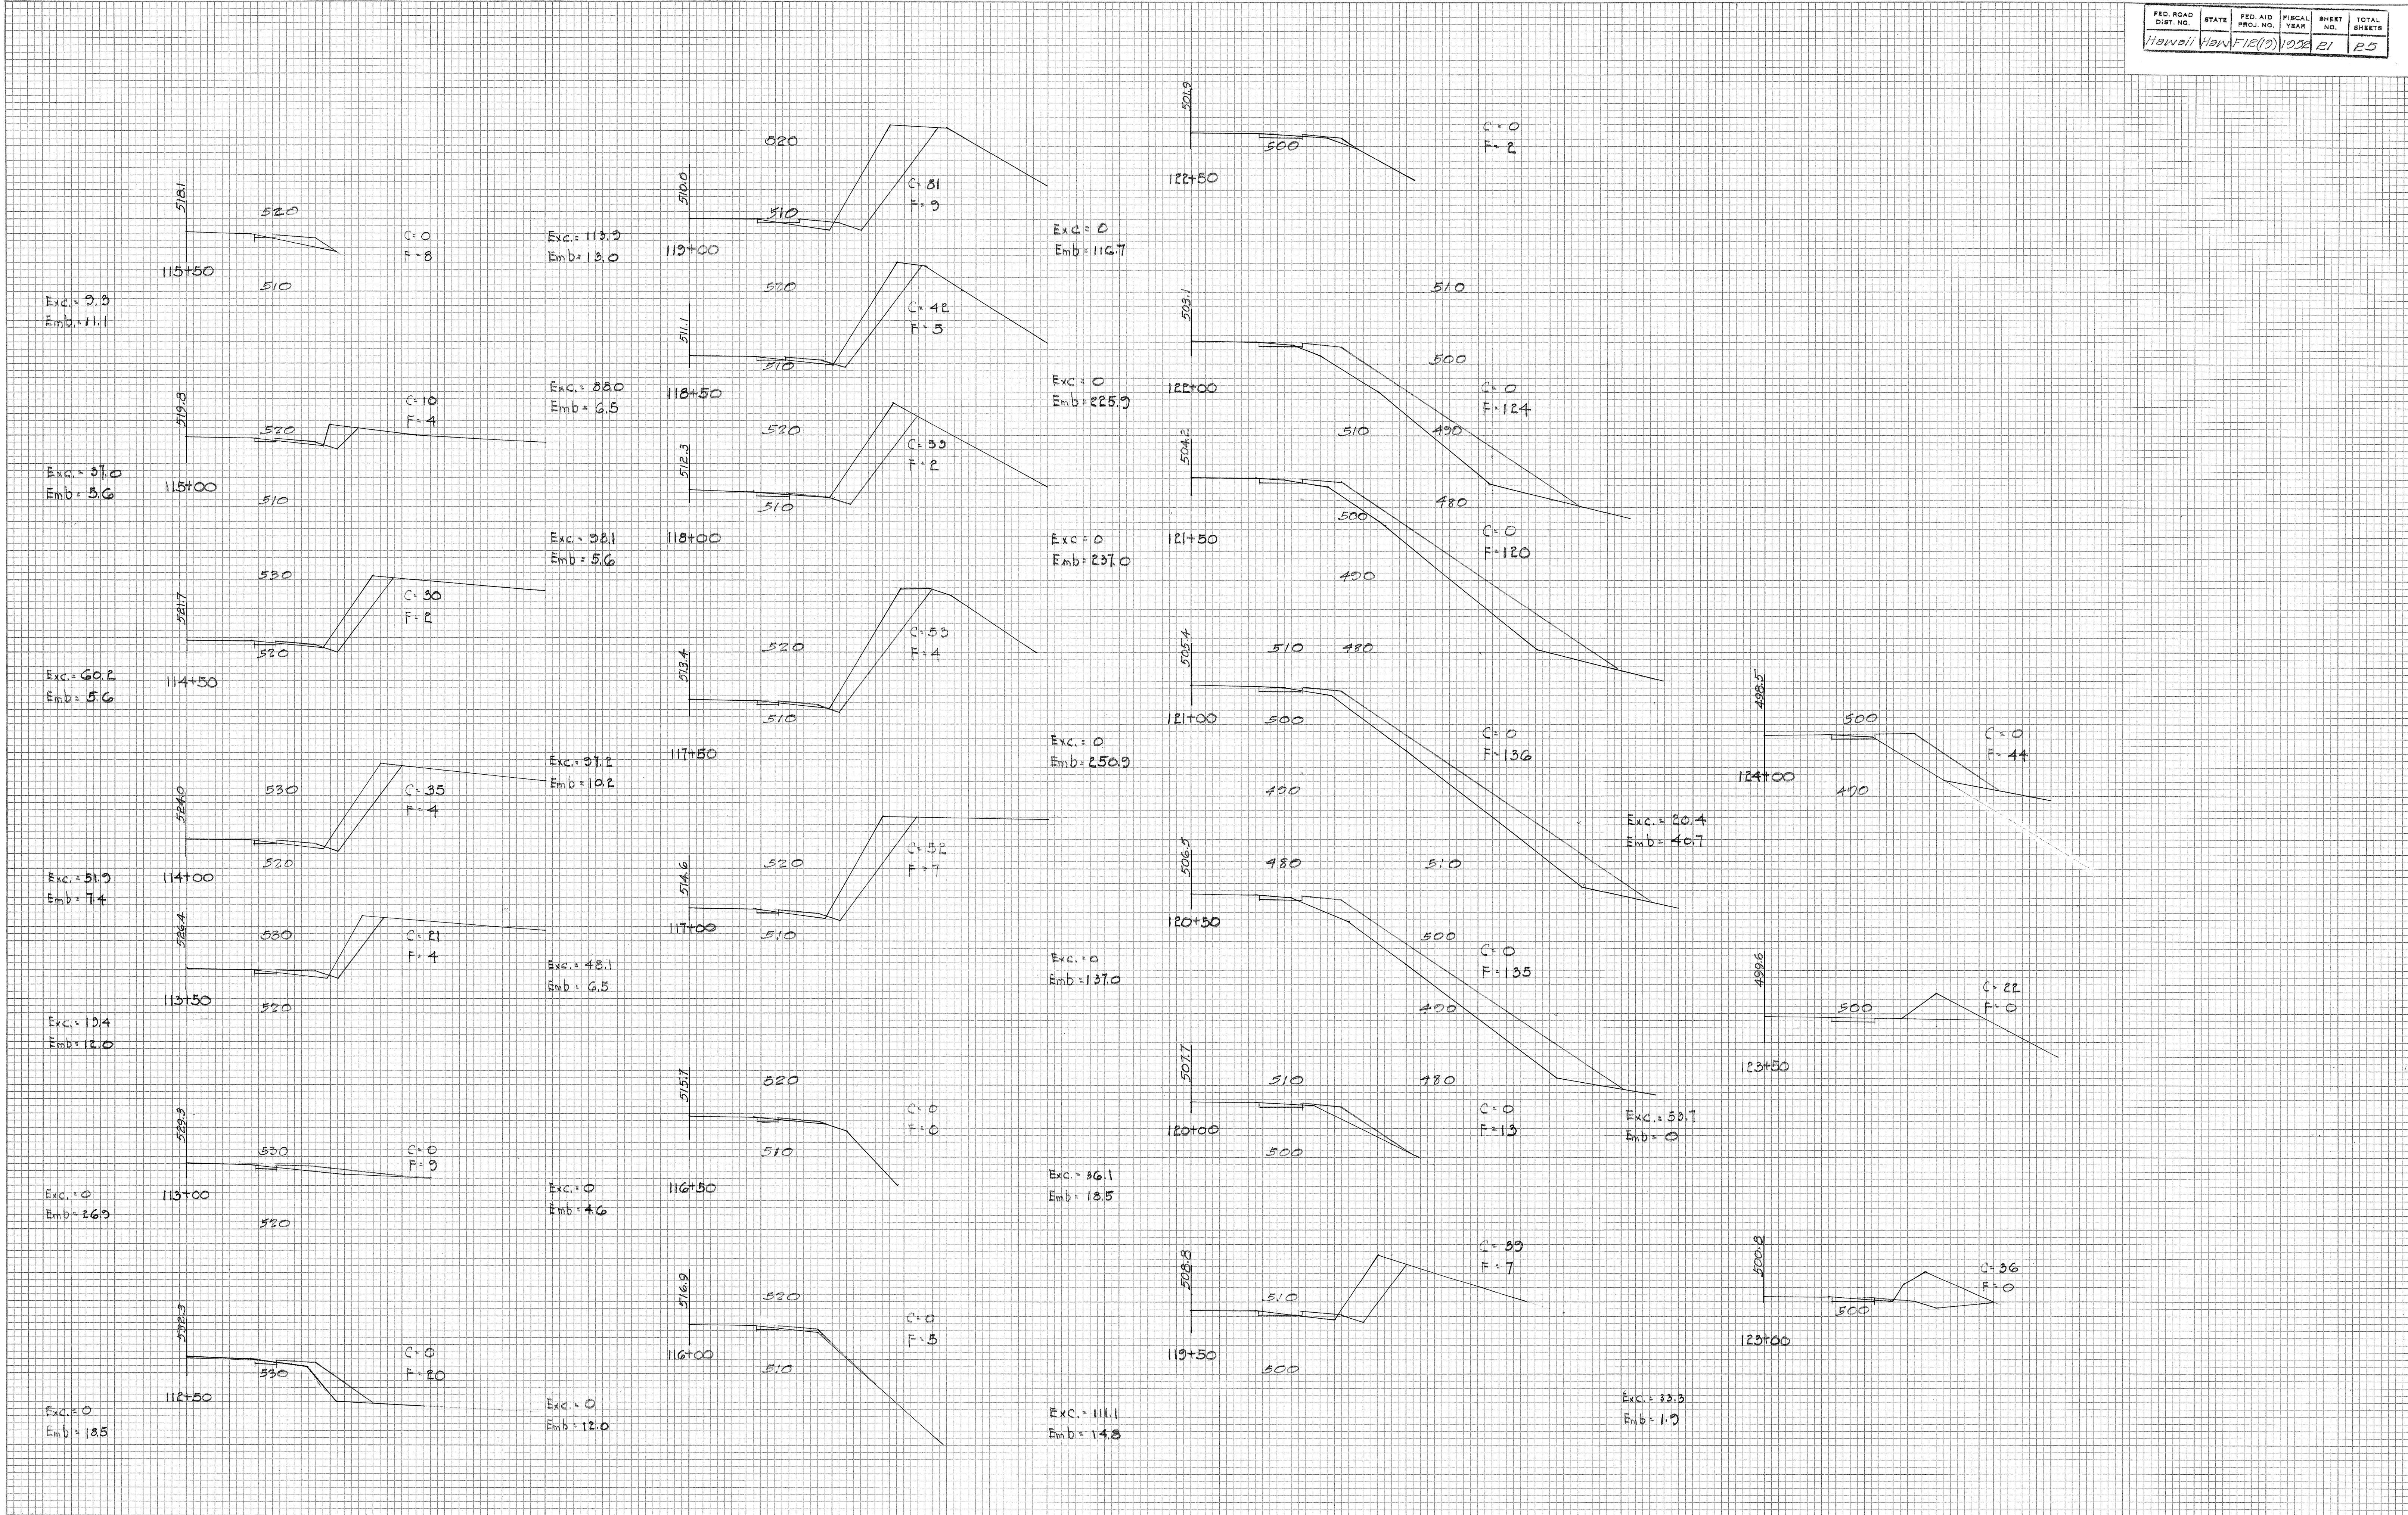

FED. ROAD DIET. NO.	STATE	FED. AID PROJ. NO.	FISCAL YEAR	SHEET NO.	TOTAL SHEETS
Hawaii	Hawaii	F-12(2)	1952	22	25

FINAL SURVEY PLOTTED
NOTE BOOK TEMPLATE
AREAS CHECKED


ORIGINAL SURVEY PLOTTED
NOTE BOOK TEMPLATE
AREAS CHECKED

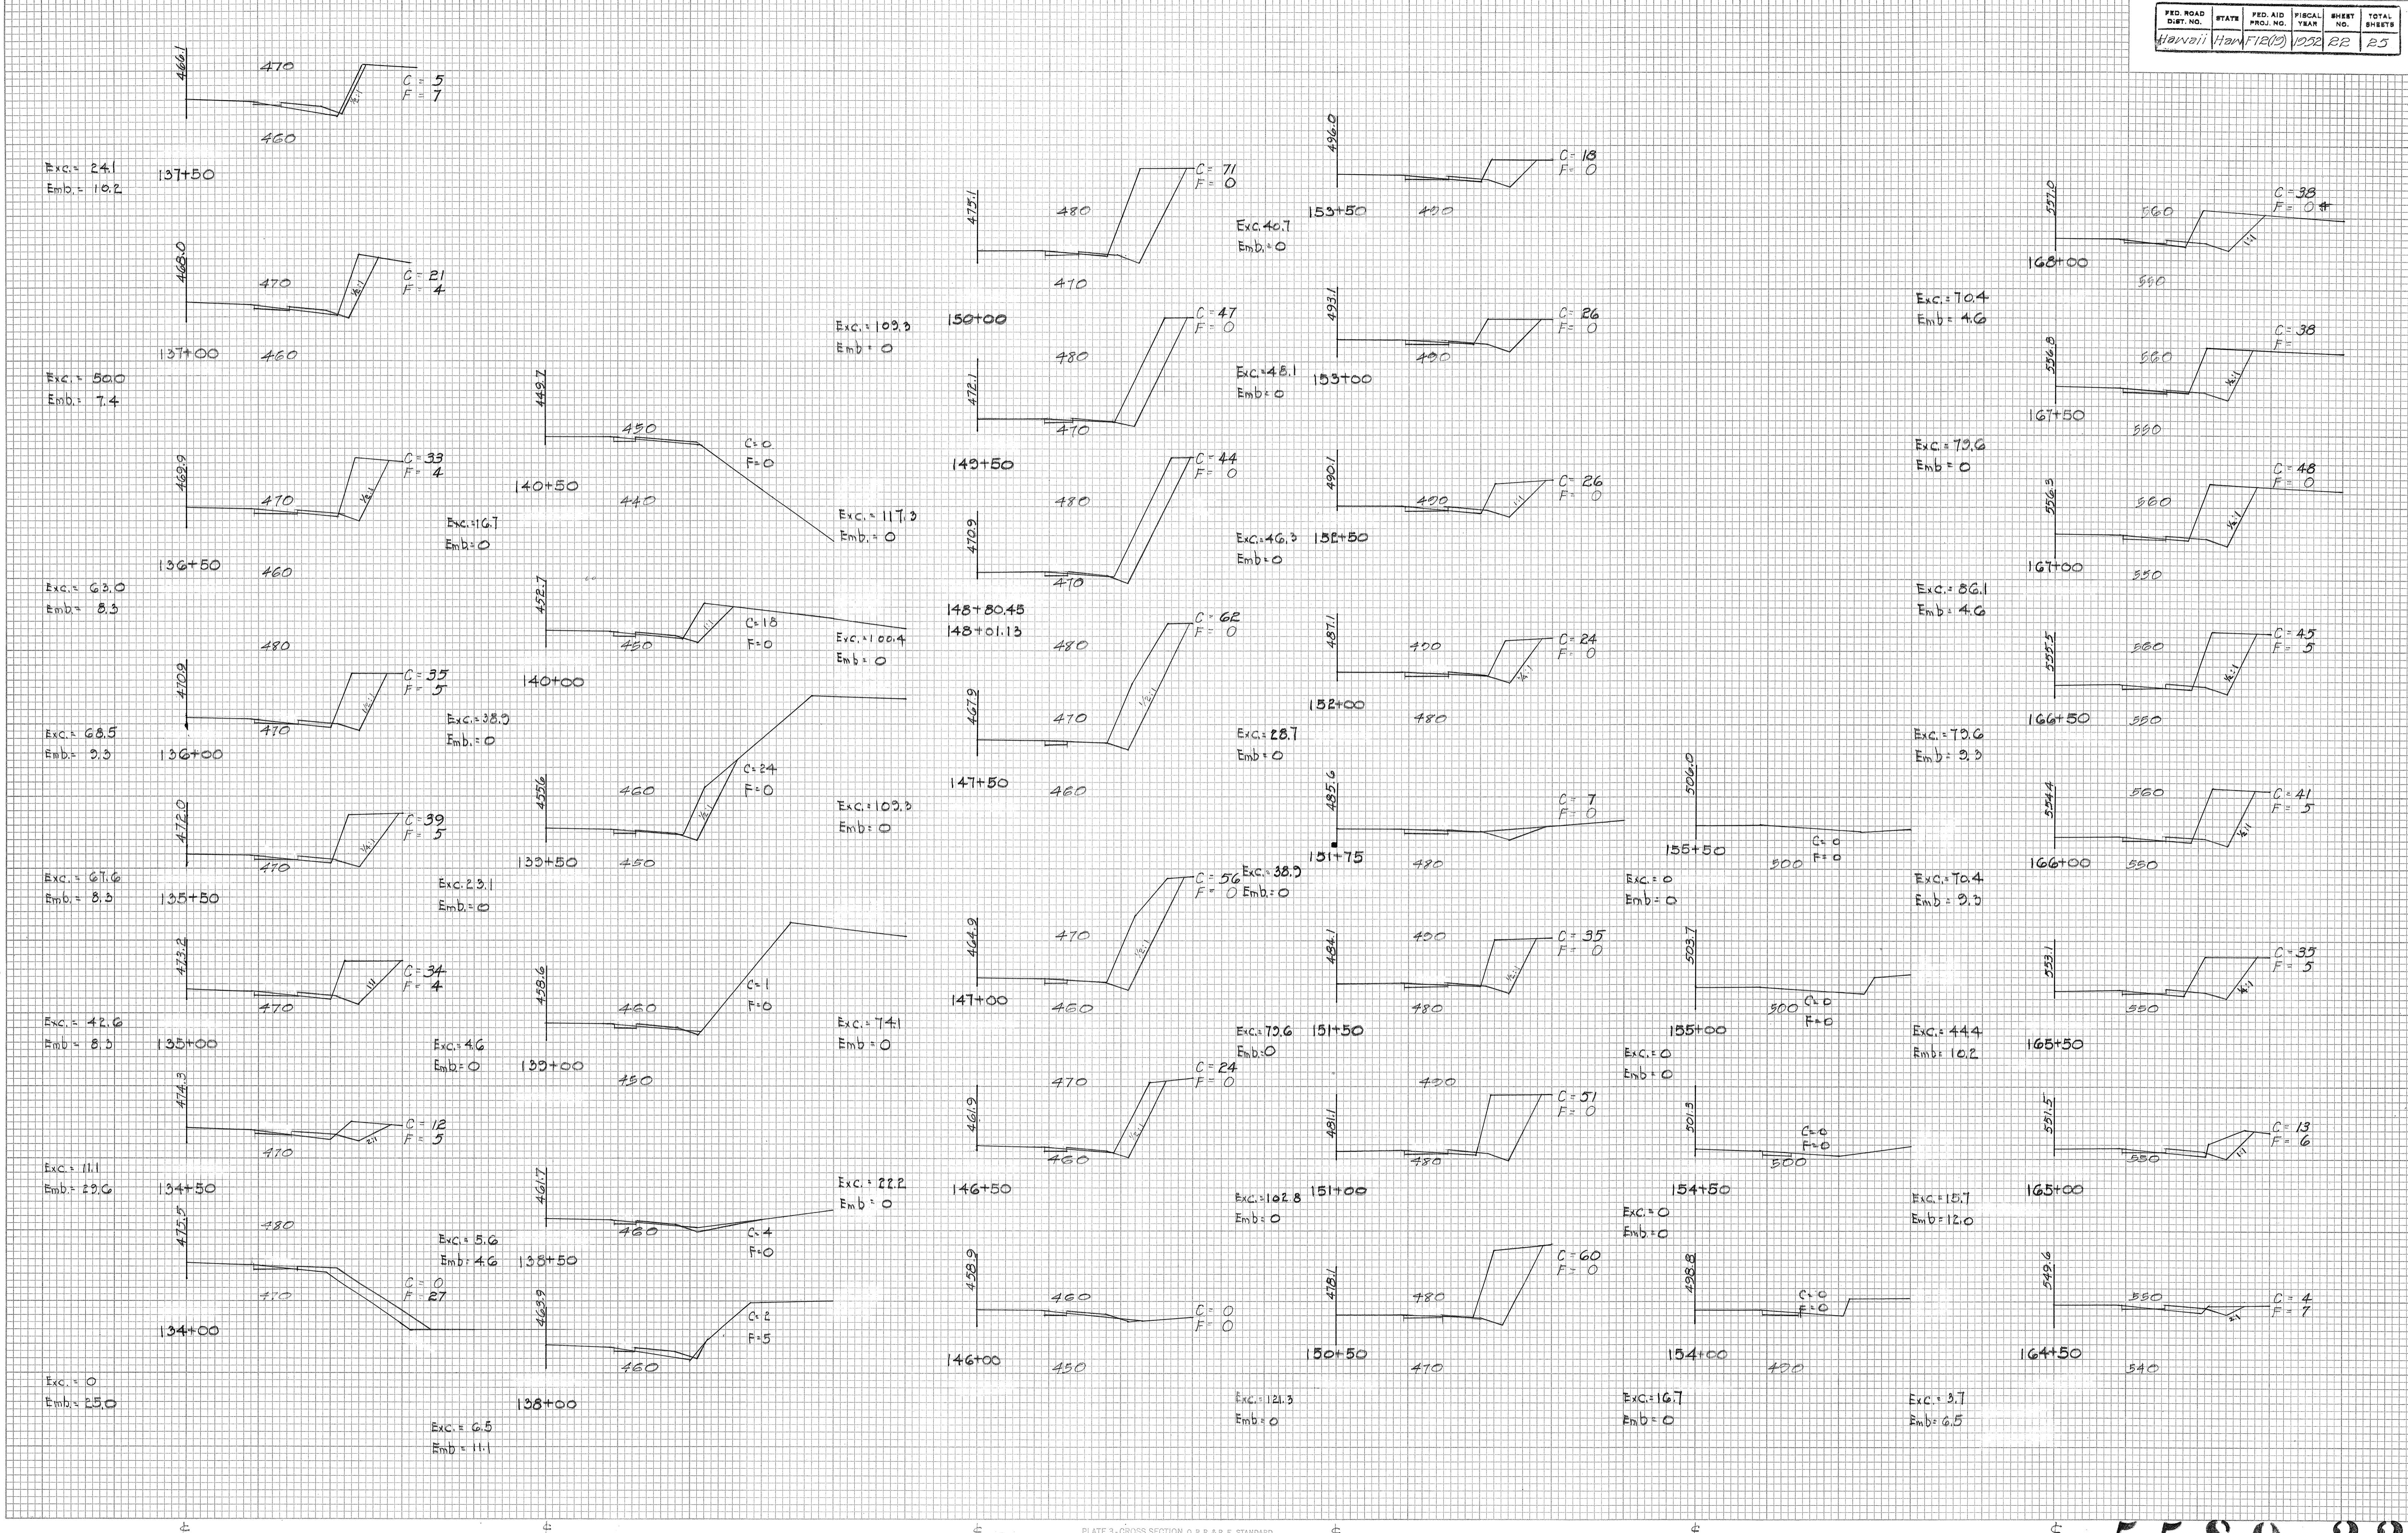

FED. ROAD DIST. NO.	STATE	FED. AID PROJ. NO.	FISCAL YEAR	SHEET NO.	TOTAL SHEETS
Hawaii	Han	F12(2)1952	23	25	

FINAL SURVEYED BY DATE
SURVEY PLOTTED
NOTE BOOK TIMELINE
AREAS CHECKED

ORIGINAL SURVEYED BY DATE
SURVEY PLOTTED
NOTE BOOK TIMELINE
AREAS CHECKED

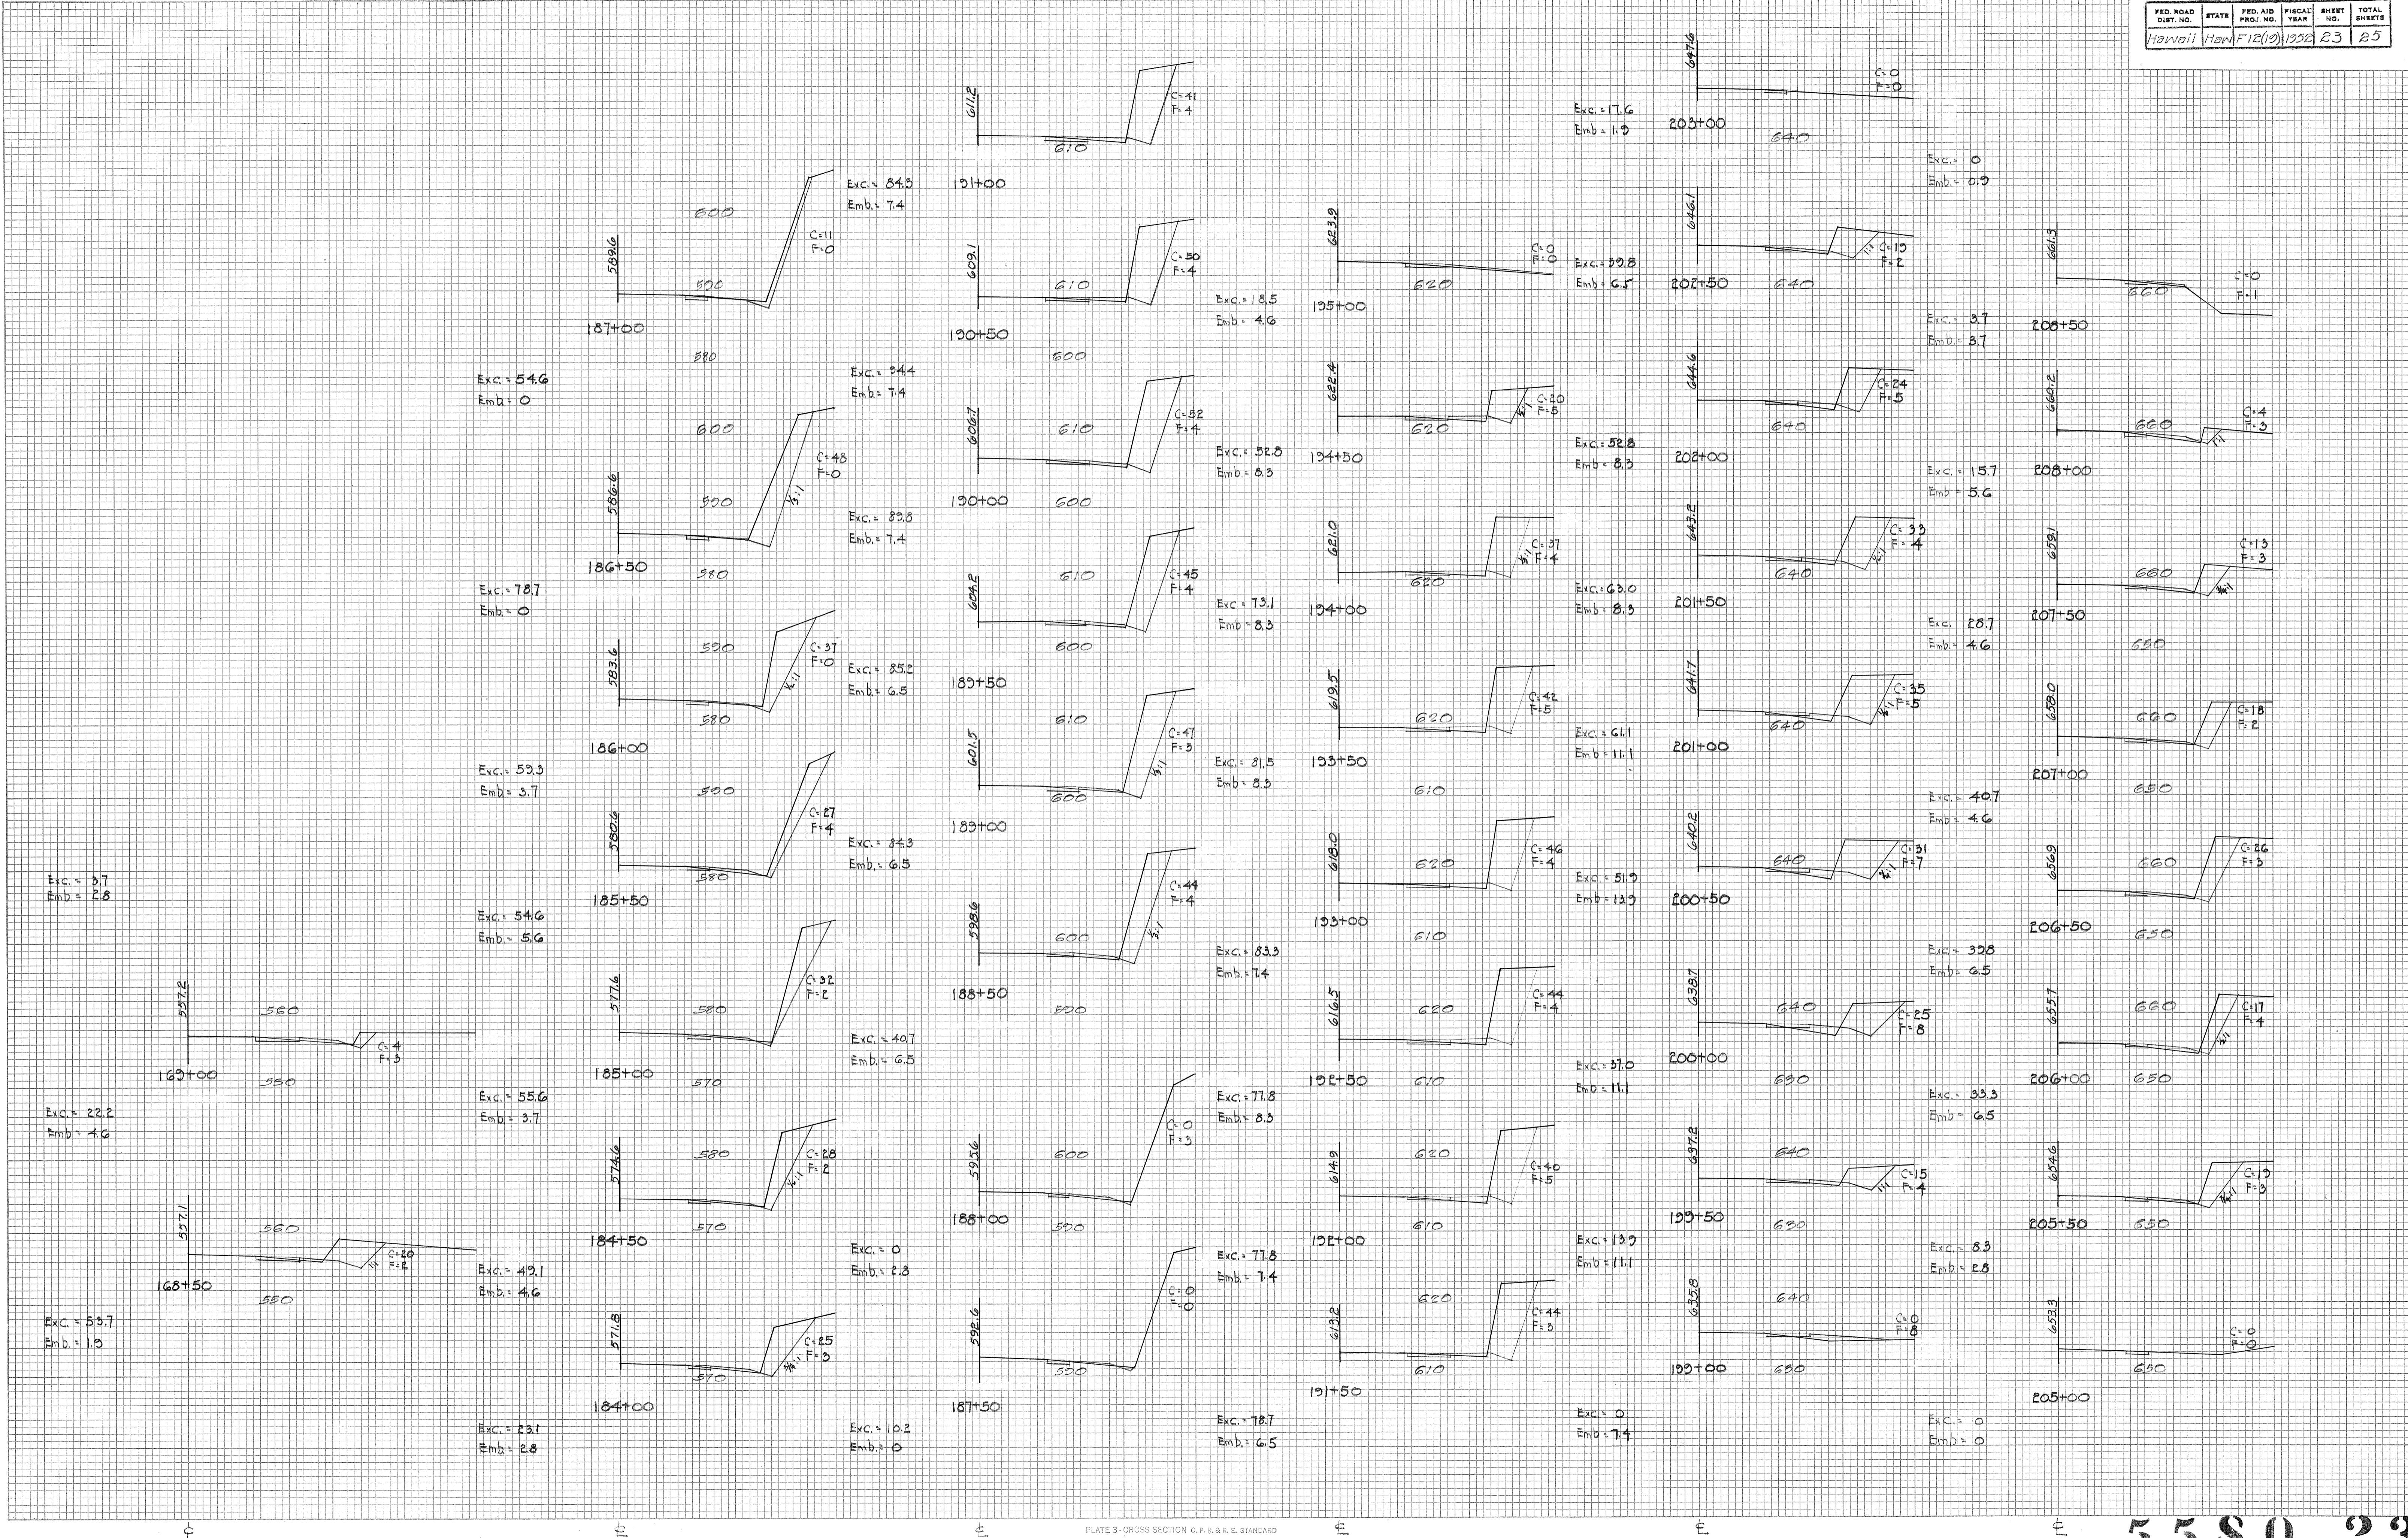

FED. ROAD DIST. NO.	STATE	FED. AID PROJ. NO.	FISCAL YEAR	SHRIFT NO.	TOTAL SHEETS
Hawaii	Hon	F12(9)	1958	24	25

ORIGINAL SURVEYED	SURVEYED
NO.	BY
SURVEY PLOTTED	
NOTE BOOK TEMPLATE	
AREAS CHECKED	

ORIGINAL SURVEYED	SURVEYED
NO.	BY
SURVEY PLOTTED	
NOTE BOOK TEMPLATE	
AREAS CHECKED	

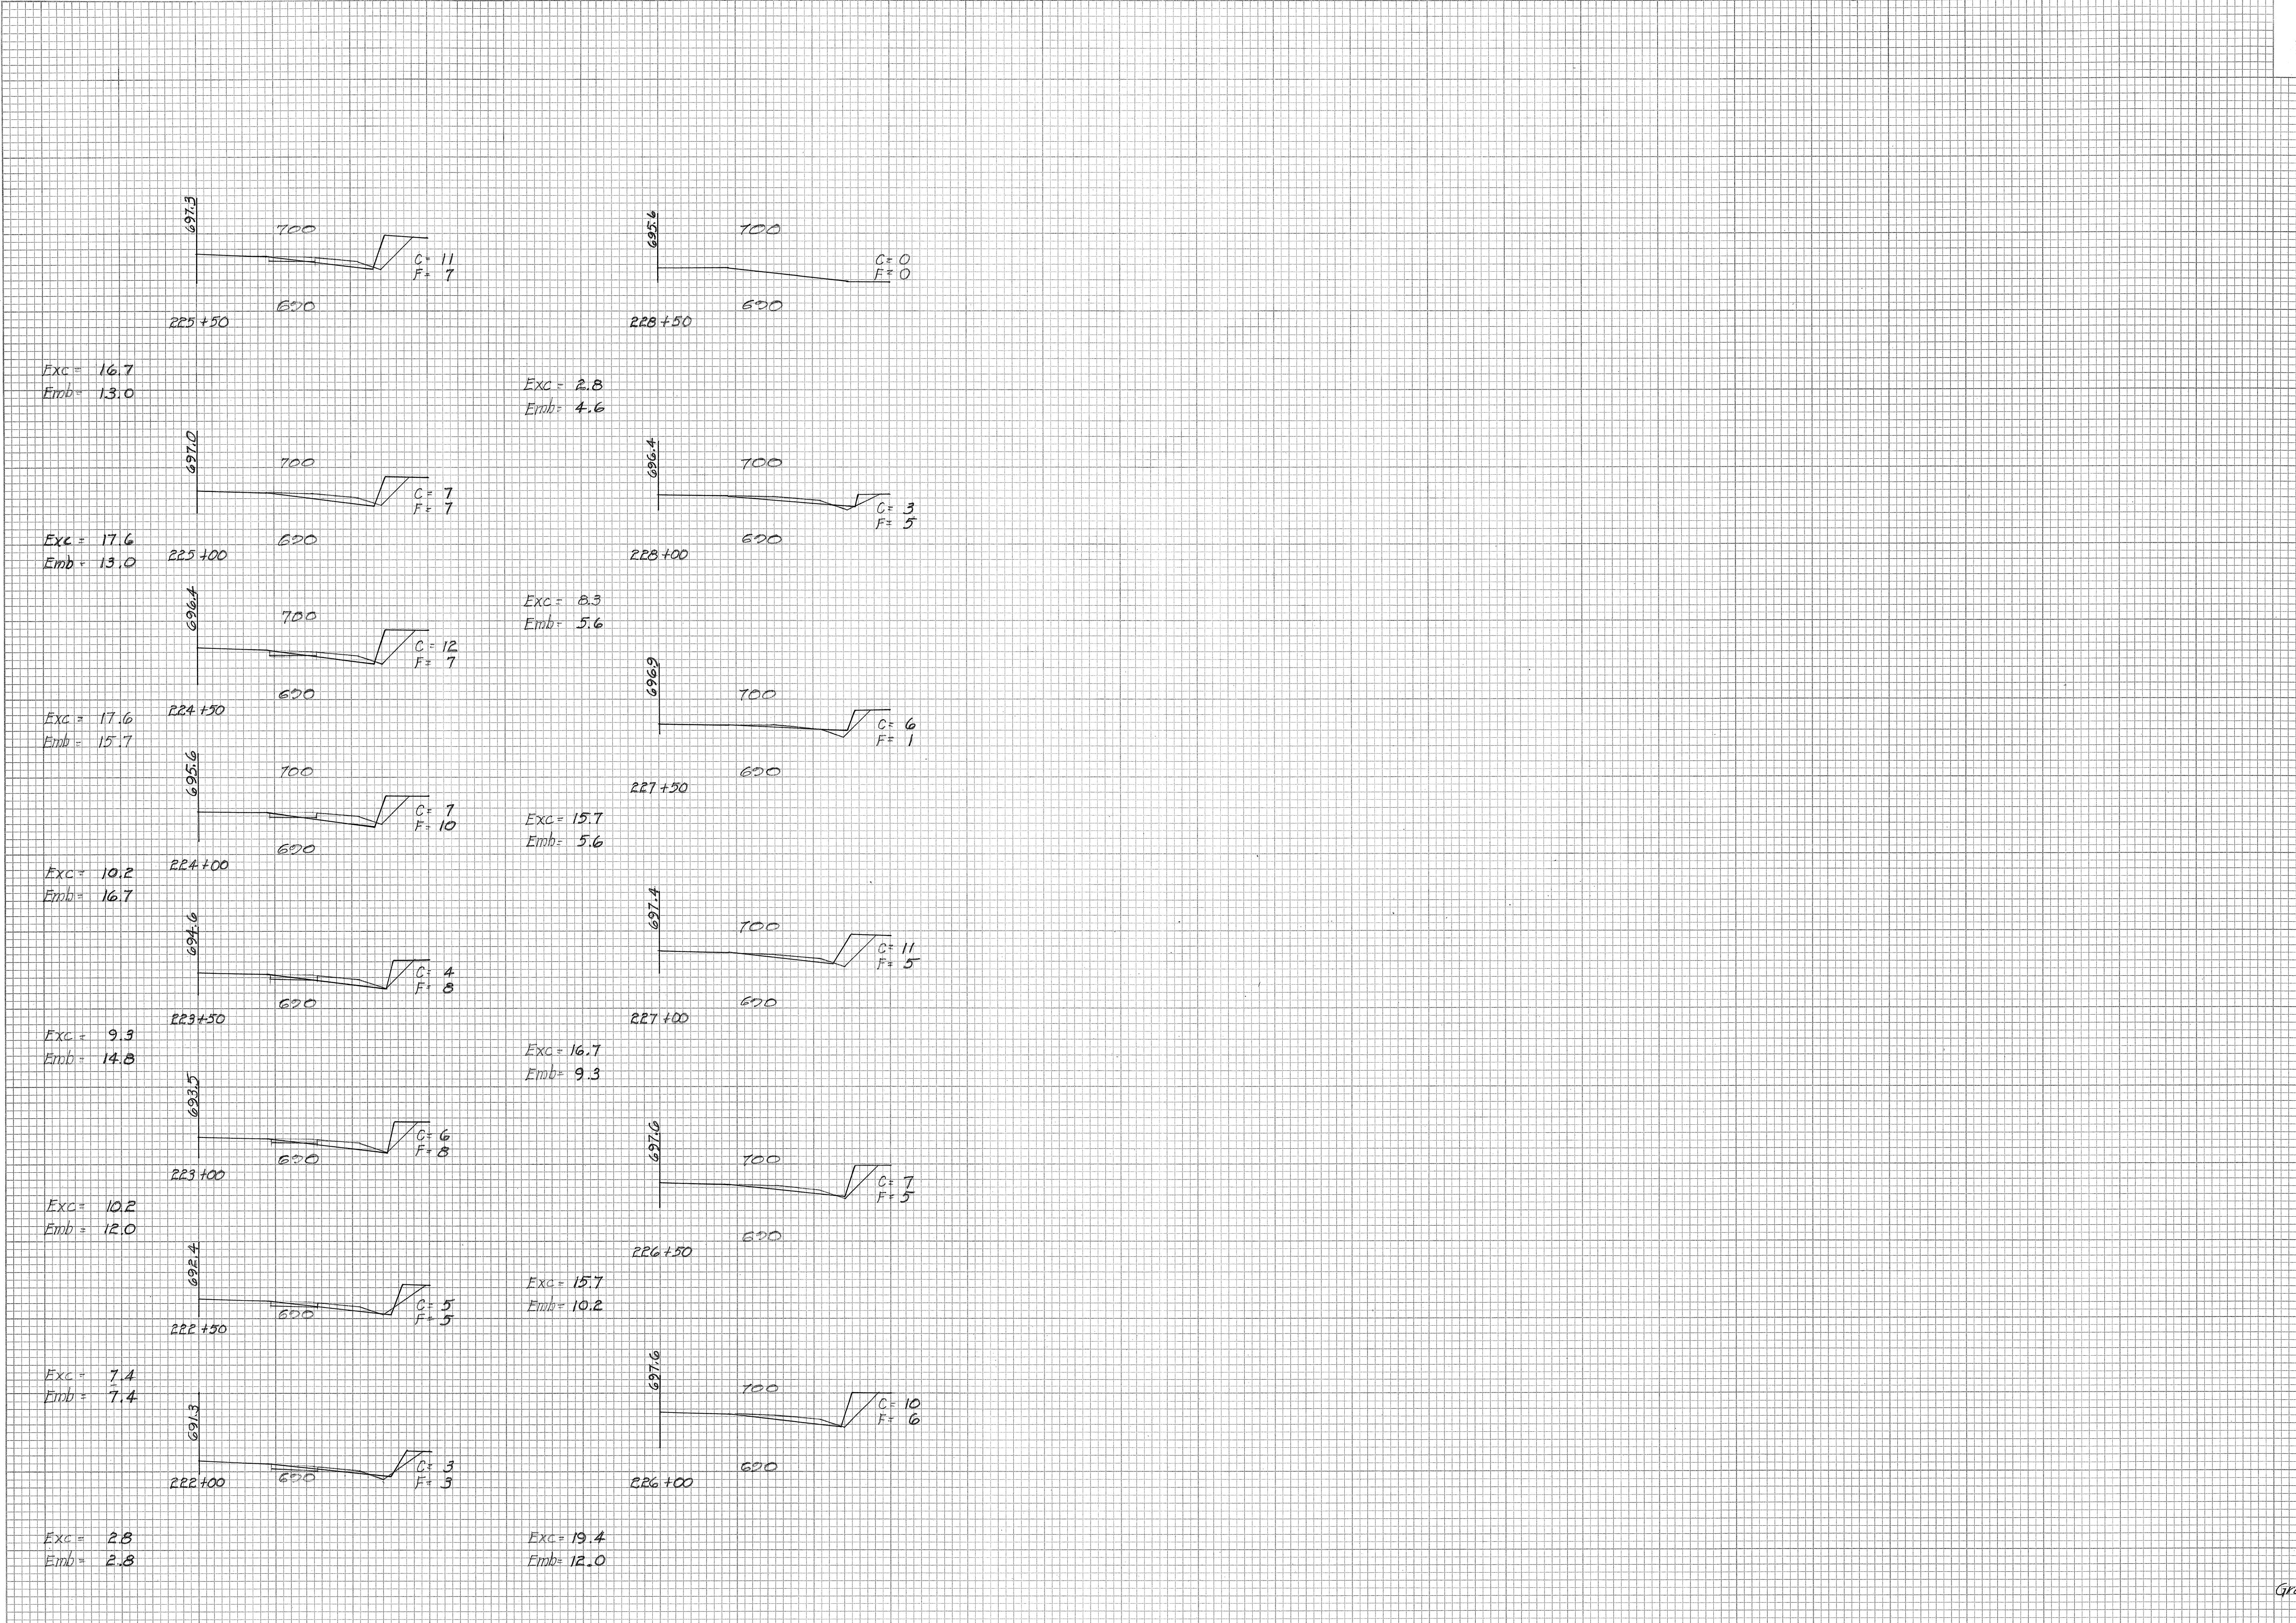


PLATE 3 - CROSS SECTION C. P. R. & R. E. STANDARD
KEUFFEL & ESSER CO., NEW YORK

K & E CO. NO. 345-3 MADE IN U.S.A. 28054

600
Grand Total
Exc = 19,411.5
Emb = 10,660.6

5580.24