
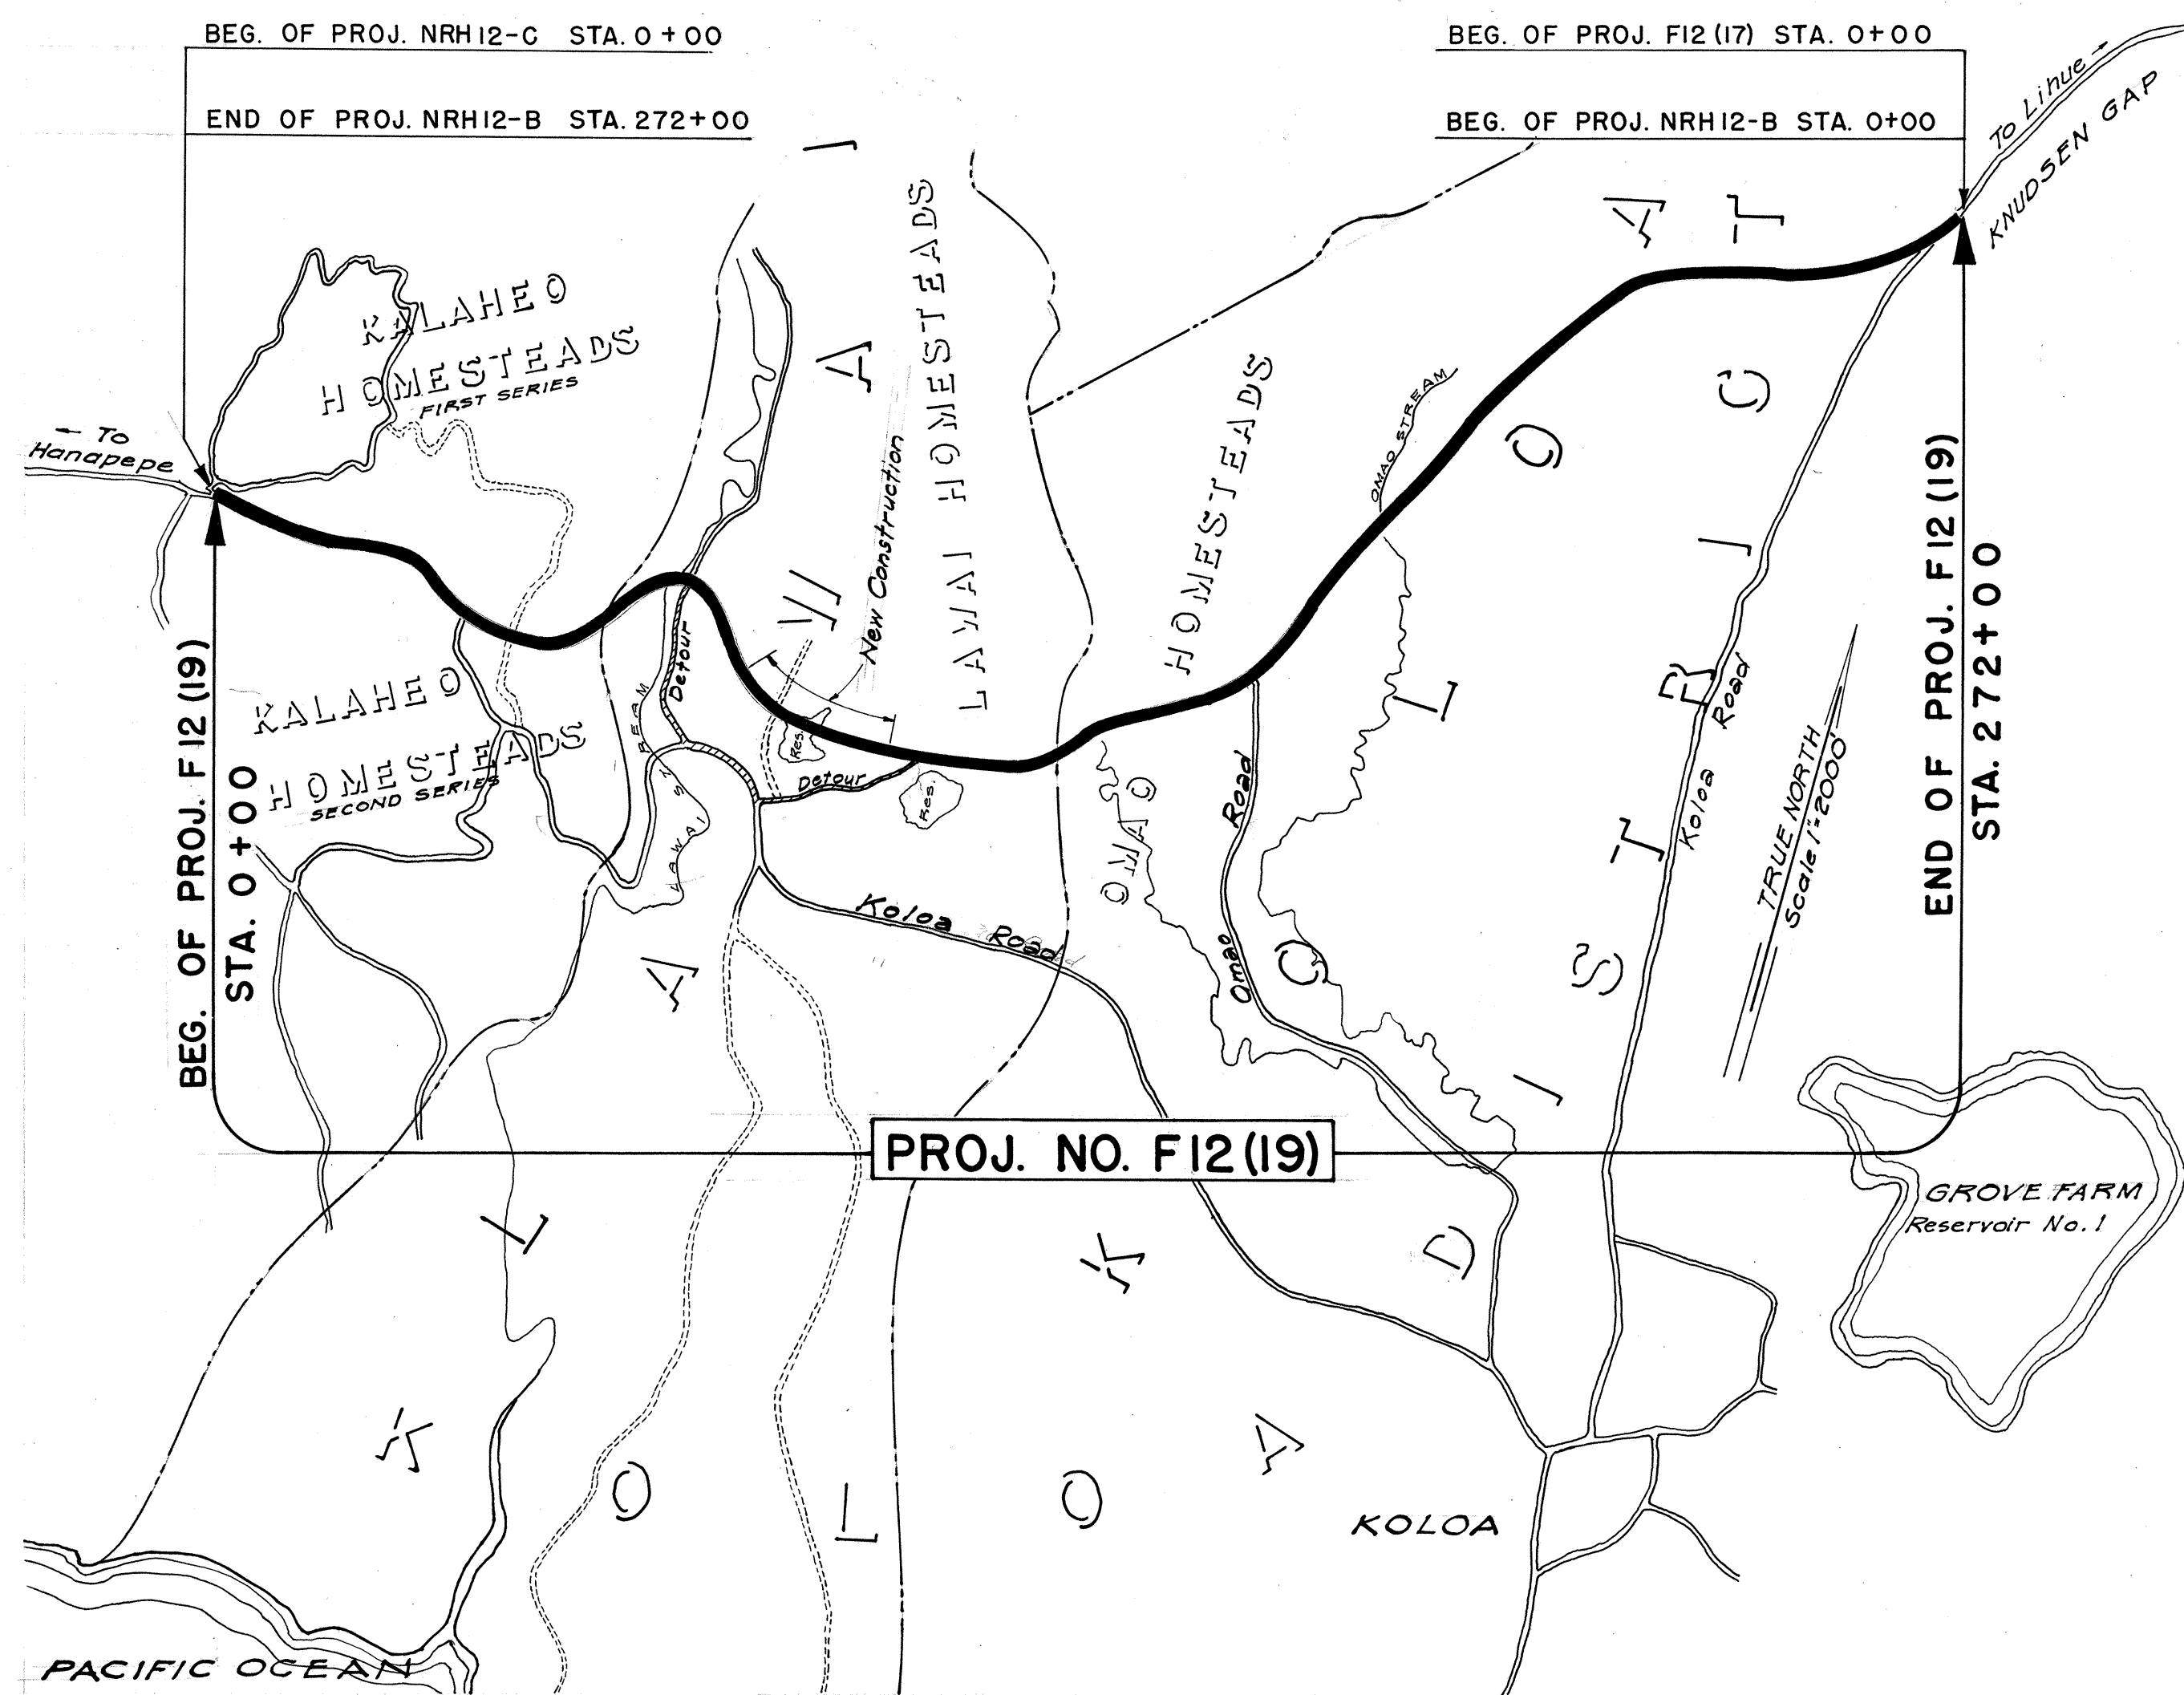


INDEX TO DRAWINGS	
SHEET NO.	DESCRIPTIONS
1	Title Sheet
2	Typical Section
3-11	Plan & Profile
12-13	Standard Details
14-24	Cross Sections
25	Culvert Details

FED. ROAD DIST. NO.	STATE	FED. AID PROJ. NO.	FISCAL YEAR	SHEET NO.	TOTAL SHEETS
HAWAII	HAW.	F12(19)	1952	1	25

TERRITORY OF HAWAII
TERRITORIAL HIGHWAY DEPARTMENT
HONOLULU T. H.
PLANS OF
WIDENING OF KAUAI BELT ROAD
FEDERAL AID PROJECT NO. F12 (19)
DISTRICT OF KOLOA
KAUAI, T. H.

SCALES
PLANS ----- 1 INCH = 100 FEET
PROFILE ----- HOR. ----- 1 INCH = 100 FEET
VERT. ----- 1 INCH = 20 FEET
CROSS SECTIONS ----- 1 INCH = 10 FEET

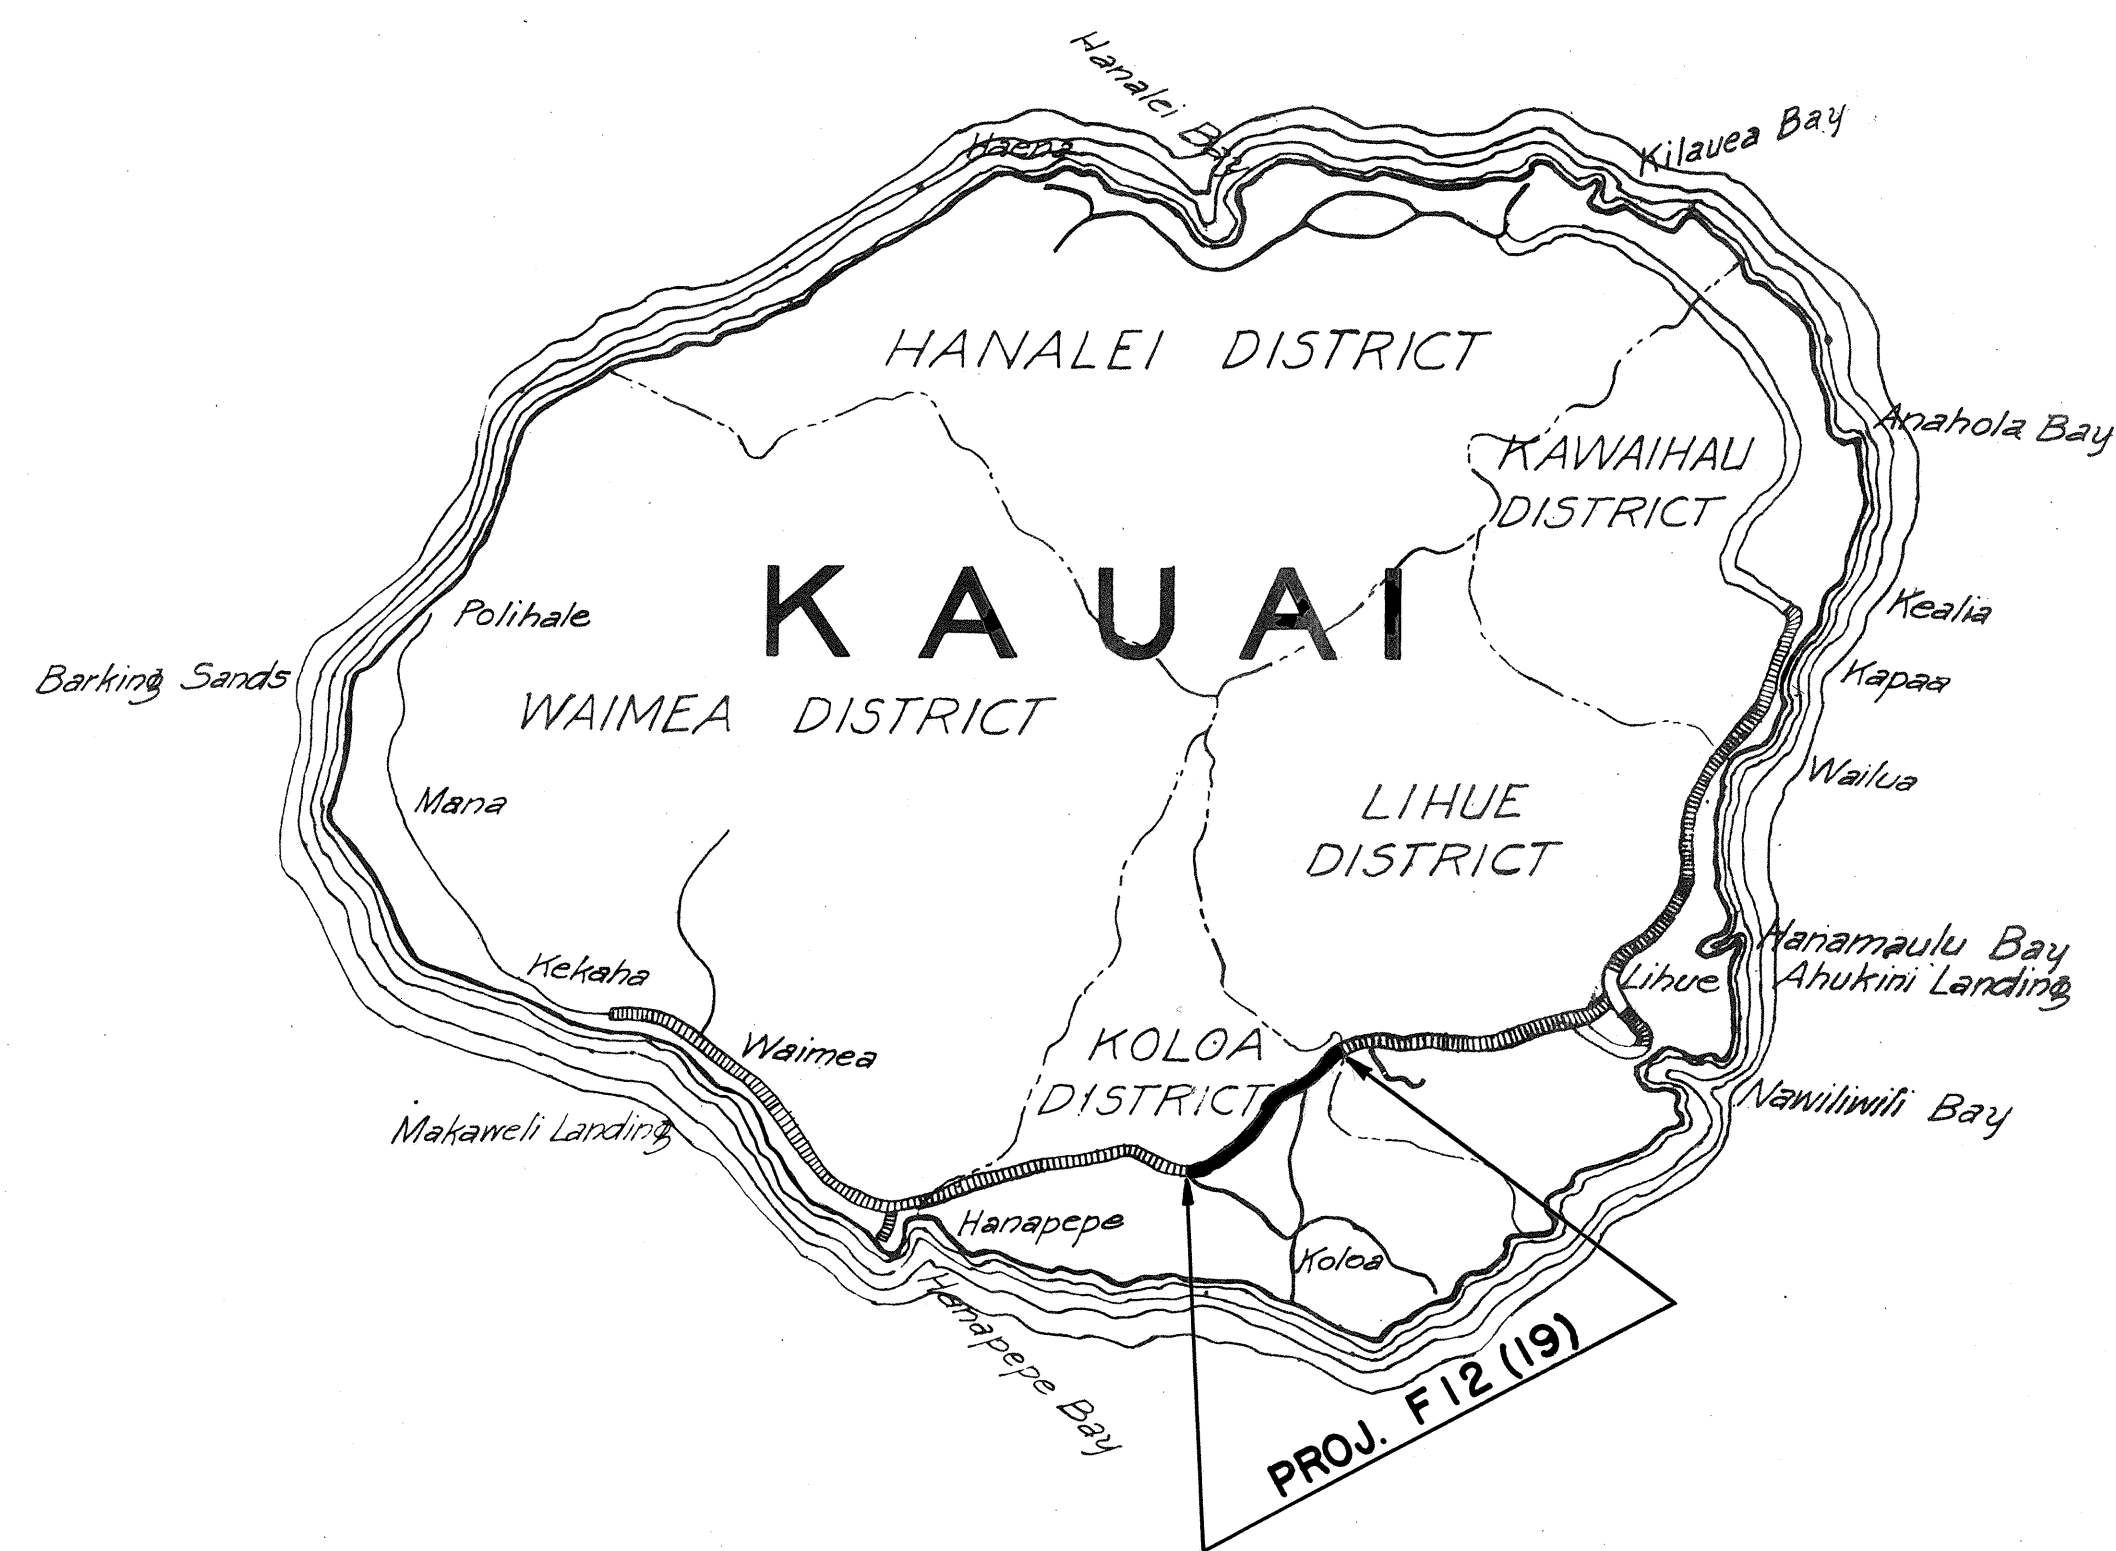

PROJ. NO. F12(19)

LAYOUT OF PROJECT
SCALE 1:24,000

Gross Length of Project 5.066 Miles
Bridges (over 20 ft.) Span 0.076 "
Net Length Roadway 4.990 "

NOTE!
Elevations are referred to B.M. No. 23
U.S.G.S. Bronze tablet, located on side-
walk of Jardins Cash & Carry Store.
Elevation 700.046 feet, which refers
to a datum of mean sea level.

CONVENTIONAL SIGNS	
Edge of existing road	-----
Existing Fence	- x - x - x -
Boundary Line (not fence)	- . - . - . -
Railroad	+++++
Centerline	-----
Future Pavement	=====
Existing Culvert	-----
Existing Bridges	-----

NOTE:
ALL CHANGES MADE DURING CONSTRUCTION HAVE
BEEN NOTED IN RED ON THESE TRACINGS AND
CHECKED BY:

[Signature]
RESIDENT ENGINEER
May 8, 1953
DATE

APPROVED: *[Signature]* DATE 4-2-52
TERRITORIAL HIGHWAY ENGINEER

DEPARTMENT OF COMMERCE BUREAU OF PUBLIC ROADS	
RECOMMENDED FOR APPROVAL:	
<i>[Signature]</i>	<i>[Signature]</i>
DISTRICT ENGINEER	DATE
APPROVED:	
<i>[Signature]</i>	<i>[Signature]</i>
DIVISION ENGINEER	DATE