
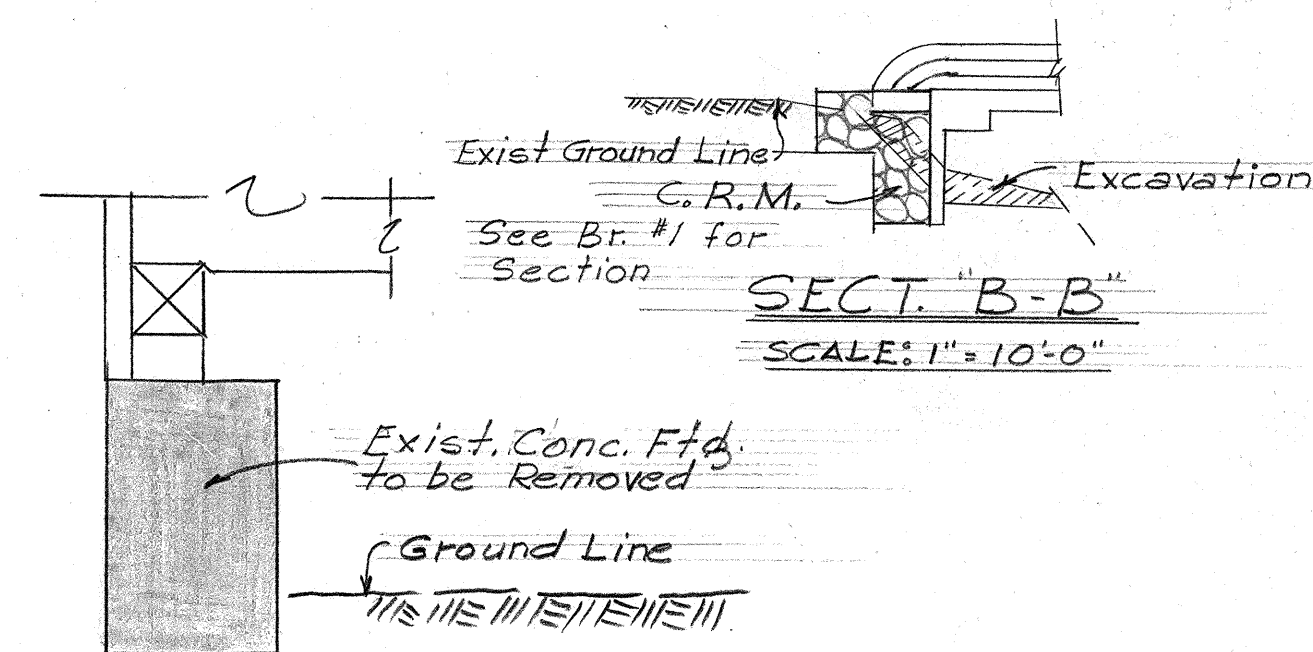
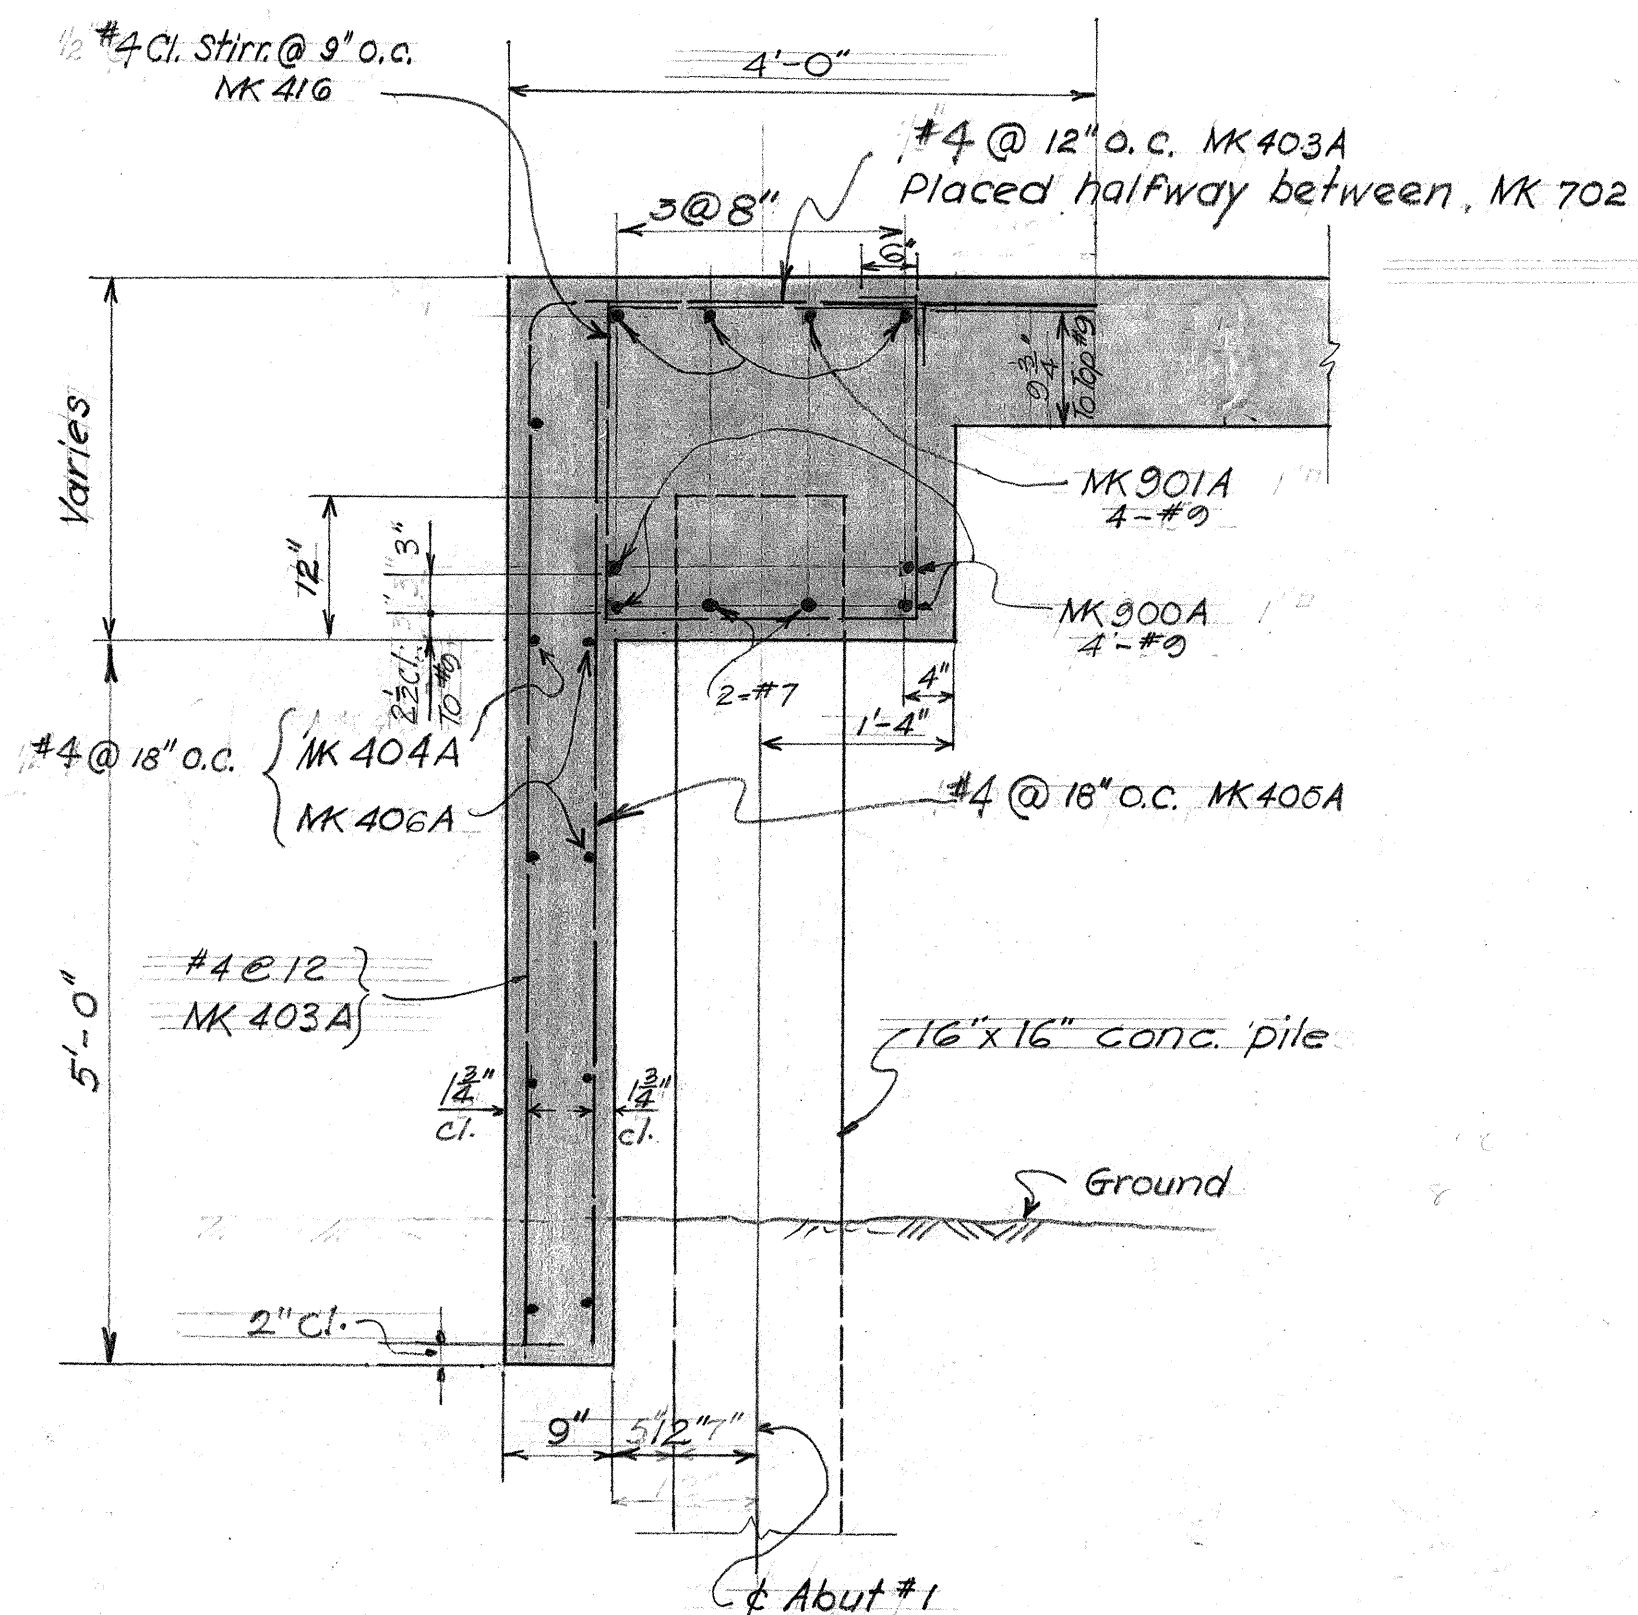


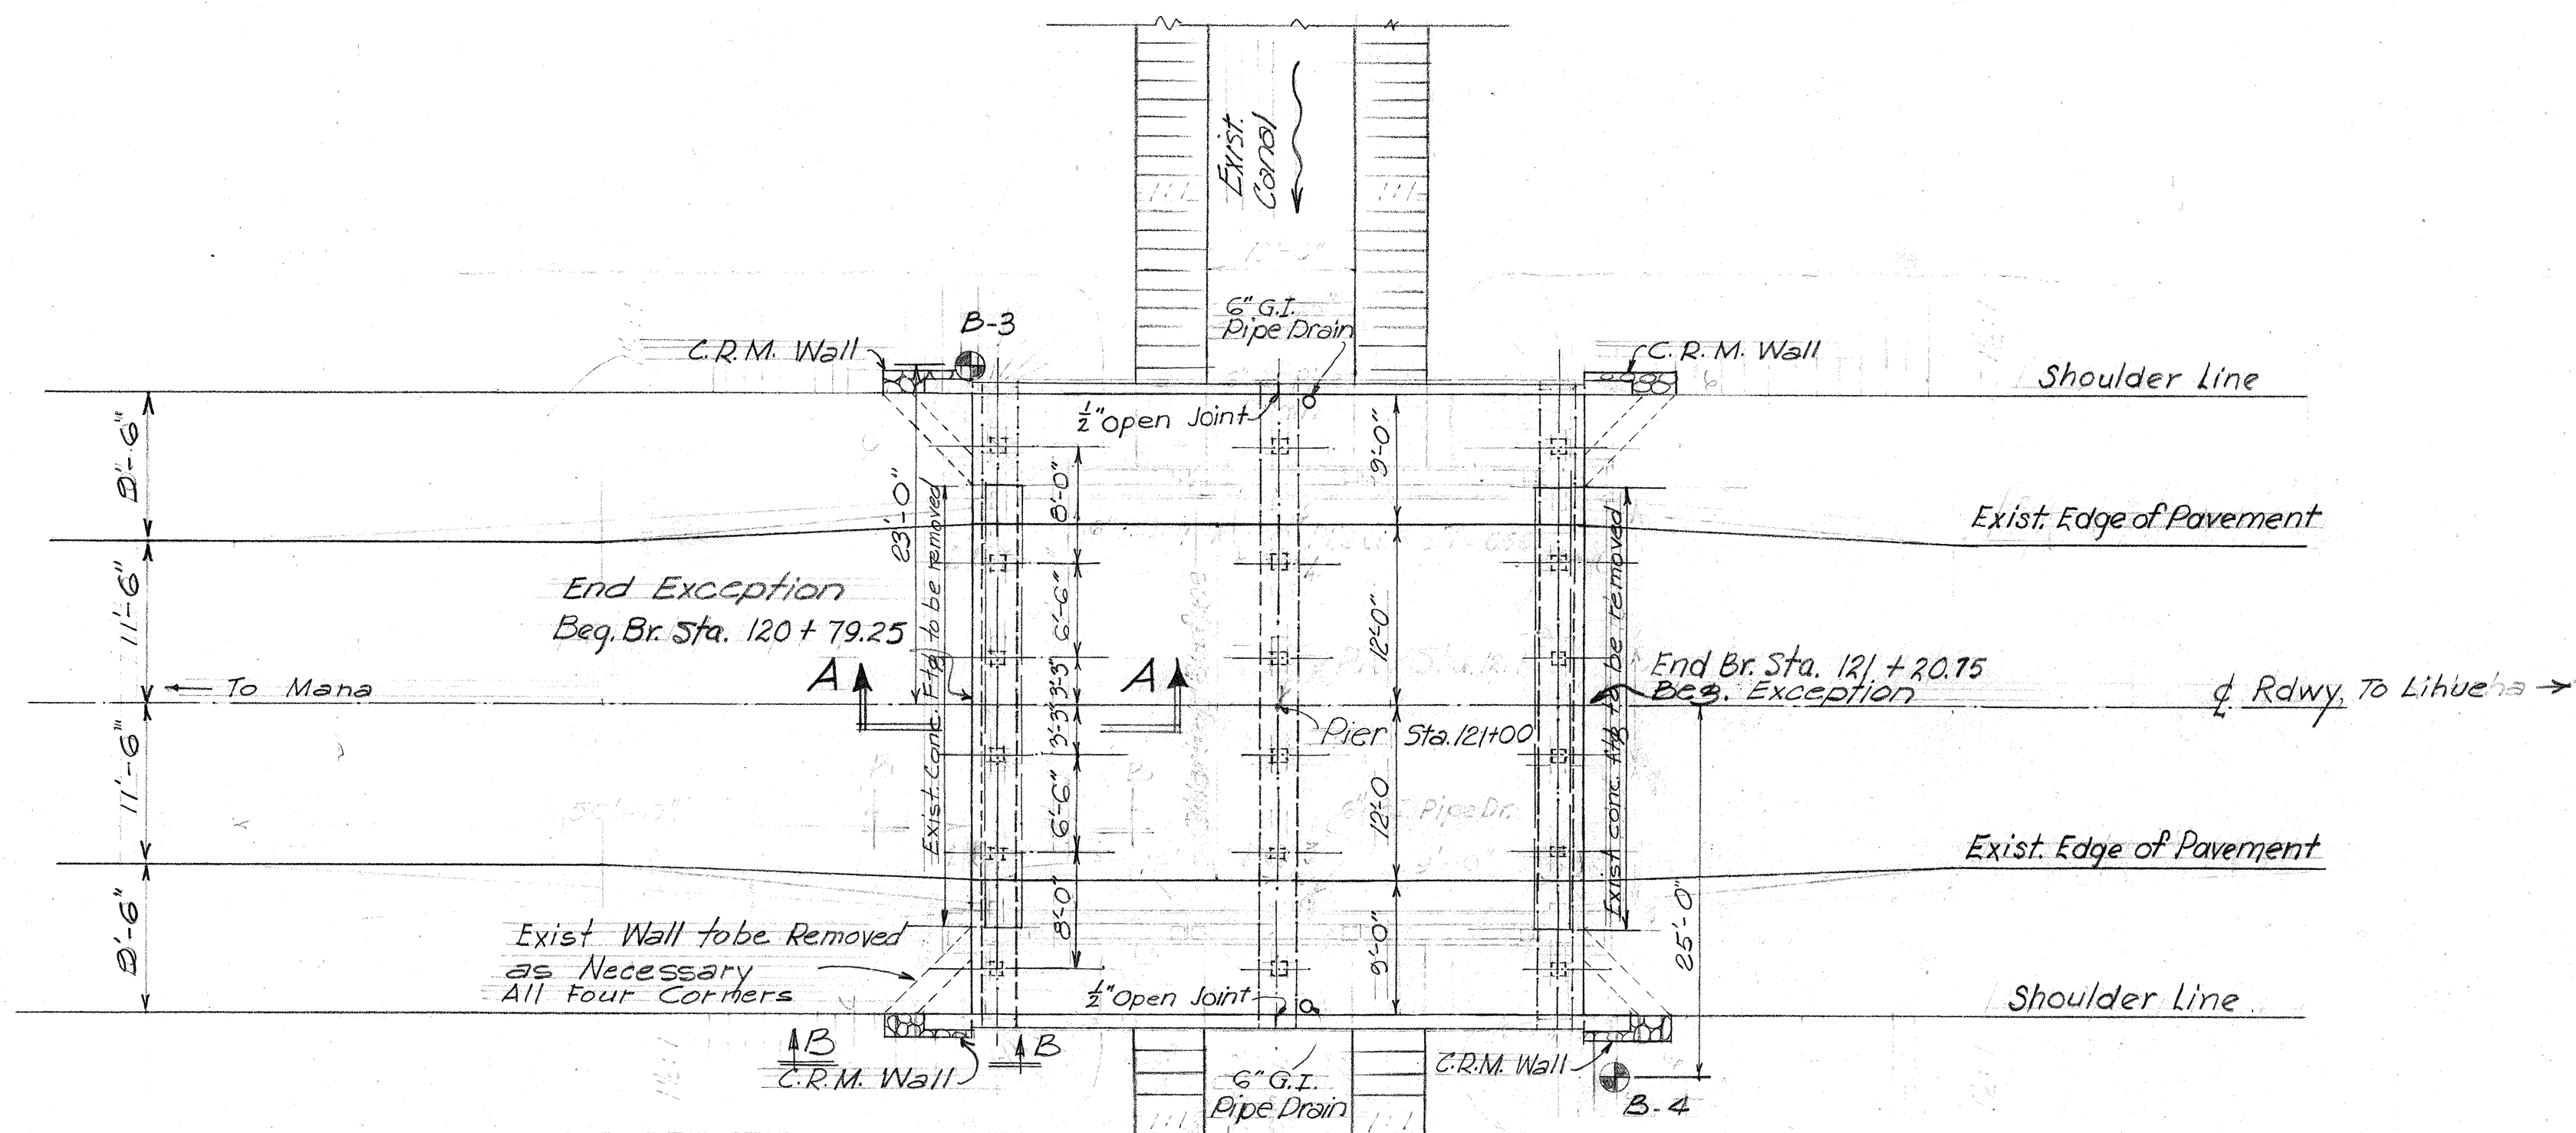


LAYOUT PLAN
Scale: 1" = 10'-0"


NOTE: See Br. No. 1 for General Notes and Slab Reinforcing.
See Br. No. 1 for Normal Section, Pier, Abut., railing details, and railing reinforcing.

SECTION A-A
Scale: 3/4" = 1'-0"

NOTE: Refer to Abut. #1 of Br. No. 1 for details on Abut. cap reinf.

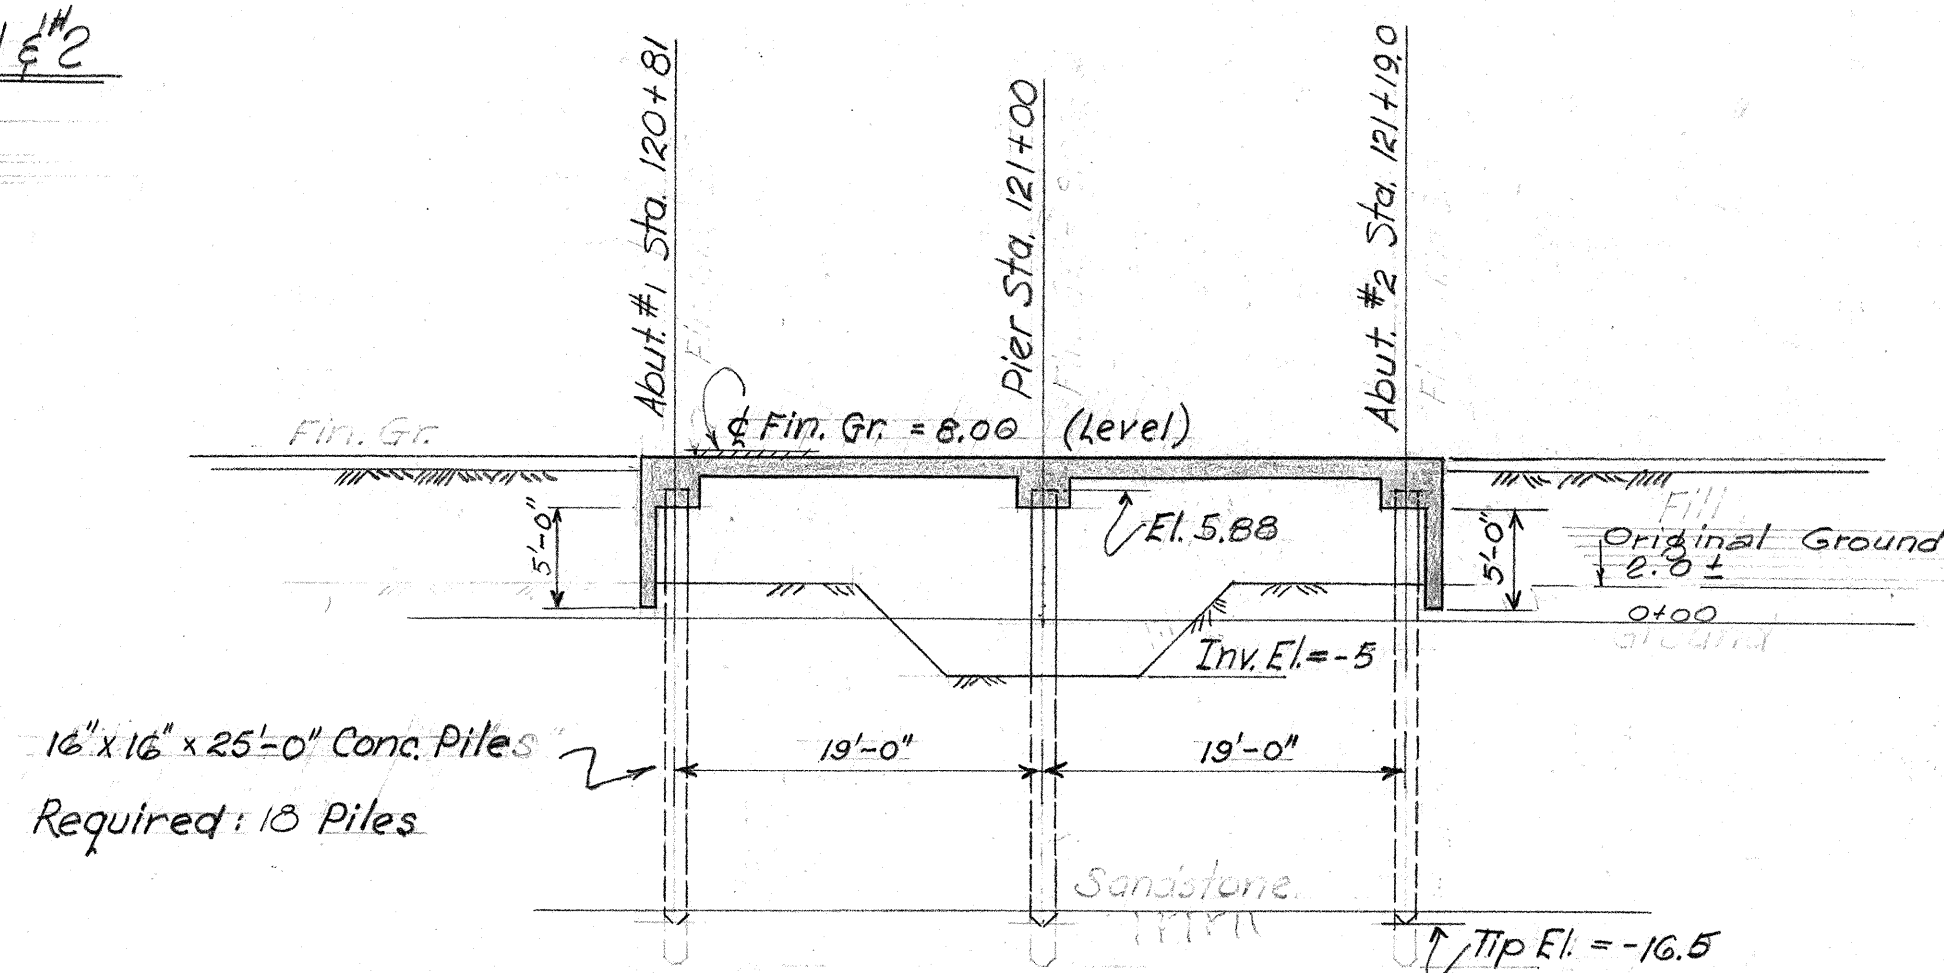

LONG. SECTION @ 1/2 RD.
Scale: 1" = 10'-0"

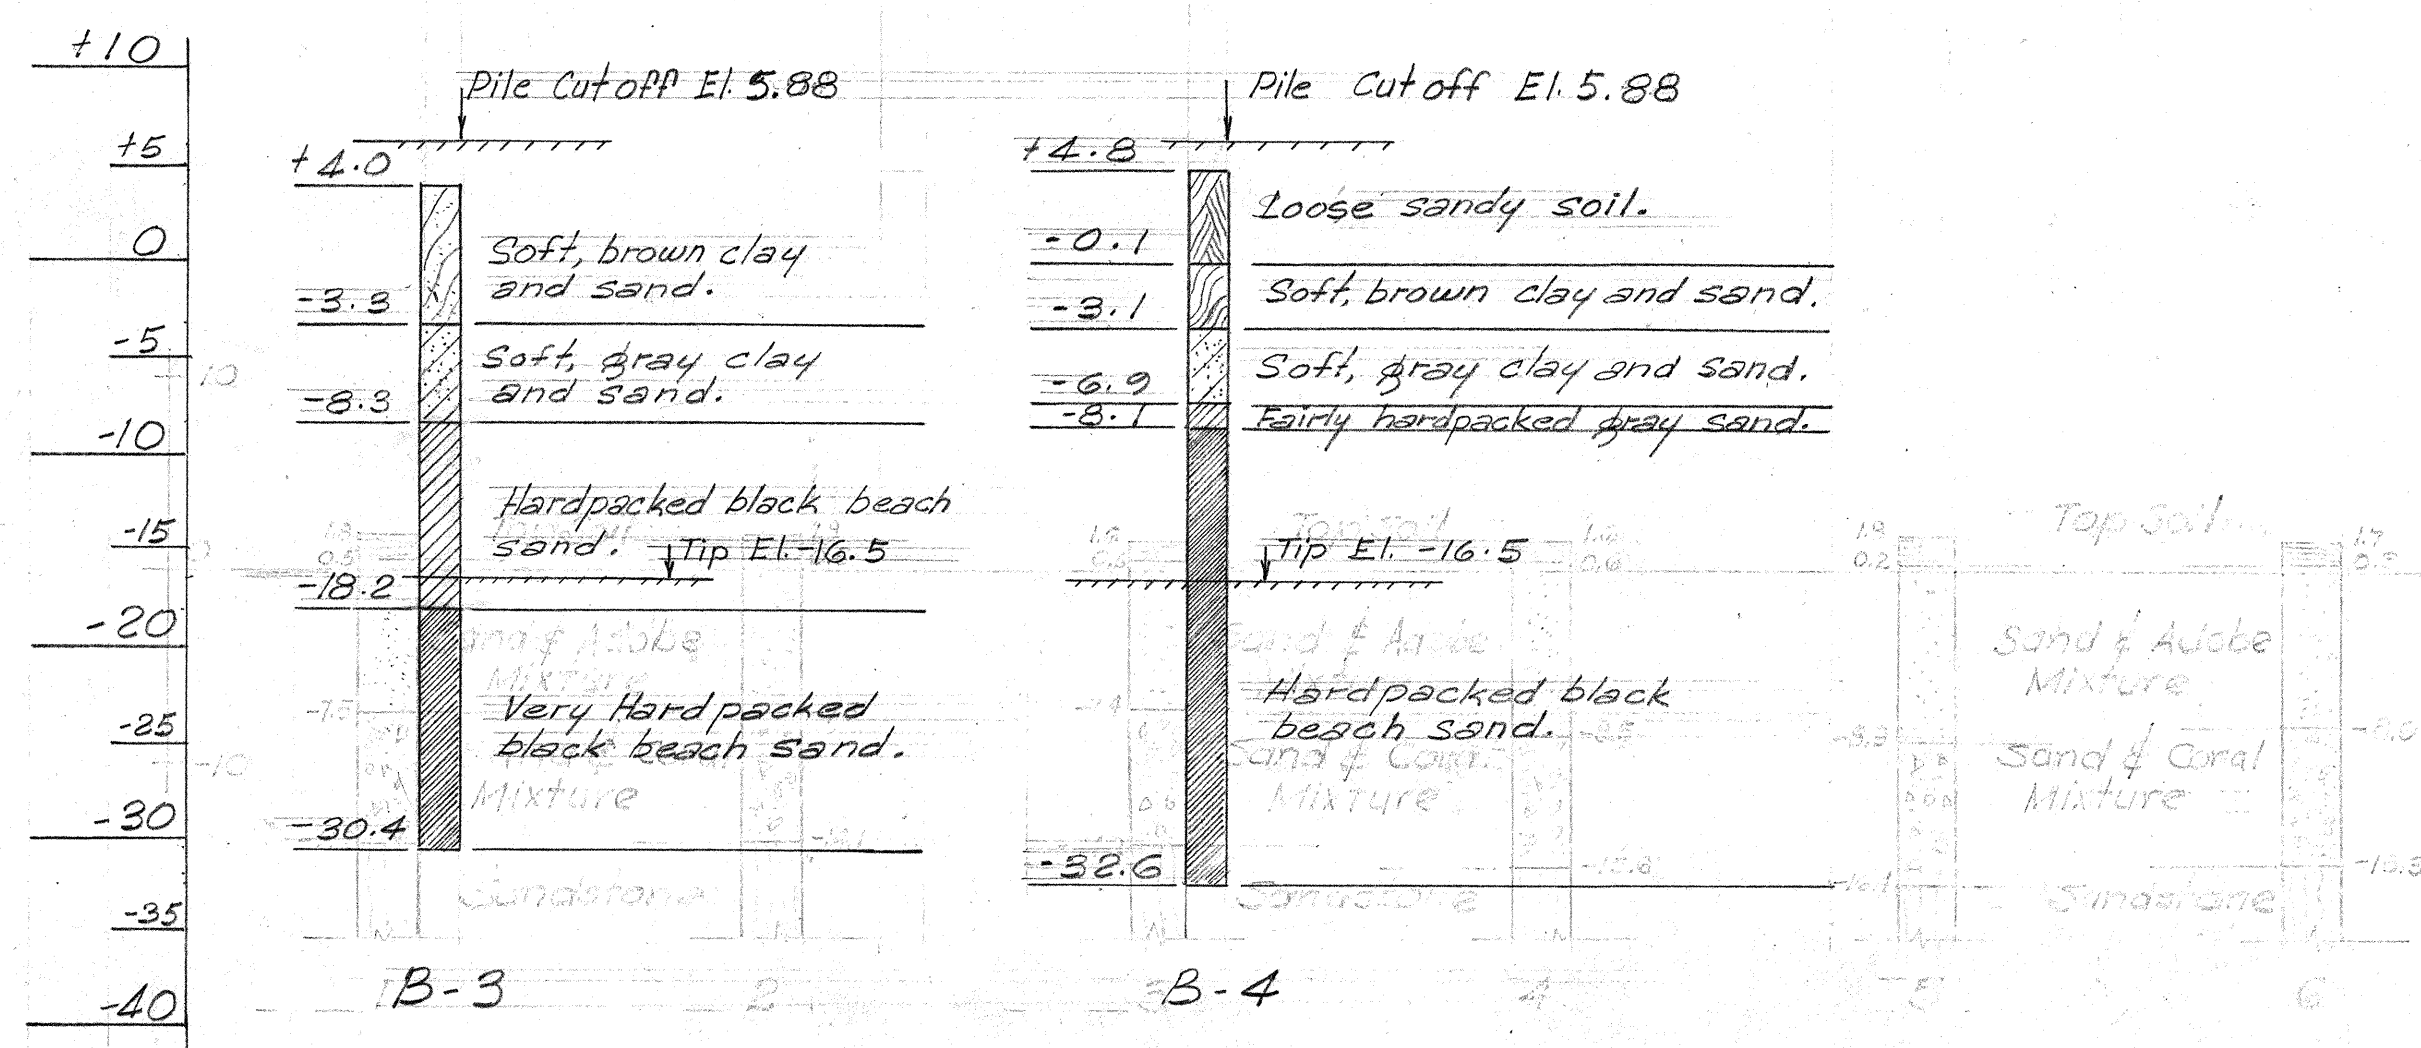

BORING DATA
Vert. Scale: 1" = 10'-0" Vertical

ESTIMATED QUANTITIES	
Class A-1 Concrete	Lump Sum
Reinforcing Steel	Lump Sum
Structure Excavation	62.4 CY
16" x 16" x 25'-0" Conc. Piles	450 (110 ft.)
C.R.M.	14.5 Tons
A.C. Pavement	10 Tons
Bituminous Tack Coat	27 gals.

TERRITORIAL HIGHWAY DEPARTMENT
TERRITORY OF HAWAII
BRIDGE No. 2
Sta. 120+79.25 - 121+20.75
PROPOSAL "A"
KAUAI BELT ROAD F-050-10
April 1966