


INDEX TO DRAWINGS	
SHEET NO.	DESCRIPTIONS
1	TITLE SHEET
2	48" & 54" REINF. CONC. CULV'T. PIPES
3-5	BRIDGE NO. 1 STA. 98+19.25 - STA. 98+60.75
6	BRIDGE NO. 2 STA. 120+79.25 - STA. 121+20.75
7-8	BRIDGE NO. 3 STA. 309+48.47 - STA. 309+81.54
9-11	BRIDGE NO. 4 STA. 327+73.25 - STA. 328+41.75
12	48" METAL PIPE CULVERT
13	MULTI-PLATE PIPE ARCHES STA. 98+40 - STA. 121+00
14	MULTI-PLATE PIPE ARCHES STA. 327+93
15	CORR. METAL PIPE CULV'TS. STA. 401+00, STA. 440+55
16	54" METAL PIPE CULV'T. STA. 476+51

TERRITORY OF HAWAII
 TERRITORIAL HIGHWAY DEPARTMENT
 HONOLULU T. H.
 PLANS OF
KAUAI BELT ROAD
 (REPLACEMENT OF STRUCTURES, MANA — KEKAHA SECTION)
 FEDERAL AID PROJECT NO. F 050-I(I)
 DISTRICT OF WAIMEA
 ISLAND OF KAUAI

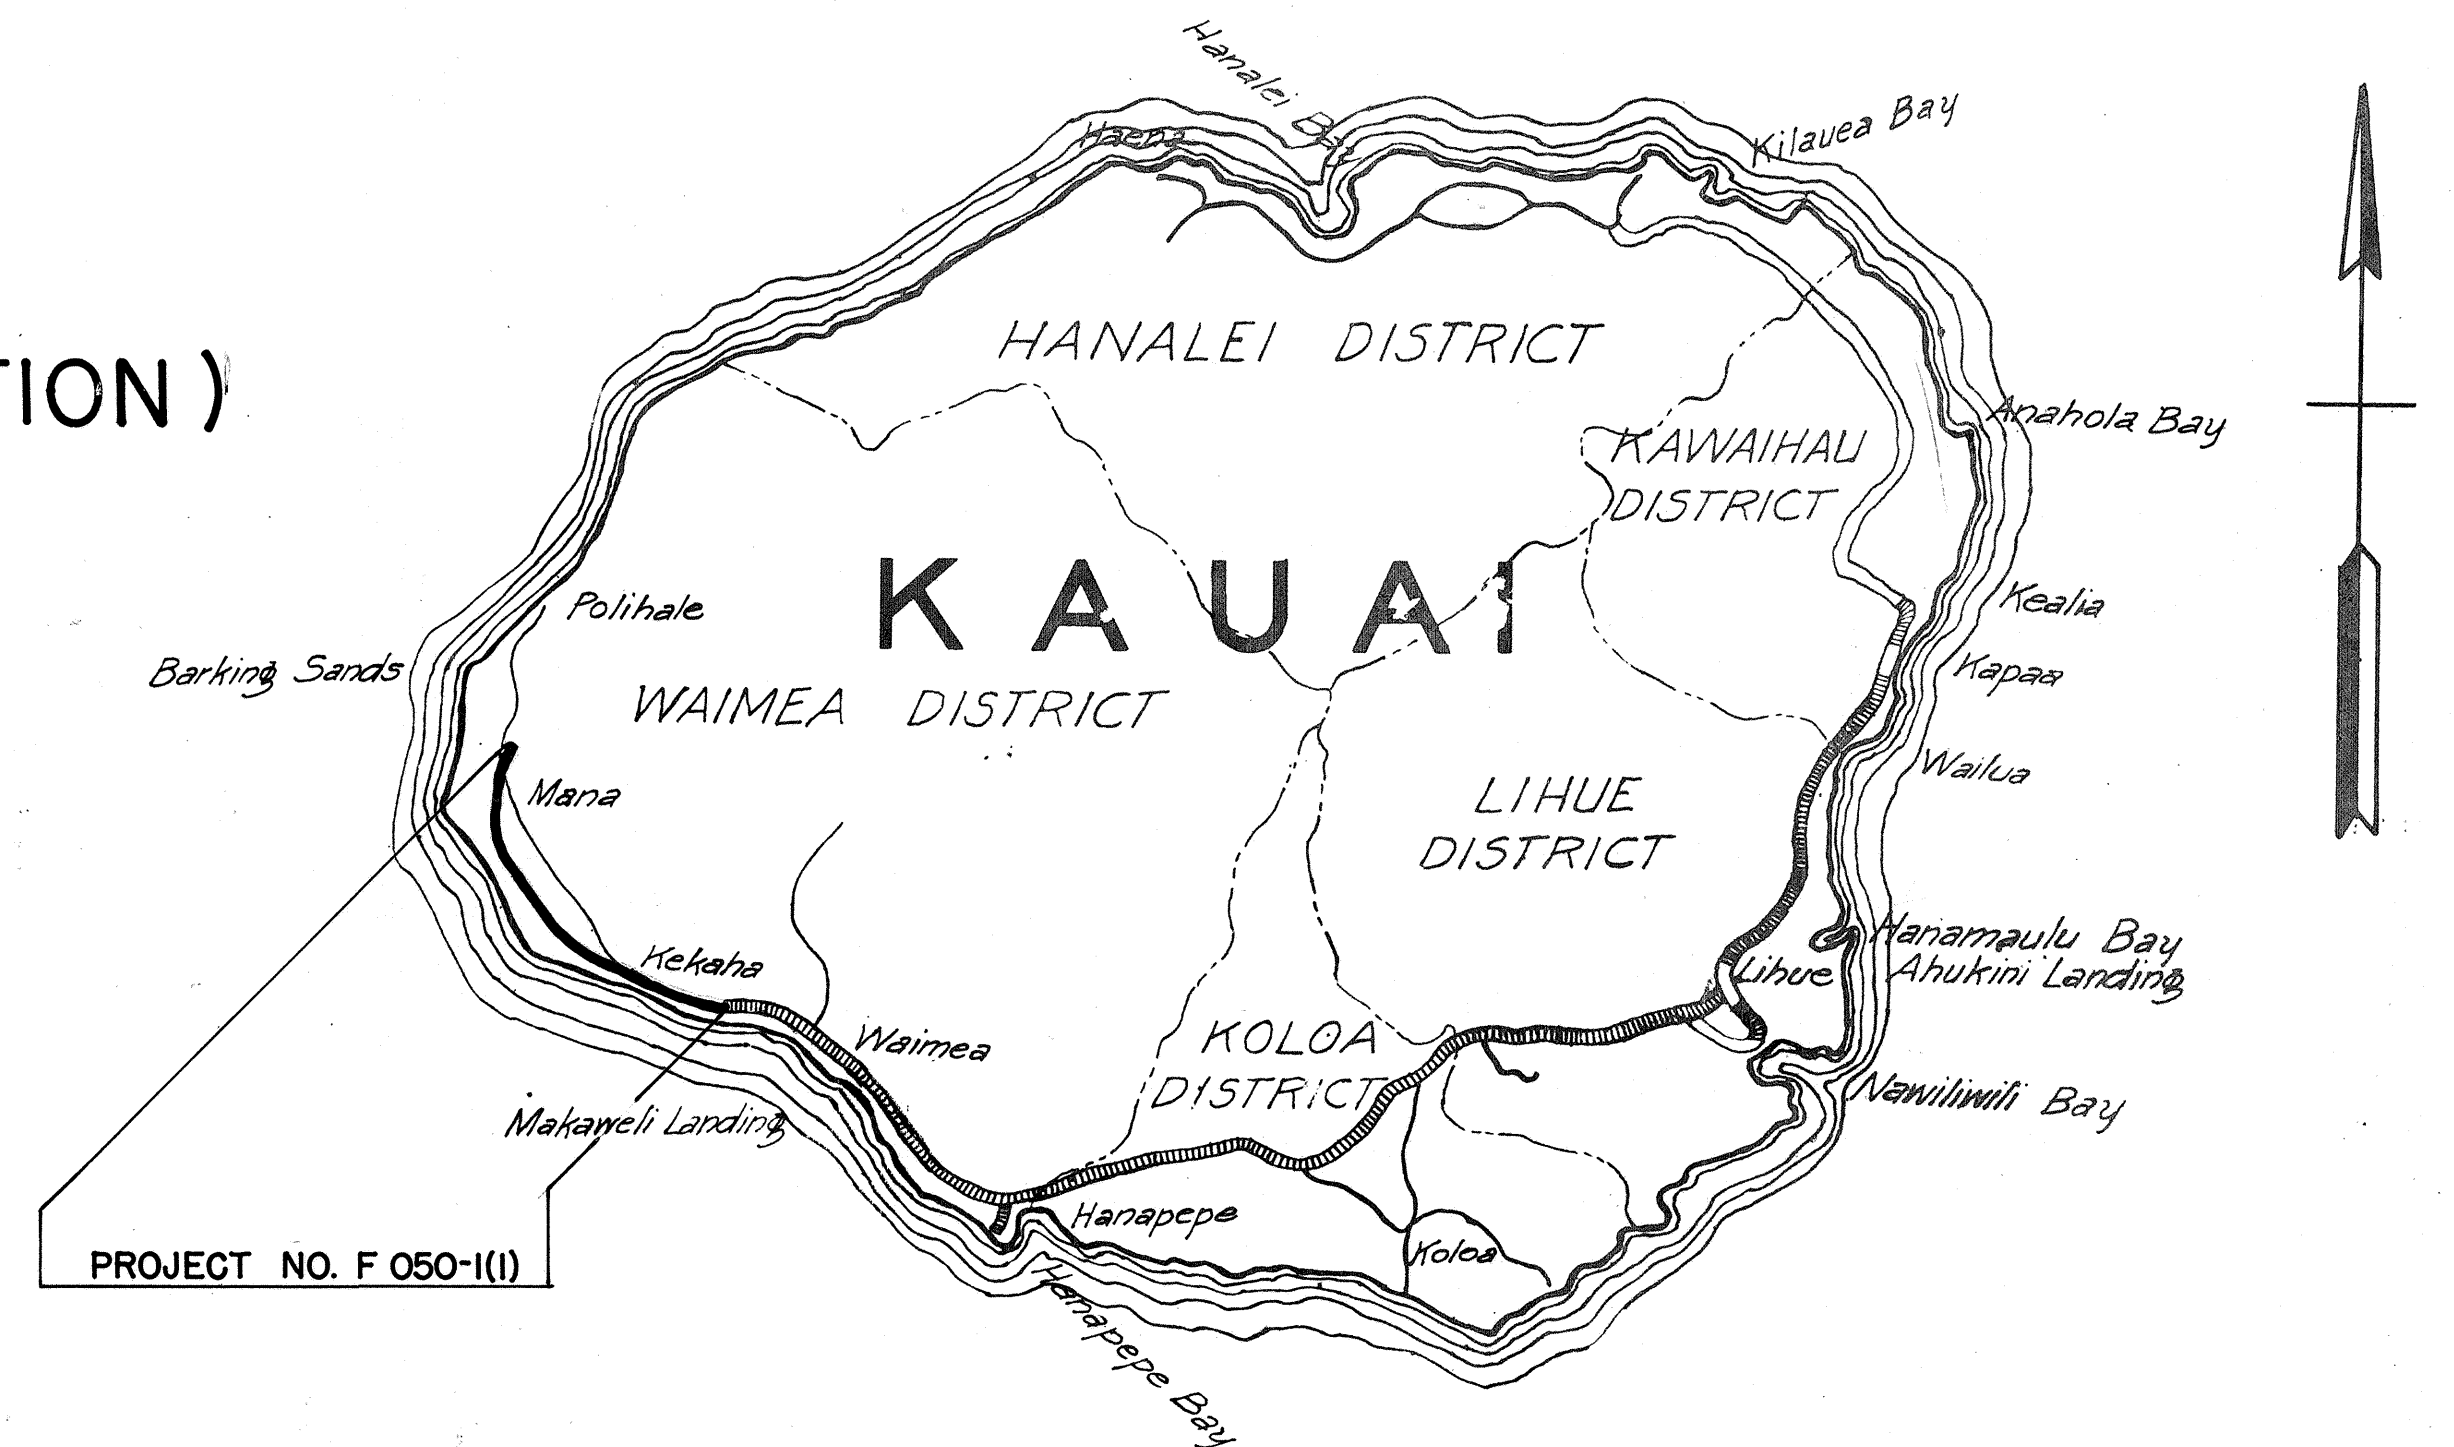


Federal Aid Projects Previously Constructed or Under Construction

NOTE:
ALL CHANGES MADE DURING CONSTRUCTION HAVE
BEEN NOTED IN RED ON THESE TRACINGS
AND CHECKED BY:

Peter J. Gamble
 PROJECT ENGINEER
 1-14-58
 DATE

APPROVED: _____ DATE _____
TERRITORIAL HIGHWAY ENGINEER

DEPARTMENT OF COMMERCE
BUREAU OF PUBLIC ROADS
APPROVED _____
DISTRICT ENGINEER DATE _____

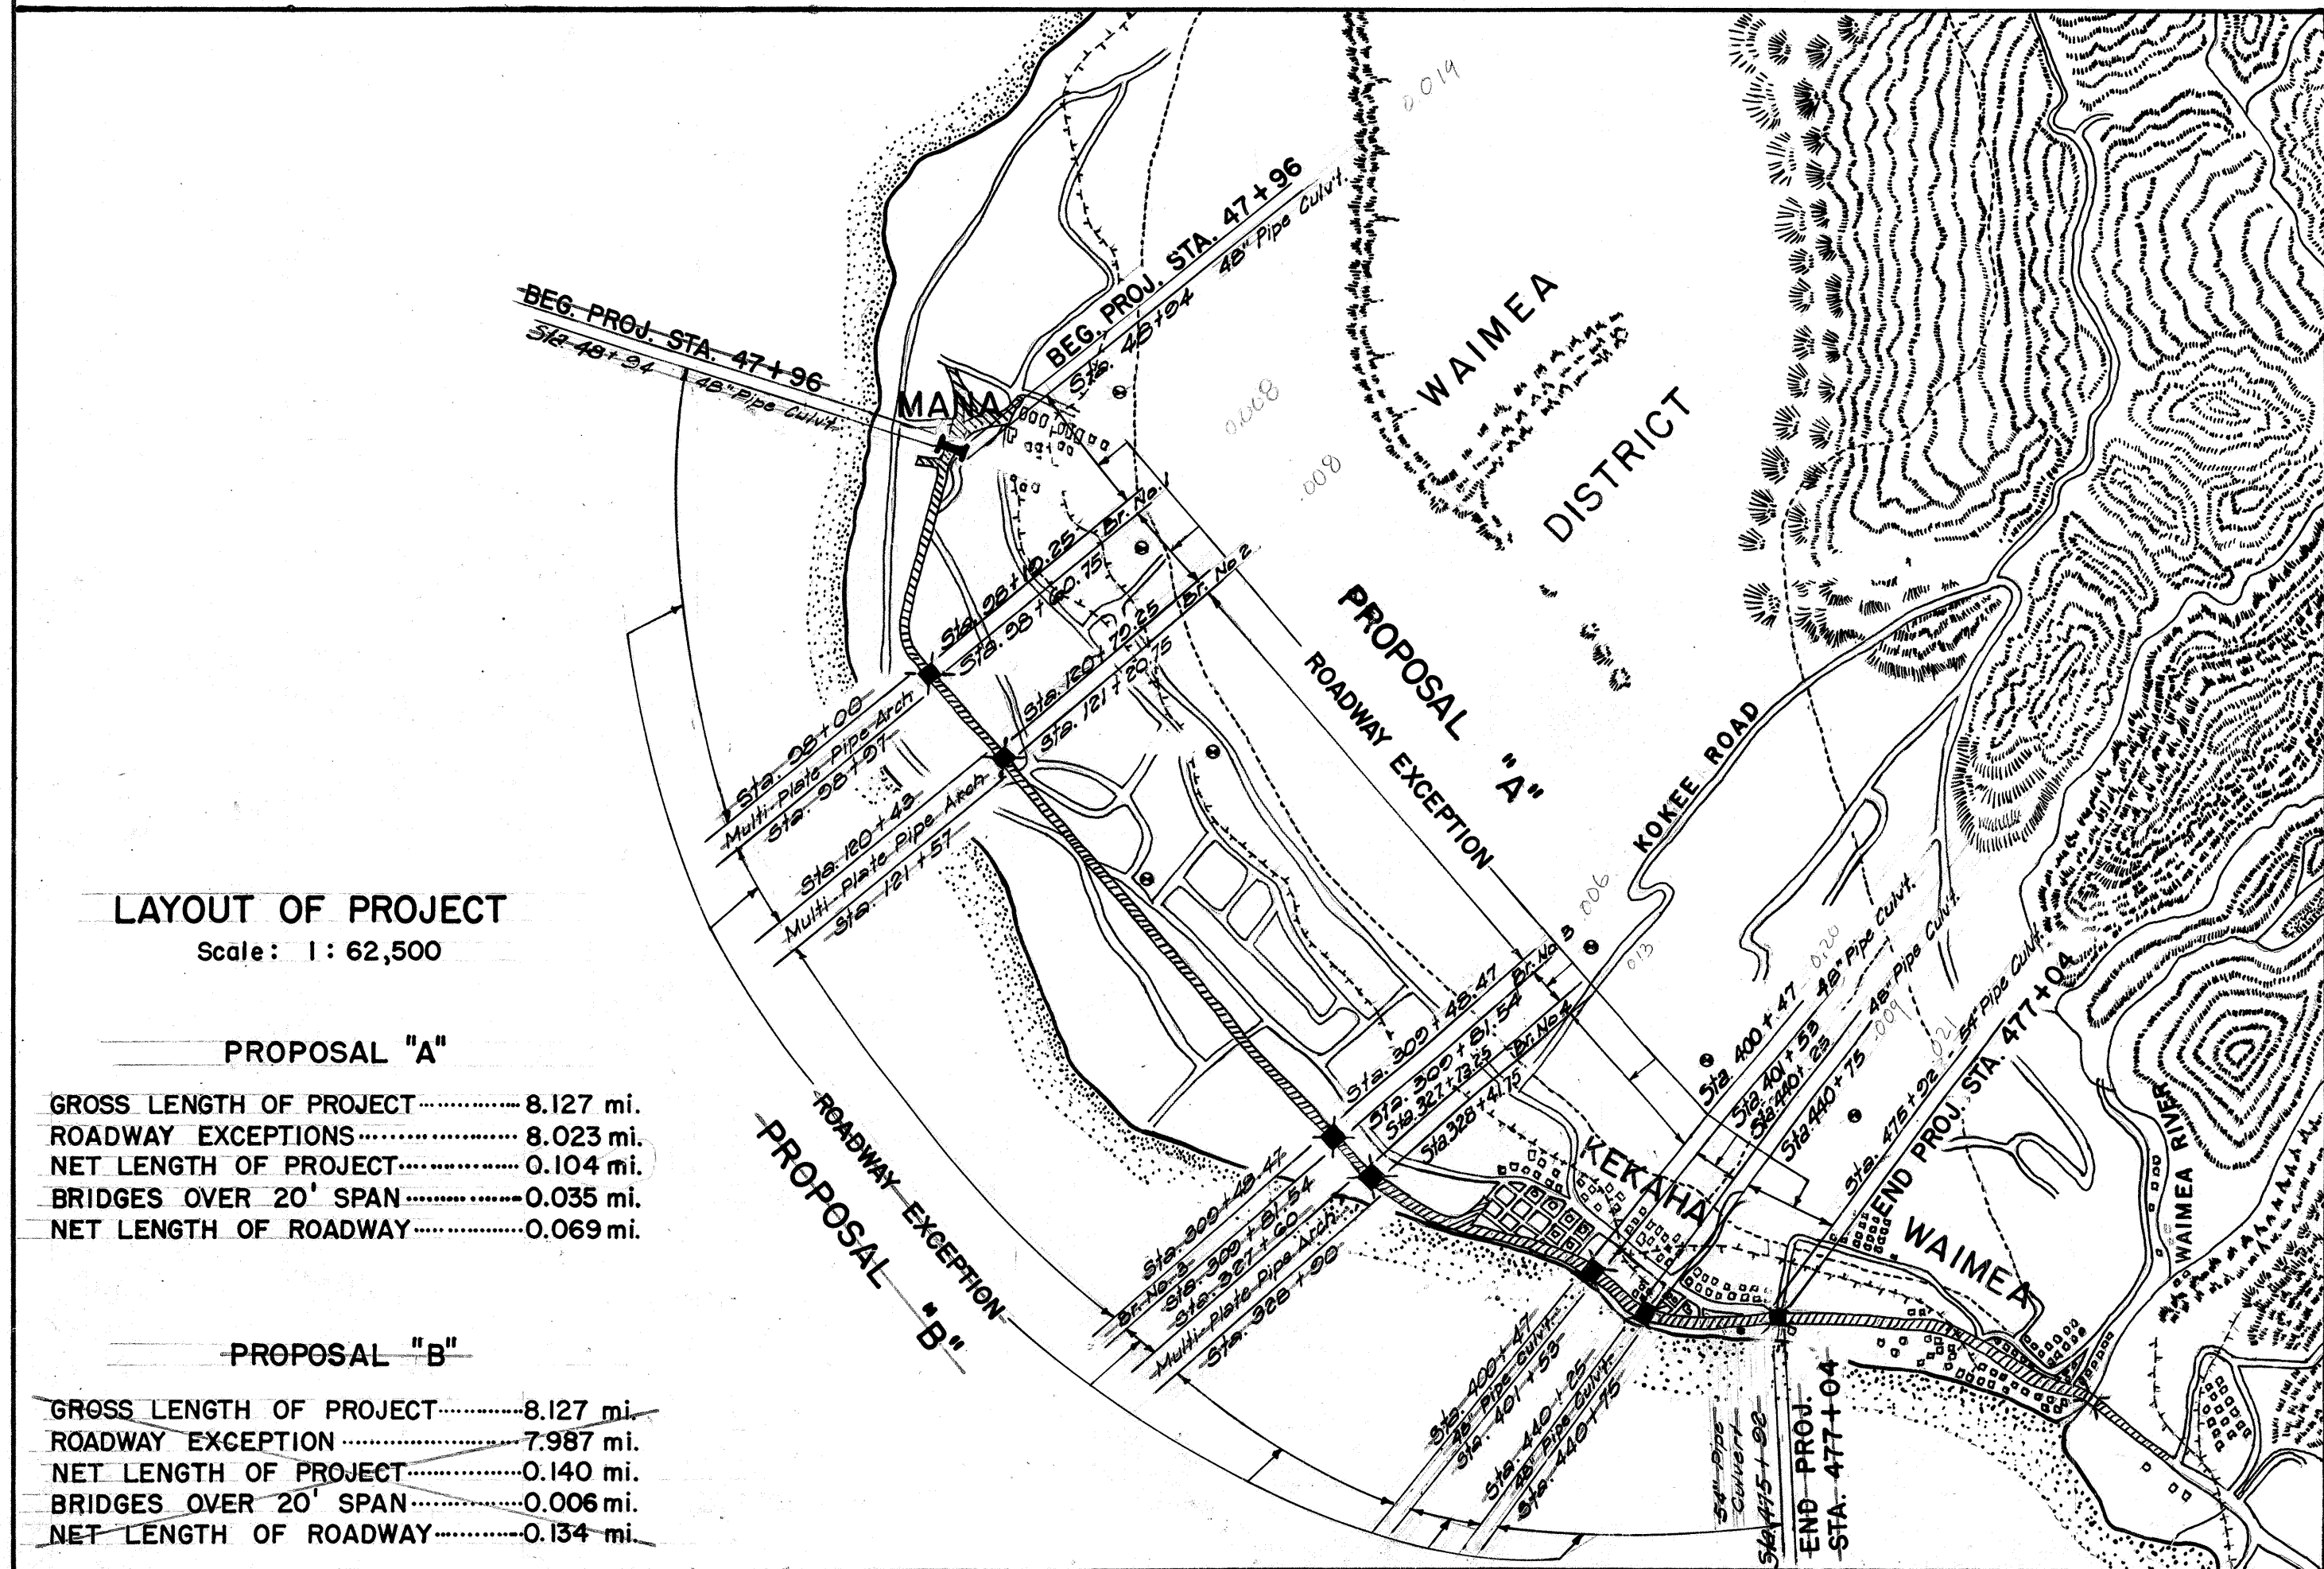

SURVEY PLOTTED BY _____
 DESIGNED BY _____
 DRAWN BY _____
 NOTE BOOK _____
 QUANTITIES CHECKED BY _____
 CHECKED BY _____
 No. _____

LAYOUT OF PROJECT
Scale: 1:62,500

PROPOSAL "A"

GROSS LENGTH OF PROJECT.....8.127 mi.
 ROADWAY EXCEPTIONS.....8.023 mi.
 NET LENGTH OF PROJECT.....0.104 mi.
 BRIDGES OVER 20' SPAN.....0.035 mi.
 NET LENGTH OF ROADWAY.....0.069 mi.

PROPOSAL "B"

GROSS LENGTH OF PROJECT.....8.127 mi.
 ROADWAY EXCEPTION.....7.987 mi.
 NET LENGTH OF PROJECT.....0.140 mi.
 BRIDGES OVER 20' SPAN.....0.006 mi.
 NET LENGTH OF ROADWAY.....0.134 mi.