


INDEX TO DRAWINGS	
SHEET NO.	DESCRIPTION
I	TITLE SHEET

STATE	PROJ. NO.	FISCAL YEAR	SHEET NO.	TOTAL SHEETS
HAWAII	E-50-01-64	1964	1	1


STATE OF HAWAII
DEPARTMENT OF TRANSPORTATION
HIGHWAYS DIVISION
"AS BUILT" PLANS FOR
RESURFACING OF A PORTION OF
KAUAI BELT ROAD
(F.A.P. PROJECT NO. F-12(17))
PROJECT NO. E-50-01-64

DISTRICT OF LIHUE
ISLAND OF KAUAI

CONVENTIONAL	SIGNS
Baseline	75
Boundary Line	
Fences (Named)	
Existing Roadway	
Pipe Culvert	
Box Culvert	
Telephone Line & Pole	
Electric Line & Pole	
Water Main	

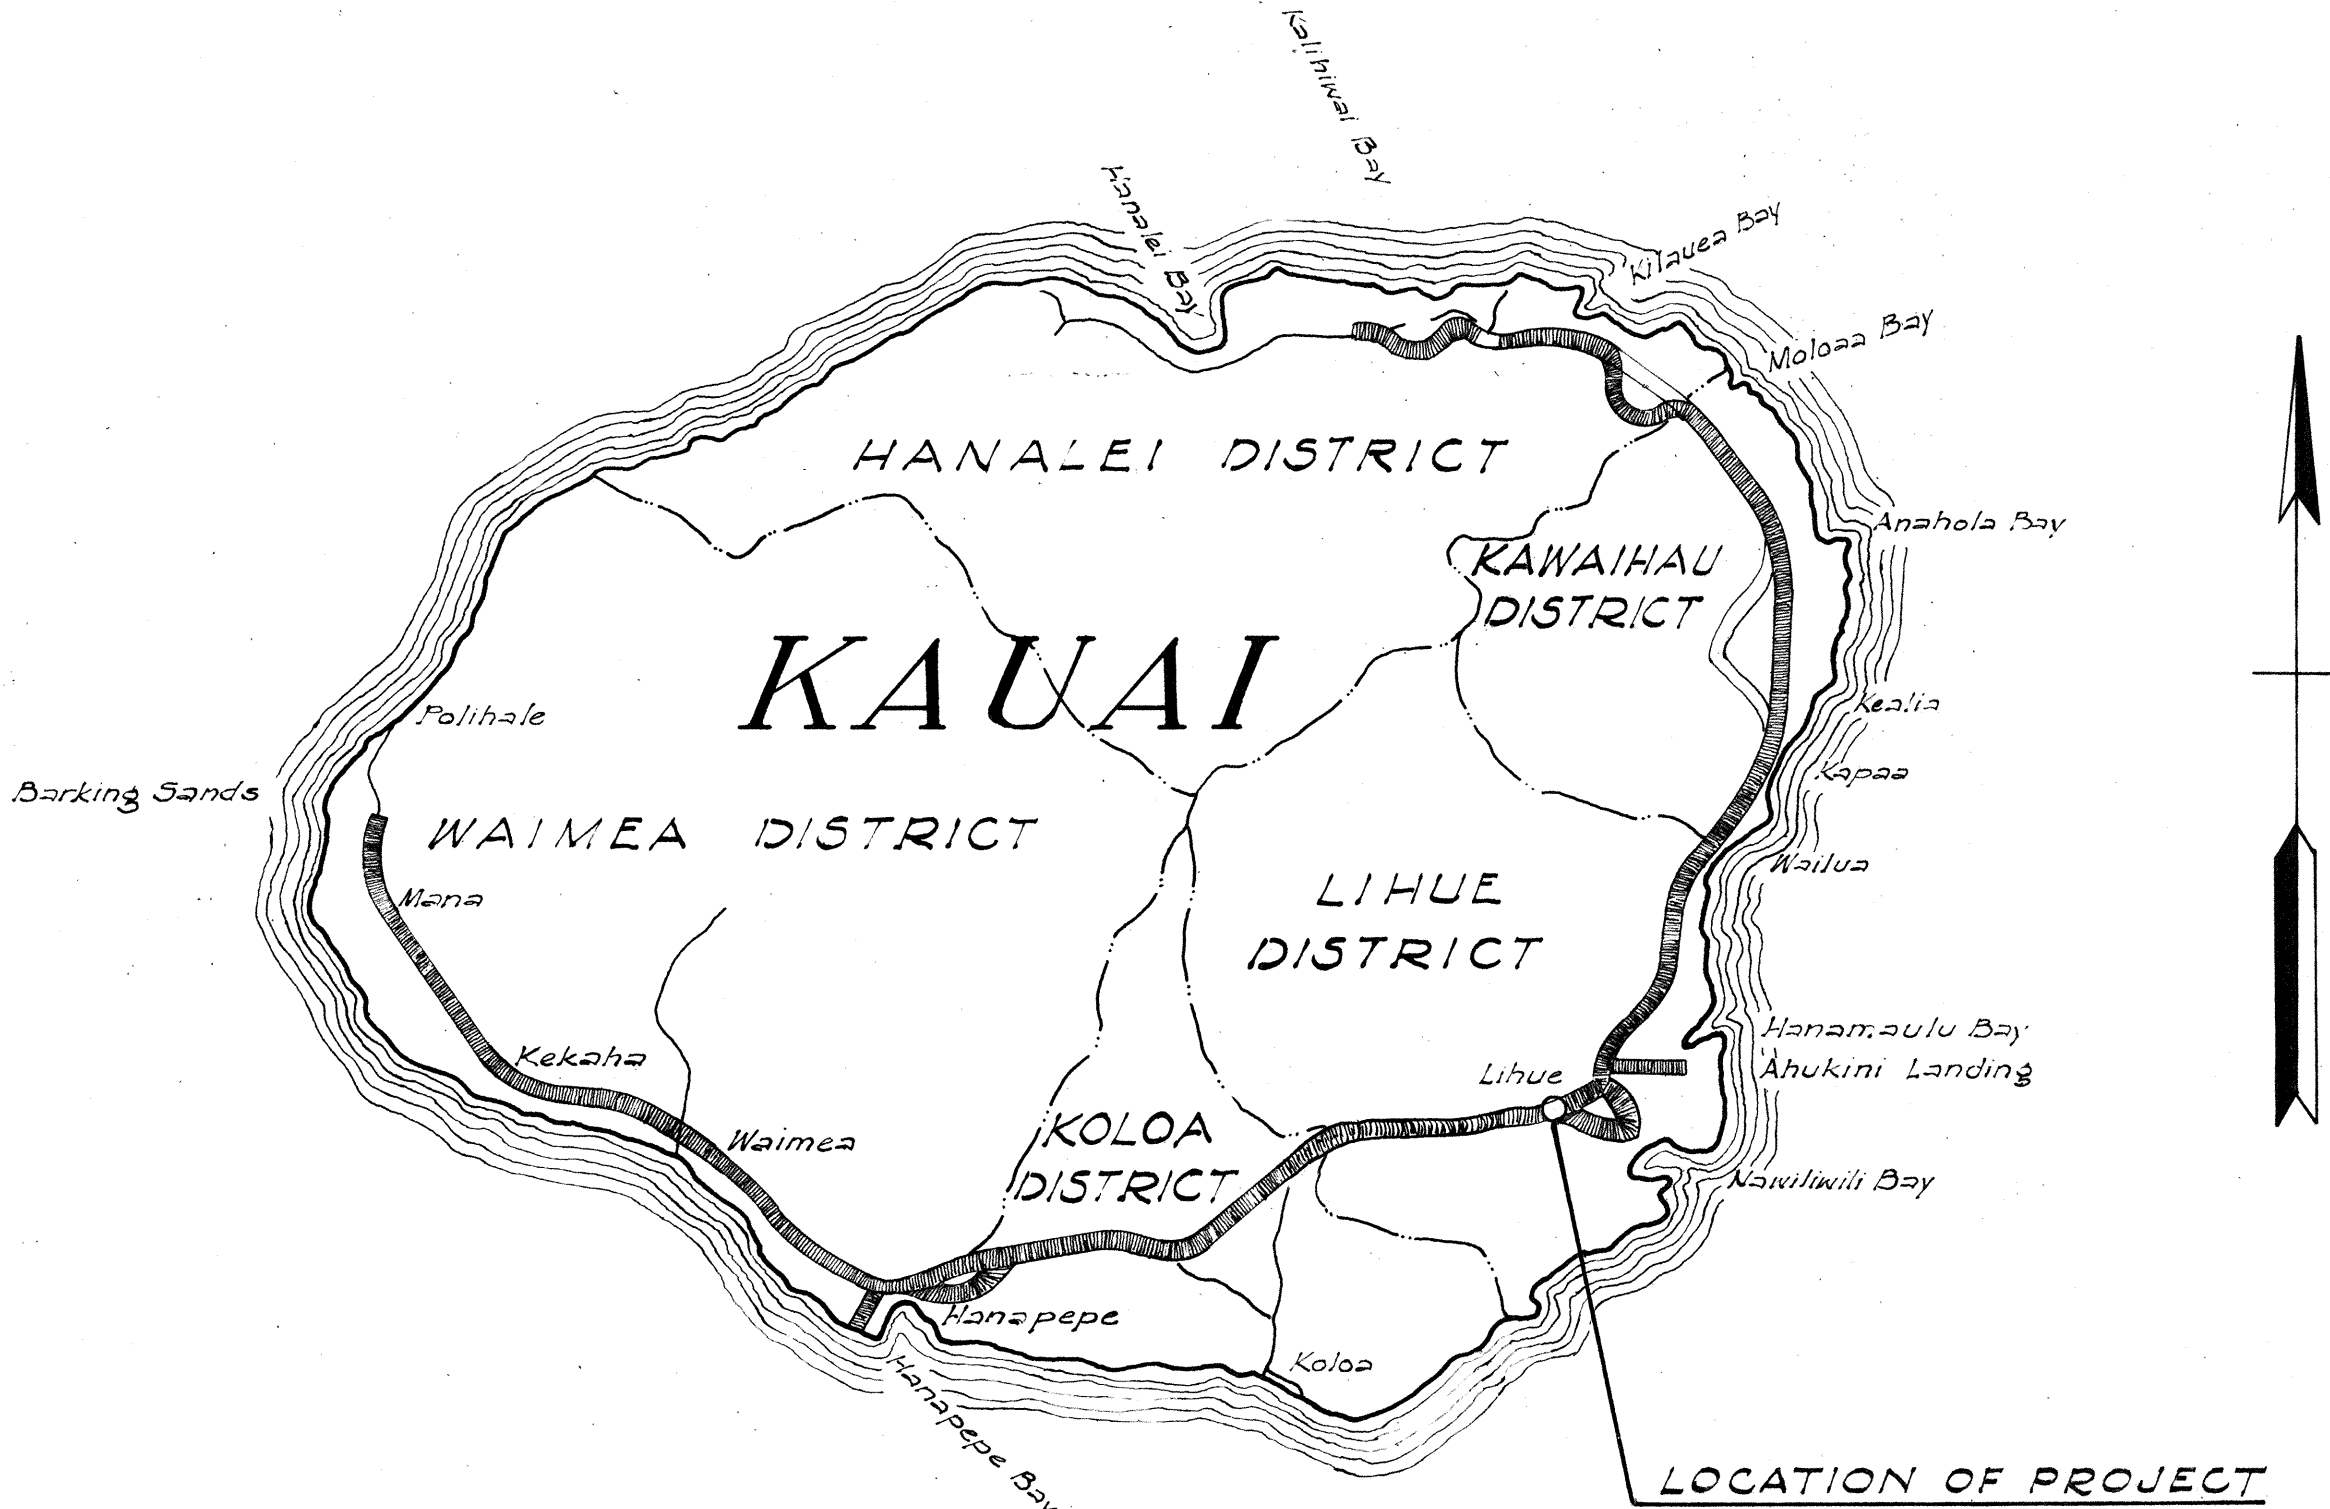

LAYOUT OF PROJECT
SCALE: 1" = 2000'

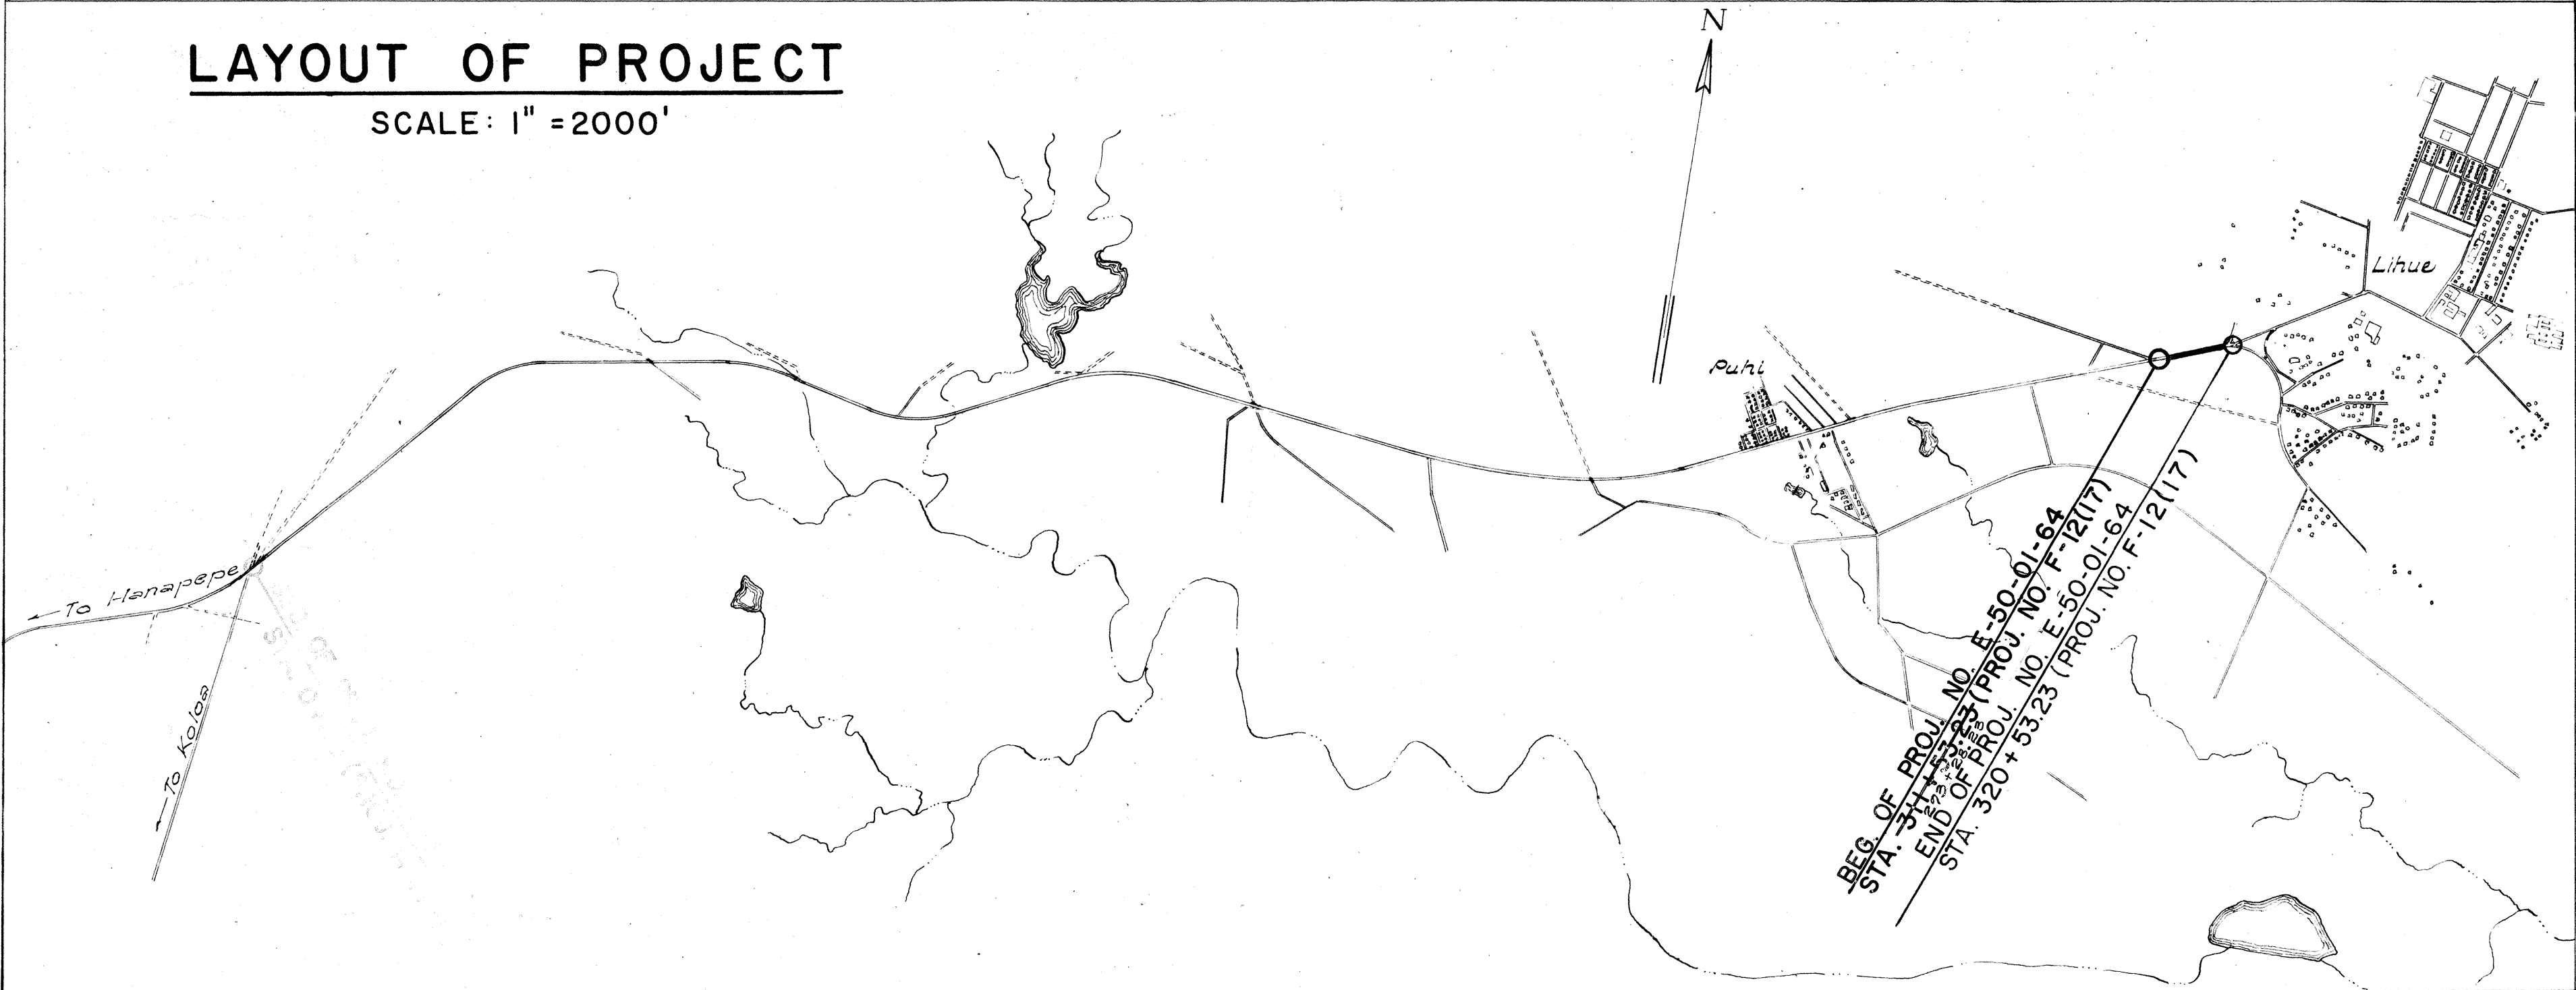

NOTE:
ALL CHANGES MADE DURING
CONSTRUCTION HAVE BEEN
NOTED IN RED ON THESE
SHEETS AND CHECKED BY.

Shigeto Yamaguchi
PROJECT ENGINEER
3/9/67
DATE

APPROVED: *Luigi Montenegro*
DIRECTOR OF TRANSPORTATION
DATE 4 May 67