


NEW DROP INTAKE DETAILS

STA. 12+70

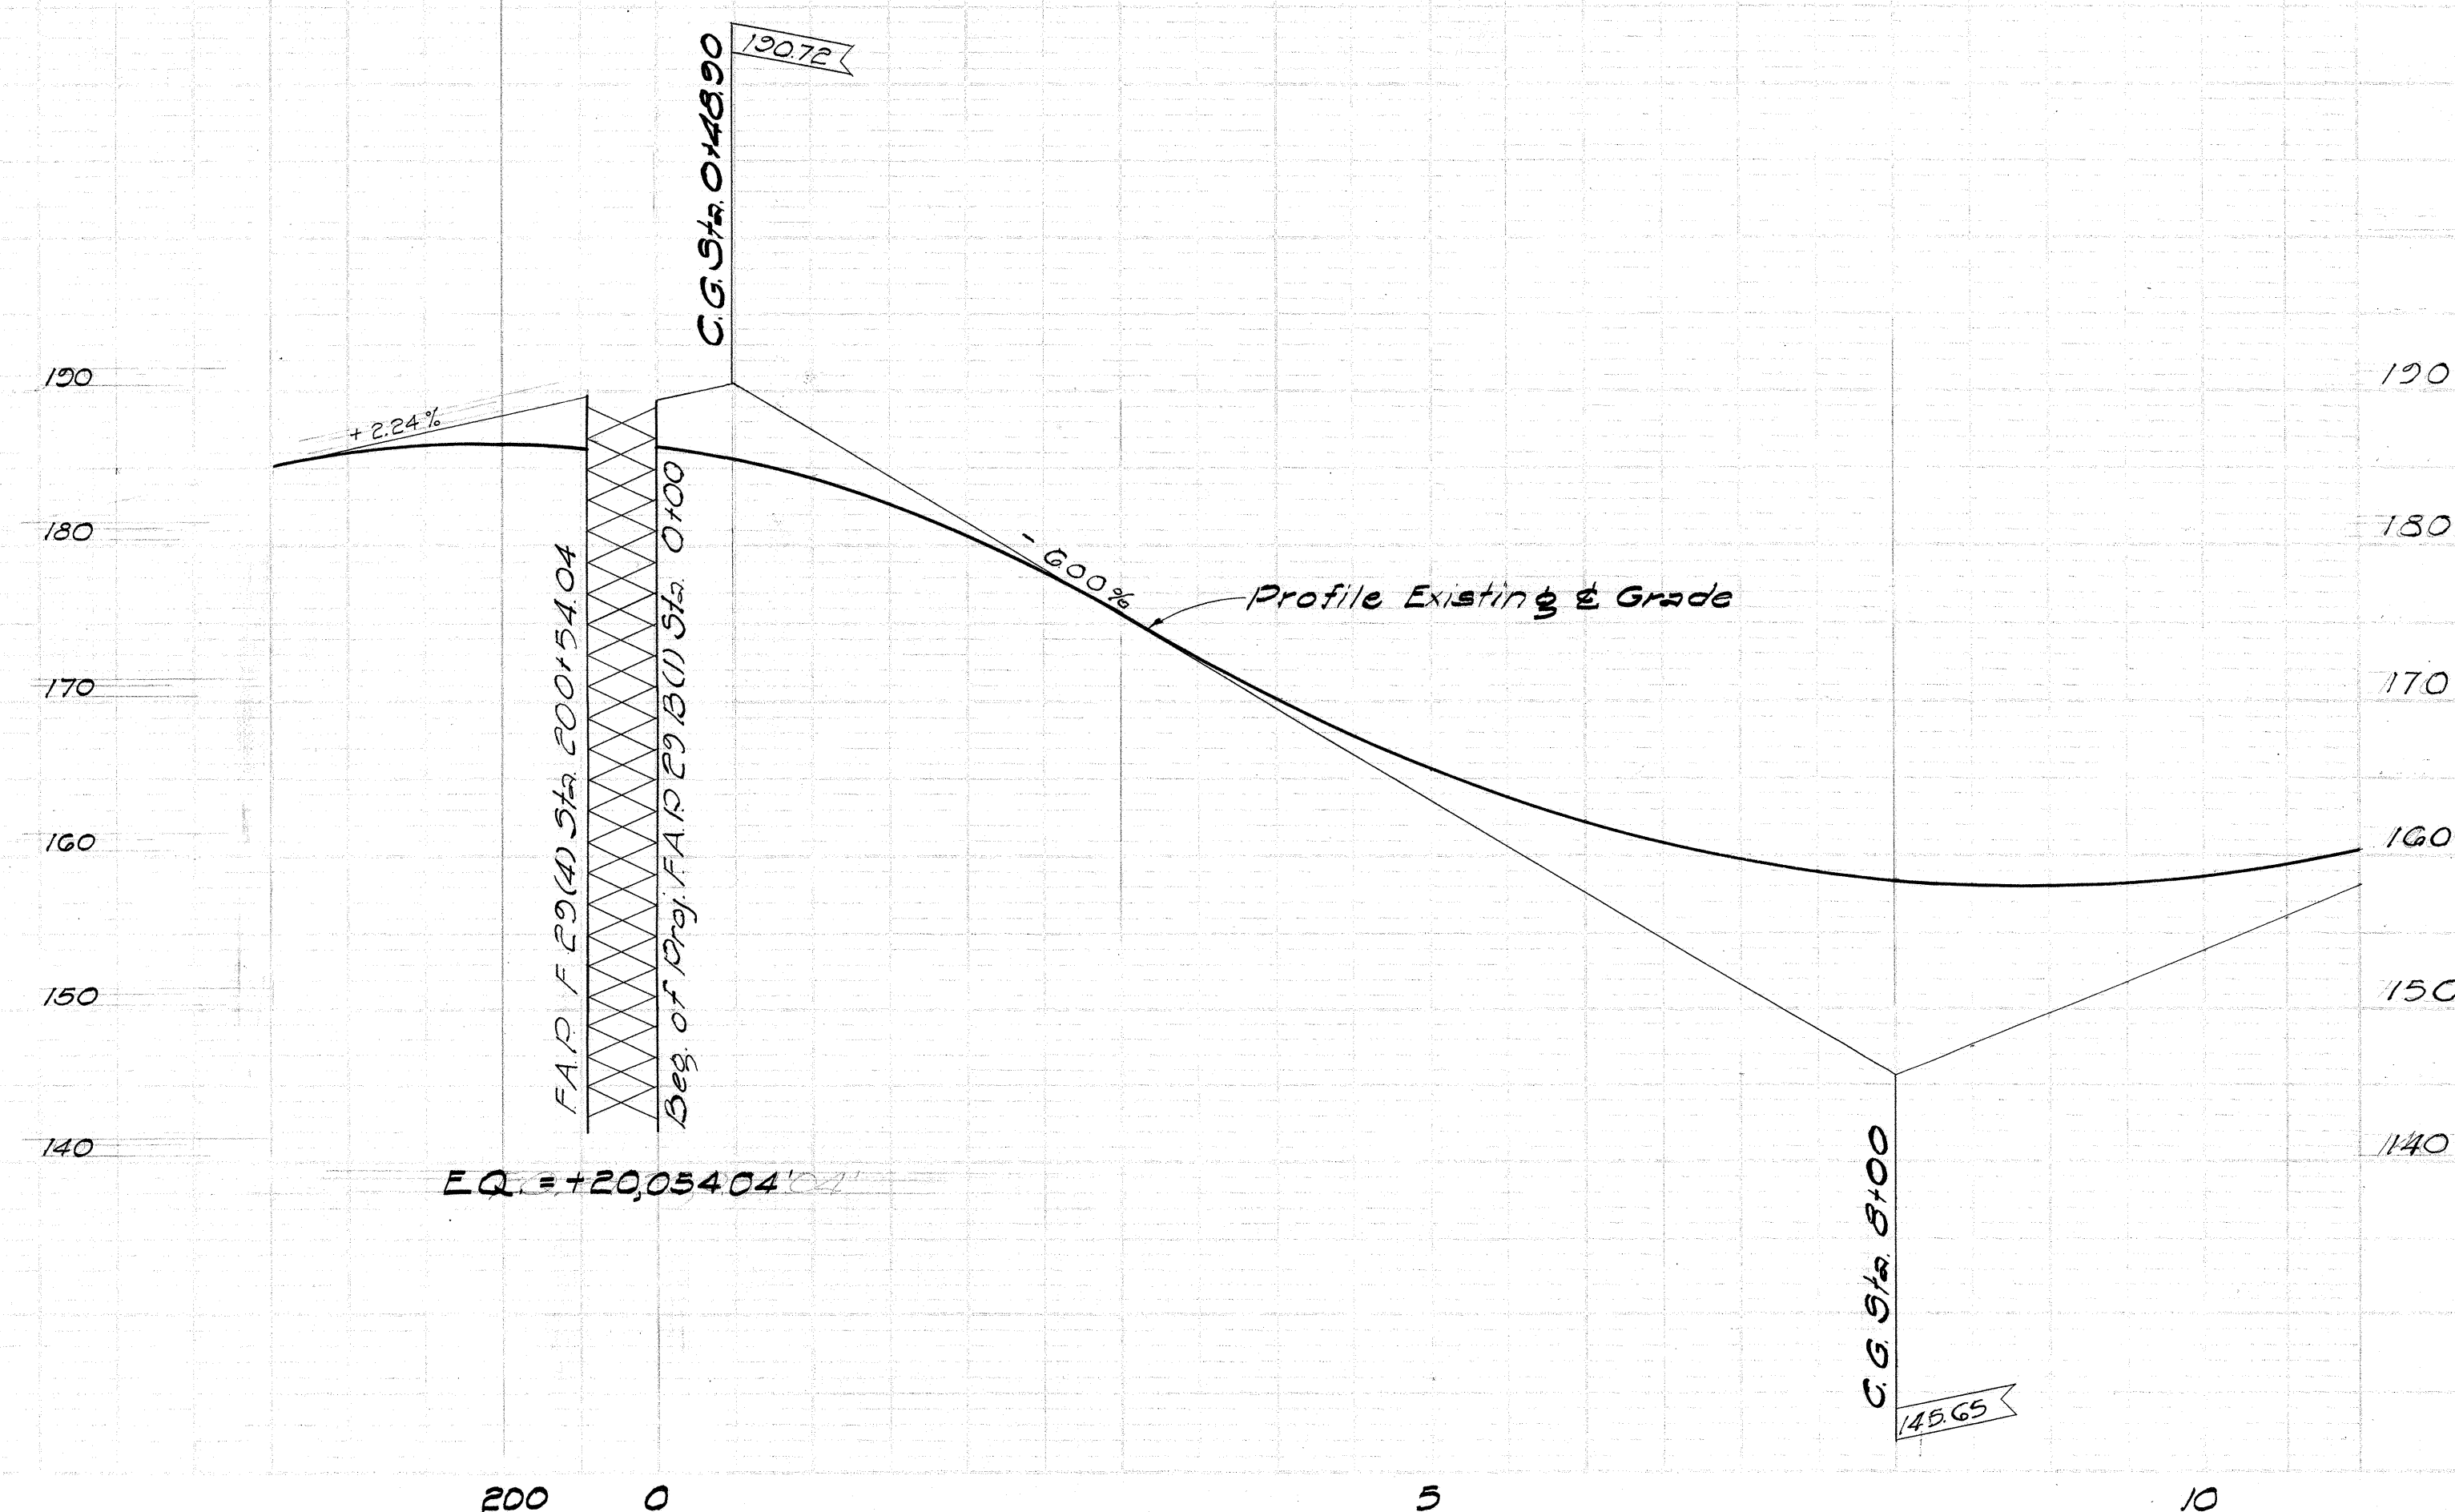

GENERAL NOTES

1. Excavated material shall be used for dressing shoulders and backfilling within the project limits as directed.
2. Excess excavated material shall be deposited on the slopes of fill along the guard rails, located approximately 500 feet Lihue of the end of project, and/or stockpiled in the vicinity as directed.
3. Widened sections and existing ravelled edges of pavement shall be leveled to the existing surface with a leveling course of Asphalt Concrete to permit full width overlay of the $\frac{3}{4}$ inch minimum wearing course.
4. Overhaul, Compacting Original Ground in widened sections, Sprinkling for compaction and all brooming if required shall not be paid for separately but shall be considered incidental to the various contract items.

DATE	
BY	
REVISION	
NO.	
PLAN	
NOTE: SEE SHEET NO. D-50-02-63 FOR PLAN AND PROFILE.	

DATE	
BY	
REVISION	
NO.	
PROFILE	
NOTE: SEE SHEET NO. D-50-02-63 FOR PLAN AND PROFILE.	

