
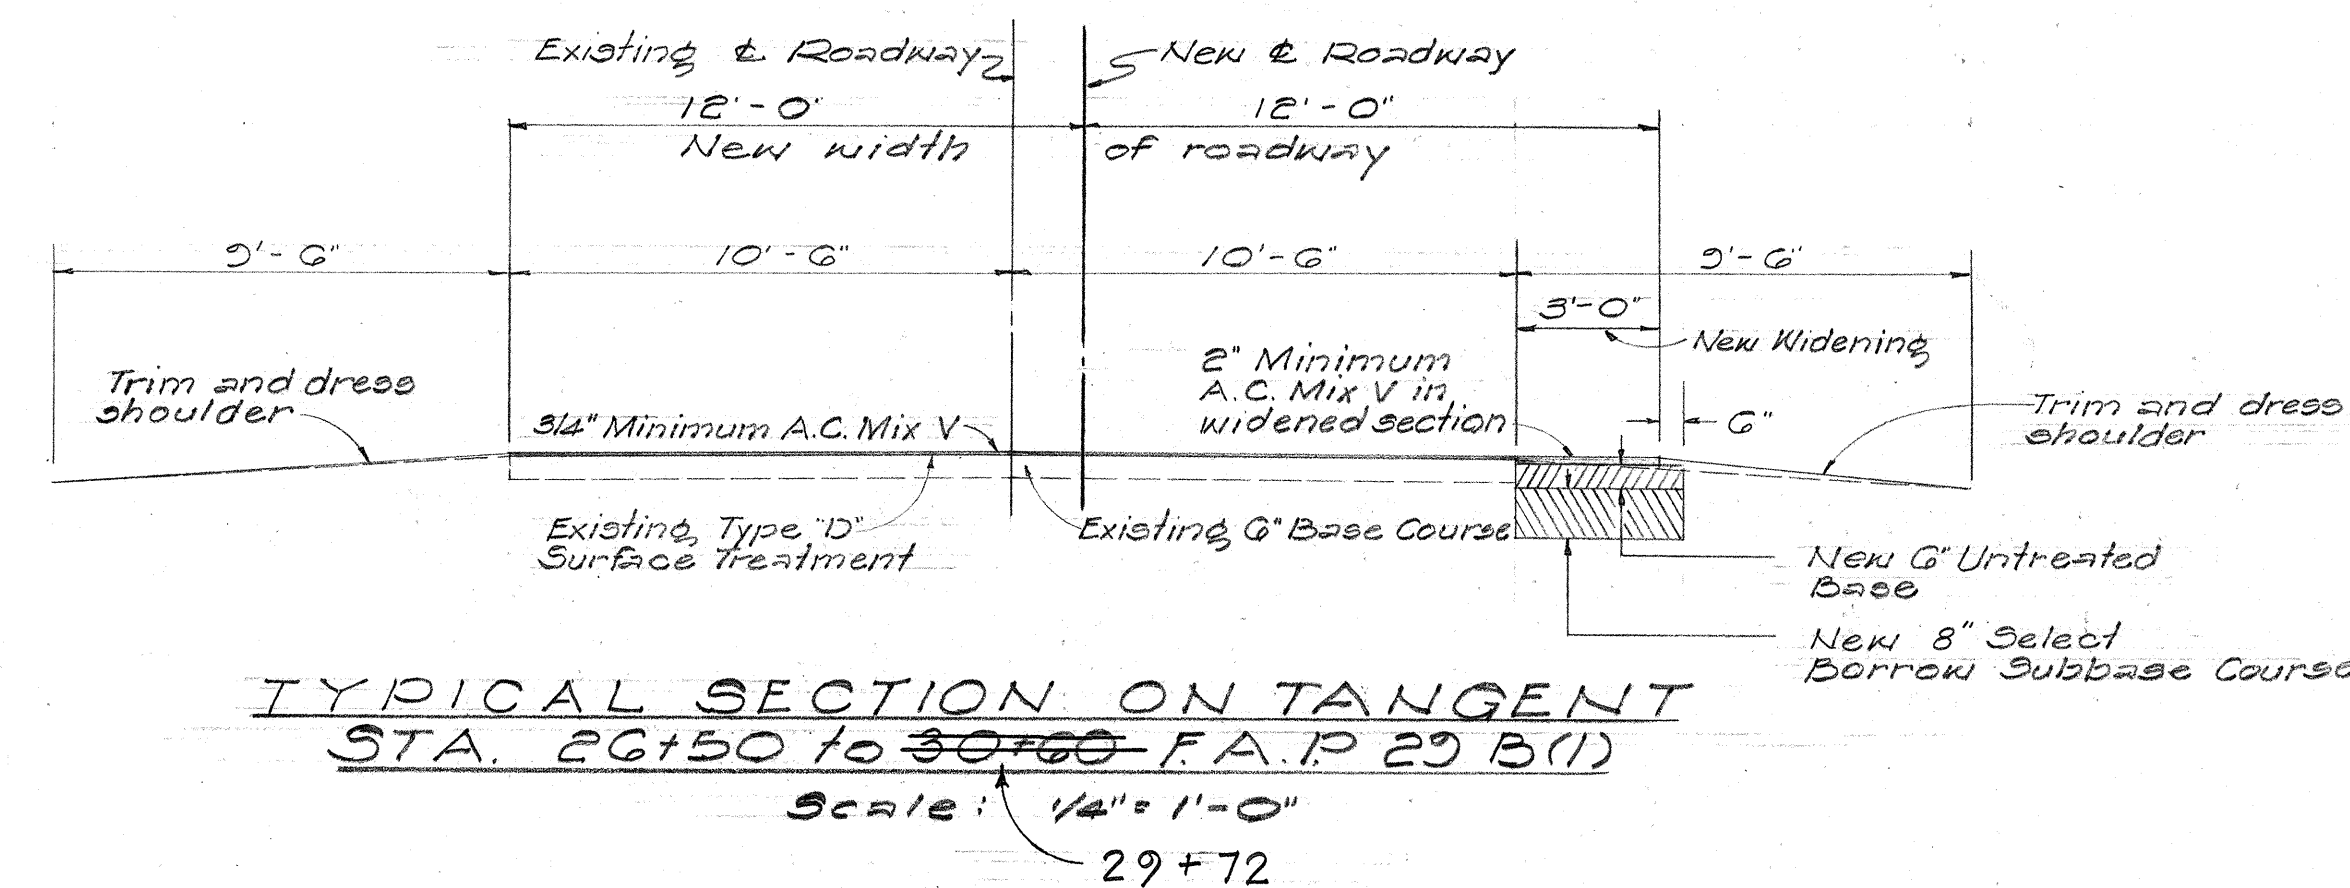
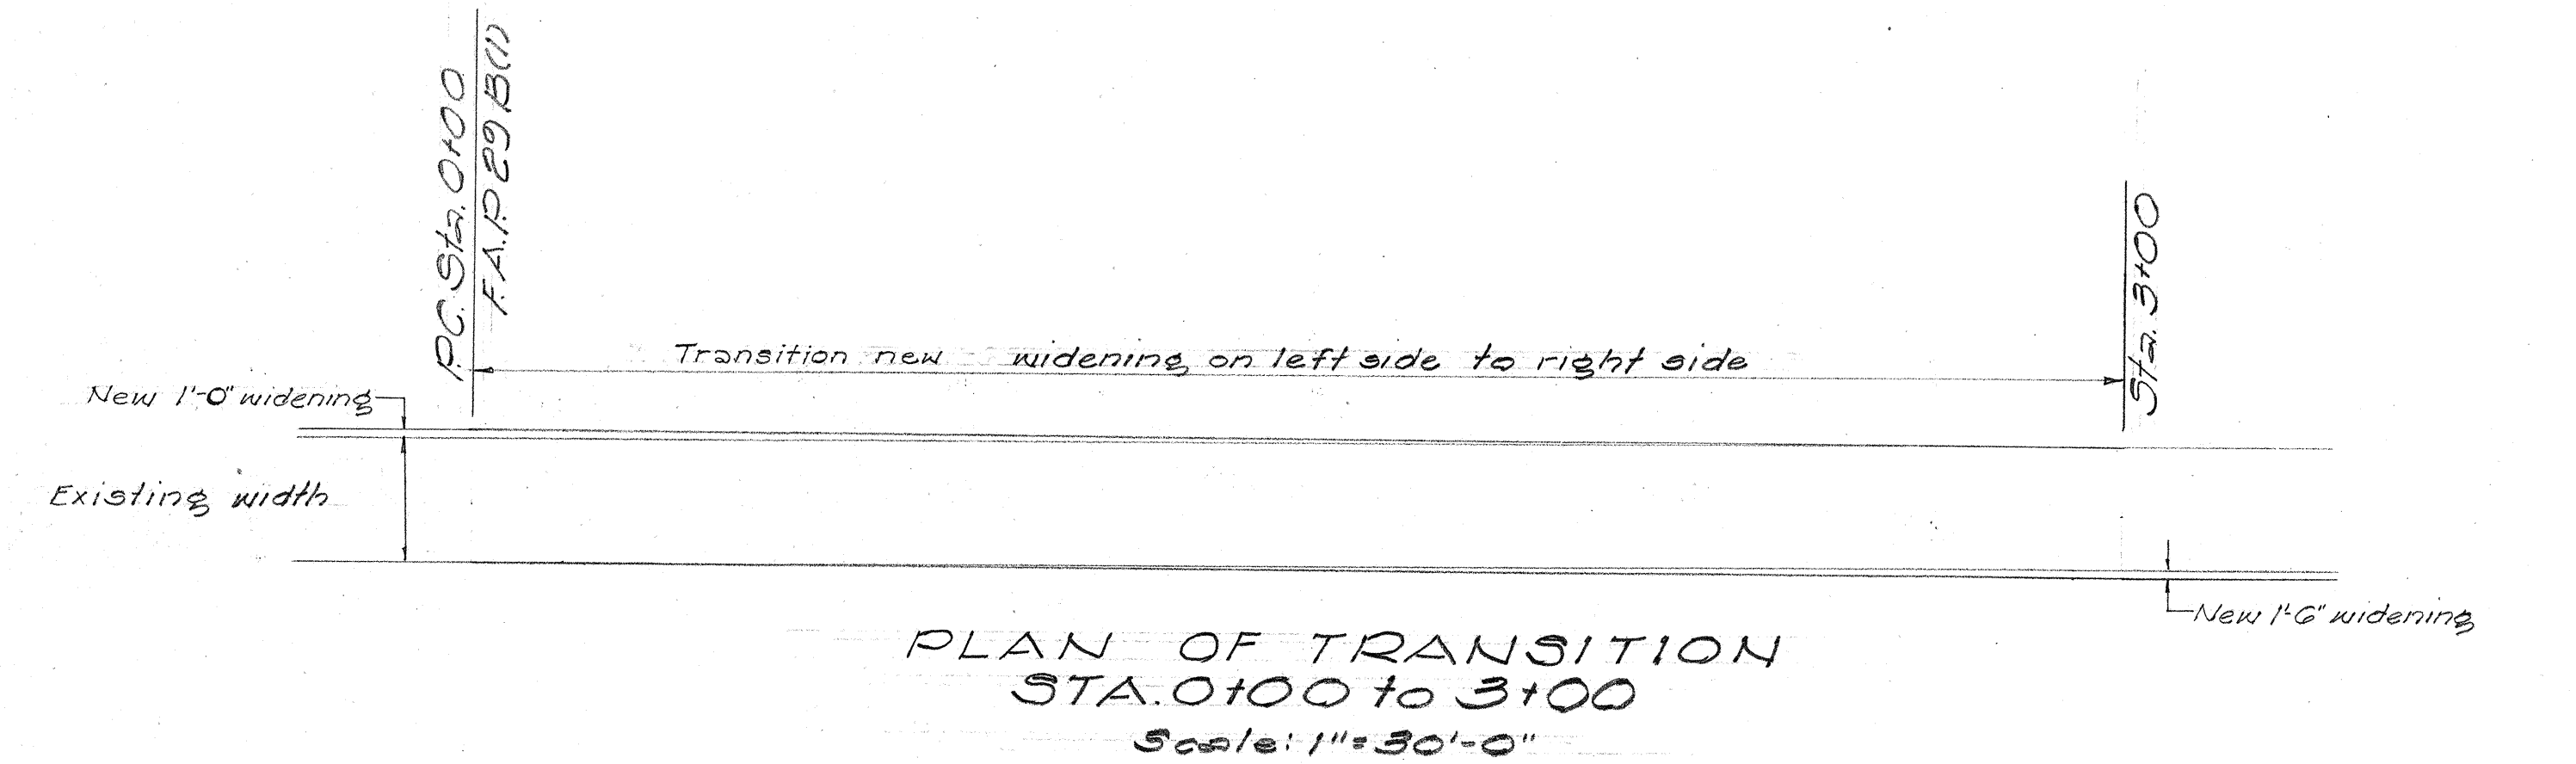
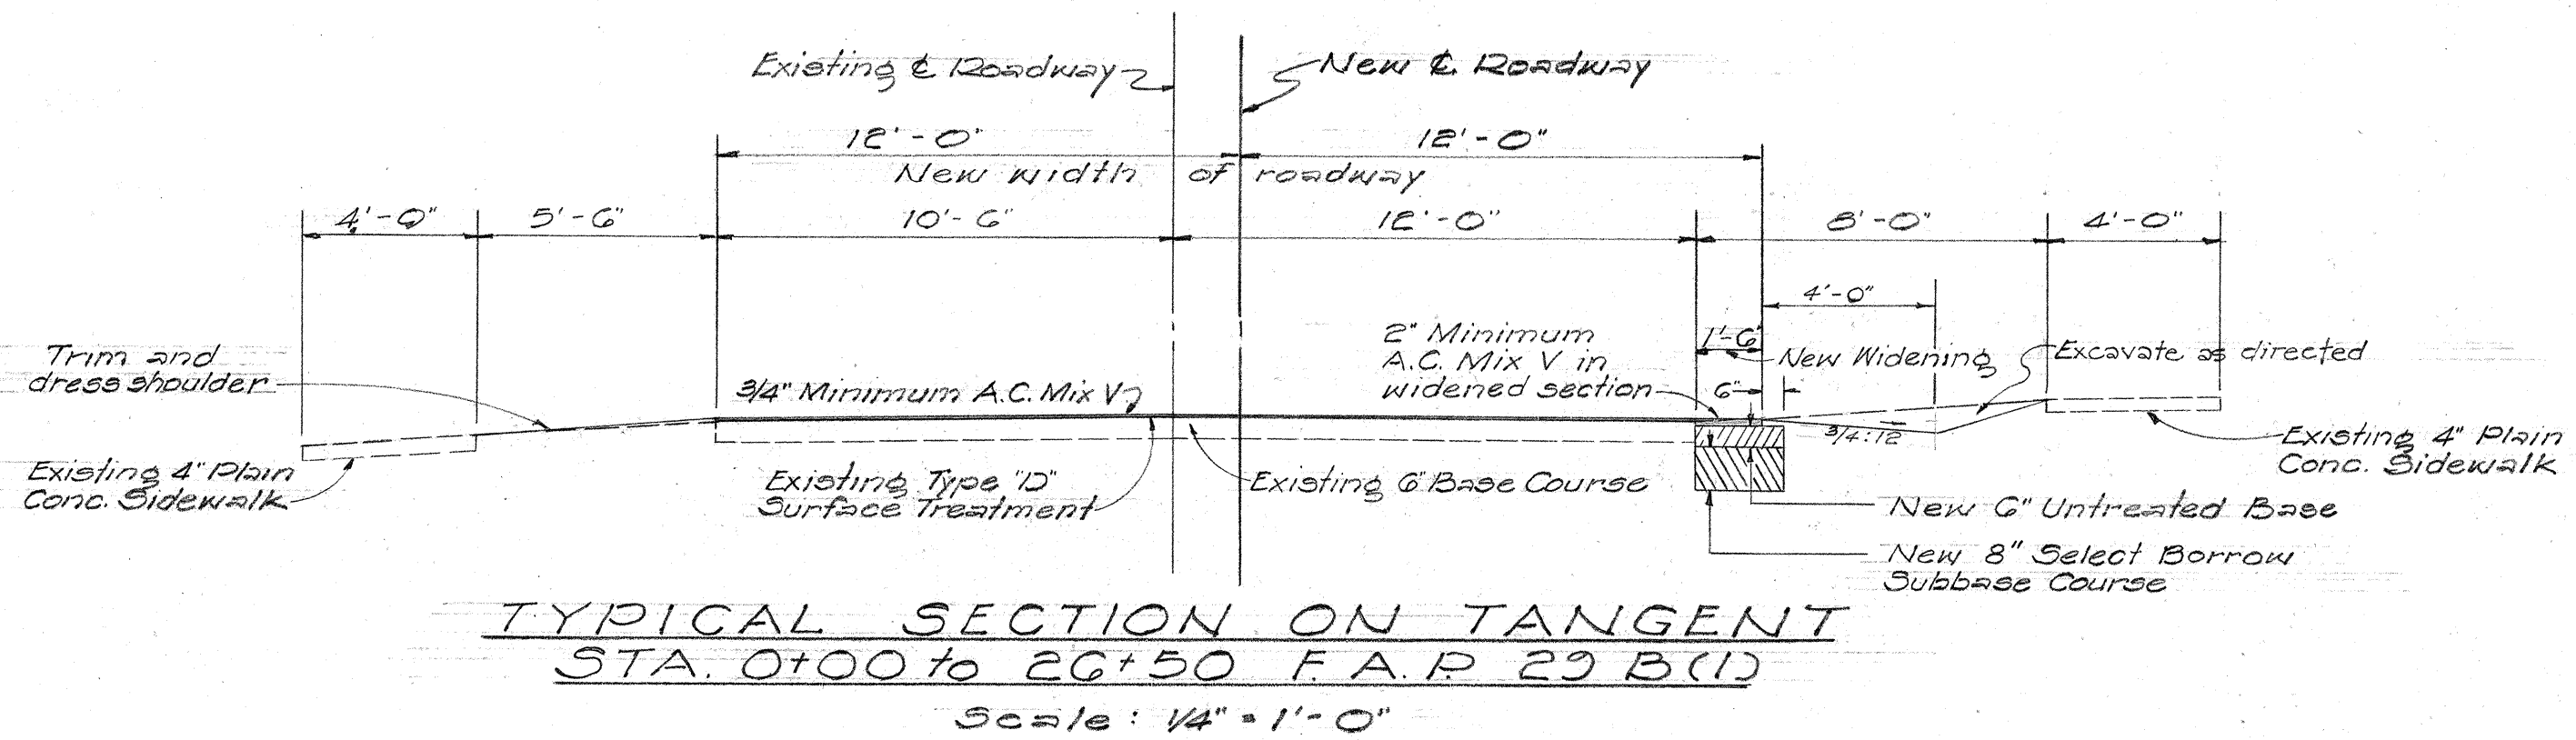
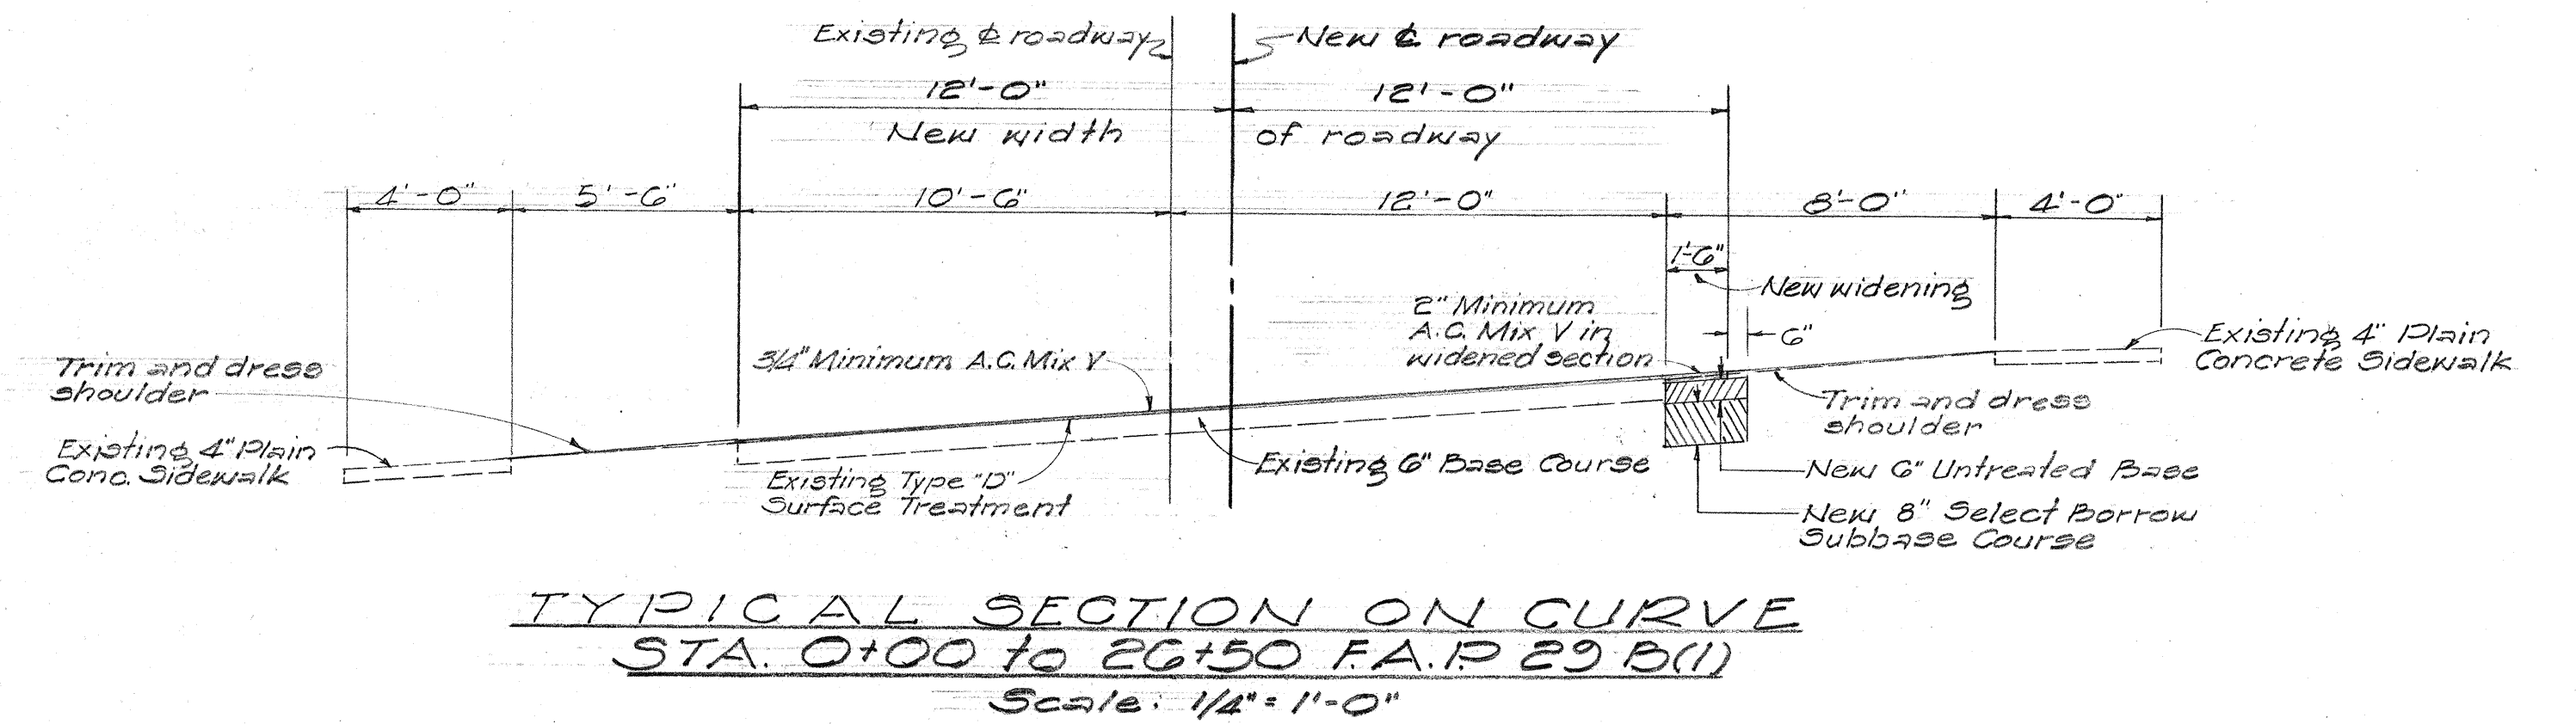


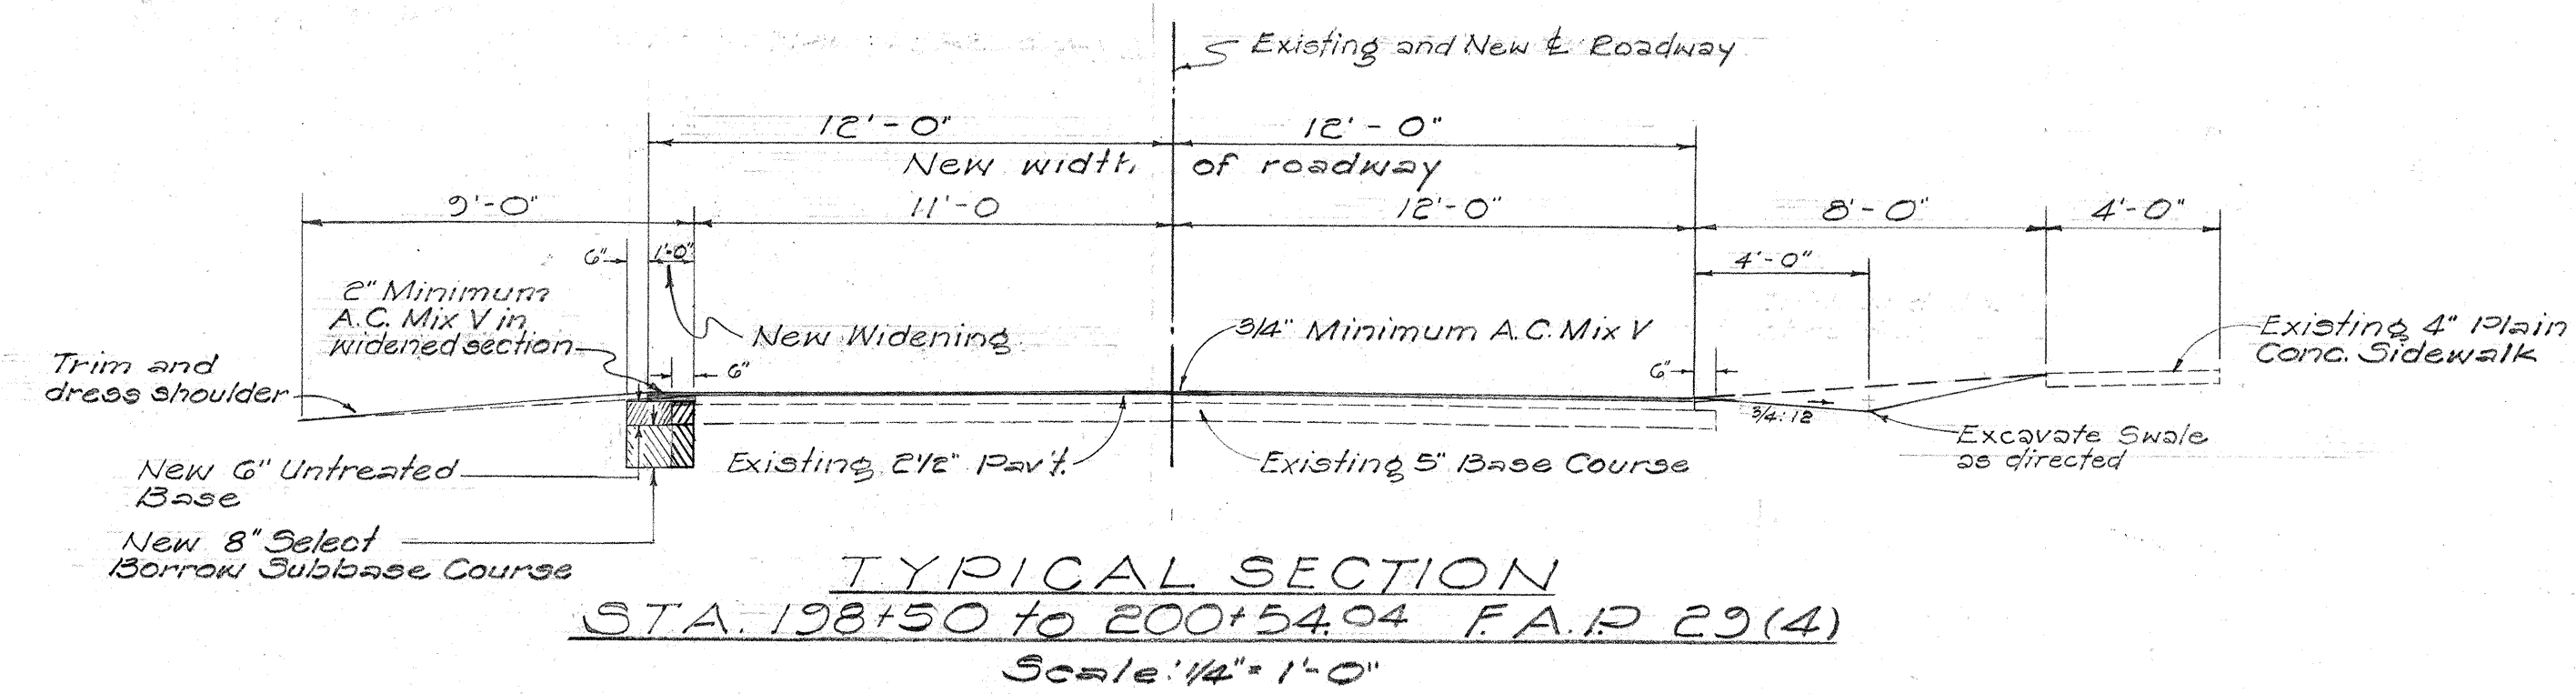

NOTE:
Work involved in leveling existing Type 'D' Surface Treatment prior to laying of A.C., to be done by others. Trimming and dressing of shoulders shall not be paid for separately but shall be considered incidental to roadway excavation.