

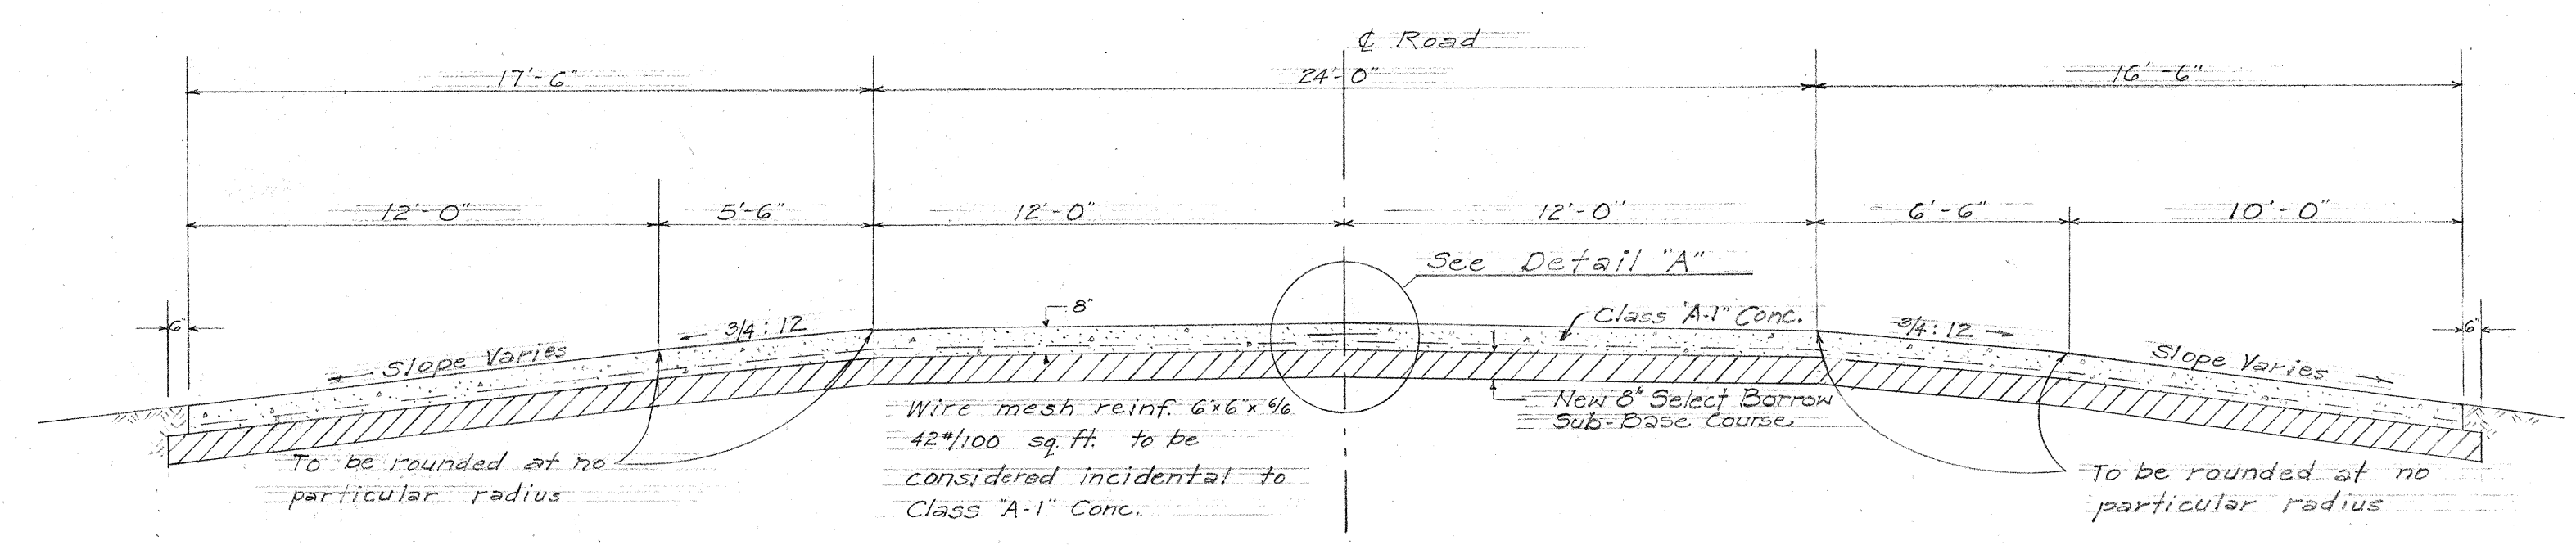
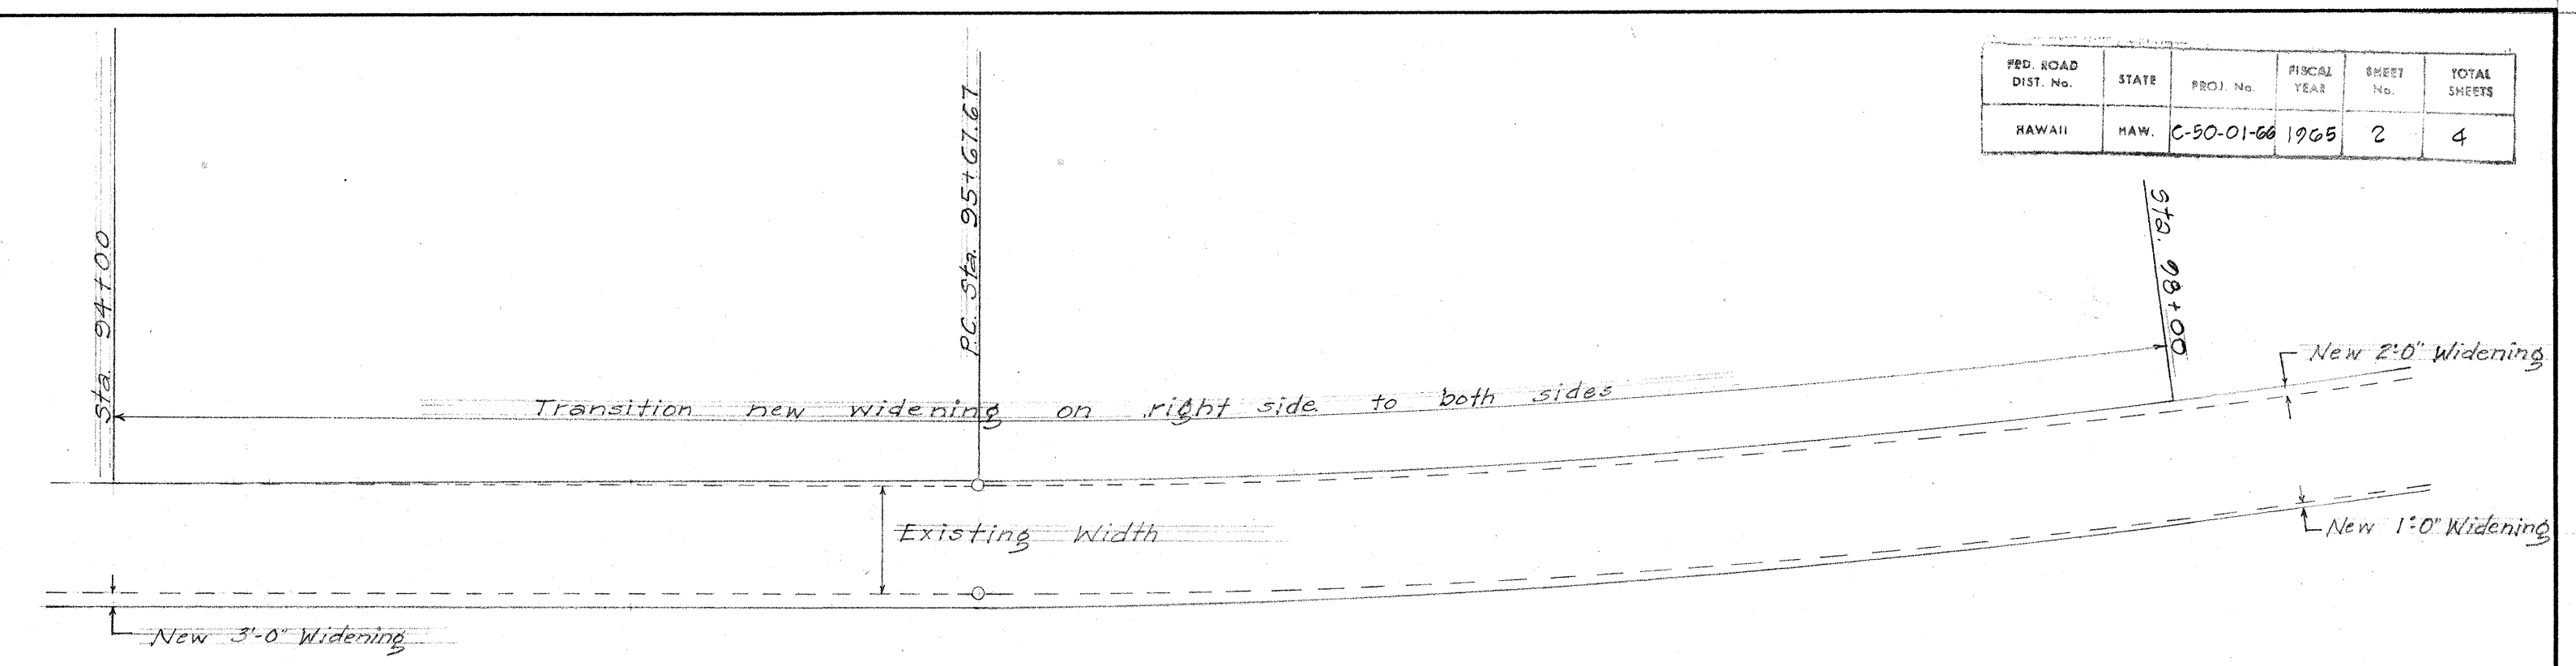
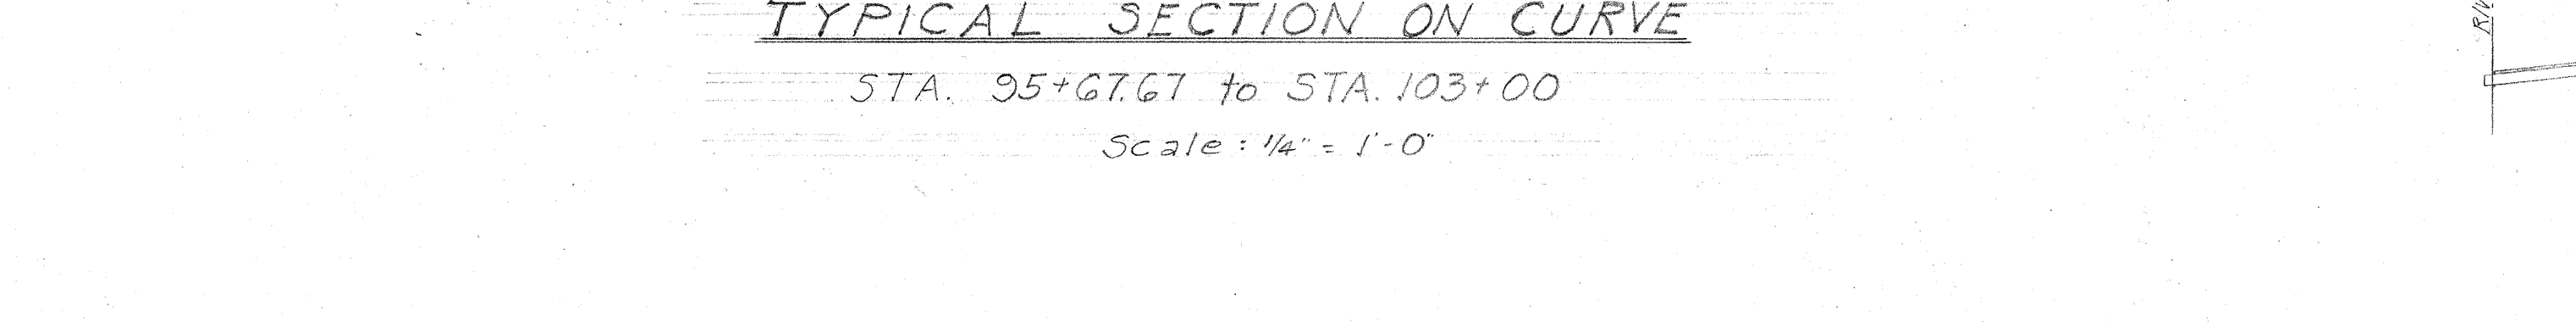
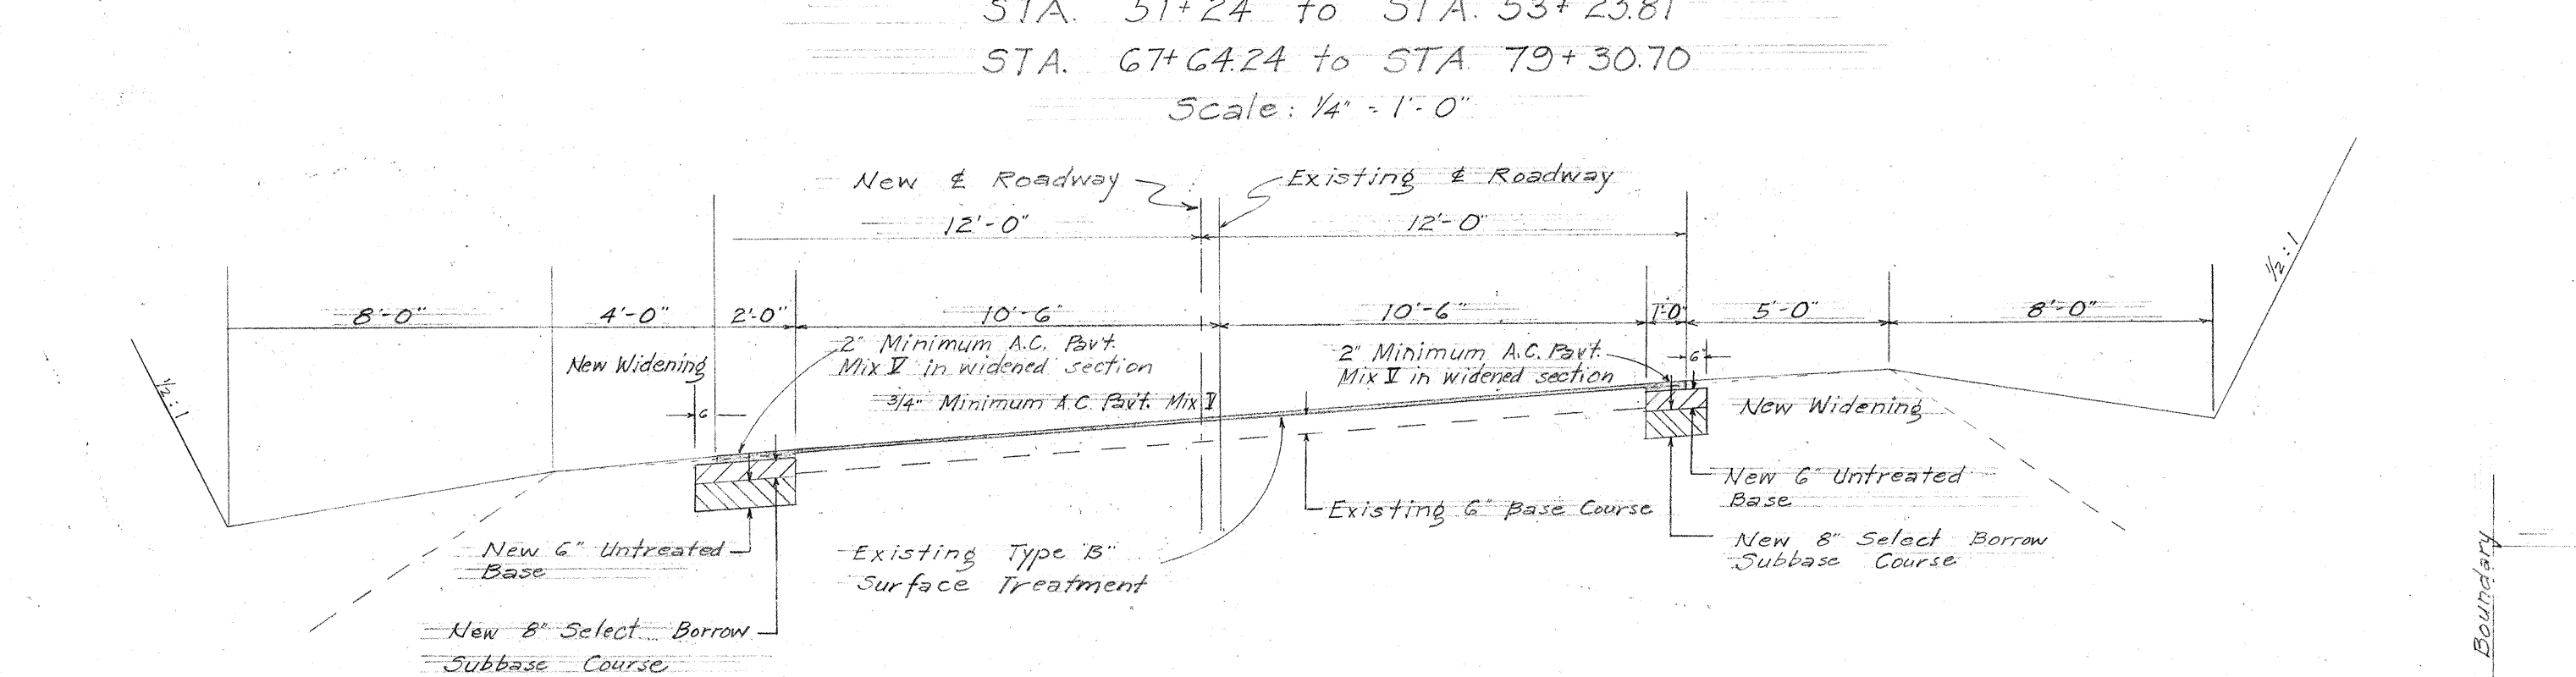
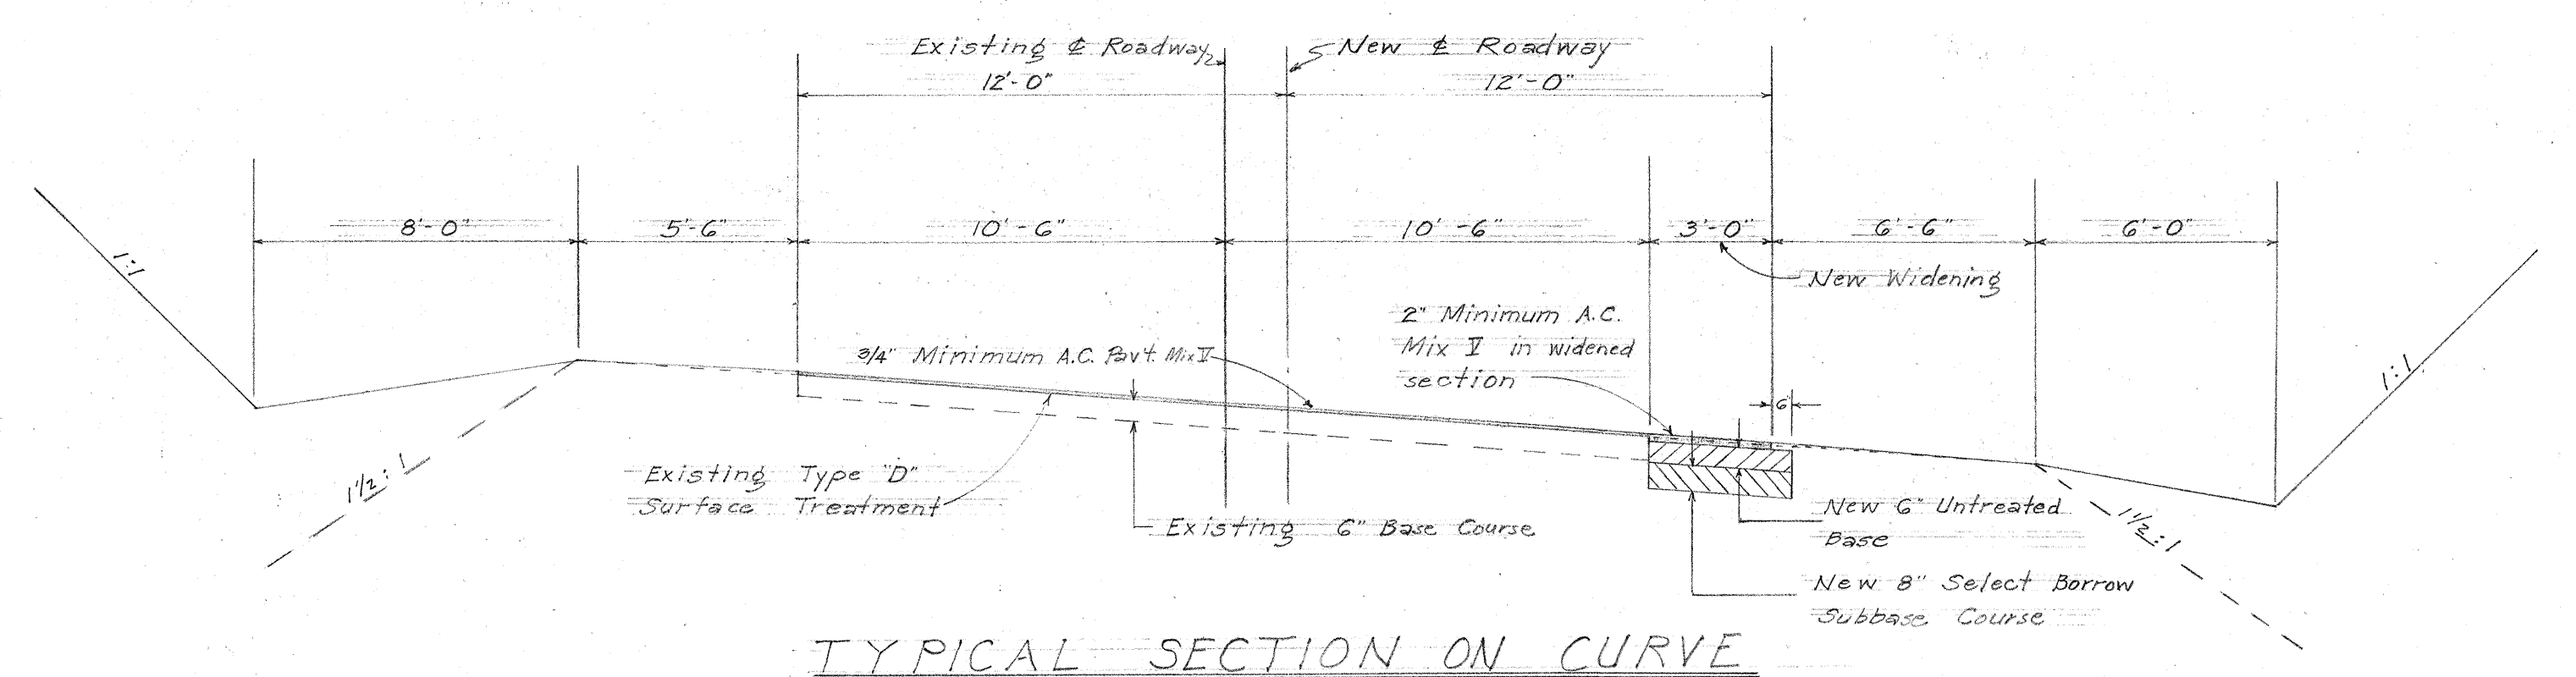
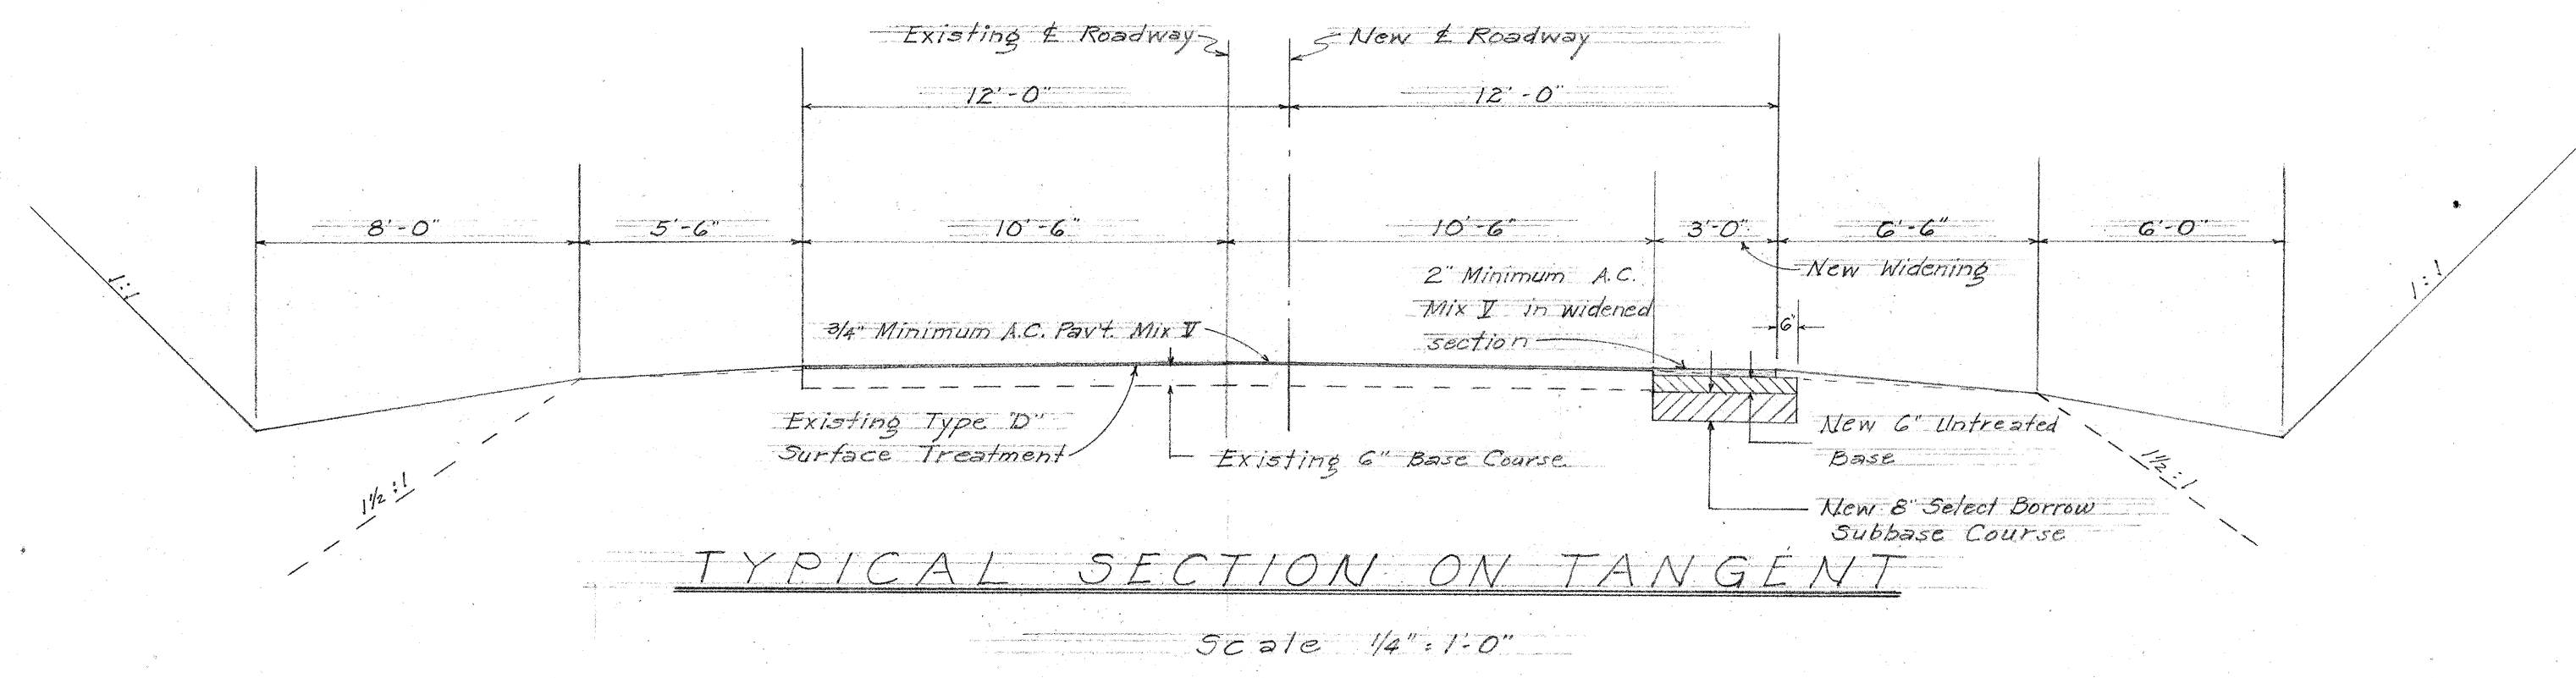
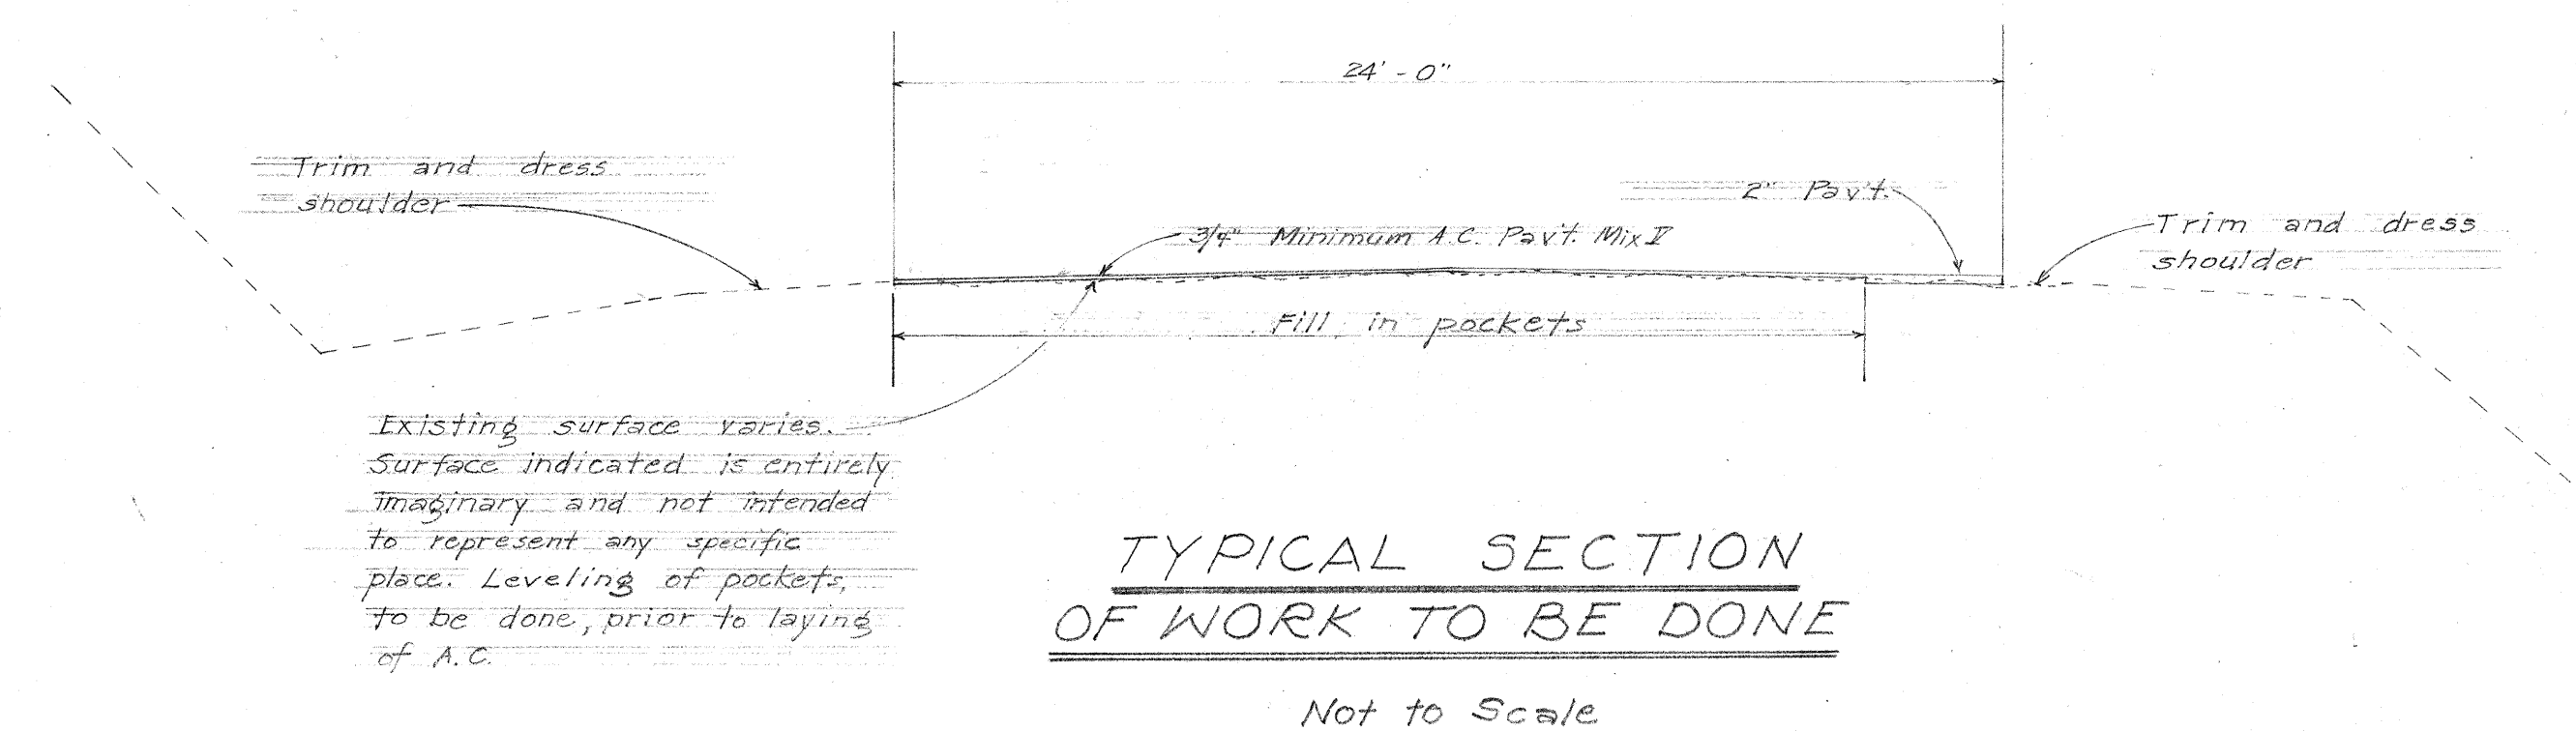


PROJ. NO.	STATE	FISCAL YEAR	SHEET NO.	TOTAL SHEETS
C-50-01-66	HAW.	1965	2	4

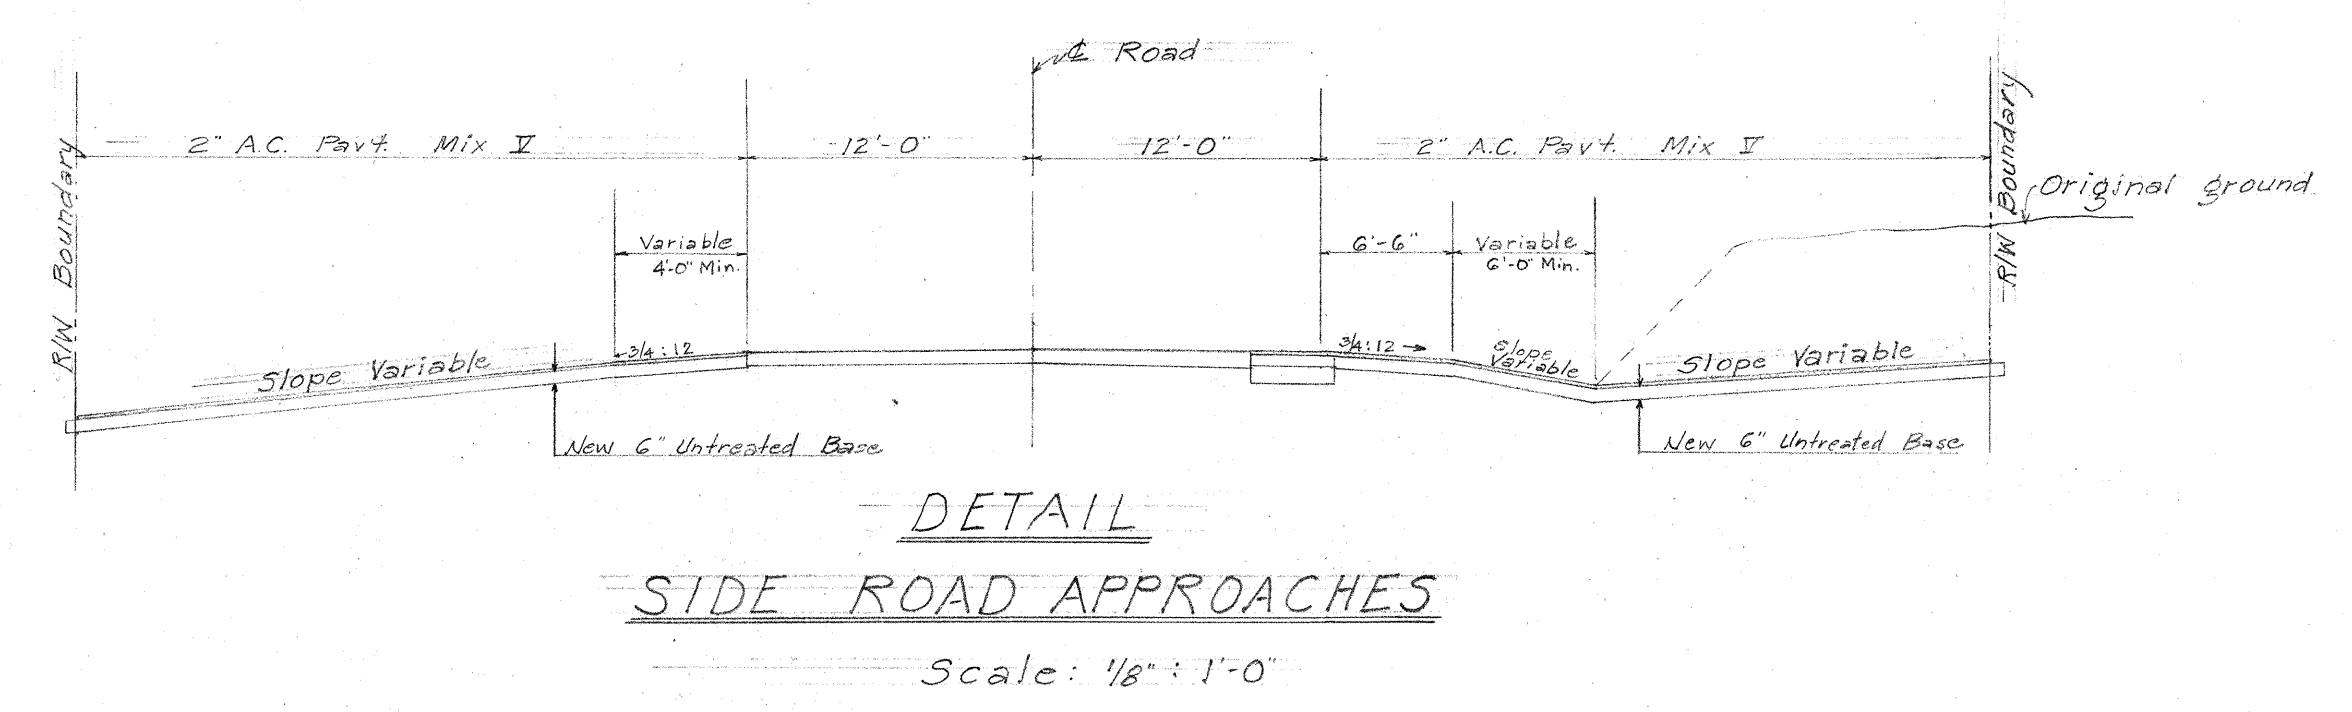

- Note:
1. Tractor crossing shall conform to pavement grade and crown.
 2. Excavation, doweled & wire mesh reinf. for tractor crossings shall be incidental to Class A-1' Concrete.
 3. Sides of tractor crossing in contact with basecourse & A.C. shall be sloped outward, in depth, at a rate of 2:12.

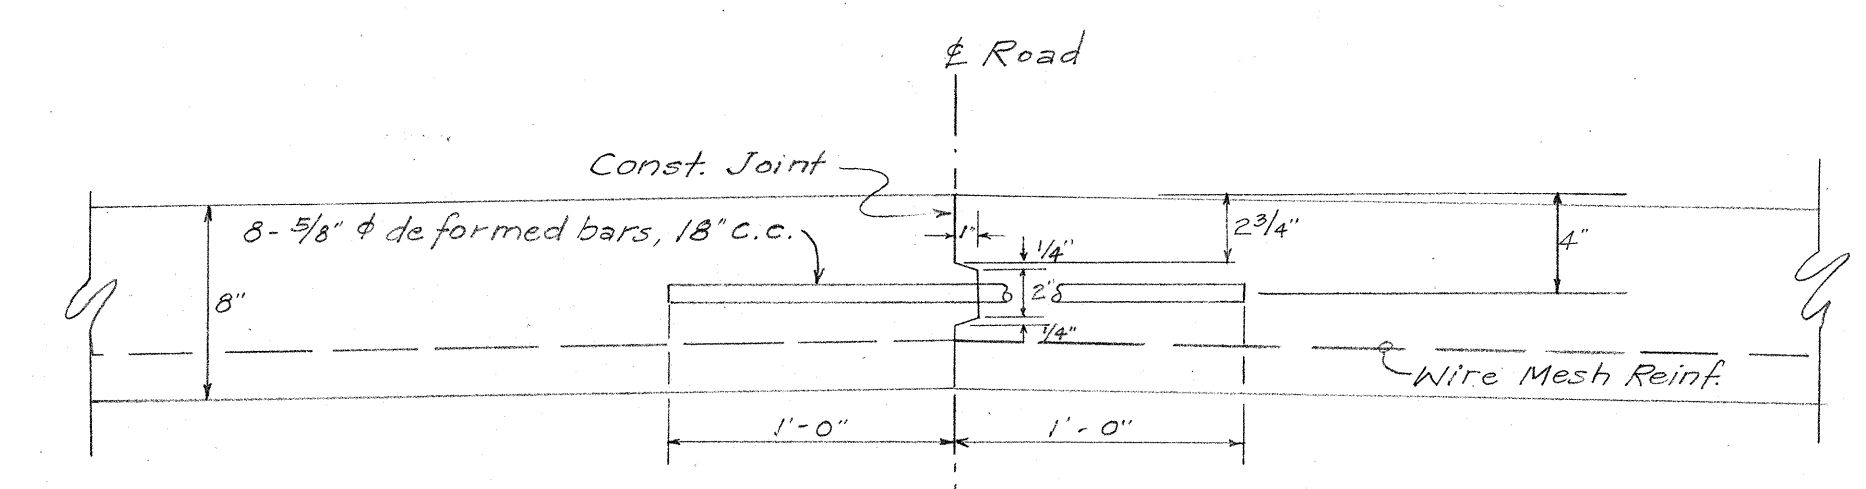

DEPARTMENT OF TRANSPORTATION
HIGHWAYS DIVISION
STATE OF HAWAII
TYPICAL SECTIONS
KAUAI BELT ROAD
WIDENING & RESURFACING
PROJ. NO. C-50-01-66
Scale: As Shown Date: Oct, 1965