


PLAN	SURVEYED _____	BY _____	DATE _____
	PLOTTED _____		
	NOTE BOOK _____		
	ALIGNMENT CHECKED _____		
NO. _____	RT. OF WAY CHECKED _____		

PROFILE	BY	DATE
SURVEYED		
PLOTTED		
GRADES CHECKED		
B. I. & S. NOTED		
NO.		
STRUCTURE NOTATIONS CH'D.		

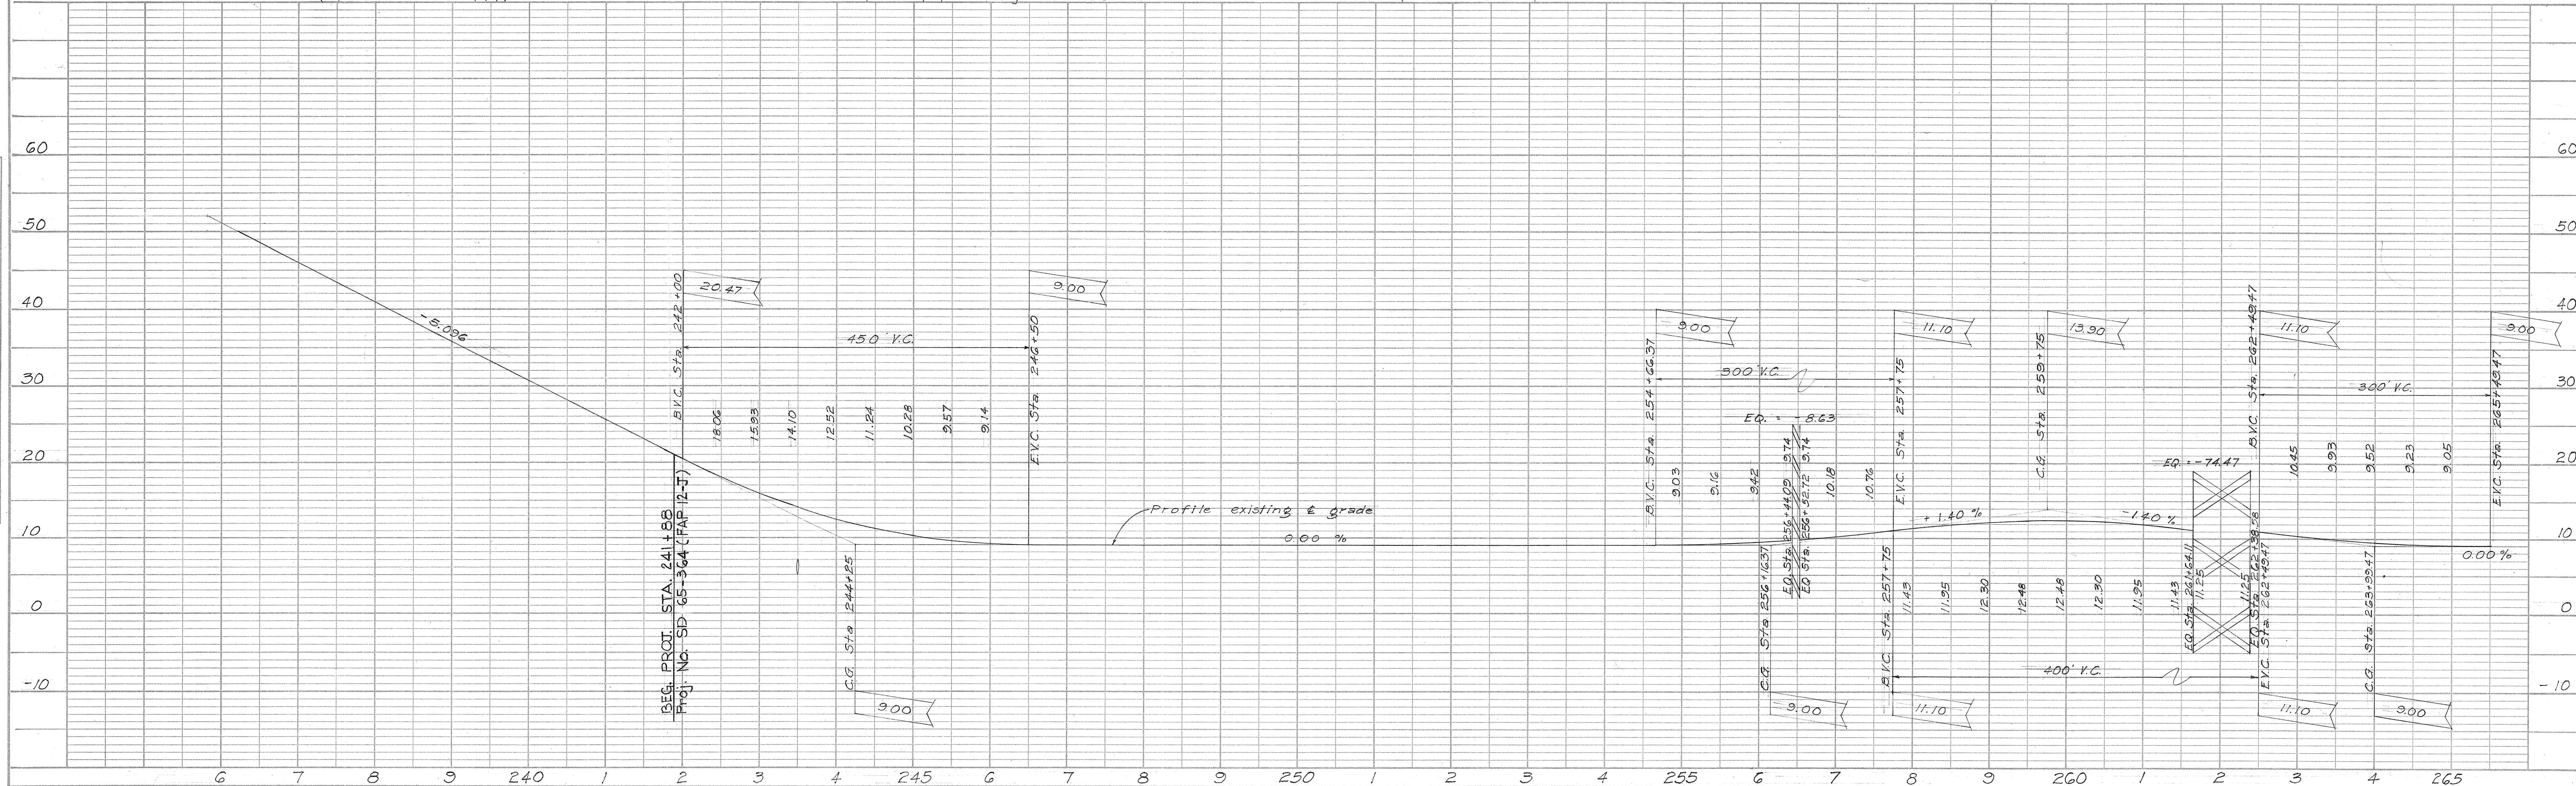


DATE _____ BY _____
 SURVEYED _____
 PLOTTED _____
 CHECKED _____
 REVISIONS _____
 NO. _____

DATE _____ BY _____
 SURVEYED _____
 PLOTTED _____
 CHECKED _____
 REVISIONS _____
 NO. _____

Construct driveways as shown. See typical detail, sheet no. 2

STA.	Approx. Width	E.P. Rad.	B.C.	A.C.	Exc.
267 + 73-Rt.	10'	10'	10'	41 sy.	37 sy. 9 cy.
269 + 76-Lt.	10'	10'	10'	41 sy.	37 sy. 9 cy.
270 + 05-Rt.	22'	20'	12'	86 sy.	80 sy. 19 cy.

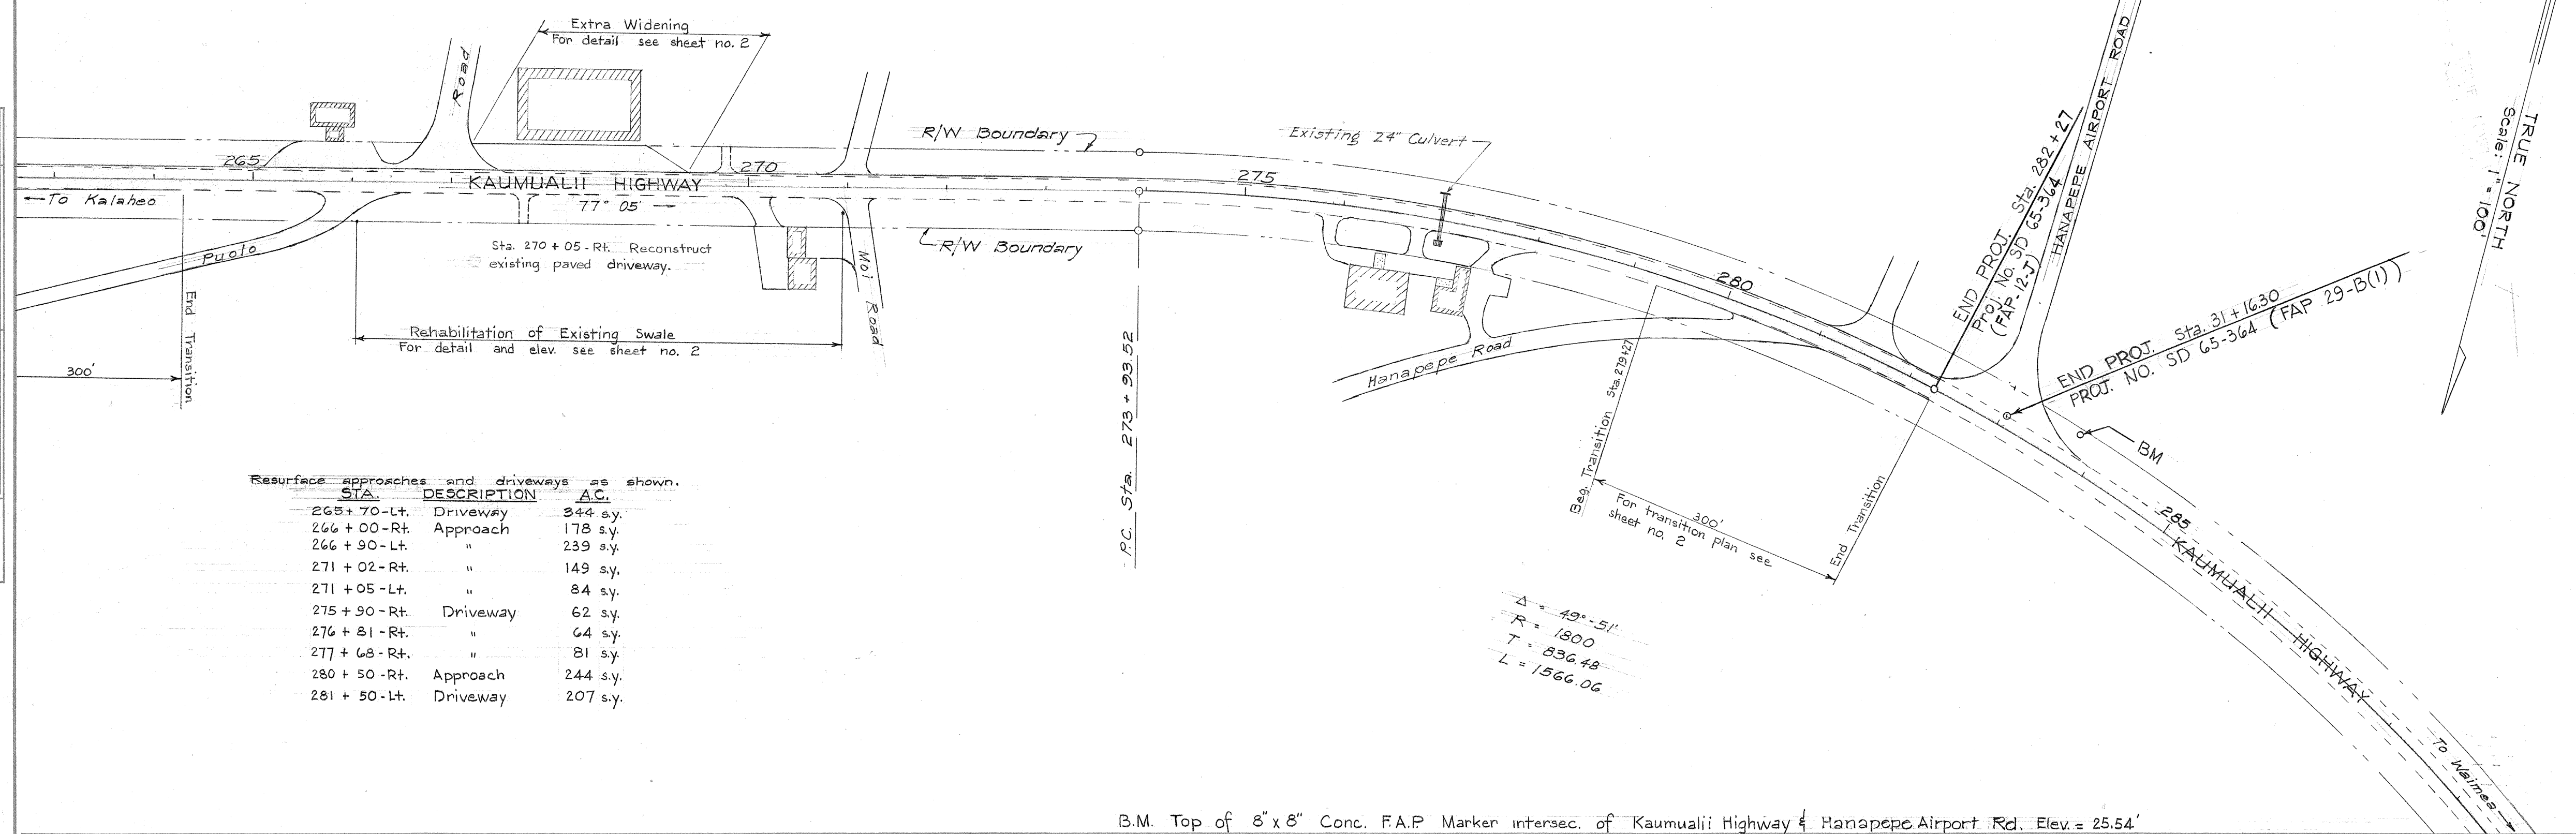


Resurface approaches and driveways as shown.

STA.	DESCRIPTION	A.C.
265 + 70-Lt.	Driveway	344 sy.
266 + 00-Rt.	Approach	178 sy.
266 + 90-Lt.	"	239 sy.
271 + 02-Rt.	"	149 sy.
271 + 05-Lt.	"	84 sy.
275 + 90-Rt.	Driveway	62 sy.
276 + 81-Rt.	"	64 sy.
277 + 68-Rt.	"	81 sy.
280 + 50-Rt.	Approach	244 sy.
281 + 50-Lt.	Driveway	207 sy.

Δ = 49° 51'
 R = 1800
 T = 836.48
 L = 1566.06

B.M. Top of 8" x 8" Conc. F.A.P. Marker intersec. of Kaumualii Highway & Hanapepe Airport Rd. Elev. = 25.54'

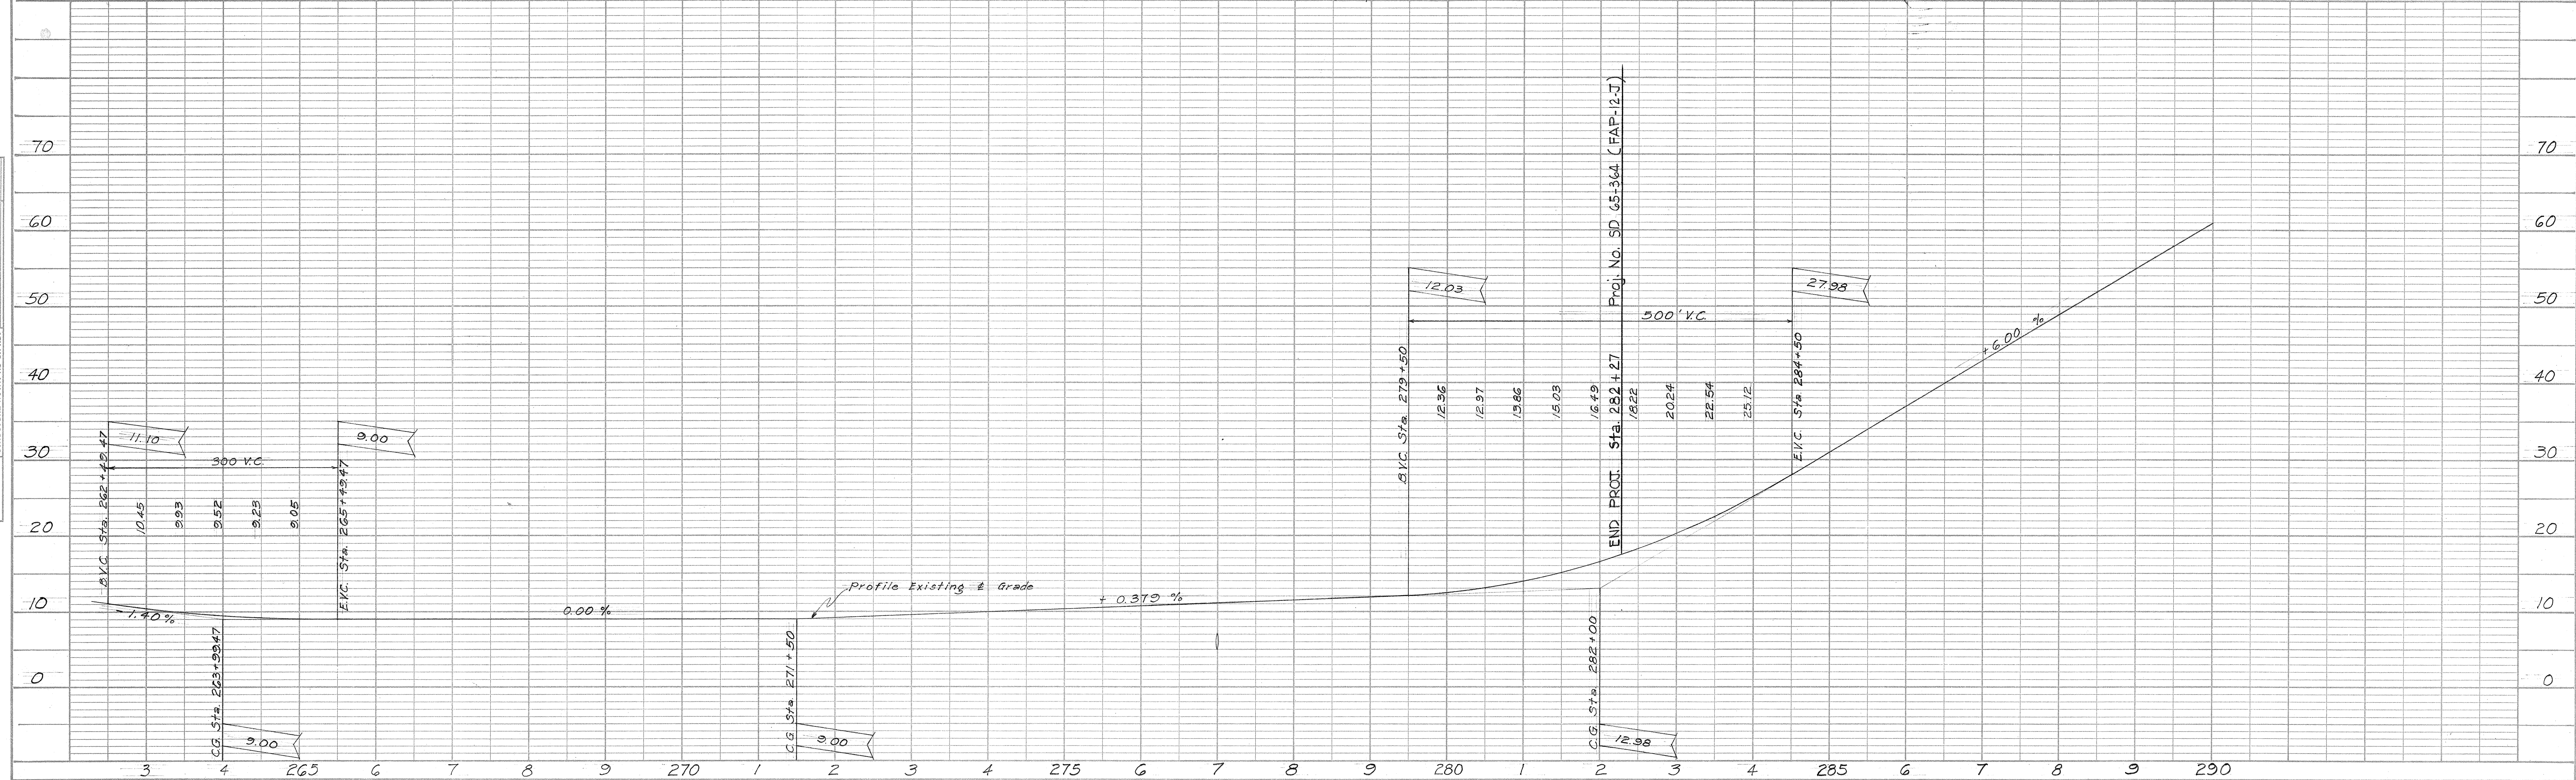

PLAN	SURVEYED	DATE
	BY	
PROFILE	NOTED	DATE
	BY	
NOTE: BOOK ALIGNMENT CHECKED.		
NO. OF WAY CHECKED.		
NO.		

PROFILE	SURVEYED	DATE
	BY	
PLAN	NOTED	DATE
	BY	
NOTE: BOOK ALIGNMENT CHECKED.		
NO. OF WAY CHECKED.		
NO.		

FED. ROAD DIST. NO.	STATE	FED. AID PROJ. NO.	FISCAL YEAR	SHEET NO.	TOTAL SHEETS
HAWAII	HAW.	SD65-364	1966	5	5

