


INDEX TO DRAWINGS	
SHEET NO.	DESCRIPTION
1	Title Sheet
2	Typical Sections
3	Details of Bus Stops


STATE OF HAWAII
DEPARTMENT OF TRANSPORTATION
HIGHWAYS DIVISION
"AS BUILT" PLANS FOR
RESURFACING OF A PORTION OF
KAUAI BELT ROAD
(KALAHEO TOWARD KNUDSEN GAP)

PROJECT NO. 50D-01-67
DISTRICT OF KOLOA
ISLAND OF KAUAI

CONVENTIONAL	SIGNS
Baseline	7.5
Boundary Line	
Fences (Named)	—x—x—x—x—x—
Existing Roadway	— — — — —
Pipe Culvert	— [] —
Box Culvert	— [] —
Telephone Line & Pole	— T — T —
Electric Line & Pole	— E — E —
Water Main	— W ₁ — W ₁ —

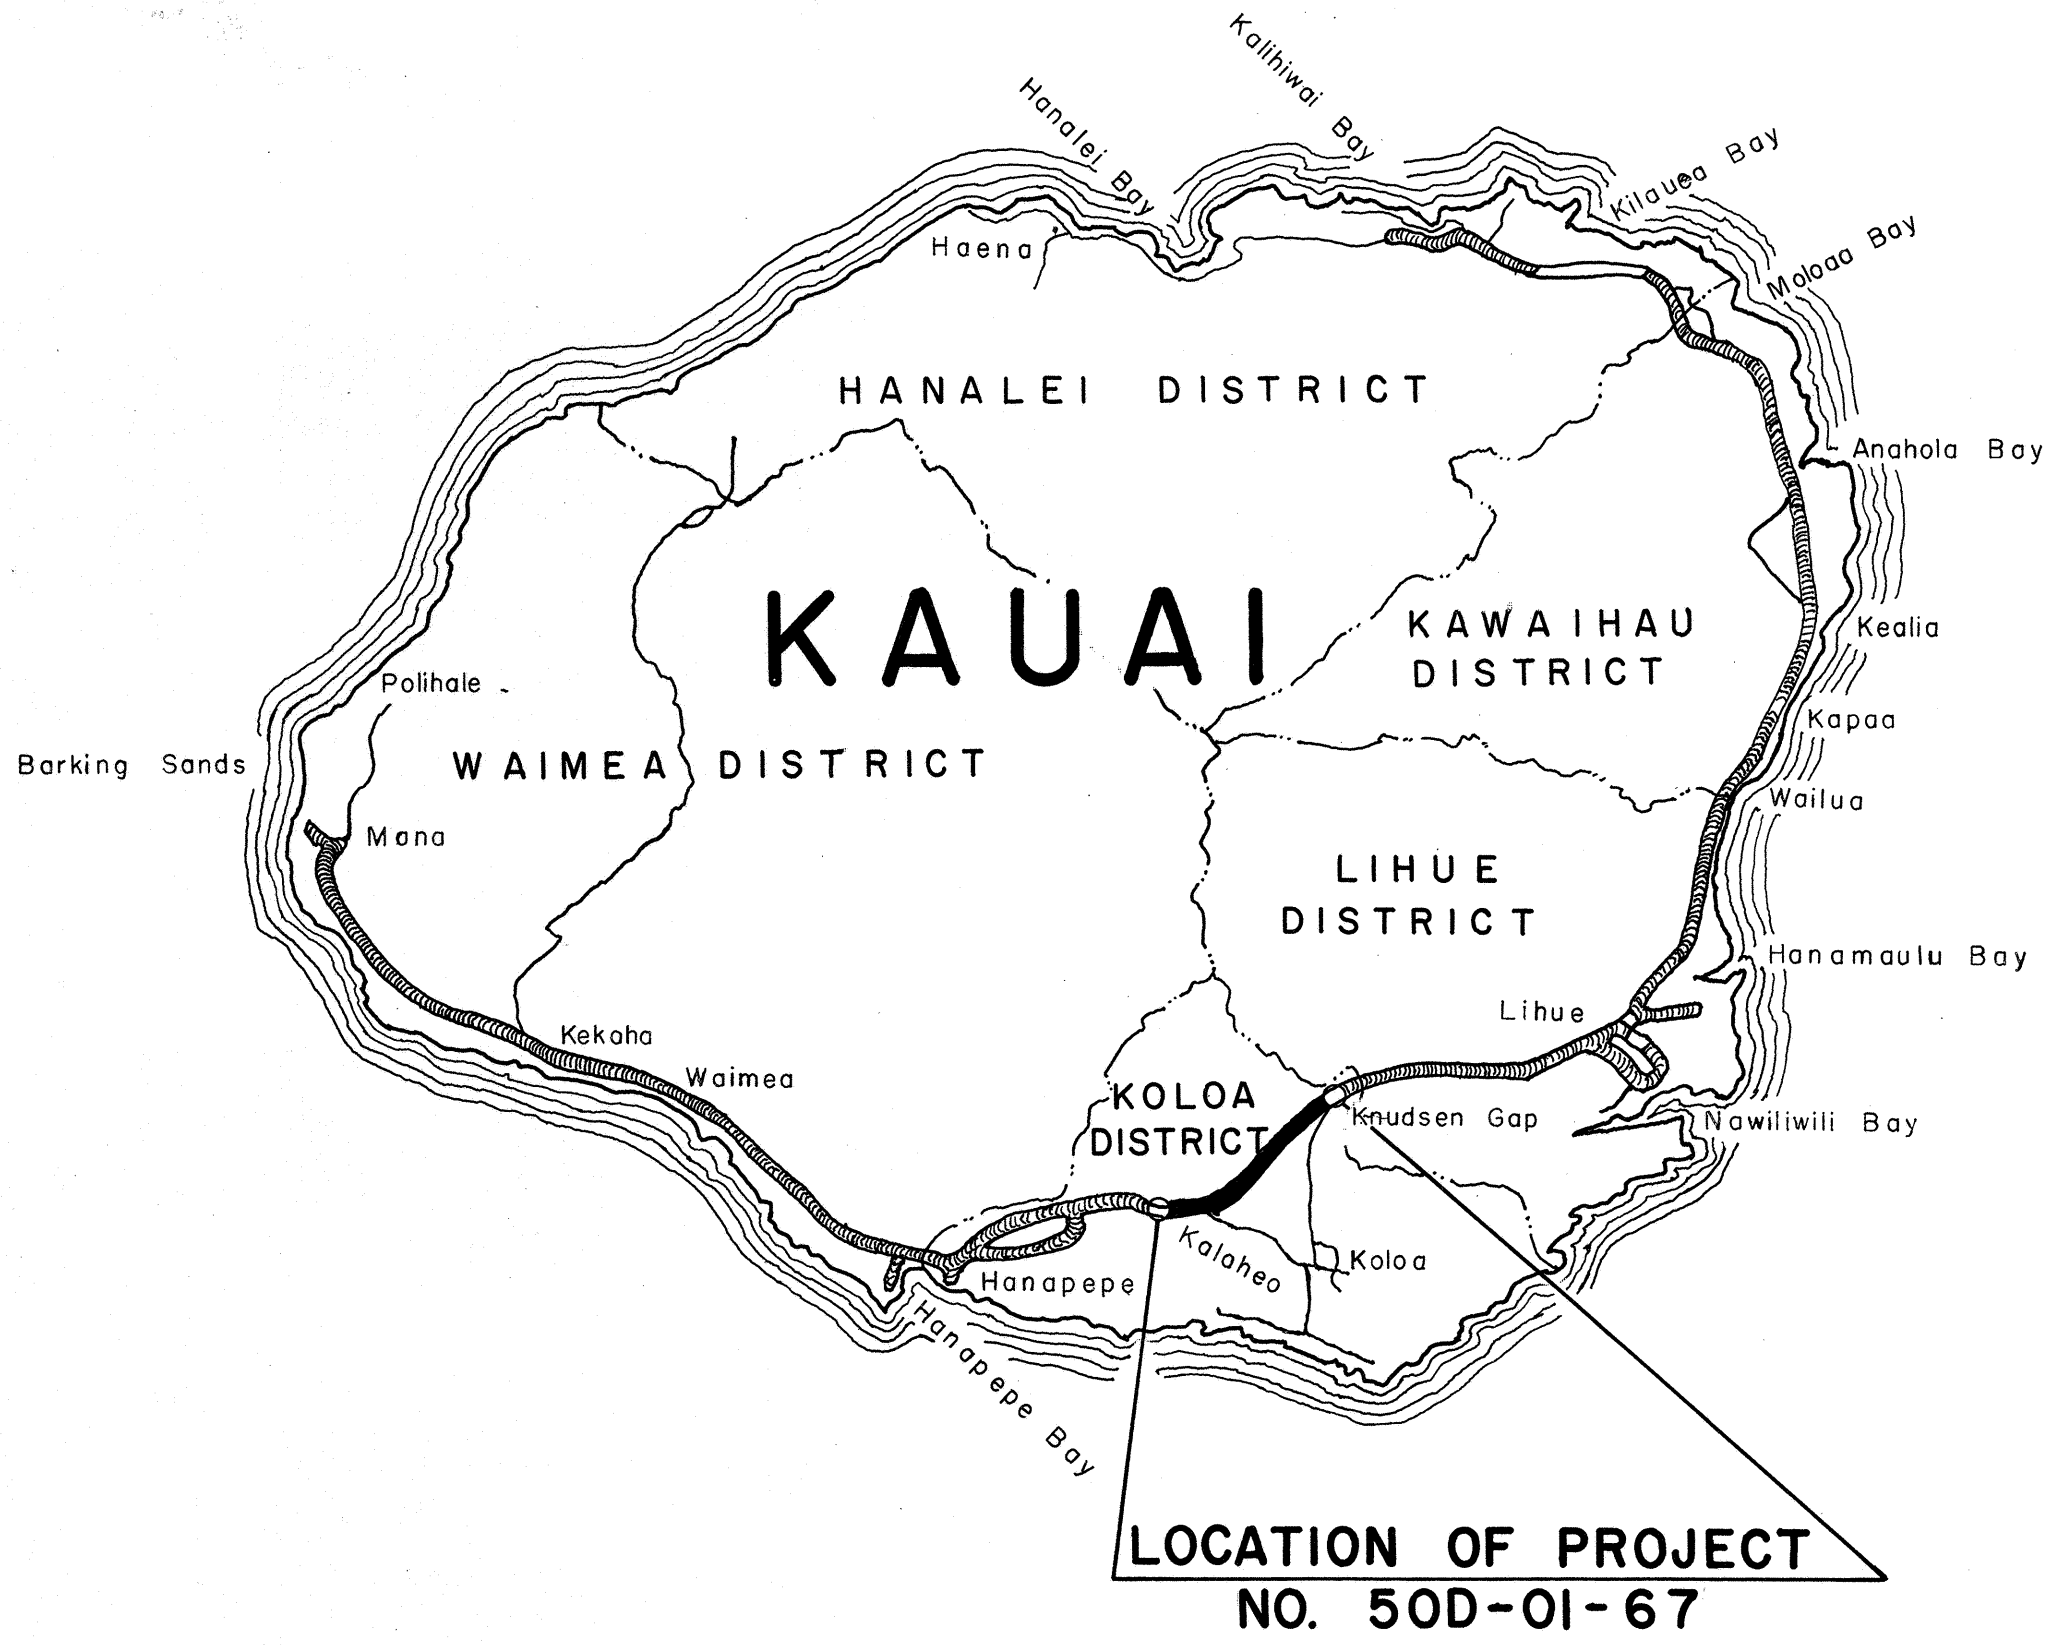

FEDERAL AID PROJECTS PREVIOUSLY CONSTRUCTED OR UNDER CONSTRUCTION

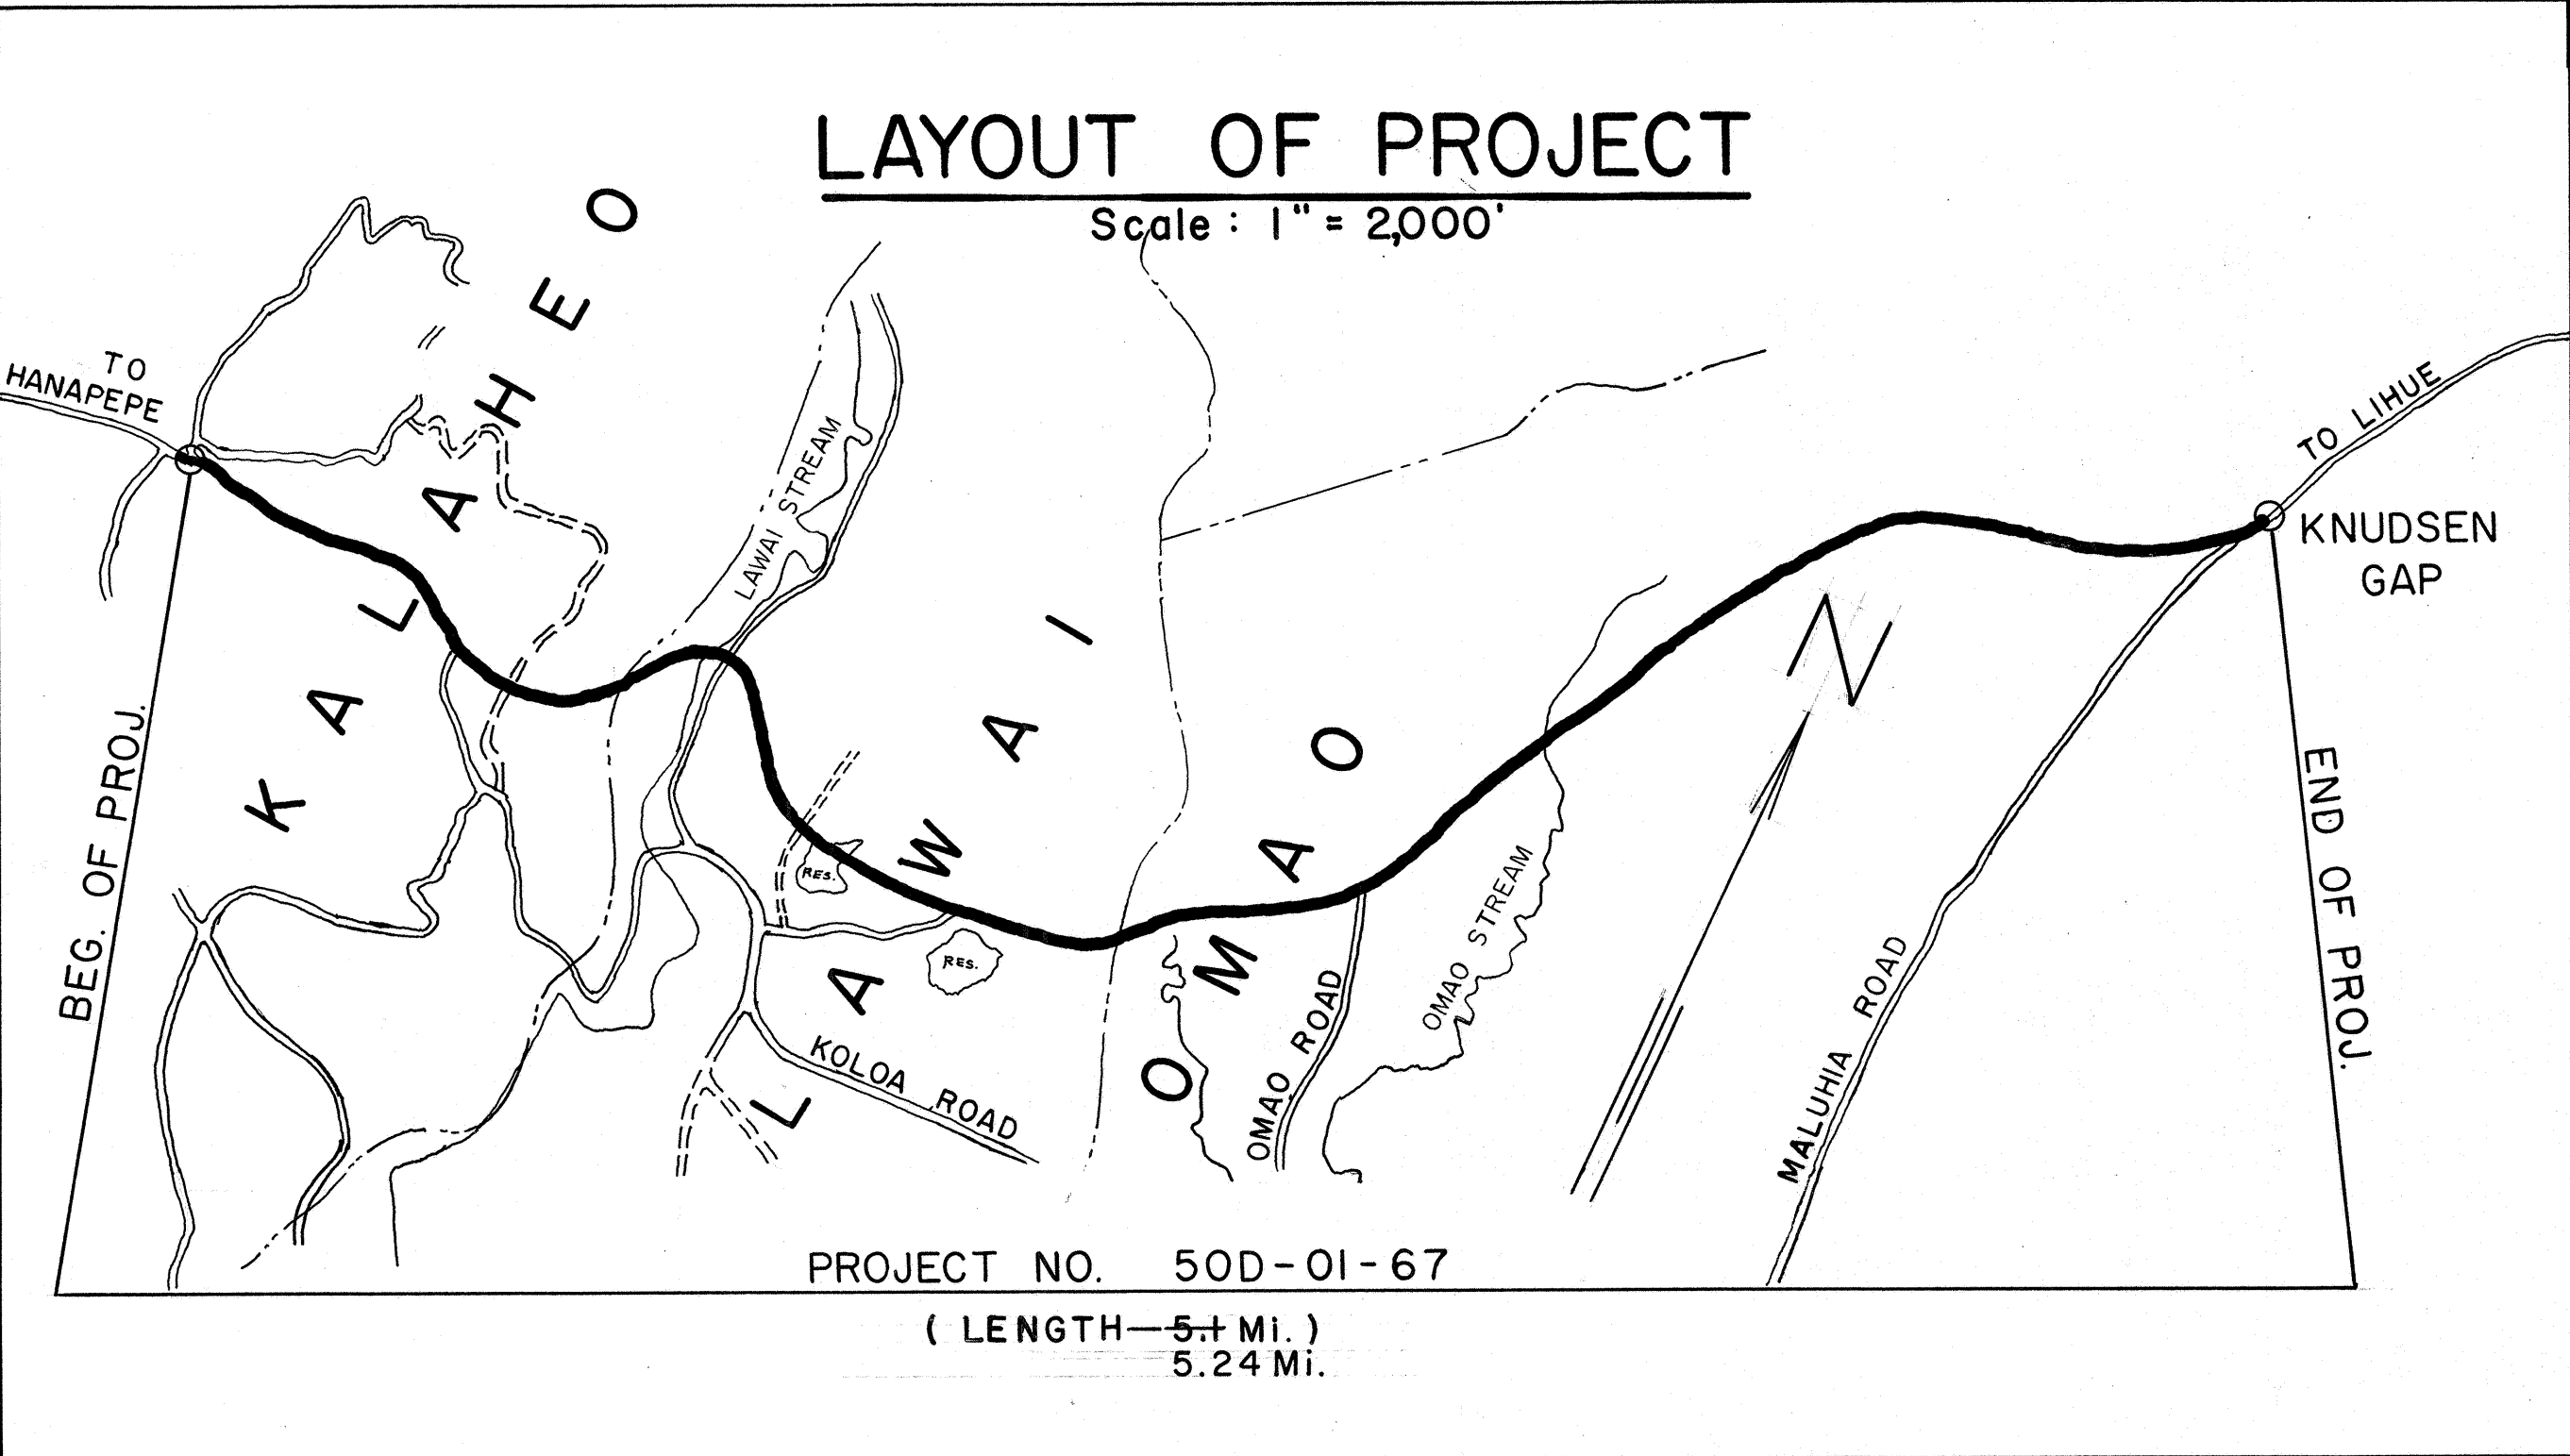

NOTE:
ALL CHANGES MADE DURING CONSTRUCTION
HAVE BEEN NOTED ON THESE TRACINGS IN
RED AND CHECKED BY:

Shigeo Yamaguchi
PROJECT ENGINEER
3/14/68
DATE

APPROVED: *John M. Am* 8-18-66
DATE
for DIRECTOR OF TRANSPORTATION

DESIGNED BY ROY OISHI
AUGUST 1966