
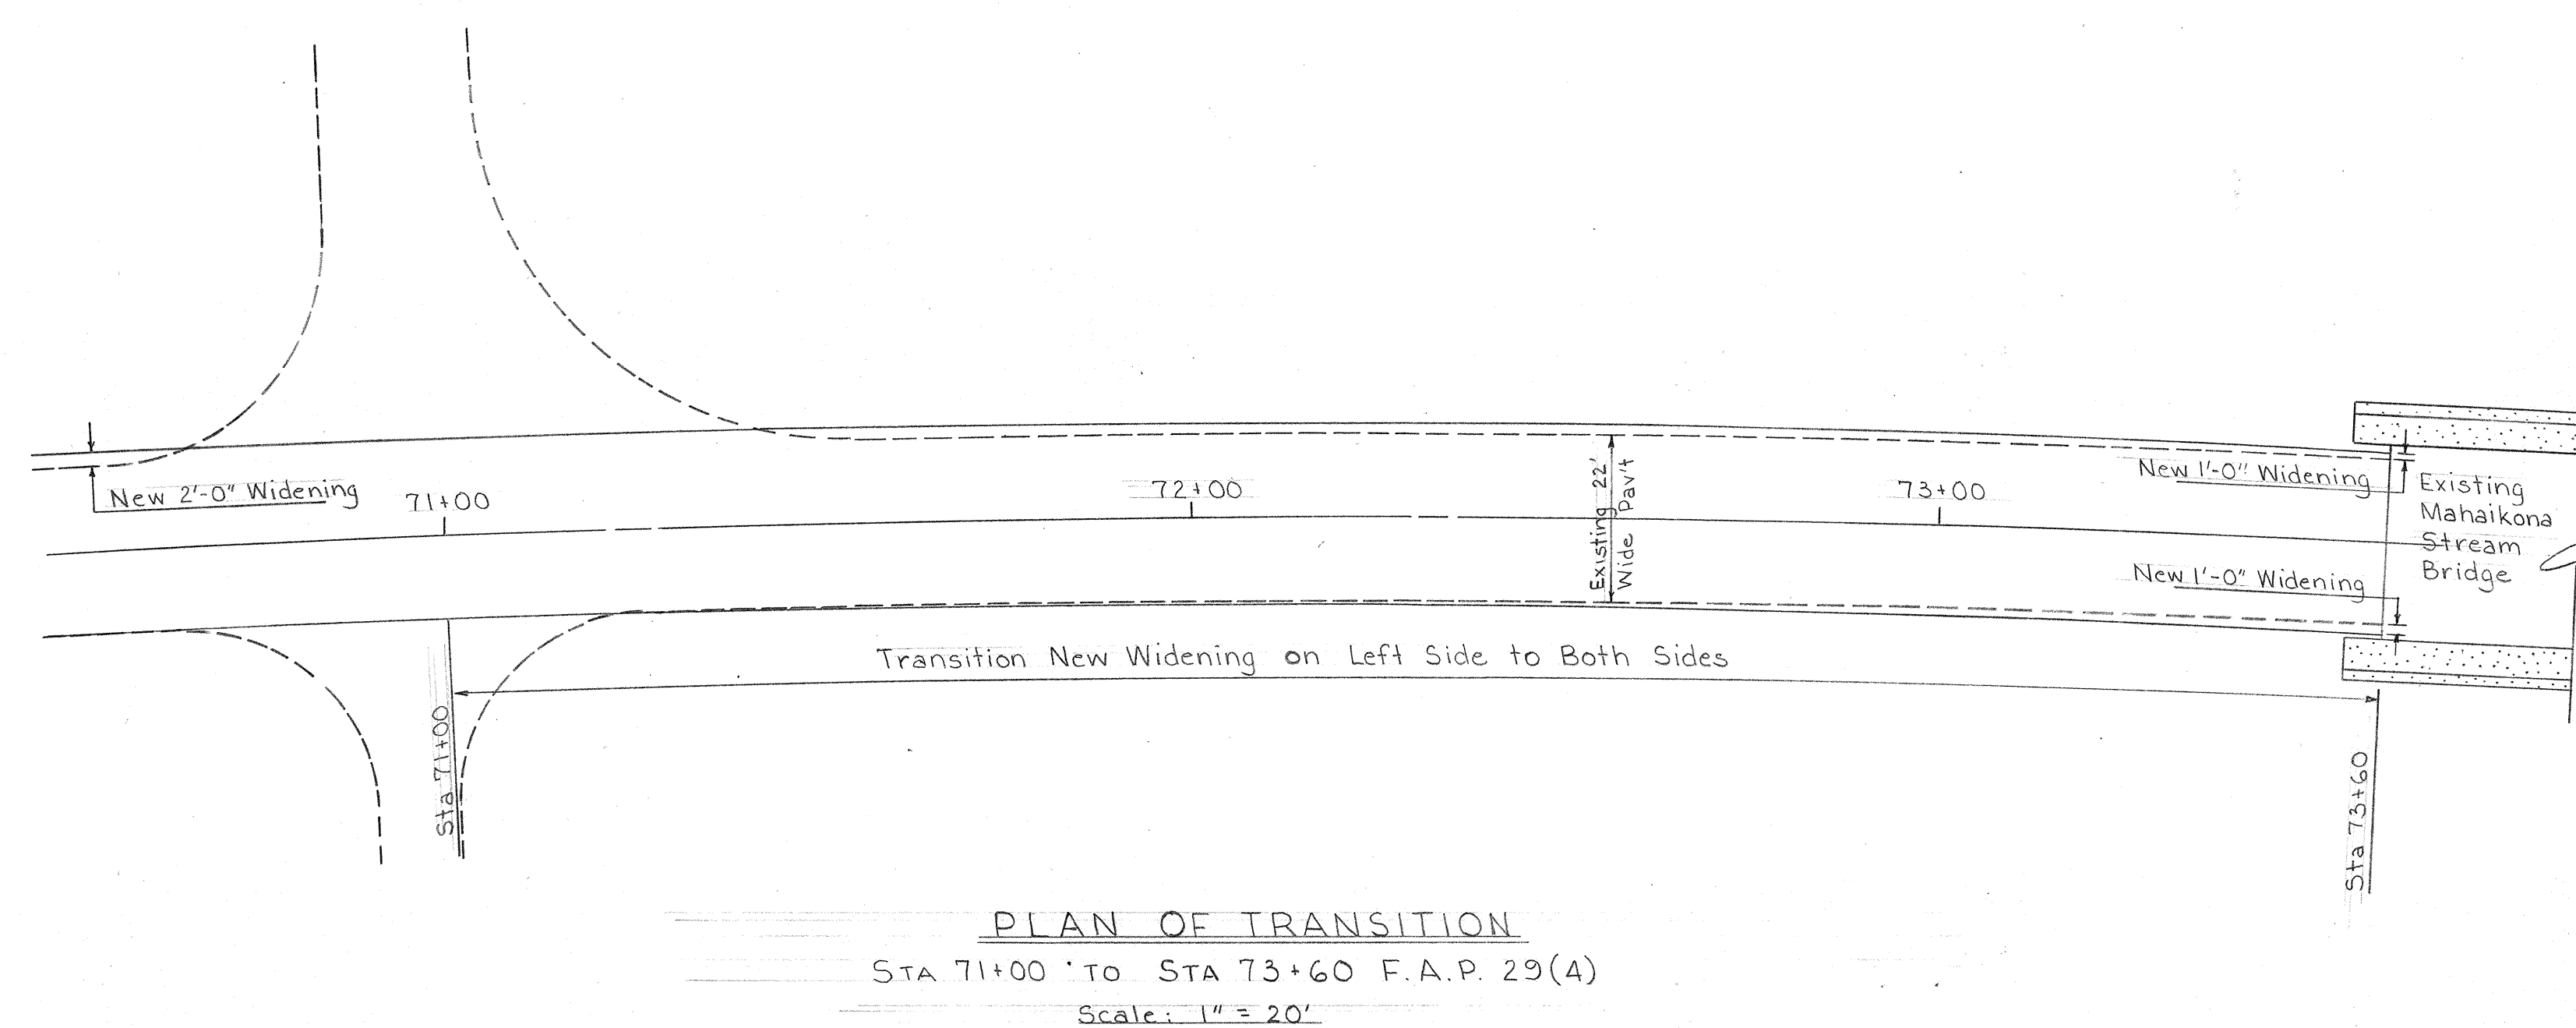
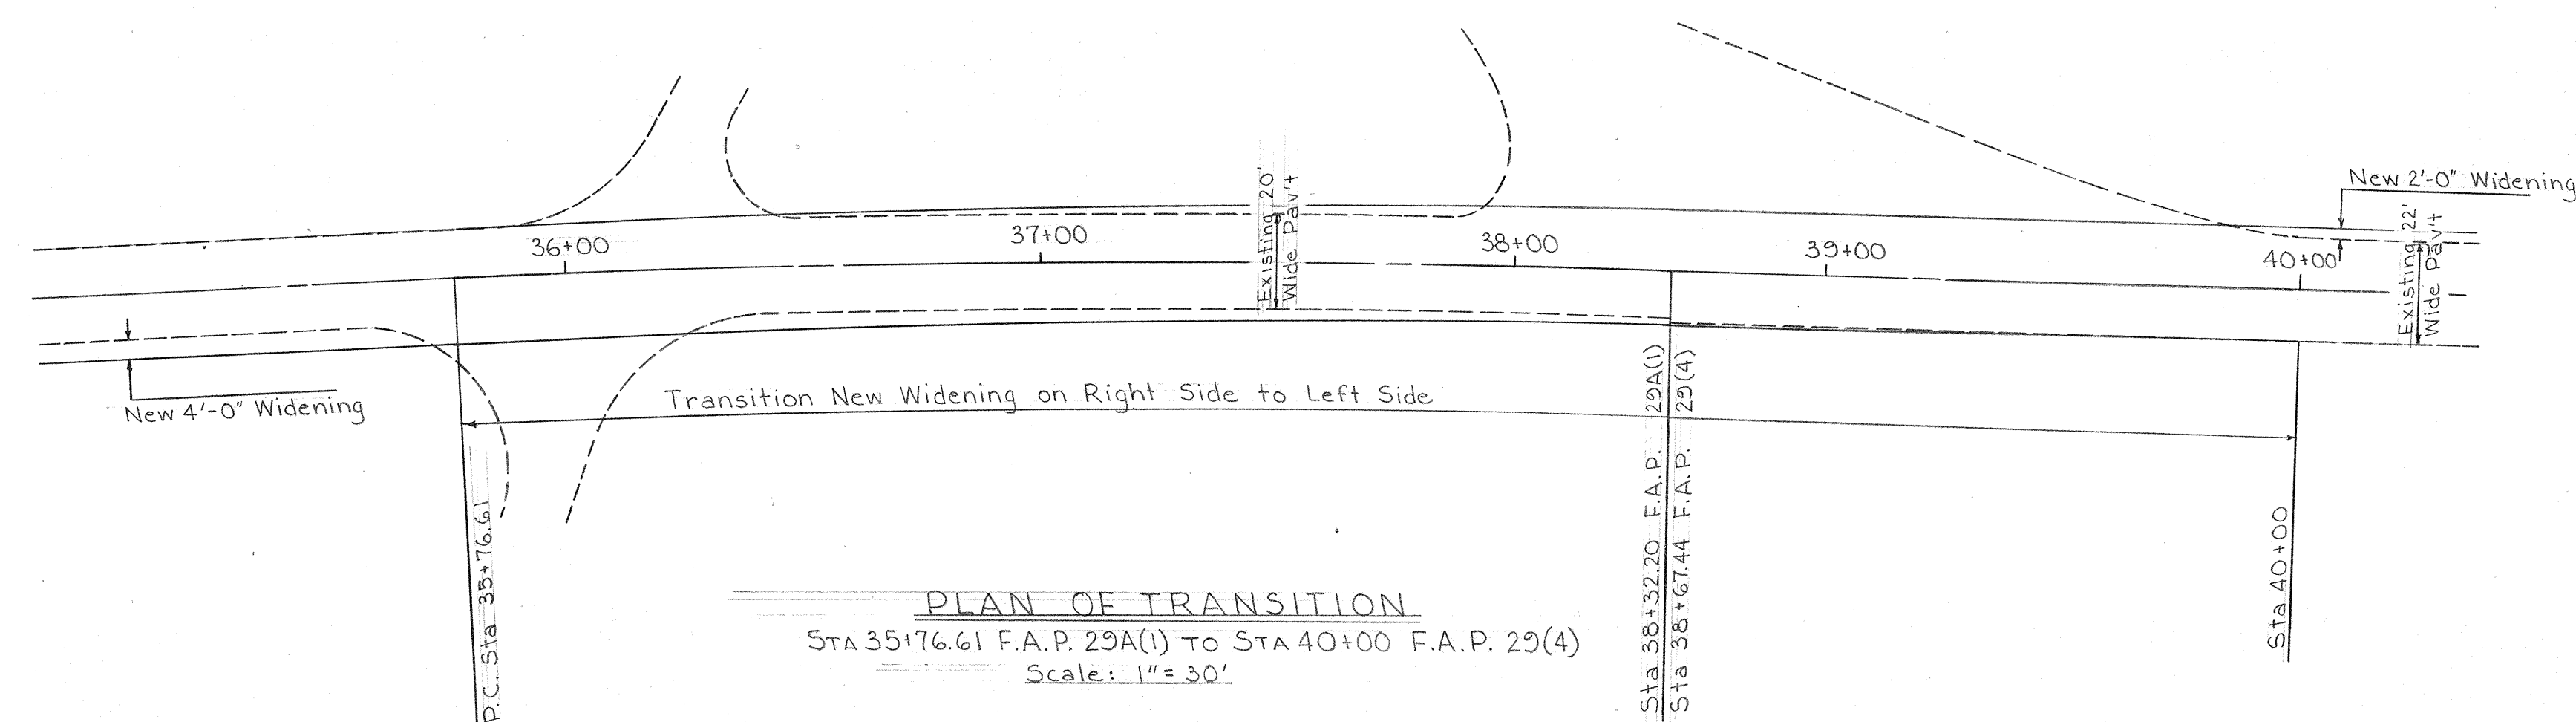


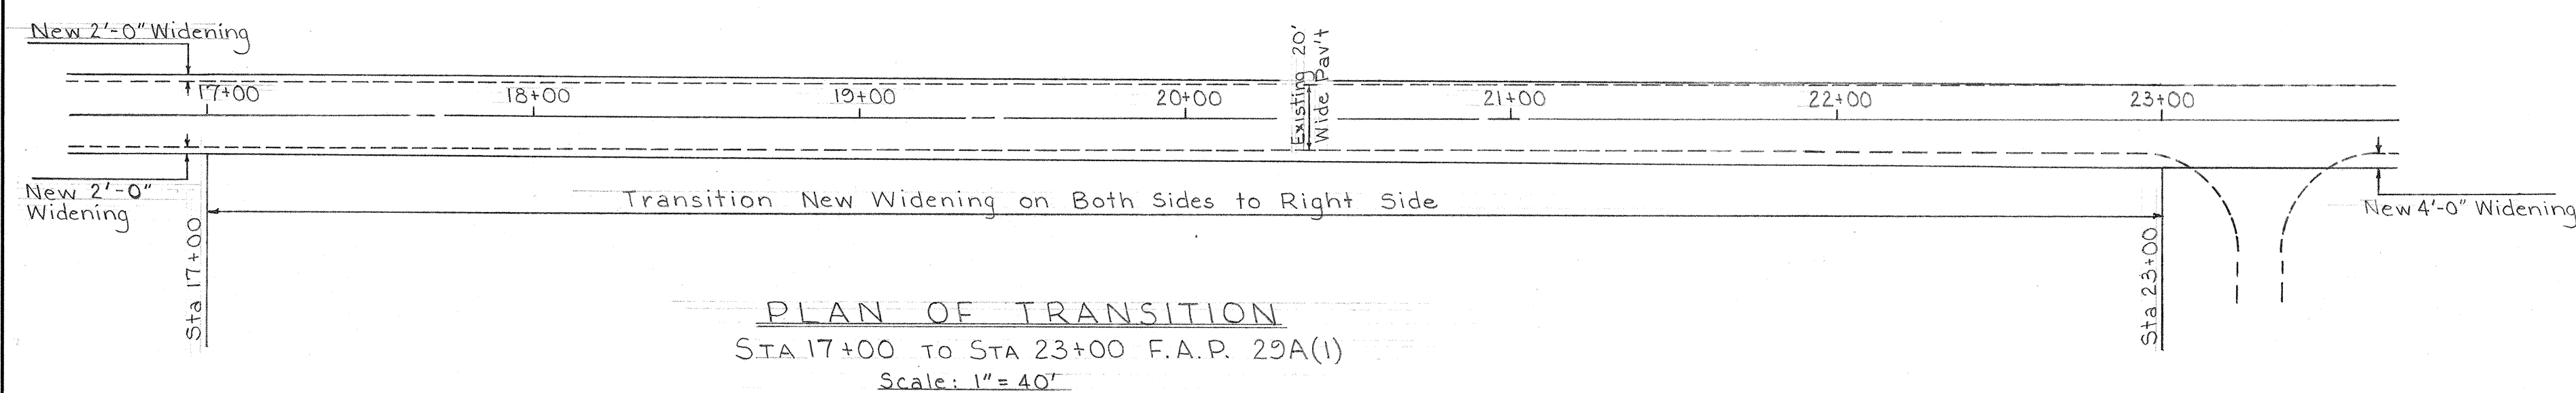

DEPT. OF TRANSPORTATION
HIGHWAYS DIVISION
STATE OF HAWAII

MISCELLANEOUS DETAILS

KAUAI BELT ROAD
PROJ. NO. 50B-01-67

Scale: As shown Date: July, 1966