



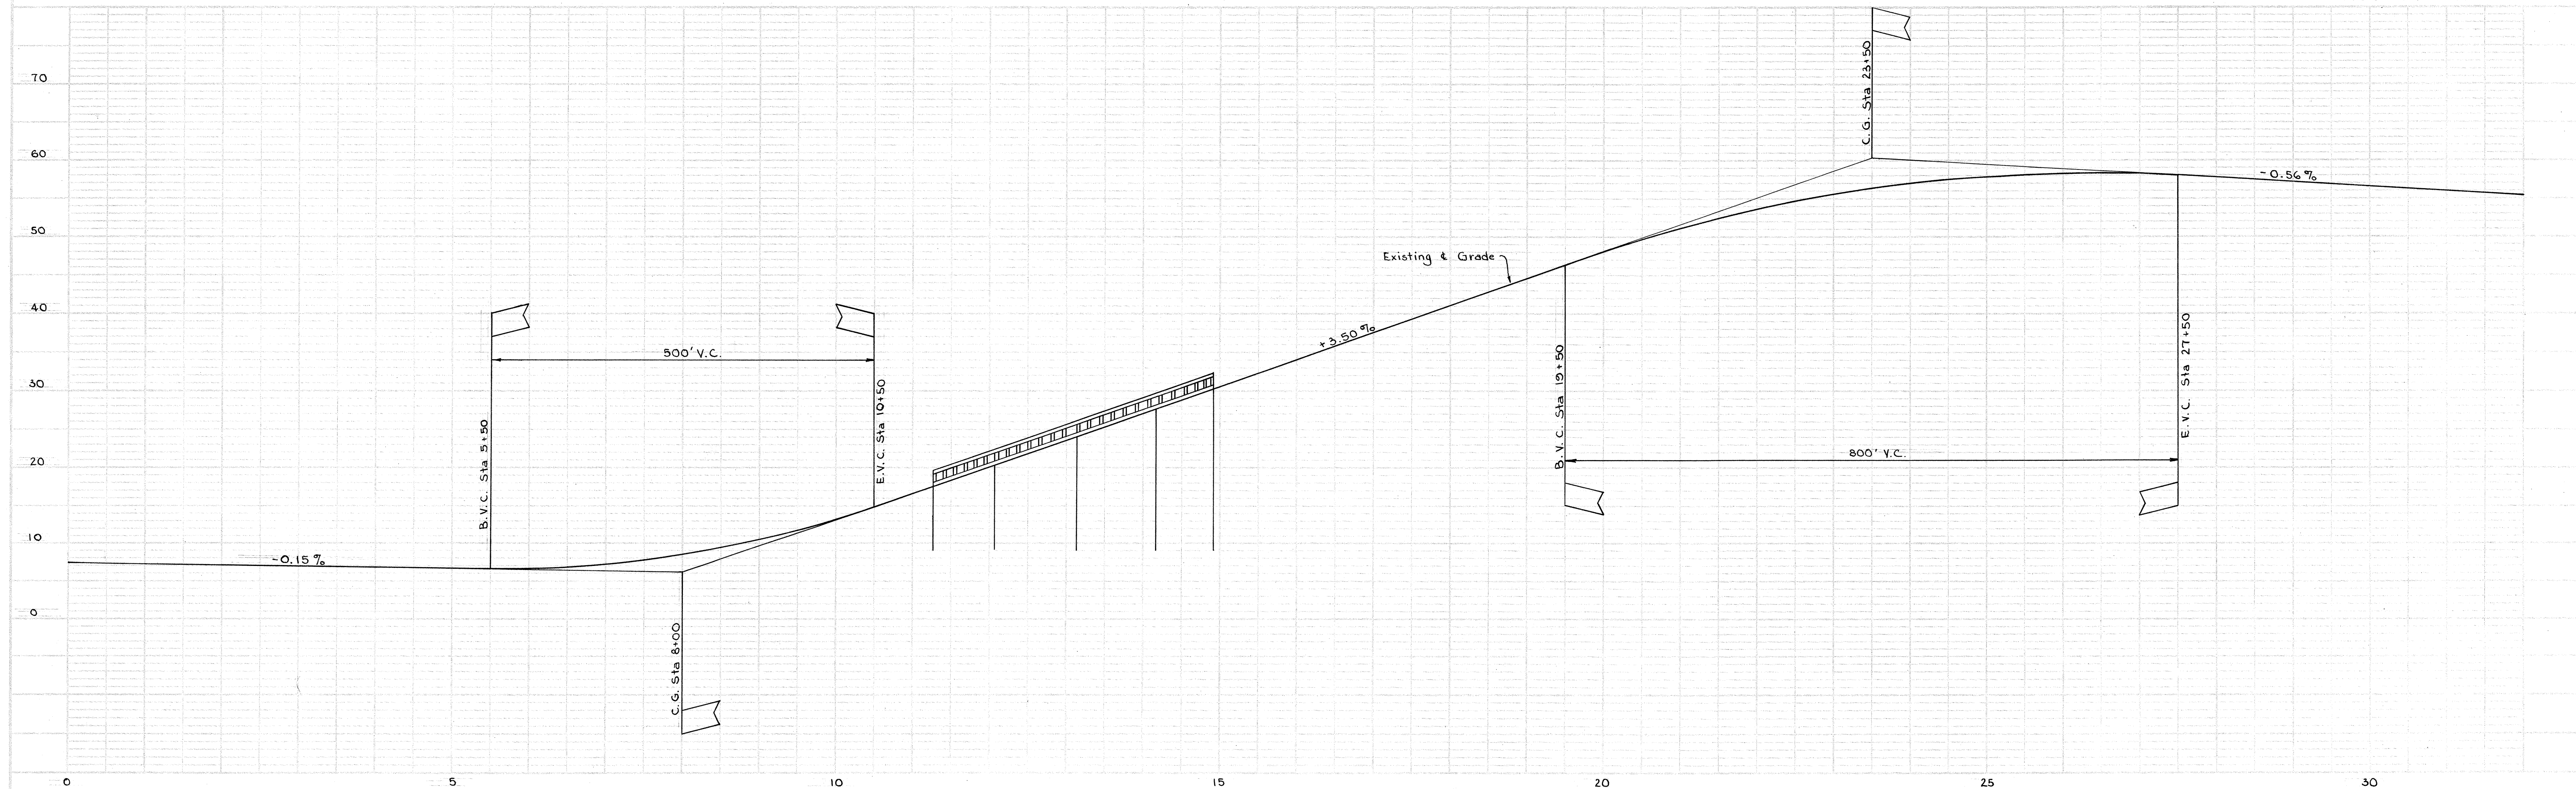


DATE	BY
SURVEYED	
ALIGNED	
NOTE BOOK	
PT. OF WAY CHECKED	
NO.	


DATE	BY
SURVEYED	
ALIGNED	
NOTE BOOK	
PT. OF WAY CHECKED	
NO.	

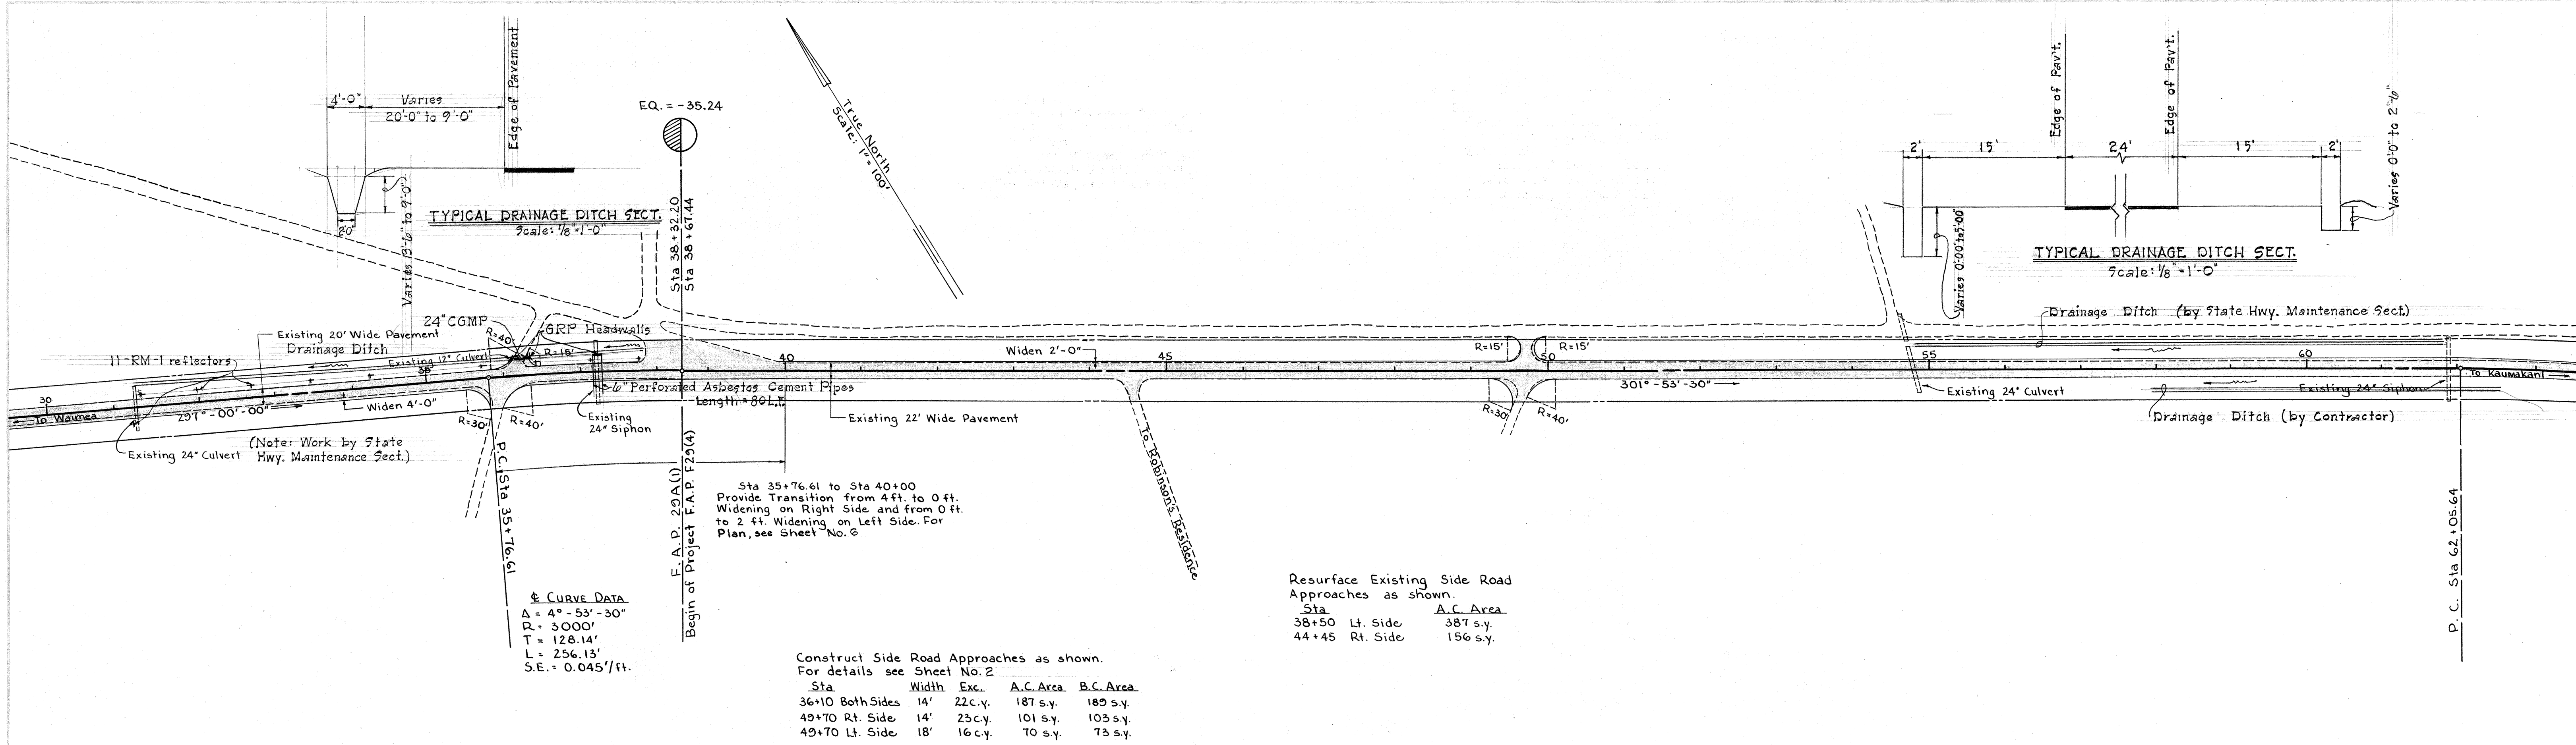

PROJECT No. 50 B-01-67

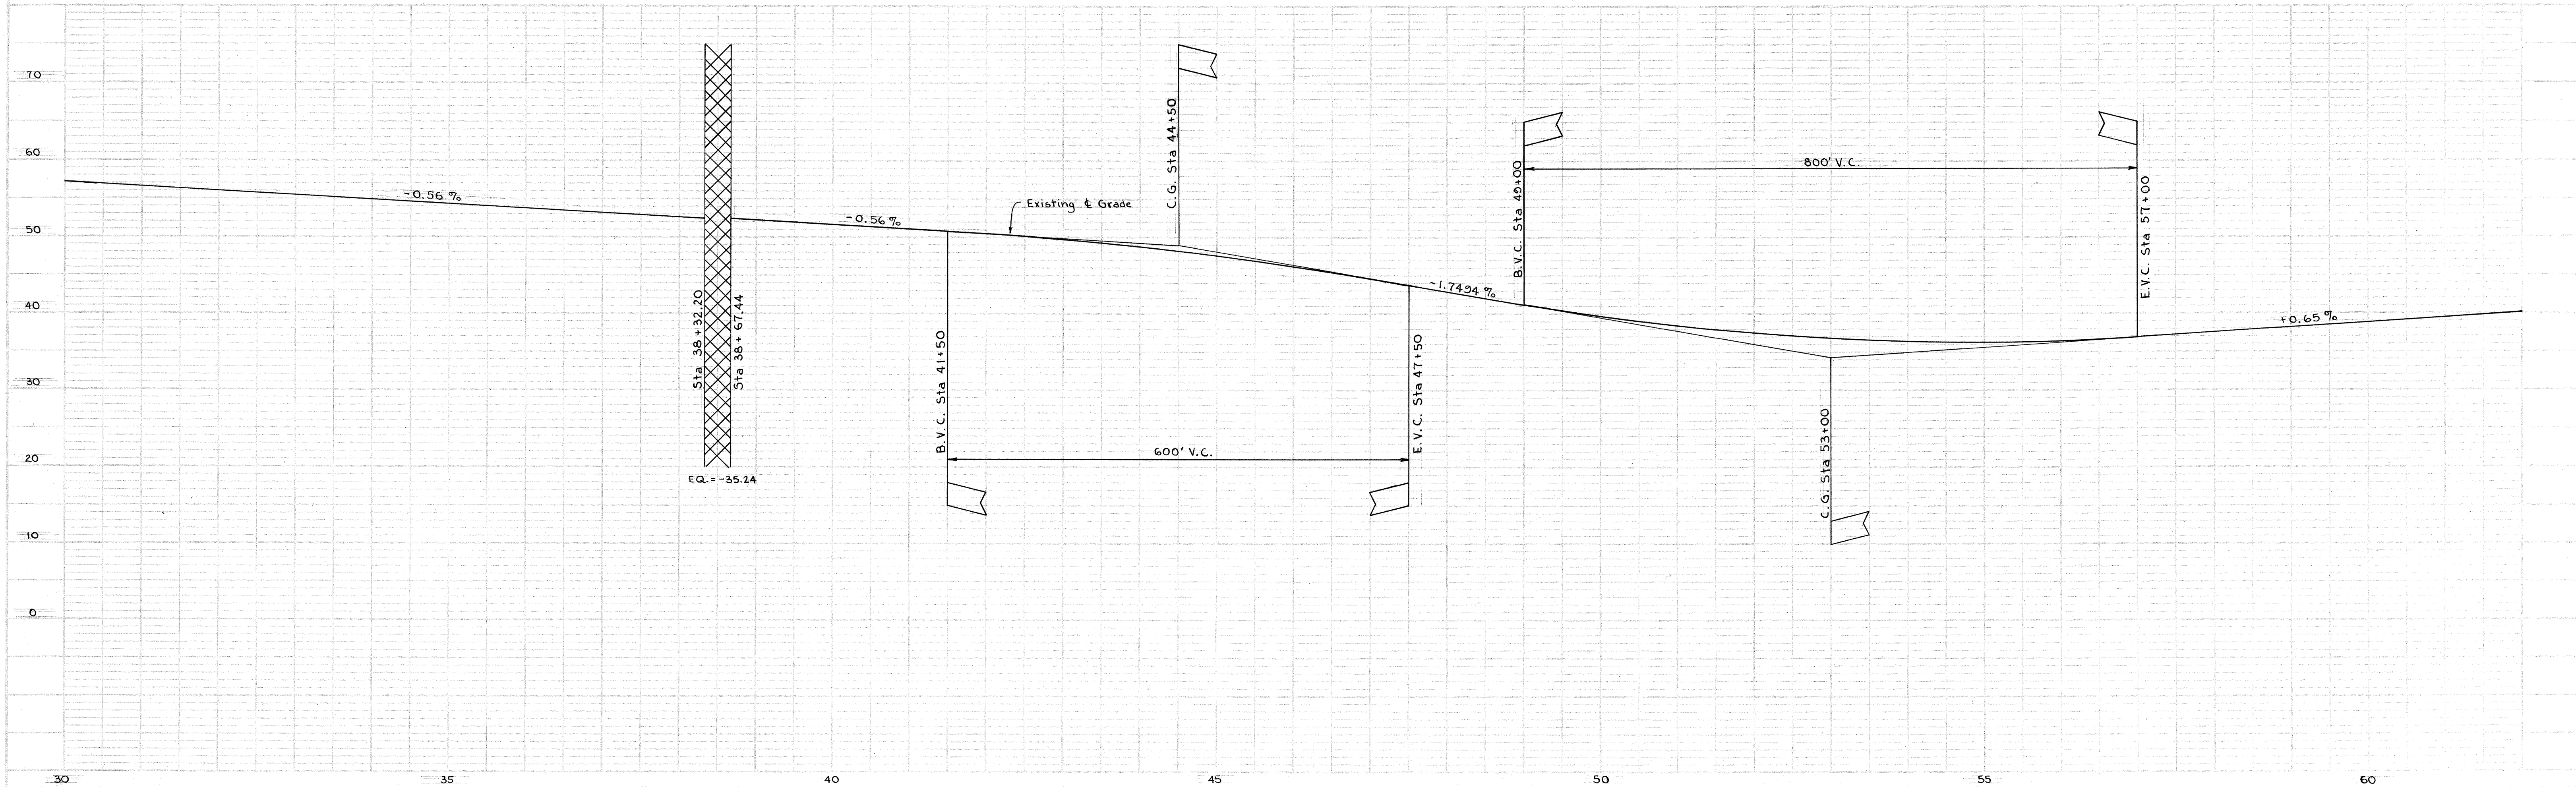

DATE	BY
DESIGNED	CHECKED
NOTED	PLANNED
NOTED	NOTED
NO.	NO.

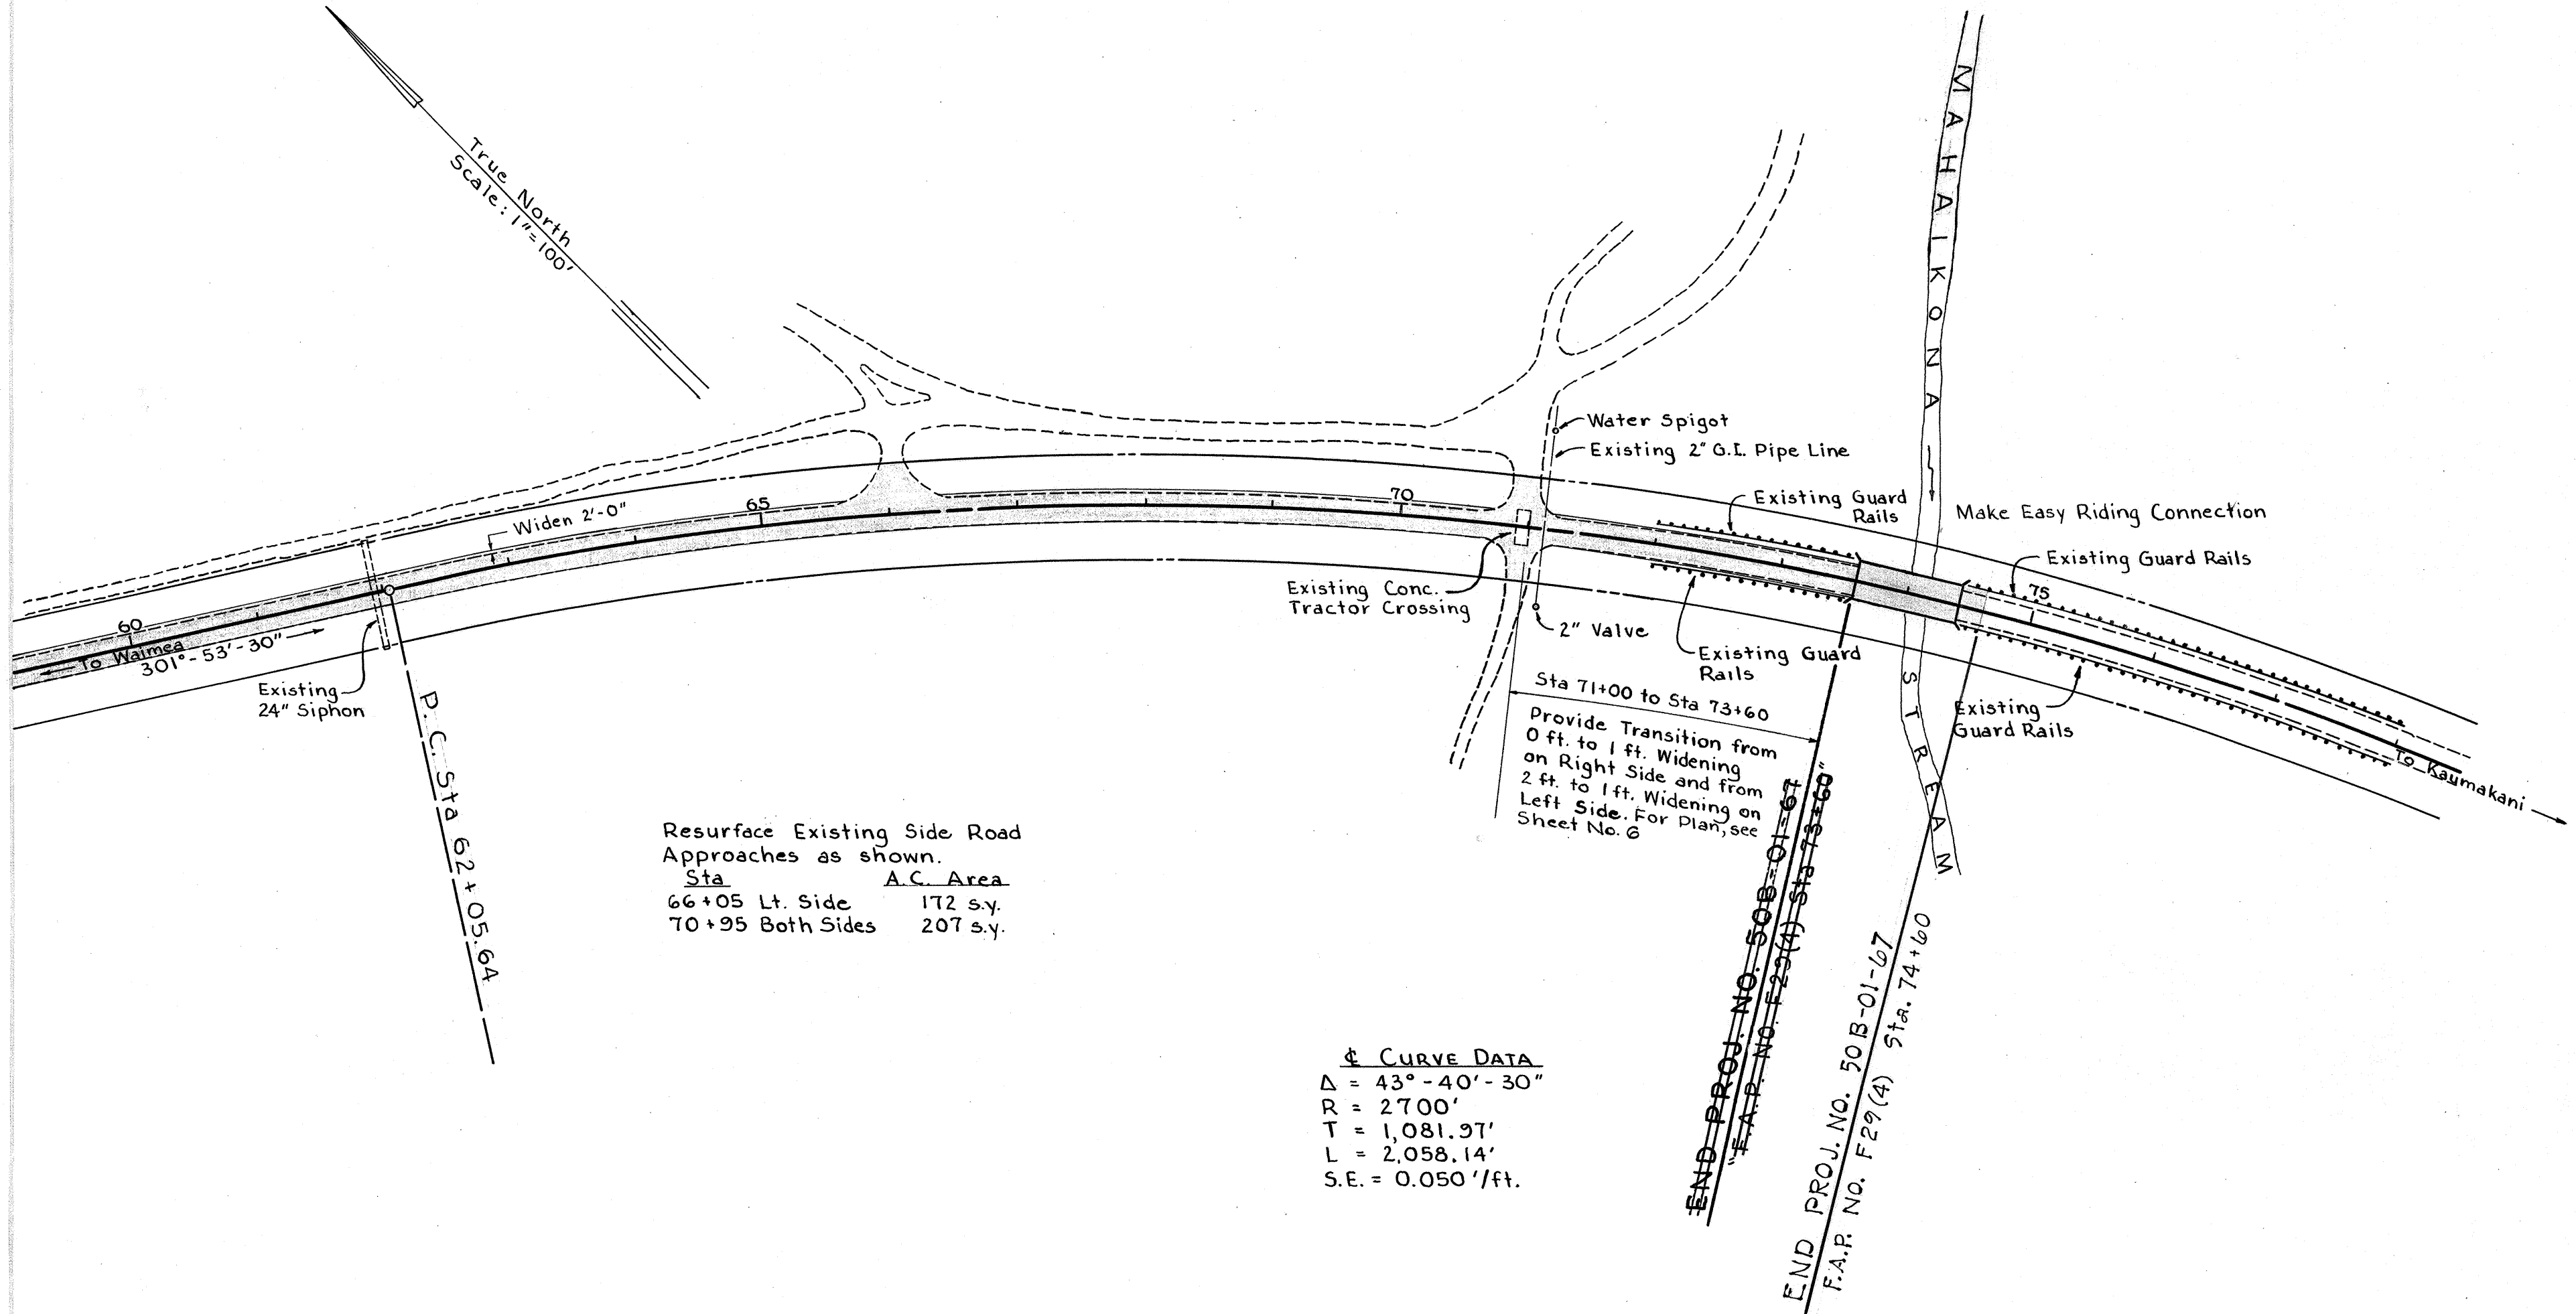

± CURVE DATA
 $\Delta = 43^\circ - 40' - 30''$
 $R = 2700'$
 $T = 1,081.97'$
 $L = 2,058.14'$
 $S.E. = 0.050' / ft.$

PROJECT No. 50 B-01-67

DATE	BY
DESIGNED	CHECKED
NOTED	PLANNED
NOTED	NOTED
NO.	NO.

